

2



US Army Corps
of Engineers
Fort Worth District

**FOUNDATION
REPORT**

AD-A229 436

DTIC
ELECTE
NOV 27 1990
S D CG D

**COMPLETION OF
EMBANKMENT, SPILLWAY
AND OUTLET WORKS
RAY ROBERTS LAKE
ELM FORK, TRINITY RIVER, TEXAS**

DISTRIBUTION STATEMENT A
Approved for public release
Distribution Unlimited

August 1990

90 11 19264

CORPS OF ENGINEERS
FORT WORTH DISTRICT, TEXAS



FOUNDATION REPORT
COMPLETION OF EMBANKMENT AND SPILLWAY

RAY ROBERTS LAKE

Accession	
NTIS <input type="checkbox"/> <input checked="" type="checkbox"/>	
DTIC <input type="checkbox"/> <input checked="" type="checkbox"/>	
U. S. Army J. E. H. H. H.	
By <i>per call</i>	
Distribution <i>1</i>	
Availability <i>1</i>	
Dist	Avail. & 1/0 Special
<i>A-1</i>	

Statement "A" per telecon Caroline Solomon. U.S. Army Engineering District, Fort Worth/CESWF-IM-C. P. O. Box 17300. Fort Worth, TX 76102-0300.

VHG

11/26/90

AUGUST 1990

TABLE OF CONTENTS

<u>Para No.</u>	<u>TITLE</u>	<u>Page No.</u>
1	INTRODUCTION	
	a. Project Location and Description	1
	b. Construction Authority	1
	c. Purpose of the Report	1
	d. Project History	2
	e. Contractors, Supervision and Quality Control Organization	4
	(1) Quality Control	4
	(2) Contract Supervision	4
2	FOUNDATIONS	
	a. Investigations Prior to Construction	5
	b. Investigations During Construction	6
3	GEOLOGY	
	a. Physiography	6
	b. Site Geology	7
	(1) Overburden	7
	(2) Structure	8
	(3) Stratigraphy	8
	(a) Pawpaw Shale	8
	(b) Main Street Limestone	9
	(c) Grayson Marl	9
	(d) Woodbine Formation	9
	(4) Weathering	10
	(5) Ground Water	11
	c. Engineering Characteristics of Over- burden Materials	11
	(1) Outlet Works	11
	(2) Embankment	11
	(3) Weak Stratum	12
	(4) Spillway	13
	d. Engineering Characteristics of Bedrock Materials	13
	(1) Outlet Works	13
	(2) Embankment	14
	(3) Spillway	14

TABLE OF CONTENTS
(cont'd)

<u>Para No.</u>	<u>TITLE</u>	<u>Page No.</u>
	e. Unusual or Unanticipated Geologic Conditions Encountered During Construction	14
4	EXCAVATION PROCEDURES	
	a. Excavation Grades	14
	b. Dewatering Provisions	15
	c. Overburden Excavation	15
	d. Rock Excavation	15
	e. Line Drilling, Presplitting and Contour Blasting	26
	f. Foundation Preparation	26
	g. Gunite in Conduit Excavation Walls	26
	h. Safety Protection Against Slides and Rockfalls	42
5	PILE DRIVING AND SPECIAL FOUNDATIONS	42
6	TUNNELS, SHAFTS, AND UNDERGROUND STRUCTURES	42
7	FOUNDATION ANCHOR TEST	42
8	CHARACTER OF FOUNDATION	
	a. Character of Overburden Materials	47
	b. Character of Primary Materials	47
9	FOUNDATION TREATMENT	48
10	FOUNDATION INSTRUMENTATION	
	a. General	48
	(1) Initial Embankment and Closure Section	48
	(2) Left Abutment	56
	(3) Embankment Underseepage	56
	(4) Outlet Works	56
	(5) Embankment Crest	56

TABLE OF CONTENTS
(cont'd)

<u>Para No.</u>	<u>TITLE</u>	<u>Page No.</u>
	b. Schedule of Instrumentation Reading	56
	c. Settlement Plates and Deep Settlement Plates	57
	d. Inclinometers	57
	e. Piezometers	57
	f. Surface Reference Marks	58
	g. Reference Pins	58
	h. Seepage Interceptor System	58
11	POSSIBLE FUTURE PROBLEMS	59
12	RECORD OF FOUNDATION APPROVAL	59

PLATES

<u>Plate No.</u>	
1	Lake Map and Vicinity Map
2	General Plan
3	Dam Site Geology
4 - 7	Plan of Explorations
8 - 39	Logs of Borings
40 - 41	Outlet Works
42 - 43	Outlet Works, Plan and Profile
44 - 46	Geologic Profile, Embankment Centerline
47	Geologic Profile, Outlet Works
48	Spillway, Approach Channel, and Discharge Channel
49 - 60	Inspection Trench, Plan and Profile
61	Left Abutment, Deep Inspection Trench
62	Plan of Instrumentation
63	Record of Foundation Approval

RAY ROBERTS LAKE FOUNDATION REPORT

1. INTRODUCTION.

a. **Project Location and Description.** Ray Roberts Dam and Lake project is situated in northern Denton, south-central Cooke and western Grayson Counties. The Dam is at river mile 60.0 on Elm Fork of the Trinity River, approximately 30 river miles north of Lewisville Dam. The location of the project is shown on Plate 1. The principal features of the project include (1) a rolled earthfill embankment approximately 14,980 feet long; (2) a limited service spillway consisting of an uncontrolled trapezoidal broad-crested weir; the spillway crest length is 100 feet; and (3) the outlet works, consisting of an excavated approach channel, intake structure and service bridge, a 708-foot long by 13-foot diameter cut and cover conduit, stilling basin and excavated discharge channel (see Plate 2). For the future addition of hydropower, a separate steel-lined concrete 5-foot diameter low flow conduit was constructed beneath the main flood control conduit. (SDN)

b. **Construction Authority.** Congressional authority for construction of Aubrey Lake (now Ray Roberts Lake) is contained in the Public Works - Rivers and Harbor Act approved 27 October 1965 (Public Law 89-298) in accordance with the plan of improvement as outlined in House Document No. 276 (89th Congress, 1st Session).

c. **Purpose of the Report.** This report was prepared in accordance with requirements as set forth by the Office, Chief of Engineers in ER 1110-1-1801.

The purpose of this report is to provide a complete record of foundation conditions encountered during construction. Information contained in this report will be valuable when evaluating (1) necessary remedial action required to prevent or repair any problems resulting from foundation deficiencies; (2) contractor claims related to foundation conditions or alleged change of condition; and (3) planning and design of future comparable construction projects.

A copy of this report should be included in the permanent records maintained at the project office.

d. **Project History.** Four dam site locations were studied prior to final site selection. Site No. 1, the project document site, is at river mile 60.0. Sites 2, 3, and 4 are at river miles 55.9, 51.2, and 64.0, respectively. Three holes were drilled at Site 2 in 1970. No subsurface explorations were done at Sites 3 and 4.

Site No. 4, located upstream of the confluence of the Elm Fork and Isle du Bois Creek would require two embankments and in effect form two lakes. Site No. 4 would also require two outlet facilities or an equalizer channel. This was the uppermost site considered. Sites downstream from Site 3 would be in the flood pool of Lewisville Lake and would require a major railroad relocation.

Based on studies that included an appraisal of the physical, historic, economic, and social impacts at each site, and the results from a public meeting held in April 1971, Site No. 1 was selected as the recommended site. By Public Law 96-384, dated 6 October 1980, the

project name was officially changed from Aubrey Lake to Ray Roberts Lake.

Seven locations, designated A through G, for the spillway were investigated. Cost estimates were made for gated, broadcrested, and uncontrolled ogee spillways. Consideration was also given to a perched spillway with the crest elevation at 5 feet, and at 10 feet above the top of the flood control pool.

Site A was used for the gated spillway estimate for site selection. It was in the steep slope of the east abutment and proved to be undesirable from the standpoint of stability and excessive excavation. Site B, the recommended site, was used for the uncontrolled spillway estimate for site selection, and for various other plans. Site B proved to be the most economical spillway location regardless of type of spillway. Site E at Culp Branch on the west abutment was investigated, but spillways here were too costly because of excessive channel excavation and downstream land requirements. Sites C, D, F, and G were eliminated by inspection because of excessive excavation and additional land requirements.

Studies showed that a gated spillway had a higher first cost than the uncontrolled spillways. Annual operating and maintenance costs for a gated spillway would also be appreciably greater. Several studies were made of various plans with both broadcrested and ogee uncontrolled spillways, in order to optimize size and type of structure.

Studies were made for uncontrolled spillways with widths varying

from 100 feet to 1,000 feet. These studies indicated that the most economical project would be one with the narrowest spillway and highest embankment. A width of 100 feet was judged to be the practical minimum and was, therefore, selected for the recommended plan.

e. **Contractors Supervision and Quality Control Organization.** The embankment, spillway, and outlet works for Ray Roberts Lake were constructed under one contract. Pertinent data related to the contract are listed below:

Contractor: Phillips and Jordan, Inc., Knoxville, TN

Contract No.: DACW63-82-C-0083

Contractor's Bid: \$48,657,799

Notice to Proceed: 31 May 1982

Completion Date: 9 October 1986

Total Payment Including Modifications: \$51,491,731.27

(1) **Quality Control.** The quality control organization was furnished and compensated by the contractor.

(2) **Contract Supervision.** Construction was under the immediate supervision of the District Engineer, U.S. Army Engineer District, Fort Worth, Texas. The contracting officer's representative for administration of the contract was Mr. Webb Boland. The following personnel participated in administering the contract: Mr. Mark Gibson, outlet works construction, and Mr. David Bowie, embankment and spillway construction.

2. FOUNDATION EXPLORATIONS.

a. **Investigations Prior to Construction.** Dam Site No. 1 was first explored in 1939. Eight combination auger and core borings numbered C-1 through C-8 were drilled near the present alignment. The borings ranged from 67 to 217 feet in depth. In December 1960, three additional combination auger and core holes, numbered 9 through 11, were drilled on the right abutment slope, ranging in total depth from 30.6 to 106 feet. There are no testing records on either the overburden materials or the rock cores and the borings were not pressure tested. Boring locations are shown on Plates 4 through 7. Logs of boring are shown on Plates 8 through 39.

Twenty-two additional holes were drilled in 1971 and 1972 during the General Design Memo Study Phase. These holes were numbered 12 through 27, and B, C, D, E, F, J, and K. The following table shows the location, total footage, and purpose for these holes.

Location	: Number : Drilled	: Total : Footage	: :	Purpose
Right (West) Abutment	6	292.0		Embankment Foundation
Left (East) Abutment	1	51.0		" "
Valley Section	4	296.4		" "
Spillway	7	476.3		Spillway Location & Foundation
Right Abutment Outlet Works	2	95.2		Intake & Stilling Basin Foundation
*Left Abutment Outlet Works	2	105.8		Intake & Stilling Basin Foundation

*Alternate location considered for outlet works.

In late 1972 and 1973, 37 additional holes were drilled. These holes were numbered 28 through 77. Holes 41 through 49 were 3-inch

Shelby tube holes, drilled along the axis of the uncontrolled spillway. Holes 3S-52 through 3S-57 were 3-inch shelby tube holes drilled along the centerline of the outlet works discharge channel. The other 22 holes were drilled in the embankment foundation.

In 1975 and 1976, holes 83 through 99 were drilled in the outlet works area, with the exception of hole 3F-86, which was drilled on the left abutment.

In late 1975, nine 8A6C holes, designated 301 through 309, were drilled at Site E for spillway site selection. This site was was not selected.

In October 1980, holes 310 through 316 were drilled, and in April 1981, holes 358 through 366 were drilled, all in the outlet works area.

One calyx hole (42-inch auger) was drilled in March 1975, to a depth of 46.5 feet to investigate soft clay seams in the embankment foundation. The hole was located at Station 120+70, 130 feet upstream.

A total of 113 foundation borings were drilled at the project.

b. **Investigations During Construction.** No problems requiring additional subsurface explorations were encountered during construction.

3. GEOLOGY.

a. **Physiography.** Ray Roberts Dam and Reservoir lie within the Gulf Coastal Plain physiographic province. The coastal plain of Texas is characterized by a broad rolling landform extending from the outcrop of the basal Cretaceous sands to the northwest to the Gulf of Mexico on

the southeast. It has developed upon a sequence of sedimentary rock units which dip gently southeastward, resulting in successively younger formations cropping out Gulfward. The outcrop of each formation or group in the coastal plain of Texas has distinctive soil, vegetation, and erosion characteristics which are the basis for further physiographic subdivision. Ray Roberts Dam and Reservoir lie within two such subdivisions; the Grand Prairie and the Eastern Cross Timbers. Damsite Geology is shown on Plate 3. The Grand Prairie, a subdivision which has developed on the outcrop of the Washita Group of Lower Cretaceous age, occurs generally west of the Elm Fork of the Trinity River. It is characterized by a rolling to hilly topography supported by limestone, marl, clay shale, and sandy shale. Typically, it is a grassy country, the uplands being given largely to grazing, the valleys being important agriculturally. Situated east of the Elm Fork, the Eastern Cross Timbers has developed on the outcrop of the Woodbine Formation of Upper Cretaceous geologic age. The Eastern Cross Timbers is characterized by a rolling to moderately rugged topography which supports a prolific growth of post oak trees.

b. Site Geology.

(1) **Overburden.** Overburden on the abutments consisted of predominantly residual clay and clayey materials generally ranging from 25 to 35 feet in thickness. The embankment is founded on these materials. In the spillway area, 2 to 11 feet of clay and silty clay with scattered gravel were removed and this structure is founded on

weathered clay shale. Overburden materials in the floodplain consist of 35 to 45 feet of alluvial clays, silts, sands, and gravels, comprising the floodplain embankment foundation. In the outlet works area about 20 to 30 feet of alluvial clays, silts, sands, and gravels were removed and the outlet works is founded in unweathered clay shale of the Pawpaw Formation.

(2) **Structure.** Subsurface investigations and subsequent foundation mapping during construction of the dam, outlet works and spillway have not revealed faulting or any other structural anomalies that would adversely affect the foundation of these structures. Correlation of marker beds encountered in the foundation borings show that the strata strike northeast and dip about 60 feet per mile to the southeast. Locally, minor undulations occur within the strata.

(3) **Stratigraphy.** Primary materials at the site from oldest to youngest are Pawpaw shale, Main Street limestone and Grayson marl of Lower Cretaceous age, and the Woodbine Formation of Upper Cretaceous age. The broad Elm Fork River valley is partially filled with Recent floodplain alluvium, while the uplands bordering the valley are often covered with Quaternary age terrace deposits.

a. **Pawpaw Shale.** Except for some isolated remnants of Main Street limestone, the Pawpaw shale comprises the primary strata beneath the embankment between station 0+00 to the base of the left abutment, the outlet works, and spillway (see Plates 44 through 48). The formation is composed of a soft to moderately hard, gray to black,

medium bedded clay shale, often sandy with sand laminations and lenses up to several inches thick. Thin, limy, fossiliferous zones occur throughout the formation.

b. **Main Street Limestone.** The Main Street limestone conformably overlies the Pawpaw shale. A full section is present in the left abutment. Erosional remnants occur in the central part of the embankment foundation and on the right abutment slope above elevation 640. The limestone is about 12 feet thick, moderately hard to hard, gray, fossiliferous, massive at its base, and becomes shaly as it grades into the overlying Grayson marl.

c. **Grayson Marl.** The Grayson marl occurs only in the left abutment at the dam site. It is represented by a soft to moderately hard, gray, highly calcareous, thick bedded, fossiliferous shale, that becomes increasingly marly at its base. Often a thin shaly limestone bed caps the formation separating it from the unconformably overlying Woodbine Formation. The Grayson and Main Street Formations are usually mapped as one geologic unit. At the dam site, their combined thickness is about 30 feet.

d. **Woodbine Formation.** The left abutment, above approximate elevation 565, is comprised of sediments belonging to the Woodbine Formation. Core borings made for the embankment reveal a fine-to-coarse-grained sand with scattered ironstone concretions and thin, poorly cemented sandstone seams to approximate elevation 600. In the basal portion of the Woodbine, a soft to moderately hard, gray to

brown, sandy clay shale predominates, although sand and sandstone can occur. Carbonaceous fragments are often noted. These inclusions, along with the generally noncalcareous nature of the shale, distinguish the material from the underlying Grayson Formation. The Woodbine exhibits gradational changes, both laterally and vertically, in its lithologic composition that make correlation between even closely spaced borings very difficult. The most detailed description of the Woodbine was developed after excavation of the inspection trench of the left abutment. Plate 58 is a geologic section of the plan of the inspection trench along the left abutment prior to placement of the fill.

(4) Weathering. Chemical weathering (oxidation and hydration) has affected the primary strata at the dam site to varying degrees. The shale and sandy shale of the Pawpaw Formation that comprise the primary strata for most of the embankment section have been only slightly altered. Staining (oxidation) is present to a maximum depth of about 14 feet below the top of primary strata that underlie the upland soils of the right abutment, while the Pawpaw shale beneath the alluvium in the valley section is fresh. In contrast, the sand, soft sandstone and shale of the Woodbine Formation that comprise the left abutment are deeply weathered. The relatively permeable sands and sandstones receptive to percolating waters are generally weathered throughout to the top of the first significant shale beds. Weathering in the shale occurs primarily as oxidation along joints and bedding

planes.

(5) **Ground Water.** Water levels are shown on Plates 44 through 48. Significant quantities of ground water are found in the floodplain alluvium and in the basal sands and gravels of the low level terrace deposits. Lesser quantities occur in joints and fractures in the weathered section of the Pawpaw shale and in the basal portion of the Woodbine Formation near its contact with the underlying Grayson in the left abutment. Prior to impoundment, ground water in the floodplain alluvium occurred at depths of 20-25 feet. During excavation of the inspection trench in the left abutment, water seeps were encountered at the contacts of the more pervious sands and sandstones with the underlying clays (see Plate 58).

c. Engineering Characteristics of the Overburden Materials.

(1) **Outlet Works.** Overburden in the outlet works area was investigated using auger, Denison and Shelby tube samplers. The materials consist of sandy clays (CL and CH) with zones of clayey sands (SC) and gravels (GC-GP). The gravelly zones generally overlay the primary materials. Overburden thickness varies from about 5 to 25 feet along the approach channel, from 8 to 20 feet along the conduit, and from 12 to 45 feet along the discharge channel. Classification and index testing were performed on jar samples taken from various depths in the overburden.

(2) **Embankment.** The overburden materials in the embankment foundation consist of alluvial clays, sands, and gravel strata.

Classification tests, Q, R, and S strength tests, and consolidation tests were performed on Denison barrel samples taken at varying depths in the clay. Classification and index tests were performed on jar samples taken from auger borings and Denison barrel samples obtained from the overburden in the floodplain. The following properties were used for overburden materials in the floodplain:

Moisture content 20%

Dry density 107.5 pcf

<u>Type Test</u>	<u>c</u> <u>tsf</u>	<u>0</u> <u>Degrees</u>
Q	0.8	3
R	0.1	14
S	0	26

(3) Weak Stratum. The following soil parameters were used for the weak, sandy clay stratum which is located in the foundation near the base of the overburden beneath the floodplain embankment.

Moisture content 23%

Dry density 102.0 pcf

<u>Type Test</u>	<u>c</u> <u>tsf</u>	<u>0</u> <u>Degrees</u>
Q	0.35 and 0.40	2.5
R	0.1	14
S	0	26

The low, undrained shear strength of this weak stratum is the controlling factor in the stability of the floodplain embankment.

(4) Spillway. The broadcrested weir is founded in weathered shale. Overburden along the centerline of the spillway increases from 2 feet in the area of the weir to 7 feet in the approach channel and 4 to 6 feet in the discharge channel. The overburden consists of principally silty clay with some fine sand and locally scattered fine gravels.

d. Engineering Characteristics of the Bedrock Materials.

(1) Outlet Works. The primary materials in the outlet works area were investigated using Denison, Shelby tube and core barrel samplers. Boring locations are shown on Plate . Primary foundation materials consist of unweathered clay shales of the Pawpaw Formation. The shales contain interbedded sandstone seams and beds that vary from a few inches to approximately 4 feet in thickness. From station 27+00 to 34+00, a near surface limestone layer was encountered which varied from about 2 to 7 feet in thickness. Laboratory testing was performed on selected samples of primary materials taken from borings along the centerline of the outlet works. Tests performed were classification, index grain size, unconfined compression and Q-triaxial compression tests. The approach channel structure, intake tower, and stilling basin was founded in unweathered shale for which the following parameters were used:

Allowable bearing pressure	8.0 ksf
Shear Strength, ϕ	20°
Cohesion	0

(2) **Embankment.** Laboratory strength tests conducted on samples of primary materials indicate that the shale stratum underlying the overburden through the floodplain has a low to moderately low strength, but its strength increases with depth. Although the strength of the shale is relatively low in the upper portion of the stratum, its strength is greater than that of the overburden; therefore, it is not the governing factor in the stability of the embankment.

(3) **Spillway.** The spillway is founded on interbedded silty shale and soft sandstone of the Pawpaw Formation. The materials are adequate to support the light loads to be imposed.

e. **Unusual or Unanticipated Geologic Conditions Encountered During Construction.** No unusual or unanticipated geologic conditions were encountered during construction.

4. EXCAVATION PROCEDURES

a. **Excavation Grades.** Foundation conditions encountered during excavation of the outlet works, inspection trench, cutoff trench, and emergency spillway were about the same as described in the subsurface data in the plans and specifications. The design slopes were achieved without any problems. The only deviation from designed grade lines was overexcavation in the primary materials. In February 1984, overexcavation occurred in the area adjacent to the outlet works conduit, between stations 28+90 and 29+80. The maximum depth of overexcavation was 2 feet. Contractor backfilled the overexcavation with concrete.

b. **Dewatering Provisions.** No ground-water problems of a serious nature were experienced in the outlet works, inspection trench, cutoff trench, or spillway excavations. On occasion, heavy rains partially filled the excavations. Small seeps were present in all the excavations except the spillway and are noted on the drawings. Surface water and the small amount of ground-water seepage experienced were handled by pump and sump operations. See Figures 1 through 6. All concrete and impervious backfill placements were on foundations free of water.

c. **Overburden Excavation.** Overburden materials excavated consisted of residual clay and other clayey materials on the abutments; alluvial clays, silts, sands, and gravels in the floodplain inspection trench and outlet works; and clay and sandy clay with scattered gravel in the spillway area. See Figures 7 through 12. Bulk excavation was done by Caterpillar scrapers. Finished grades were achieved with motor graders. Overburden materials considered suitable were used as random and semicompacted fill.

d. **Rock Excavation.** All rock excavation was accomplished using rippers and scrapers. Much of the weathered shale was used in a manner similar to the overburden; as random or semicompacted fill. Excavation methods were also similar. After bulk excavations of weathered shale by caterpillar scrapers, final grade was accomplished using motor graders. Exposure of weathered or unweathered shale of the Pawpaw Formation was limited to 3 days. See Figures 13 through 20. When this limit was exceeded, the contractor was required to clean the exposed



Figure 1. Outlet Works excavation, showing peripheral ditches controlling ground water.



Figure 2. Same as above

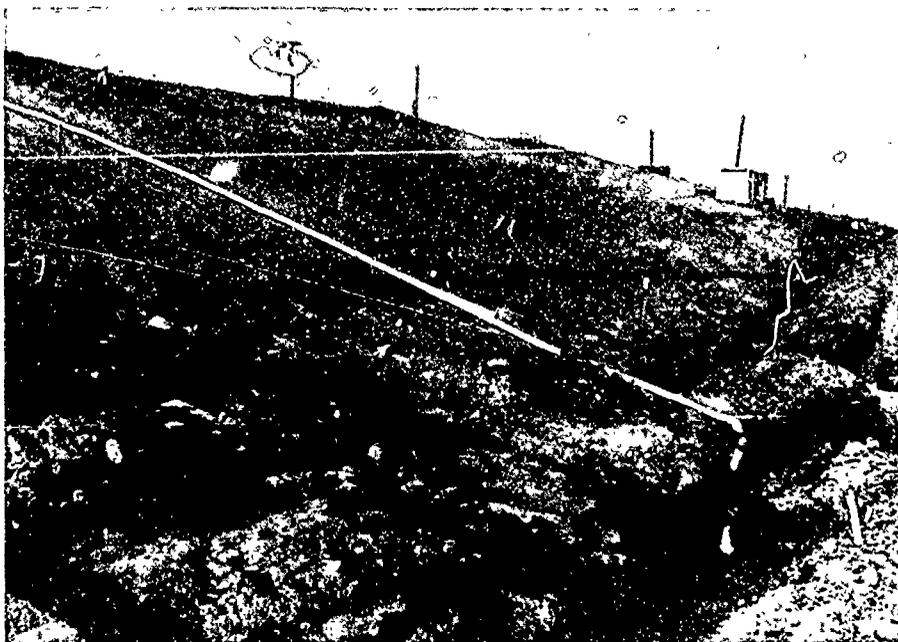


Figure 3. Outlet Works excavation showing peripheral ditches controlling ground water.

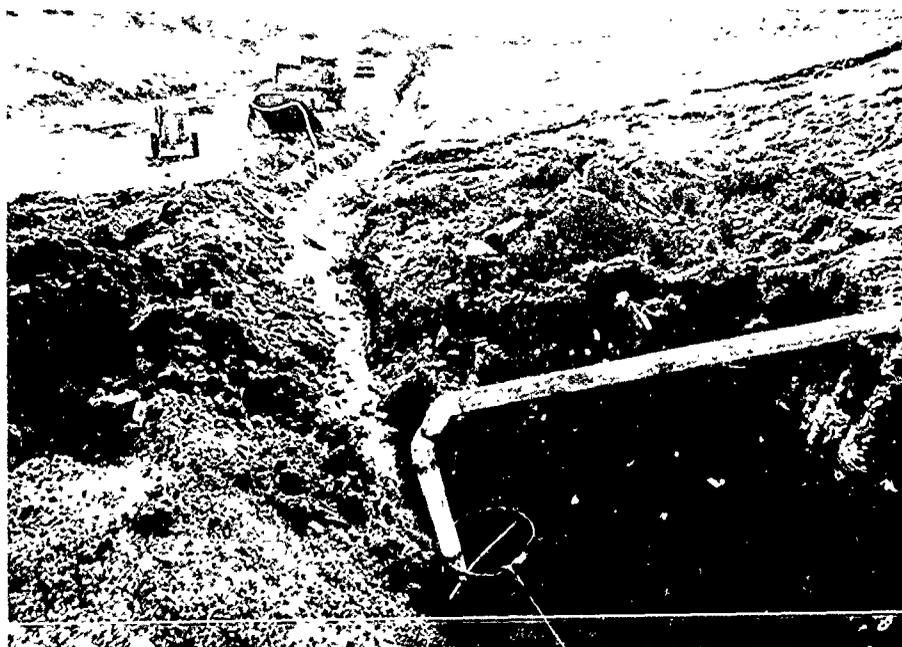


Figure 4. Same as above.



Figure 5. Outlet Works excavation showing peripheral ditches controlling ground water.



Figure 6. Same as above.

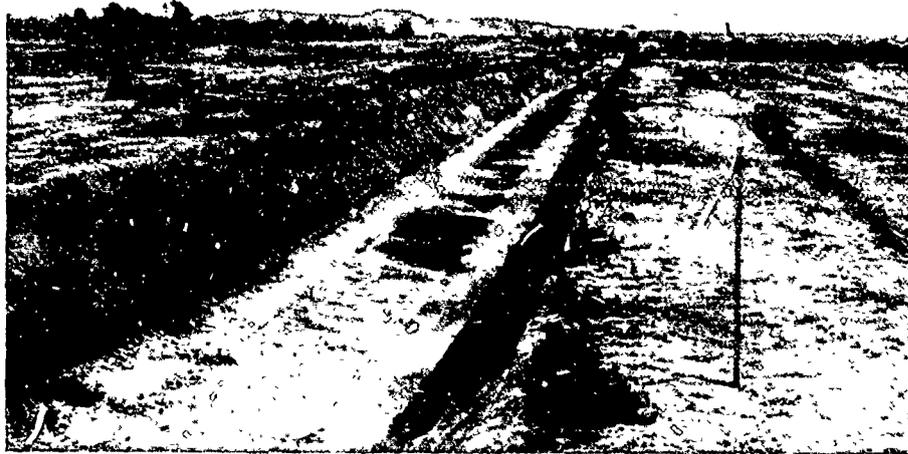


Figure 7. Right Abutment inspection trench looking east (Upstation)



Figure 8. Left Abutment looking east.



Figure 9. Downstream face of right abutment inspection trench approx. sta. 66+50 to 69+00, looking east (Upstation).



Figure 10. Upstream face of right abutment inspection trench Approx. sta. 66+50 to 69+00, looking east.



Figure 11. Right abutment inspection trench, looking west (downstream).



Figure 12. Same as above.

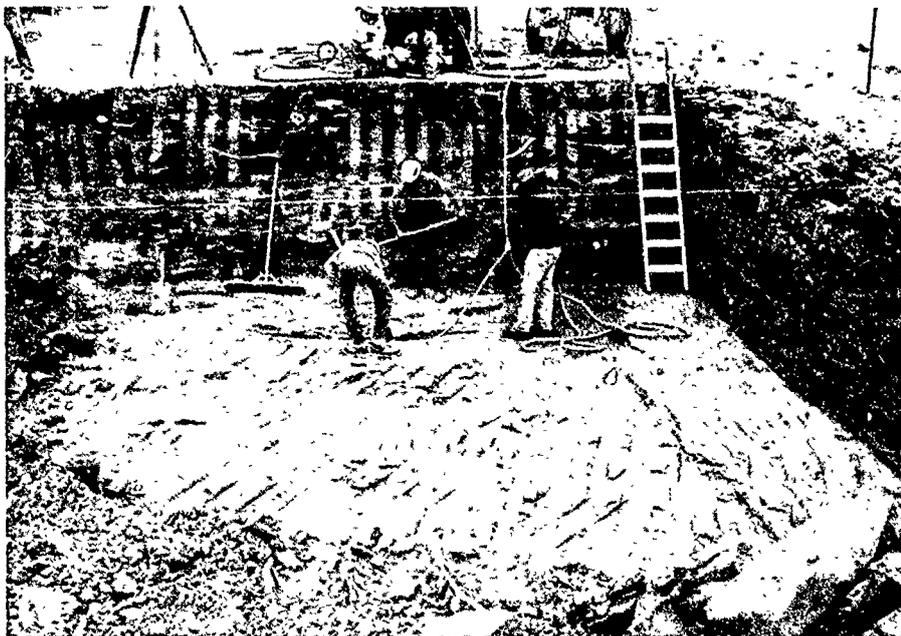


Figure 13. Intake Structure, hand cleaning shale foundation.



Figure 14. Intake Structure, placing re-bar for slab.



Figure 15. Looking Upstream from valve vault, showing fresh shale surface prior to placement of impervious material.

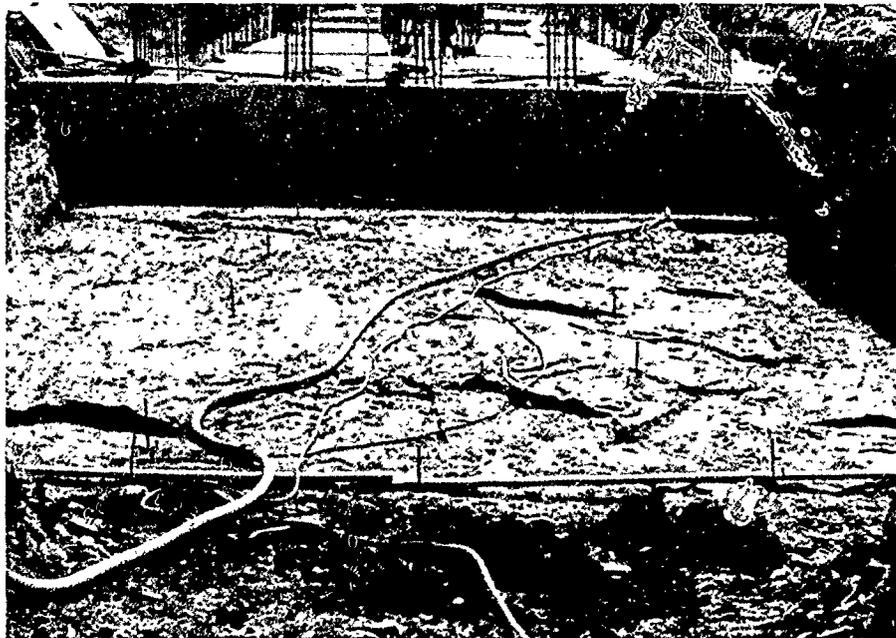


Figure 16. Foundation for approach slab.

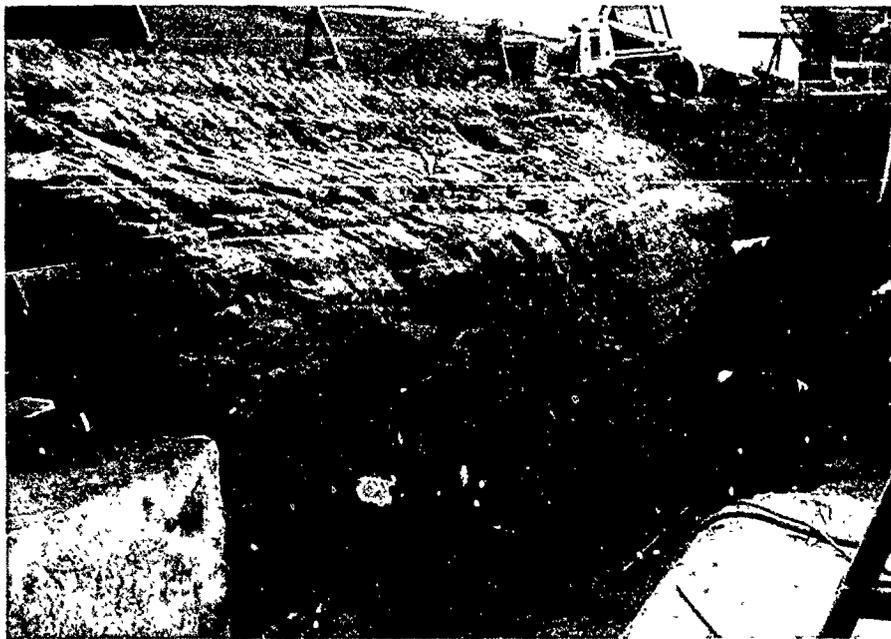


Figure 17. Excavation for intake for hydropower conduit at intake structure slab - looking downstream.

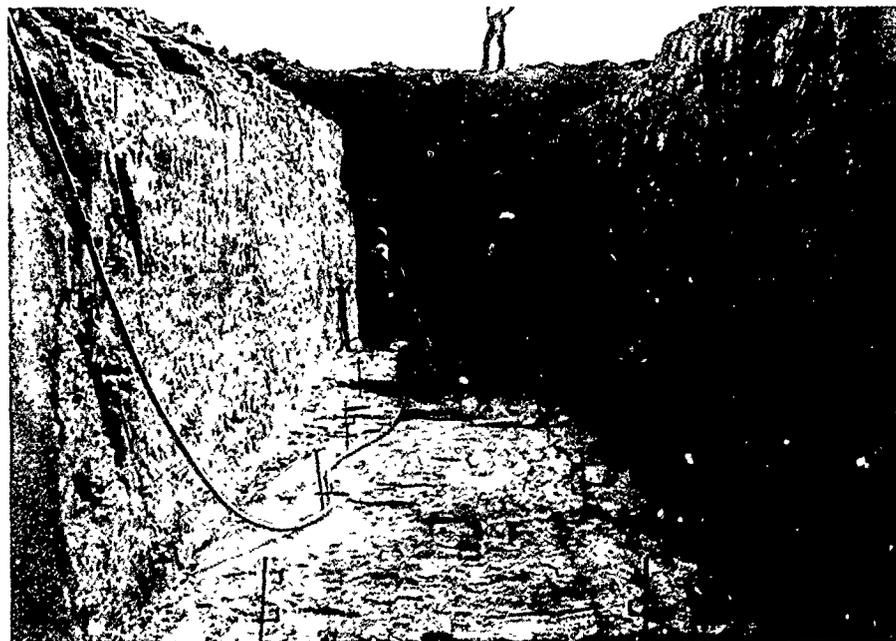


Figure 18. Hydropower conduit - placing gunite, Sta. 29+50-30+00.

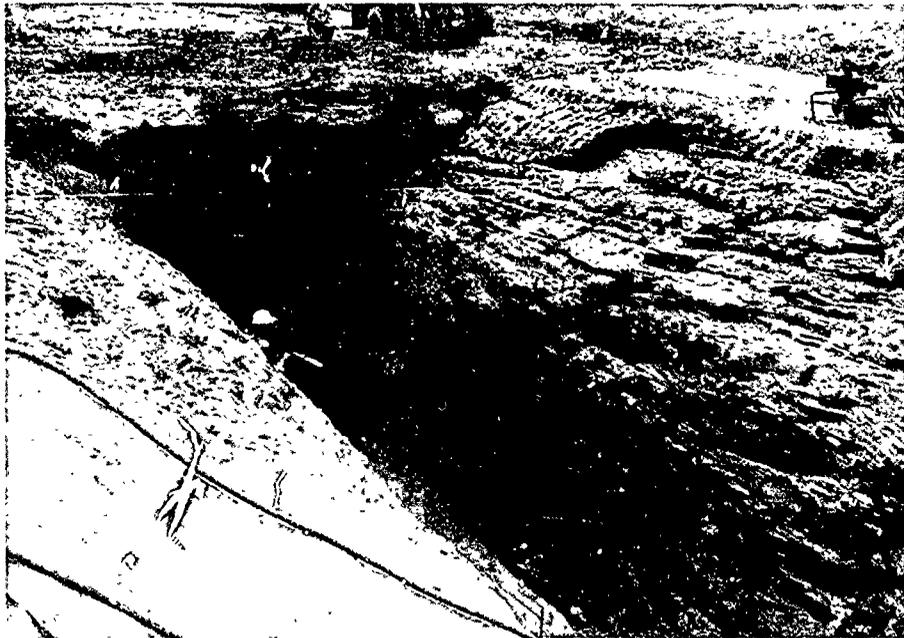


Figure 19. Hydropower conduit, looking downstream,
Sta. 29+20.

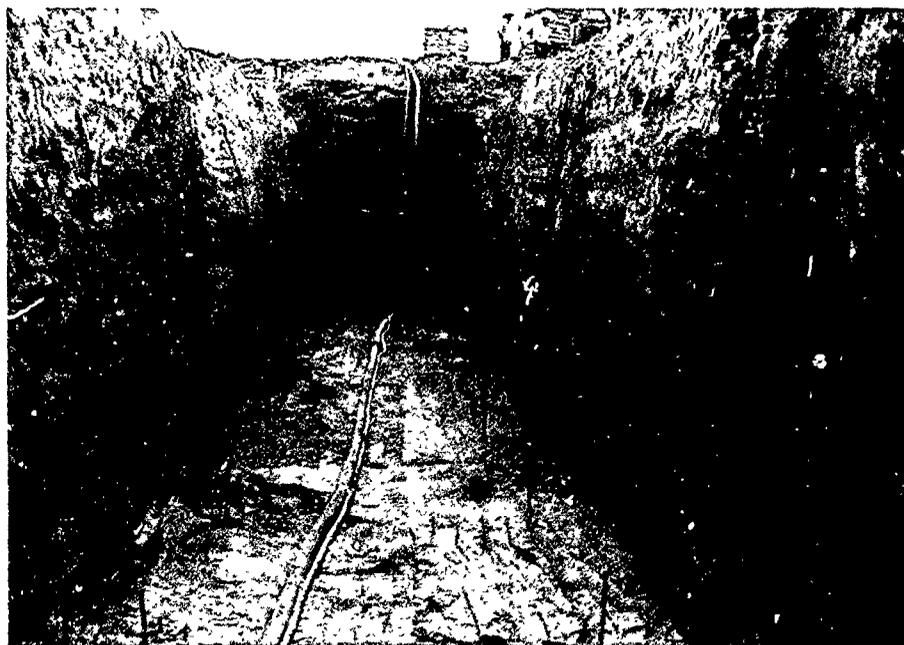


Figure 20. Hydropower conduit, looking downstream,
Sta. 30+10.

face by jackhammer and/or air jetting before protective concrete was placed.

e. **Line Drilling, Presplitting, and Contour Blasting.** No line drilling, presplitting, or contour blasting were performed during the course of construction.

f. **Foundation Preparation.** Clay shale of the Pawpaw Formation forms the majority of the foundation in the outlet works excavation and in the excavation for the sill of the limited-use spillway. See Figures 21 through 29. Primary materials in general were not exposed in cutoff or inspection trench excavations. See Figures 30 and 31. The most predominant material exposed was clay, especially CH clays. Since the clay shale deteriorates upon exposure to air, usually very noticeable within about 3 days, protective sealant or lean concrete (Gunitite) were specified for exposed shale surfaces. See Figures 34, 35, 36, 41, and 42.

g. **Gunitite in Conduit Excavation Walls.** Problems with Gunitite (protective concrete) developed in November 1982 in the hydropower conduit section between Stations 26+63 and 30+85. Excavation of the trench was done between 10 November 1982 and 23 November 1982. Gunitite was applied, as excavation progressed, on the floor and nearly vertical walls of the trench. Inspection on 24 November 1982 revealed numerous horizontal cracks, circular areas where Gunitite has fallen off the wall, and evidence that voids existed behind the Gunitite face. Inspection on 30 November 1982 revealed that deterioration of the Gunitite had greatly

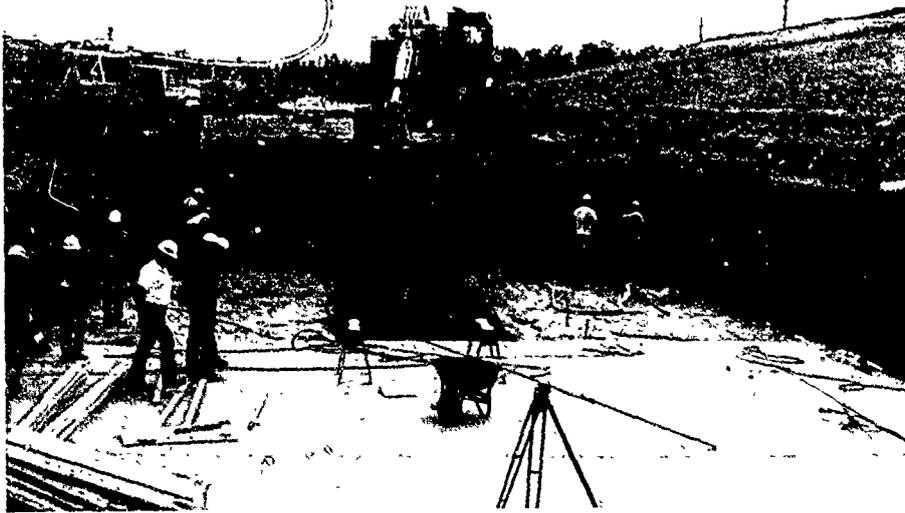


Figure 21. Excavation for hydropower conduit at intake structure slab.



Figure 22. Same as above.

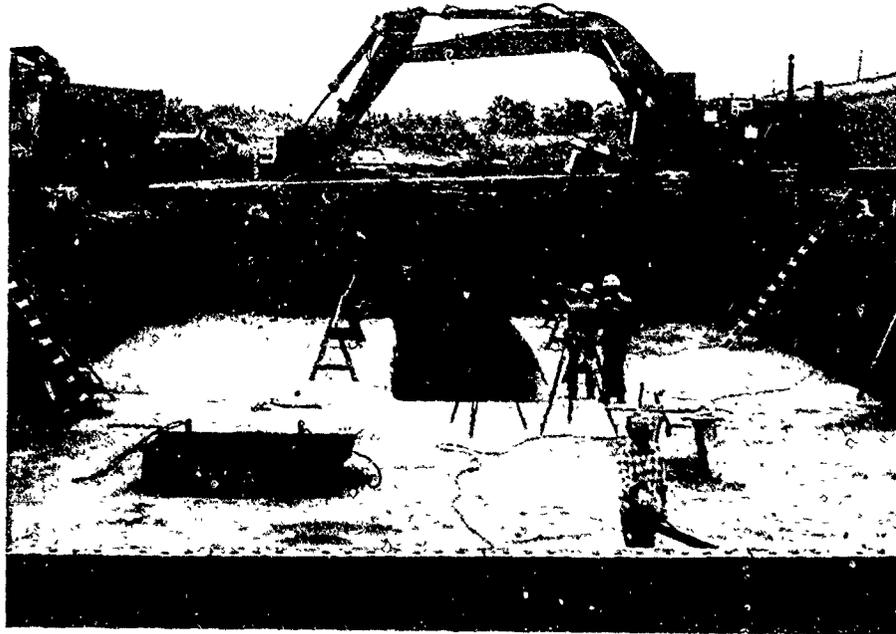


Figure 23. Excavation for hydropower conduit at intake structure slab.

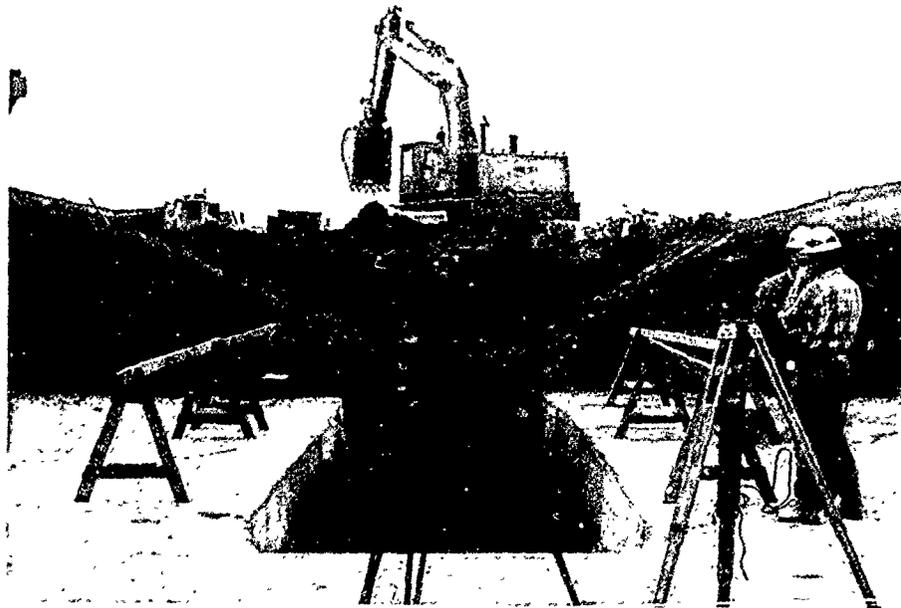


Figure 24. Same as above.

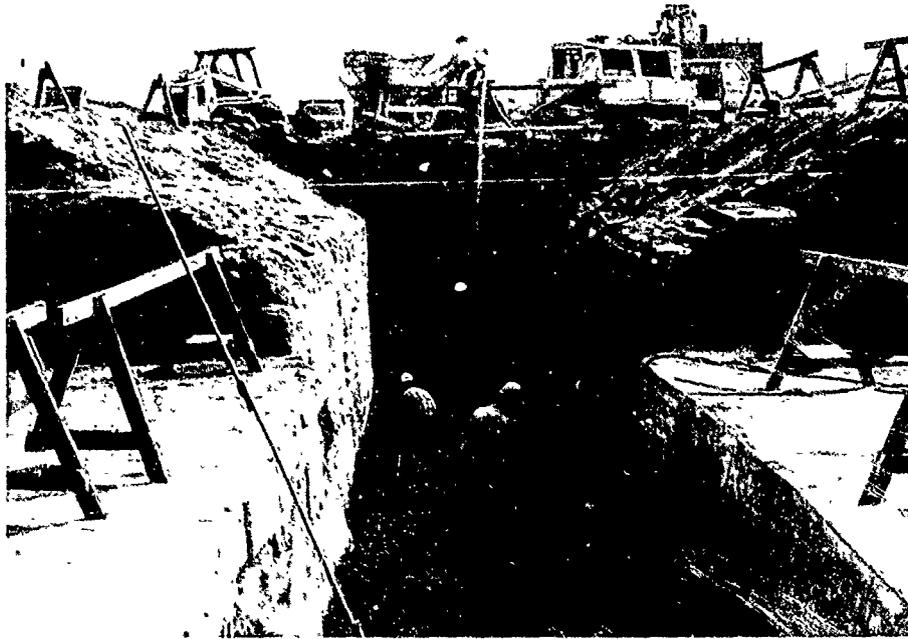


Figure 25. Excavation for hydropower conduit at intake structure slab.



Figure 26. Same as above.

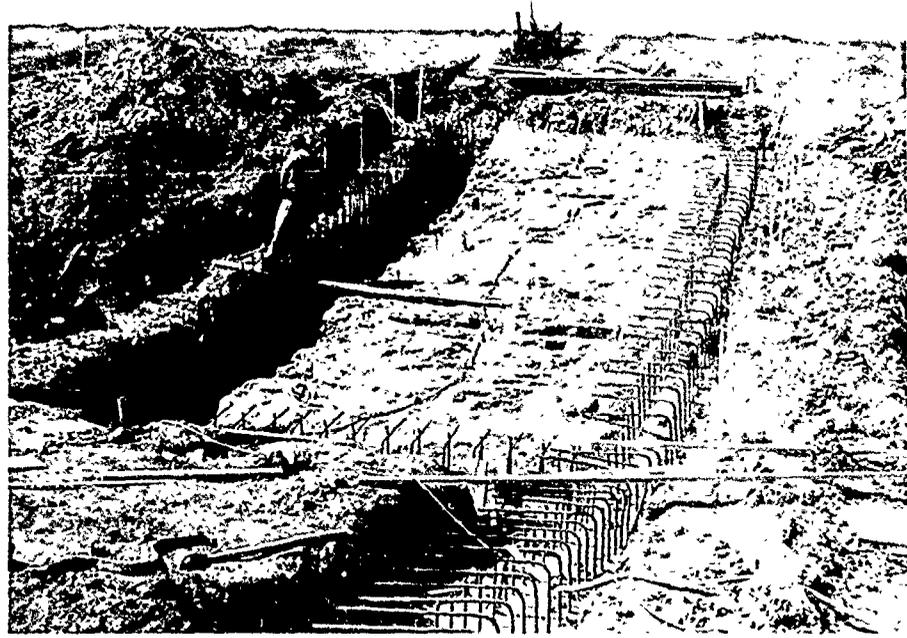


Figure 27. Construction of spillway sill.

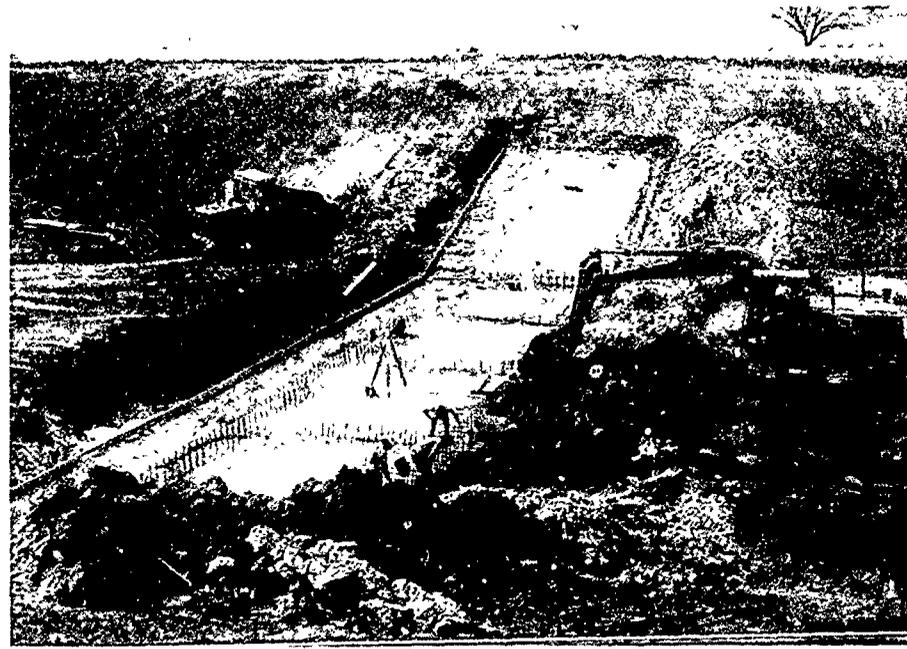


Figure 28. Same as above.

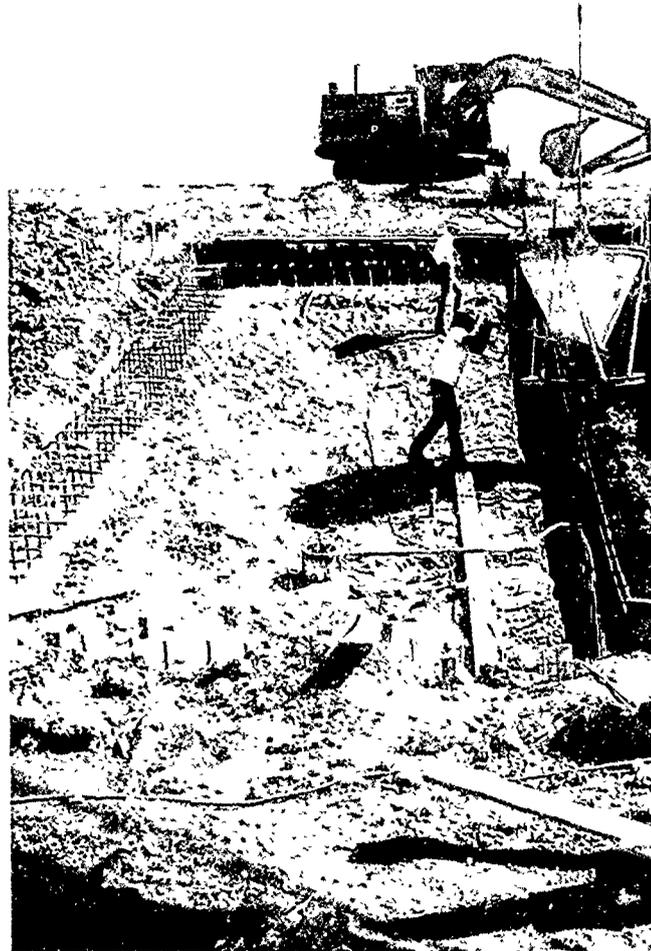


Figure. 29. Spillway - placing concrete footings.

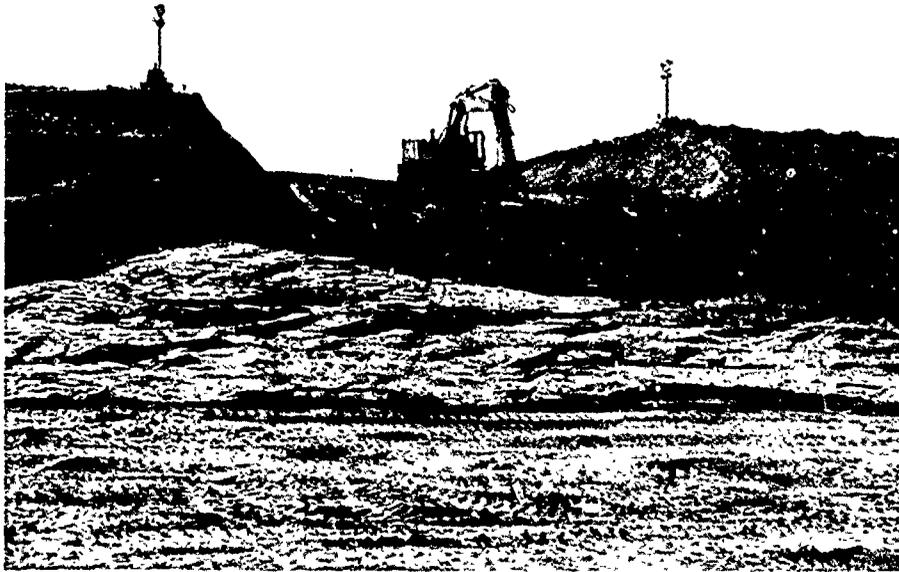


Figure 30. Looking downstation along dam centerline at intersection of embankment centerline and outlet works centerline.

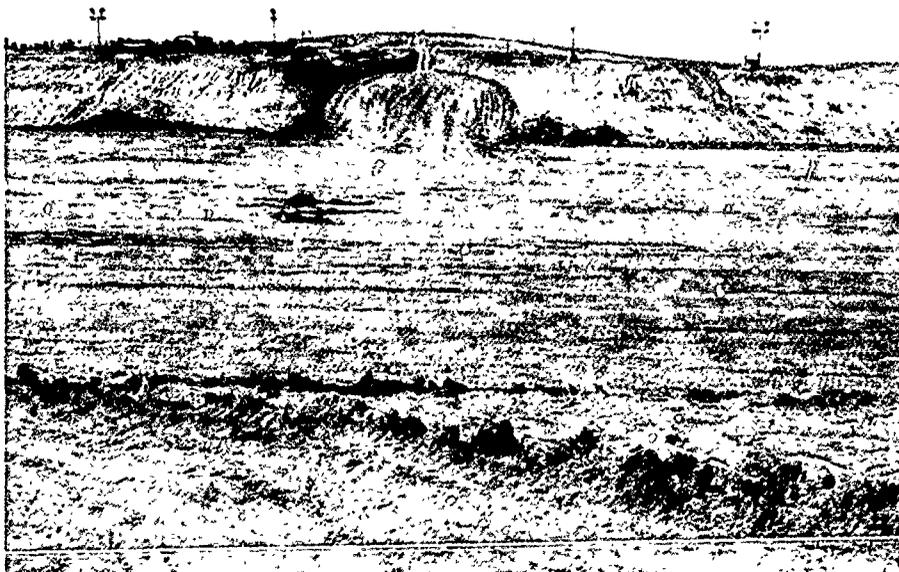


Figure 31. Later view of same area.



Figure 32. Inspection trench looking upstation (east).

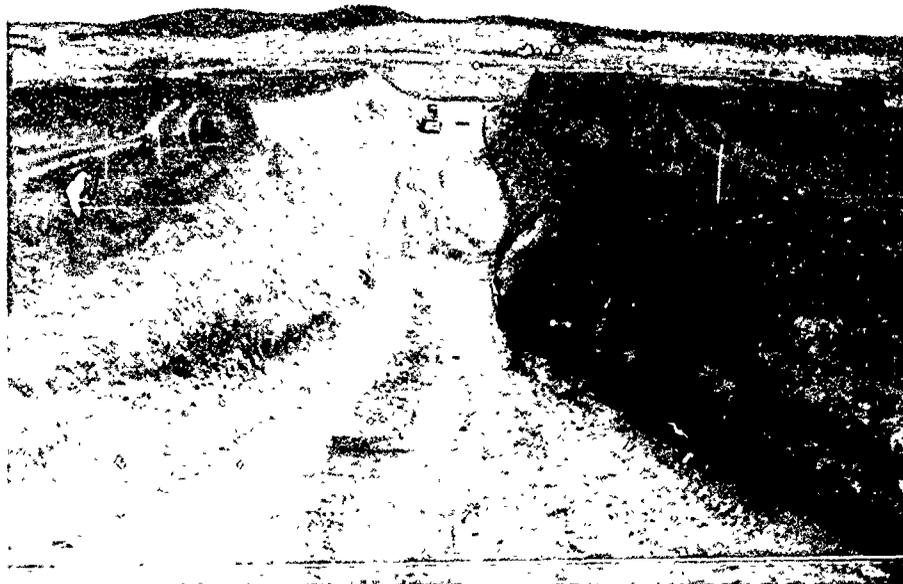


Figure 33. Inspection trench looking upstation.
Sta. 83+00 - 91+00.

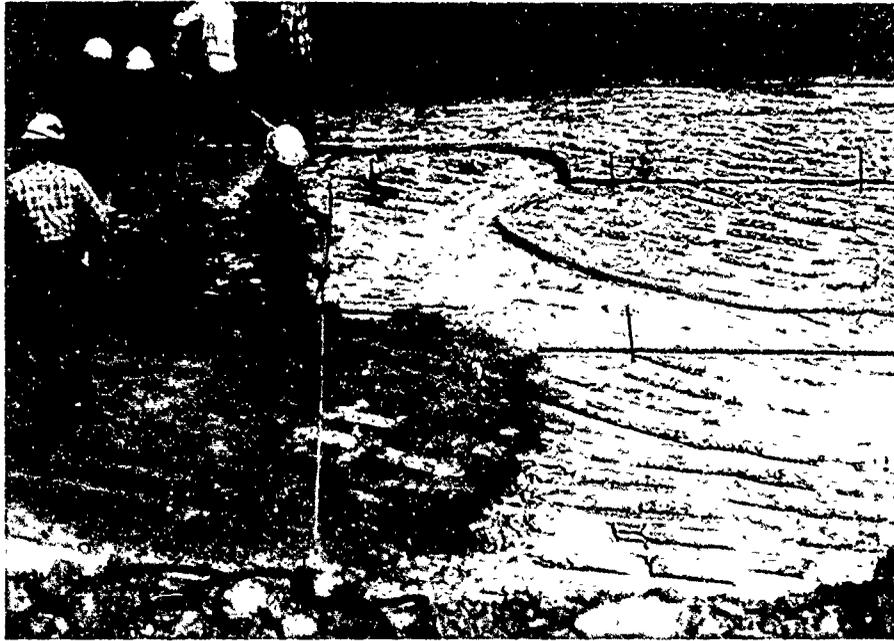


Figure 34. Intake structure foundation - spraying aerospray.

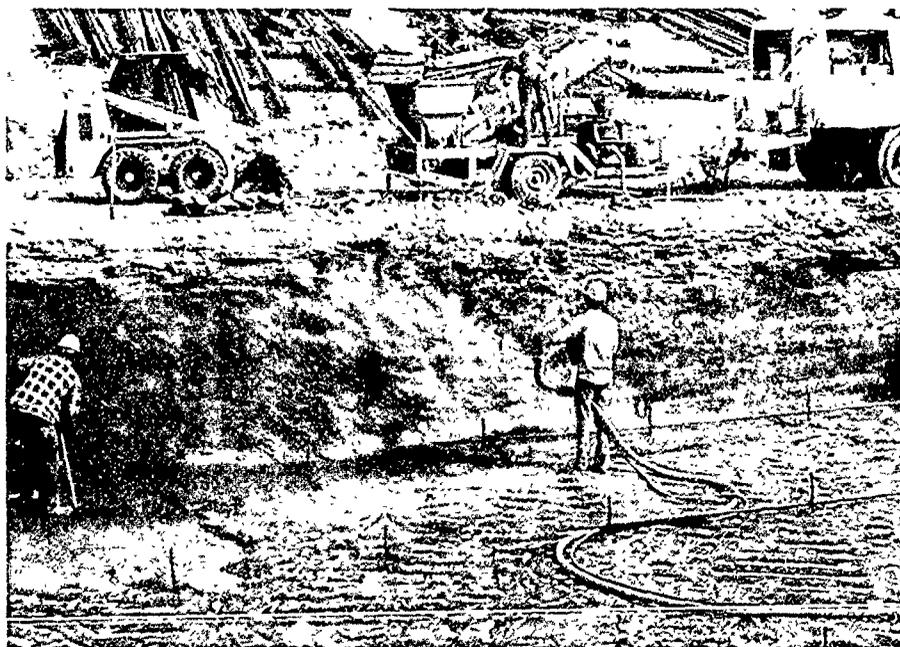


Figure 35. Intake structure foundation - applying gunite.



Figure 36. Intake structure foundation - placing protective concrete.



Figure 37. Forms for intake structure.



Figure 38. Outlet works, left side looking downstream at intake structure wing walls showing fresh shale surface.

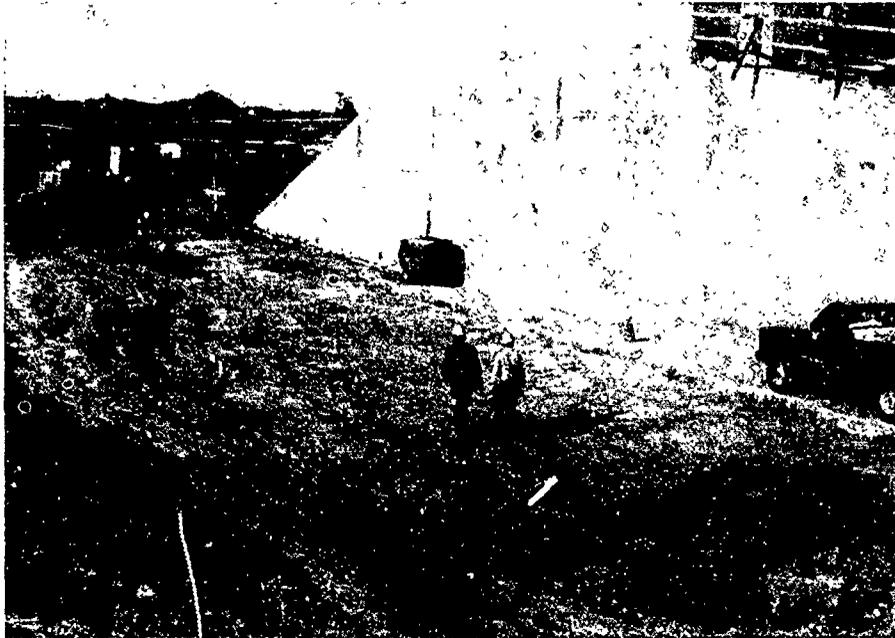


Figure 39. Intake structure, left side looking upstream. Fresh shale surface prior to placement of impervious.

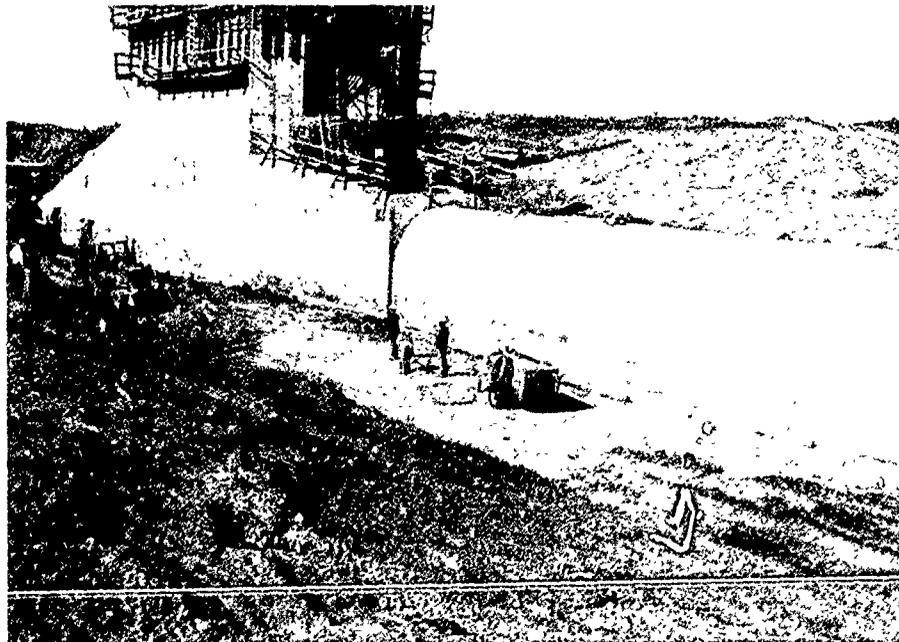


Figure 40. Same as above.



Figure 41. Hydropower conduit excavation showing gunite and aerospray application (looking upstream) Sta. 28+50 - 27+50.

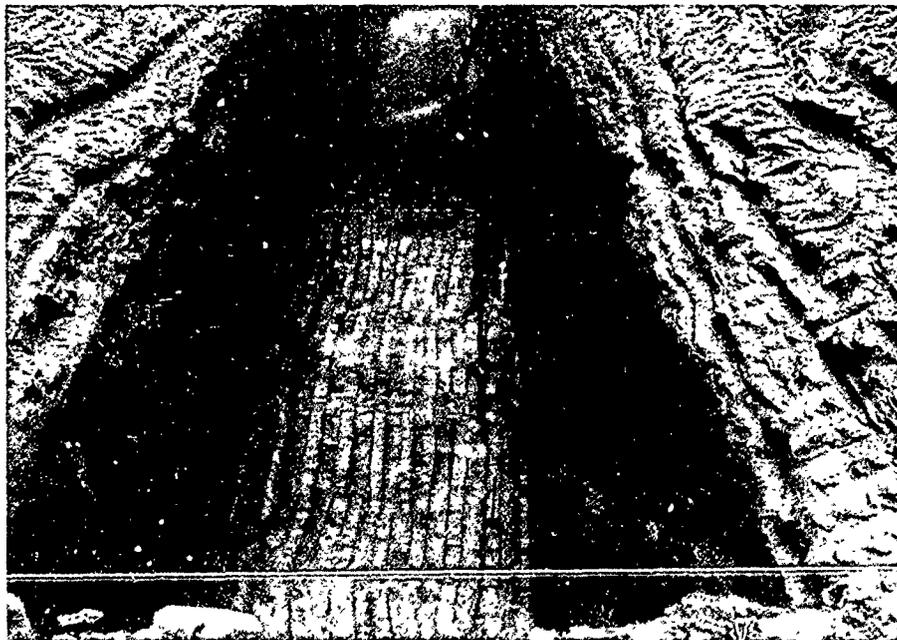


Figure 42. Same as above.

accelerated, apparently because of a heavy rain on 25-26 November 1982. See Figures 43 through 46. From Station 28+25 to 30+85 the Gunite was severely cracked and broken and an estimated 30-foot long section on the east wall of the trench had fallen. Most of the Gunite on both walls in this section appeared loose and ready to fall. Portions of the Gunite, though still in-place, had void space between the Gunite and the rock face. This space could provide a seepage path along the outside of the conduit connected directly to the reservoir pool. A contract modification was signed on 3 December 1982 which stated:

(1) On remainder of penstock excavation (Station 30+85 to Station 34+07), delete pneumatic concrete from the IV: .09 H slopes, and spray these slopes with Aero-spray 70 as often as required to prevent weathering of shale.

(2) Between Stations 28+22 and 30+75 remove all pneumatic concrete which is drummy, cracked, or loose. Spray exposed shale with Aero-spray 70 as often as required to prevent weathering of shale.

(3) All future penstock excavation (Station 30+85 to Station 34+07) and removal of existing pneumatic concrete (Station 28+22 to Station 30+75), will proceed at a rate to accommodate one placement at a time to minimize shale exposure.

The contractor agreed that no more than 3 days would pass between exposure of the clay shale and concrete encasement. On occasions when exposure was more than 3 days, deterioration, consisting of severe drying, cracking and checking, was often noted. Contractor was then

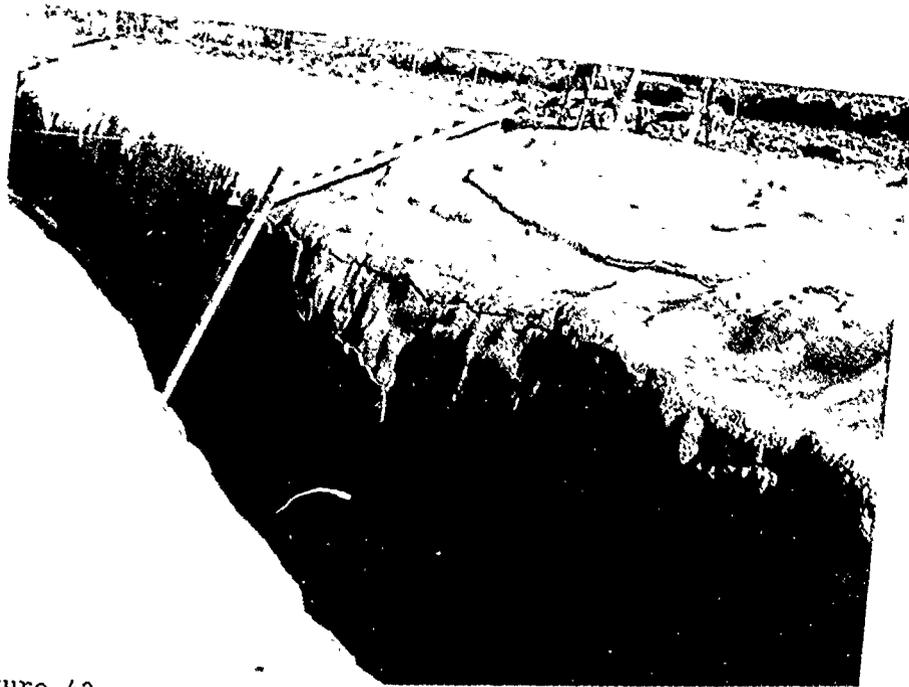


Figure 43. Failure of gunite on hydropower conduit excavation.



Figure 44. Same as above.

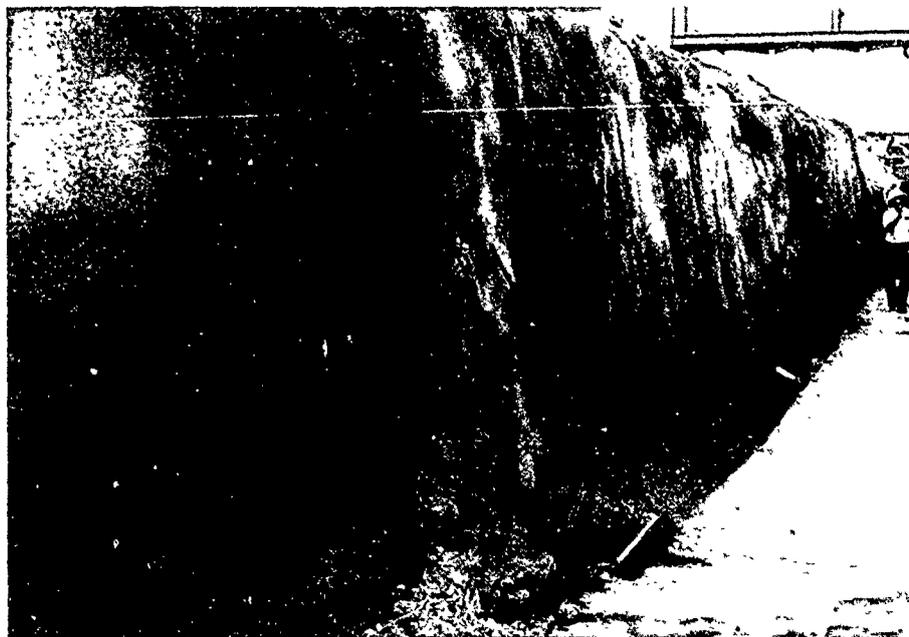


Figure 45. Failure of gunite on hydropower conduit excavation.

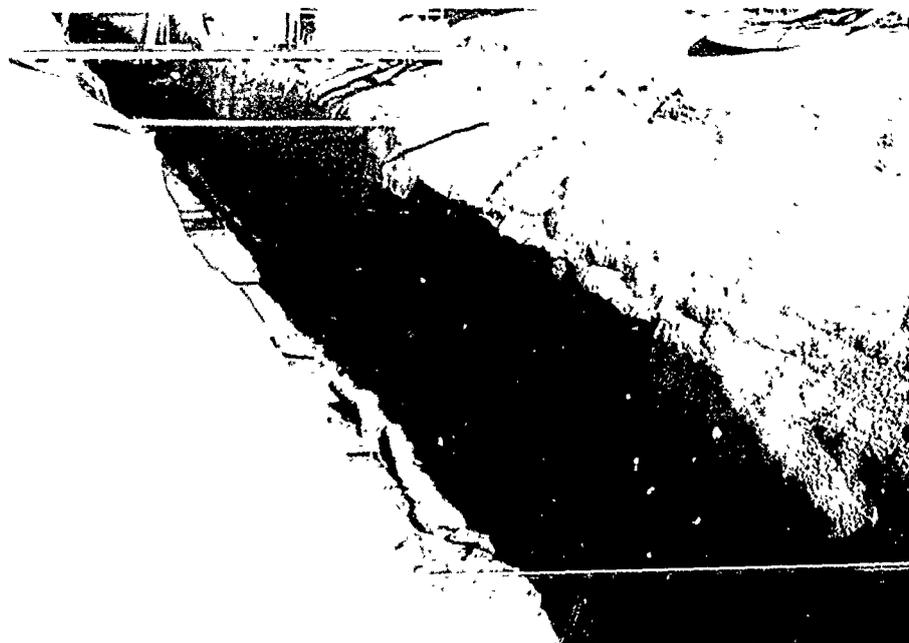


Figure 46. Same as above.

instructed to clean loose and drummy rock by jackhammer and to make final cleanup with compressed air before placement of concrete.

h. **Safety Protection Against Slides and Rock Falls.** Slopes excavated to design grade were generally not steep enough to require special protection against slides and rock falls.

5. **PILE DRIVING AND SPECIAL FOUNDATIONS.** No special foundations, such as driven piles, caissons, or drilled piers were utilized.

6. **TUNNELS, SHAFTS, AND UNDERGROUND STRUCTURES.** The construction of this project did not include any tunnel shafts or underground structures.

7. **FOUNDATION ANCHOR TEST.** A foundation anchor test was performed 4 April 1983 at Station 34+93.5, 5 feet west of outlet works centerline. See Figures 47 through 50. The surface elevation was 531.3. The test was performed in the chute foundation area on a 12-foot anchor with test results shown on pages 19 and 20.

8. **CHARACTER OF FOUNDATION.**

a. **General.** The limited service spillway is founded in weathered clay shale of the Pawpaw Formation of Lower Cretaceous age. The outlet works conduit, chute, and stilling basin are founded on unweathered clay shale of the Pawpaw Formation. Except for the left abutment, the inspection trench was almost entirely in overburden with clays and silty clays predominating. The Woodbine Formation, the basal formation of the Upper Cretaceous, was exposed in the inspection trench in the left abutment. It consists of weathered reddish-brown sands, clays,



Figure 47. Pullout test. Stilling Basin.

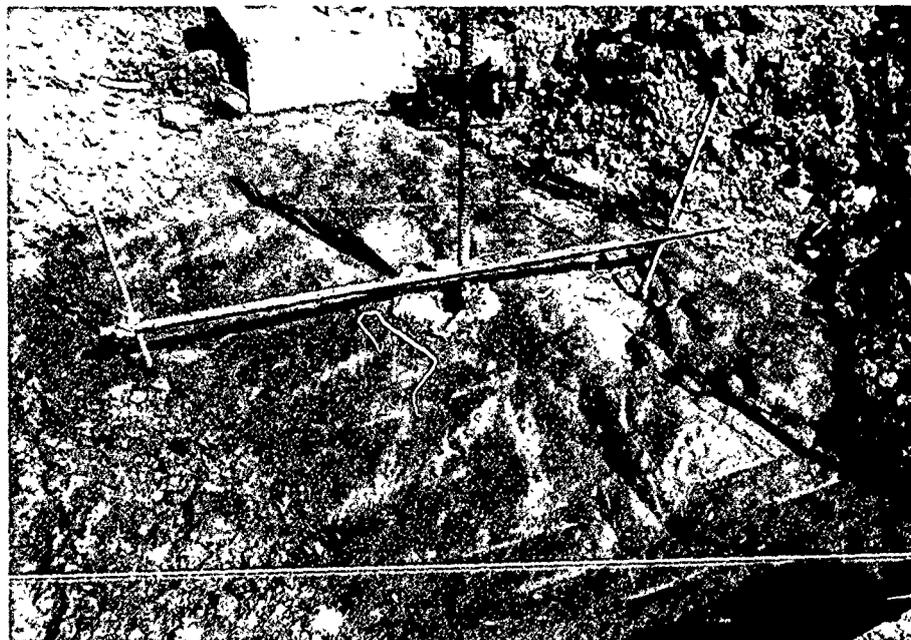


Figure 48. Same as above

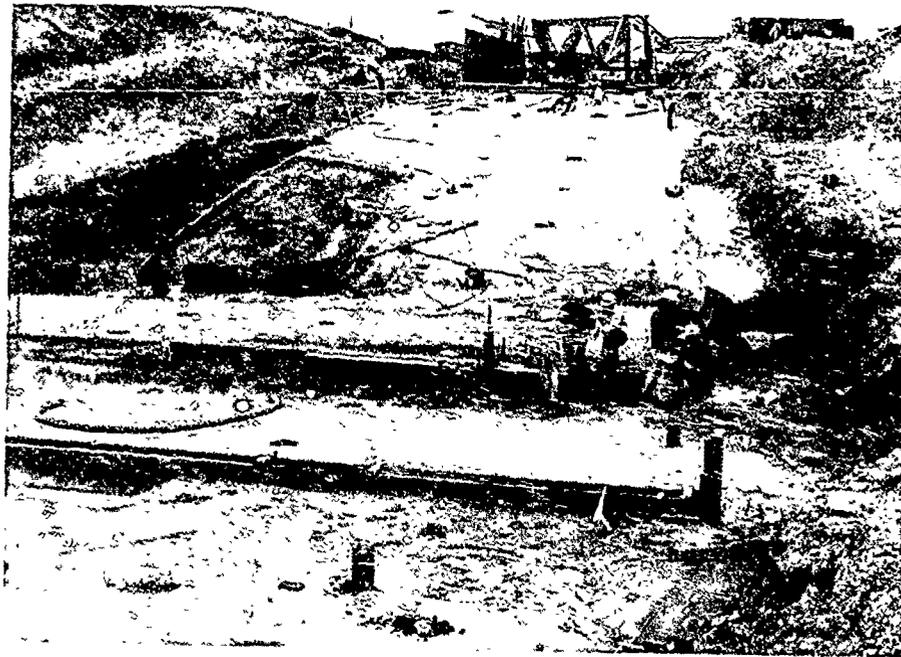


Figure 49. Pullout test. Stilling basin.



Figure 50. Same as above.

TEST NO. 1

<u>Time</u>	<u>Load In Tons</u>	<u>PSI</u>	<u>Deflection In Inches</u>
1044	0	0	.000
1044	5	930	.017
1049	5	930	.017
1050	12.7	2350	.026
1105	12.7	2350	.026
1105	17.7	3150	.035
1110	22.7		.046
1115	22.7		.046
1115	27.7		.059
1120	Stopped test - sag in "I" beam causing deflection in anchor bar.		

TEST NO. 2

<u>Time</u>	<u>Load In Tons</u>	<u>PSI</u>	<u>Deflection In Inches</u>
1137	5	930	.003
1142	5	930	.003
1142	12.7	2350	.015
1157	12.7	2350	.016
1157	17.7	3150	.023
1201	17.7	3150	.023
1201	22.7	4050	.034
1207	22.7	4050	.034
1207	27.7	4950	.045
1212	27.7	4950	.046
1212	32.7	5850	.060
1216	32.7	5850	.067
1216	36.0	6600	.075
1221	36.0	6600	.085
1222	32.7	5850	.085
1226	32.7	5850	.085
1226	27.7	4950	.078
1231	27.7	4950	.077
1231	22.7	4050	.068
1236	22.7	4050	.068
1236	17.7	3150	.057
1241	17.7	3150	.057
1241	12.7	2350	.043
1246	12.7	2350	.043

TEST NO. 2
(cont'd)

<u>Time</u>	<u>Load In Tons</u>	<u>PSI</u>	<u>Deflection In Inches</u>
1246	5	930	.018
1251	5	930	.018
1251	0	0	.000
1300	0	0	.000
1300	5	930	-.012
1305	5	930	-.012
1305	12.7	2350	.000
1310	0	0	.000
1310	5	930	-.006
1315	5	930	.000
Bar deflecting downward and horizontal under initial load.			
1320	5	930	.000
1320	12.7	2350	.016
1335	12.7	2350	.016
1335	5	930	.003
1340	5	930	.003
1340	0	0	-.006
1341	5	930	.001
1346	5	930	.001
1346	10	1820	.011
1351	10	1820	.011
1351	15	2750	.021
1356	15	2750	.023
1356	20	3650	.038
1401	20	3650	.038
1401	25	4550	.049
1406	25	4550	.050
1406	30	5450	.064
1411	30	5450	.064
1411	35	6300	.078
1416	35	6300	.083
1416	40	7200	.107
1421	40	7200	.109

Stop Test

and sandstones ranging from soft and friable to moderately hard.

b. **Character of Overburden Materials.** Overburden materials comprise the foundation for the embankment, in the outlet works approach and discharge channels, and in the approach and discharge channels for the spillway. Overburden materials exposed in the inspection trench and cutoff trench consist of alluvial clays, silts, sands, and gravels in the floodplain between Stations 105+00 and 136+00, and residual overburden on the abutments. Residual overburden consisting of clay and silty clay was exposed in the approach and discharge channels for the spillway. The outlet works approach and discharge channels were excavated in fluvial terrace and floodplain alluvial materials consisting of clay, sand, silt, and gravel.

c. **Character of Primary Materials.** The Pawpaw Formation comprises much of the foundation and was exposed in the outlet works and the spillway excavation. The Pawpaw is relatively level and finished grade was often on or near bedding planes. See Figures 13, 16, and 18. In the outlet works foundation, the clay shale is generally soft to moderately hard, unweathered, gray to dark gray and thin to medium bedded with scattered sandy seams and occasional sandstone seams north of Station 27+00. South of station 27+00 the clay shale contains up to 50 percent fine-to-medium grained sandstone and sandy seams. The base of the sandy phase was encountered at elevation 523, Station 36+15 in the chute foundation. A 2- to 3-inch thick fossiliferous zone was exposed near the base of the chute at elevation 520.0. Excavation,

cleaning of shale surfaces, and placement of fill are shown in Figures 51 through 64. The stilling basin foundation surface was described as shale, soft, slightly sandy with occasional sandy pockets and zones, fossiliferous, gray. See Figures 63 and 64.

The sill foundation for the limited use spillway was excavated down to a sandy, stiff, yellowish-brown to light gray clay, underlain by about 3 feet of gravelly clay. The edges and narrow sections in the middle, horizontal part of the foundation were keyed into weathered shale of the Pawpaw Formation. The approach and discharge channels were excavated in sandy clay. See Figures 27, 28, and 29.

9. FOUNDATION TREATMENT. No grouting was necessary at the project and no dental concrete or broom grouting were utilized.

10. FOUNDATION INSTRUMENTATION.

a. General. The instrumentation program at Ray Roberts Dam was designed to monitor five basic areas which are discussed below. A plan of instrumentation is shown on Plate 57. The following descriptions are taken from "Periodic Inspection No. 1, Ray Roberts Lake, July 1987."

(1) Initial Embankment and Closure Section. Nineteen piezometers were installed to monitor pore pressure development in the floodplain foundation during construction of the initial embankment and closure section. Settlement gages (12 deep settlement plates and 3 foundation surface settlement plates) were installed to monitor vertical movement of the foundation in the floodplain, and 8 surface

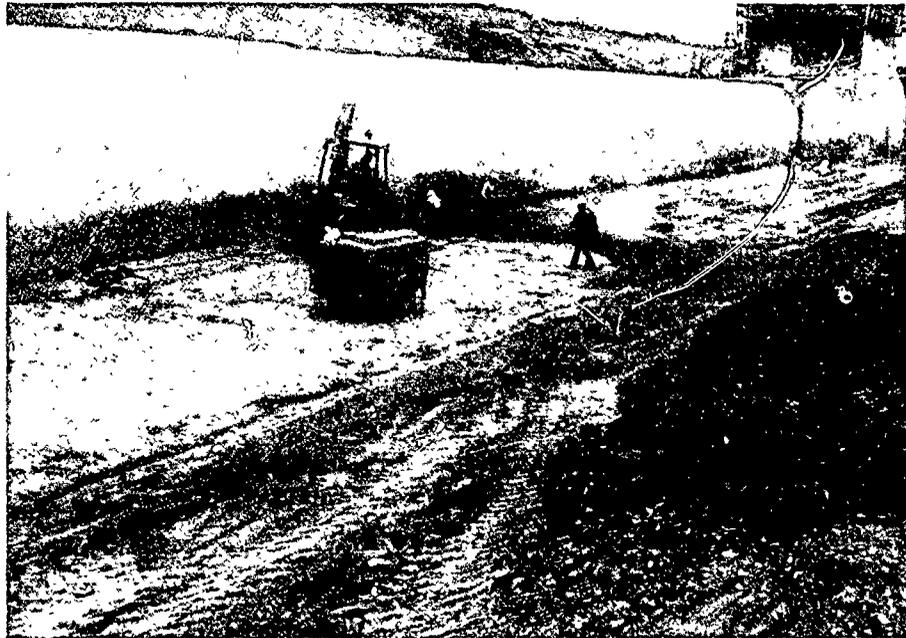


Figure 51. Outlet works, left side looking upstream. Fresh shale surface prior to placement of impervious material.



Figure 52. Same as above.

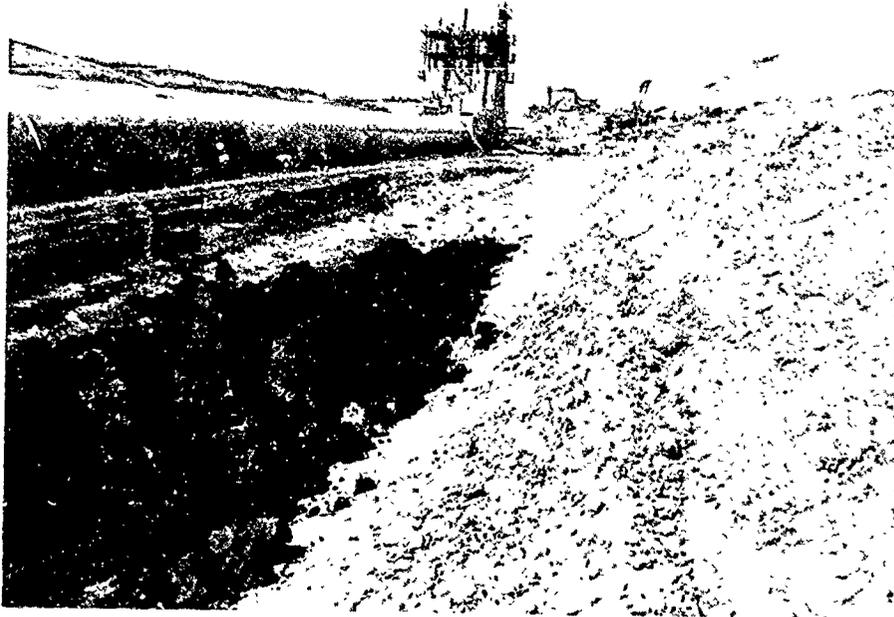


Figure 53. Outlet works conduit, left side, looking upstream. Placing fill on fresh shale surface.



Figure 54. Outlet works conduit, right side, looking upstream. Fresh shale adjacent to conduit.



Figure 55. Outlet works excavation, right side looking downstream. Placing fill on fresh shale surface.



Figure 56. Outlet works, right side, looking upstream. Fresh shale surface.



Figure 57. Outlet works, right side looking upstream. Cleaning shale surface in increments prior to placement of fill.

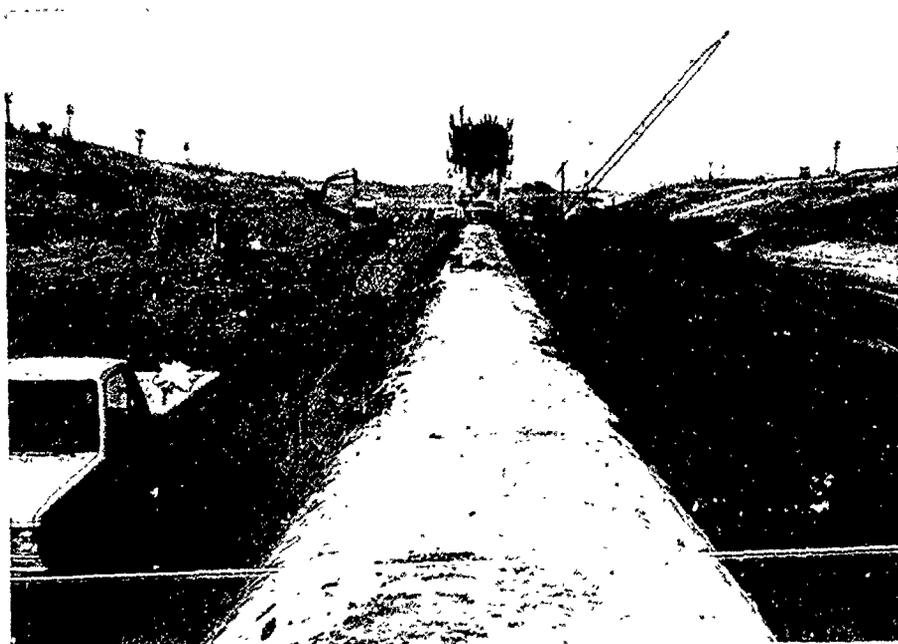


Figure 58. Outlets works conduit, looking upstream.



Figure 59. Outlet works looking downstream from tower.



Figure 60. Same as above.



Figure 61. Outlet works, right side, looking downstream. Cleaning shale surface prior to placement of fill.



Figure 62. Same area as above.



Figure 63. Stilling basin. Spraying aerospray.



Figure 64. Excavation for discharge from valve vault.

reference marks were provided to monitor embankment movement. Twelve inclinometers were installed to measure lateral displacement of the foundation during construction of the initial embankment and closure section. Of primary concern in planning the instrumentation program was the performance of the initial embankment which was designed to preload and consolidate the floodplain soils.

(2) **Left Abutment.** Nine piezometers were installed to monitor potential seepage effects at the left abutment (the upper portion of the abutment consists of pervious strata) including uplift pressures acting on the downstream portion of the embankment.

(3) **Embankment Underseepage.** Twenty-six seepage piezometers were installed in the embankment foundation to monitor underseepage.

(4) **Outlet Works.** To monitor movement of the outlet work structure, reference pins were installed within the conduit, on the stilling basin walls, and on the service bridge.

(5) **Embankment Crest.** A set of embankment station monuments has been installed along the downstream side of the crest to monitor post-construction settlement.

b. **Schedule of Instrumentation Reading.** Instrumentation located at the project will be read by CESWF-ED-G personnel according to the following schedule, or more frequently, if deemed necessary.

- o Piezometers - quarterly
- o Inclinometers - annually
- o Seepage Interceptor - monthly and when pool reaches 580, 590, 600, and 632.5

- o Settlement Gages - quarterly and when pool reaches 580, 590, 600, and 632.5
- o Outlet Works Reference Pins - semiannually
- o Embankment Reference Marks - quarterly

c. **Settlement Plates and Deep Settlement Plates.** Settlement Plates SP-1 through SP-3, and deep settlement Plates DSP-1 through DSP-12 were installed in the floodplain foundation prior to and during initial embankment construction to monitor foundation settlement. Settlement plates consist of a 36-inch square, $\frac{1}{4}$ -inch thick steel plate placed within the foundation materials and welded to a steel riser pipe extended through the embankment fill.

d. **Inclinometers.** I-1 through I-12 were installed within the floodplain embankment foundation prior to construction of the initial embankment to monitor horizontal deflection within the foundation. To provide a fixed frame of reference, all inclinometers were anchored in the primary clay shale. Inclinometers consist of a 3.34-inch diameter grooved ABS casing manufactured by Slope Indicator Company, Seattle Washington. Inclinometers were extended through the fill and steel casing.

e. **Piezometers.** Piezometers P-1 through P-43b have been installed within the embankment foundation materials to monitor foundation performance during construction and after impoundment. Open system piezometers utilizing porous plastic tips as manufactured by Slope Indicator Company, Seattle Washington, were installed using 3/8-inch diameter PVC risers and extended through the fill with steel casing.

Piezometers P-1 through P-19 were installed within the floodplain embankment foundation prior to construction of the initial embankment to monitor excess pore pressure development during construction. After embankment completion, piezometers P-20 through P-36 were installed on the downstream toe and slope within the sands and gravels overlying the shale. Piezometers P-37 through P-43b were installed after embankment completion, within the sandy abutment materials. All Piezometers (P-20 through P-43b) will monitor seepage within the foundation materials during and after reservoir filling.

f. **Surface Reference Marks.** Reference marks consisting of a brass monument, set into a 6-inch diameter pipe filled with concrete, were installed within the floodplain embankment to a depth of 5 feet to monitor vertical movement.

g. **Reference Pins.** Reference pins were installed along the outlet works conduit invert, stilling basin monolith walls, and service bridge. Reference pins which consist of bronze bolts embedded in concrete are used to monitor vertical movement of the monolith or slabs, and relative movement between monoliths or slabs.

h. **Seepage Interceptor System.** A seepage interceptor system has been installed within the left abutment embankment foundation to collect underseepage. The discharge is currently being monitored to record the normal ground-water flow. Flow from the system will be monitored, along with piezometers P-37 through P-43b, during impoundment when the pool reaches elevation 580, 590, 600, 620, and 632.5.

11. POSSIBLE FUTURE PROBLEMS. At the time foundations were approved and the dam completed in October 1986, no potential for future problems was apparent. The first periodic inspection was performed in July 1987. By that time several minor skin slides had occurred in the spillway approach channel slope. It was concluded that this problem could be easily remedied. Other minor problems are addressed in "Periodic Inspection Report No. 1, July 1987." The dam is considered to be in good general condition.

12. RECORD OF FOUNDATION APPROVAL. A record of the date when each section of the outlet works foundation was approved is shown on Plate 58. Records of approval of final foundation grades were kept for all foundations on which concrete was to be placed. The foundation for the emergency spillway was approved as a unit on 11 February 1984.



Figure 65. Outlet works, right side looking downstream. Cleaning shale surface in increments prior to placement of fill.



Figure 66. Placing fill.



Figure 67. Outlet works. Placing fill.



Figure 68. Outlet works backfill, looking downstream.



Figure 69. Excavation for valve vault.

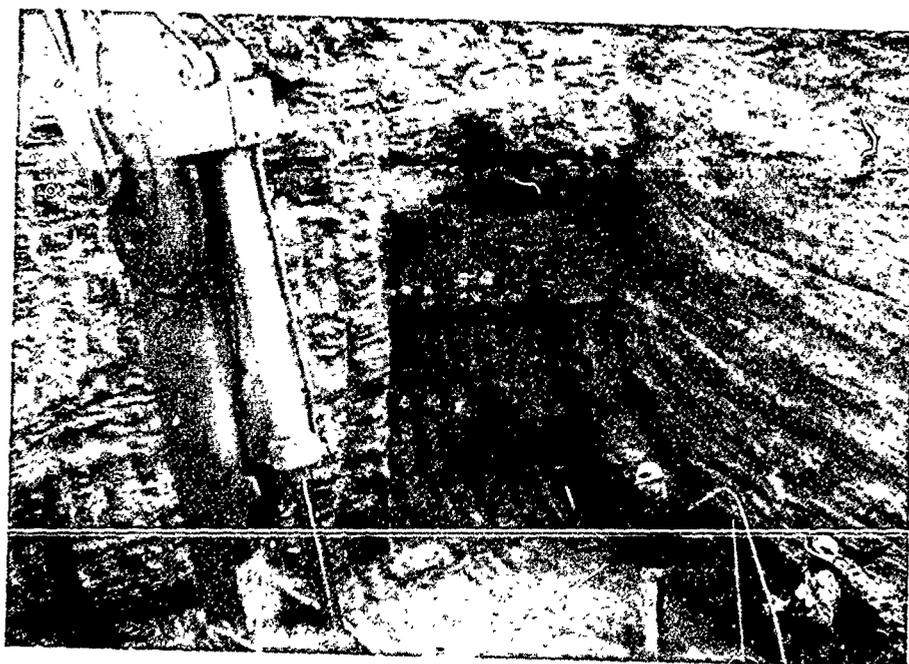


Figure 70. Same as above.

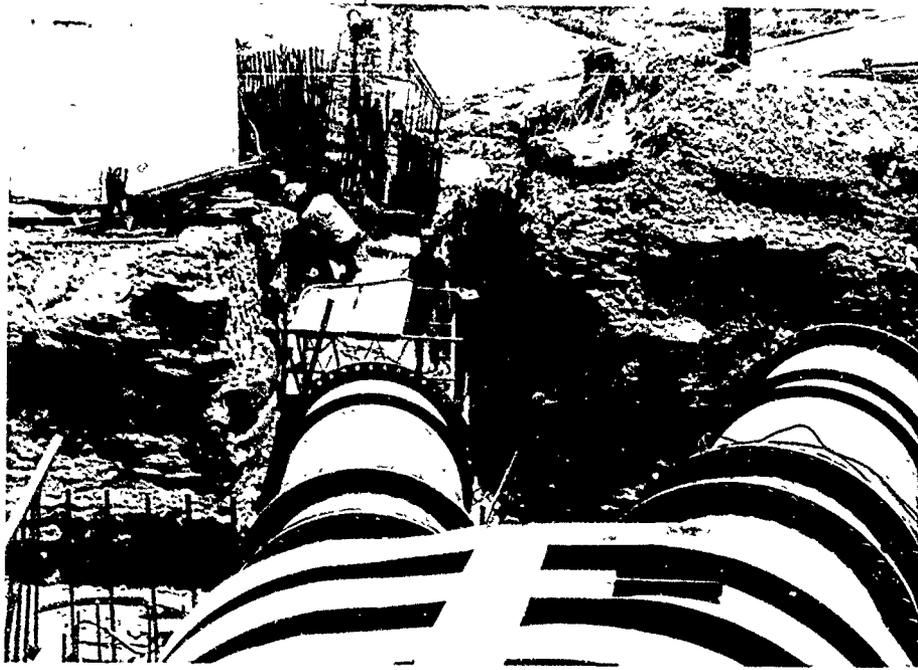


Figure 71. Discharge pipes from valve vault.



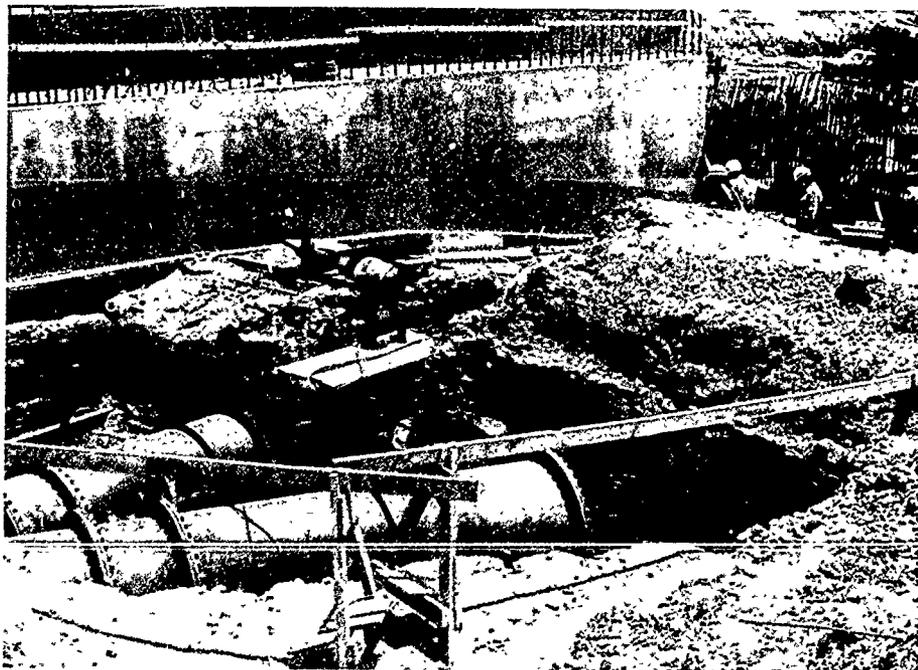


Figure 72. Same as above.

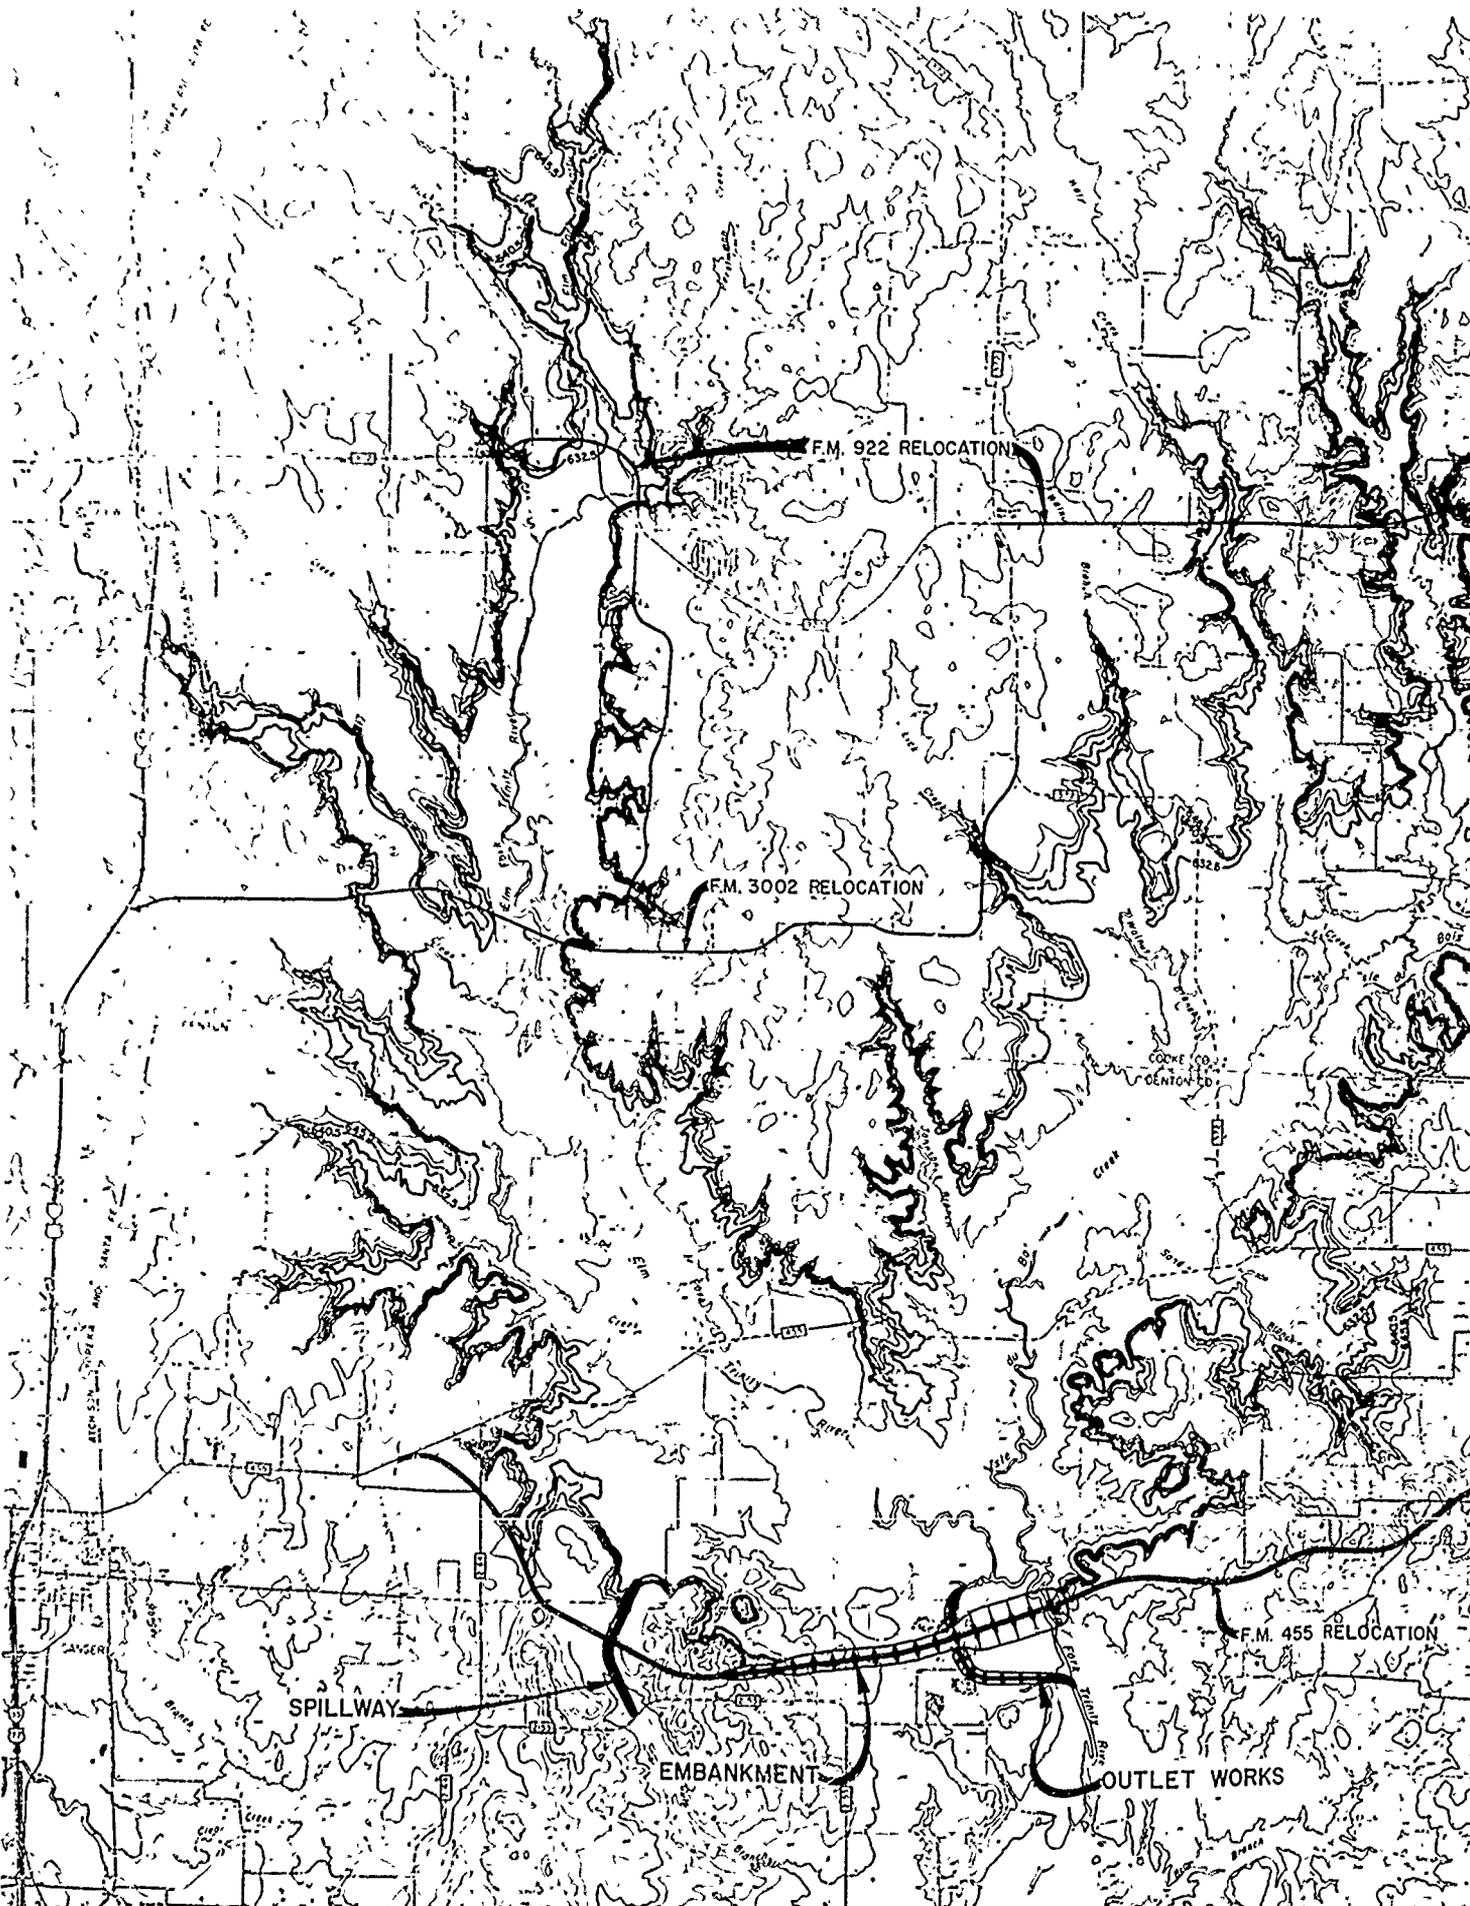


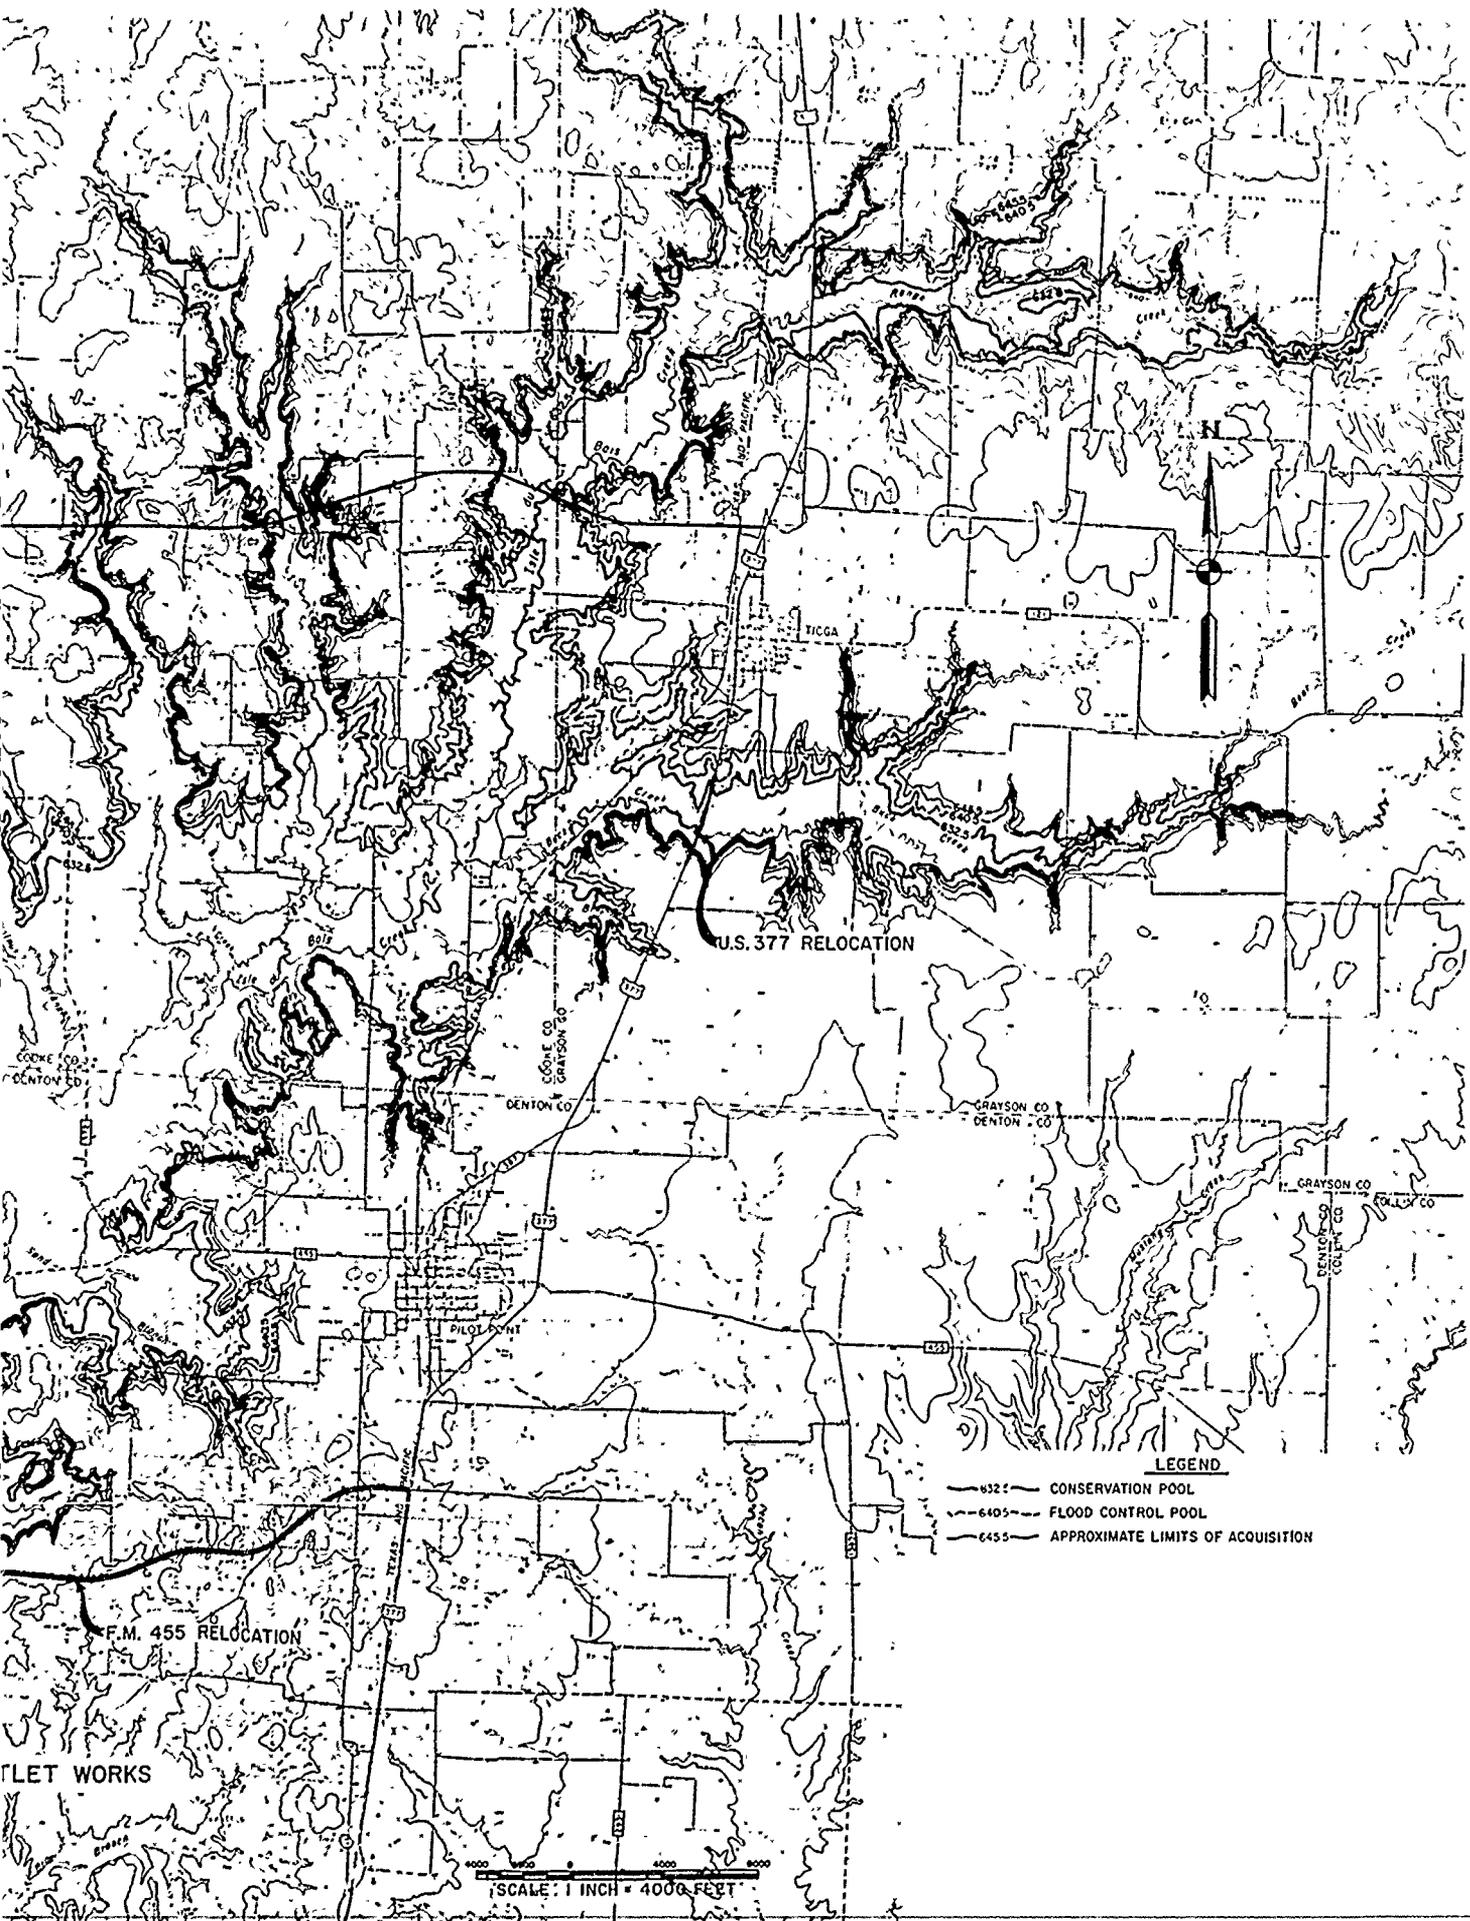


U.S. 377 RELOCATION

LEGEND

- 6322 — CONSERVATION POOL
- 6405 — FLOOD CONTROL POOL
- 6455 — APPROXIMATE LIMITS OF ACQUISITION


SCALE: 1 INCH = 4000 FEET

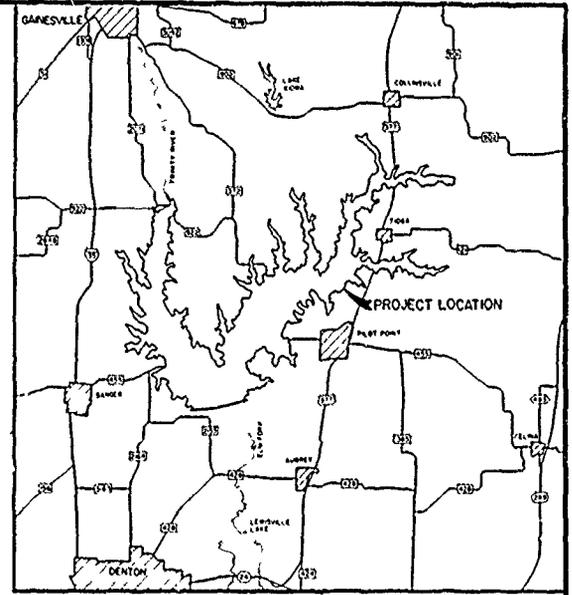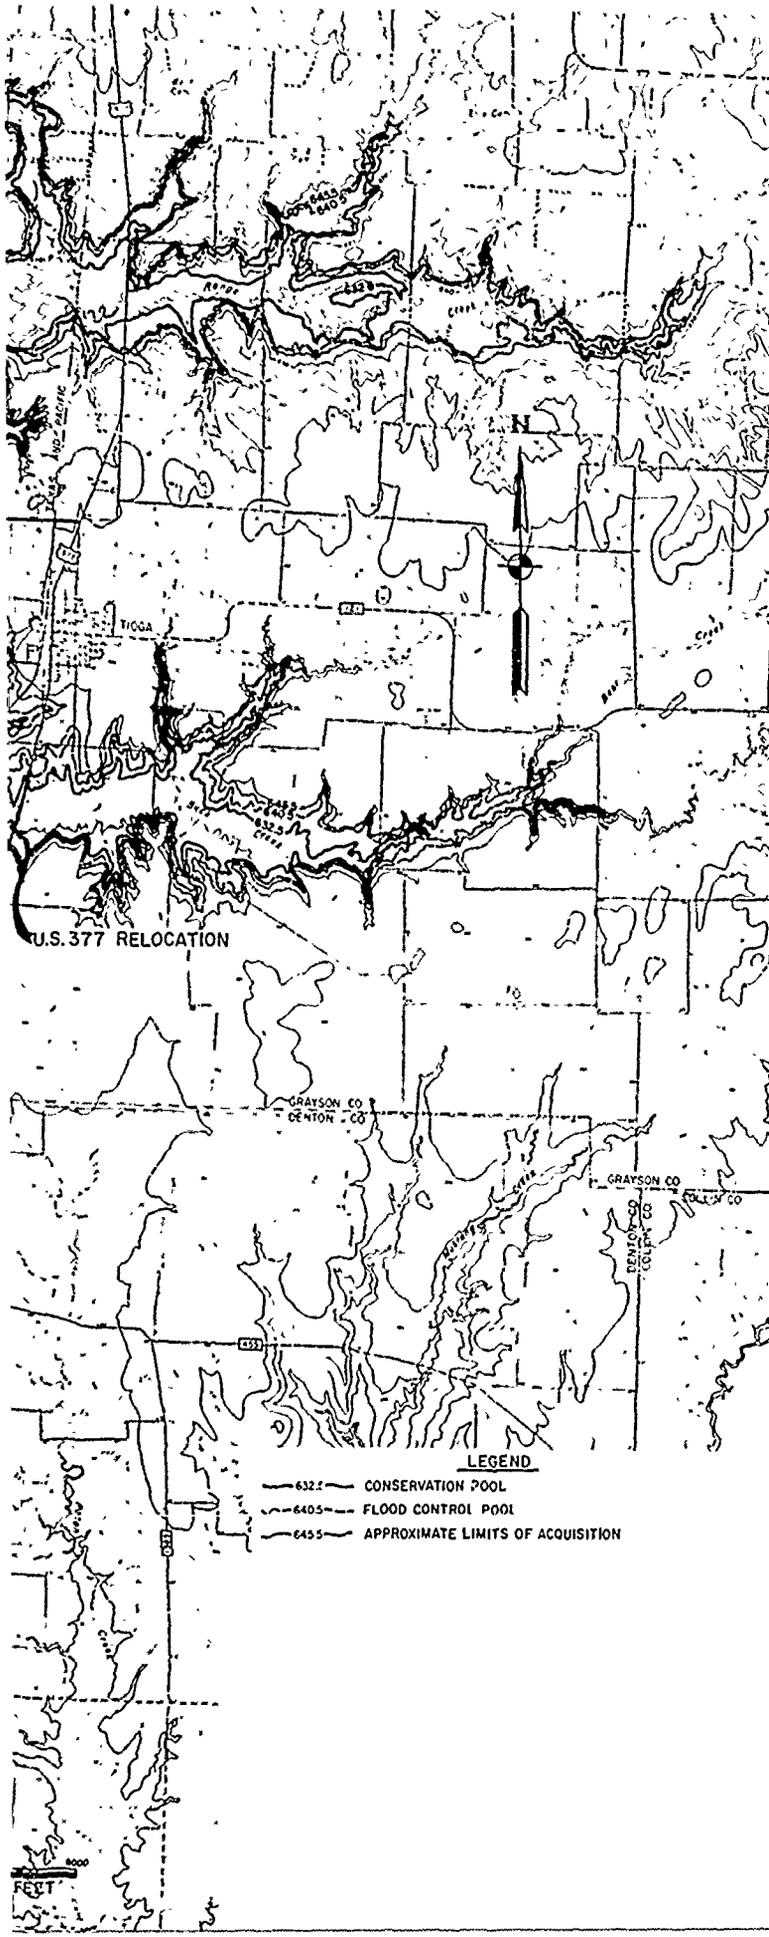


VICINITY MAP
SCALE: 1 INCH = 4 MILES APPROX.


SYM. OR. NO.	ACTION	DATE	DESCRIPTION OF REVISION
U.S. ARMY ENGINEER DISTRICT, FORT WORTH CORPS OF ENGINEERS FORT WORTH, TEXAS			
DESIGNED BY:	RAY ROBERTS LAKE ELM FORK, TRINITY RIVER, TEXAS FOUNDATION REPORT LAKE MAP AND VICINITY MAP		
DRAWN BY:			
REVIEWED BY:			
SUBMITTED BY:	INVITATION NO.	DATE:	
	CONTRACT NO.		

ATTACH 01

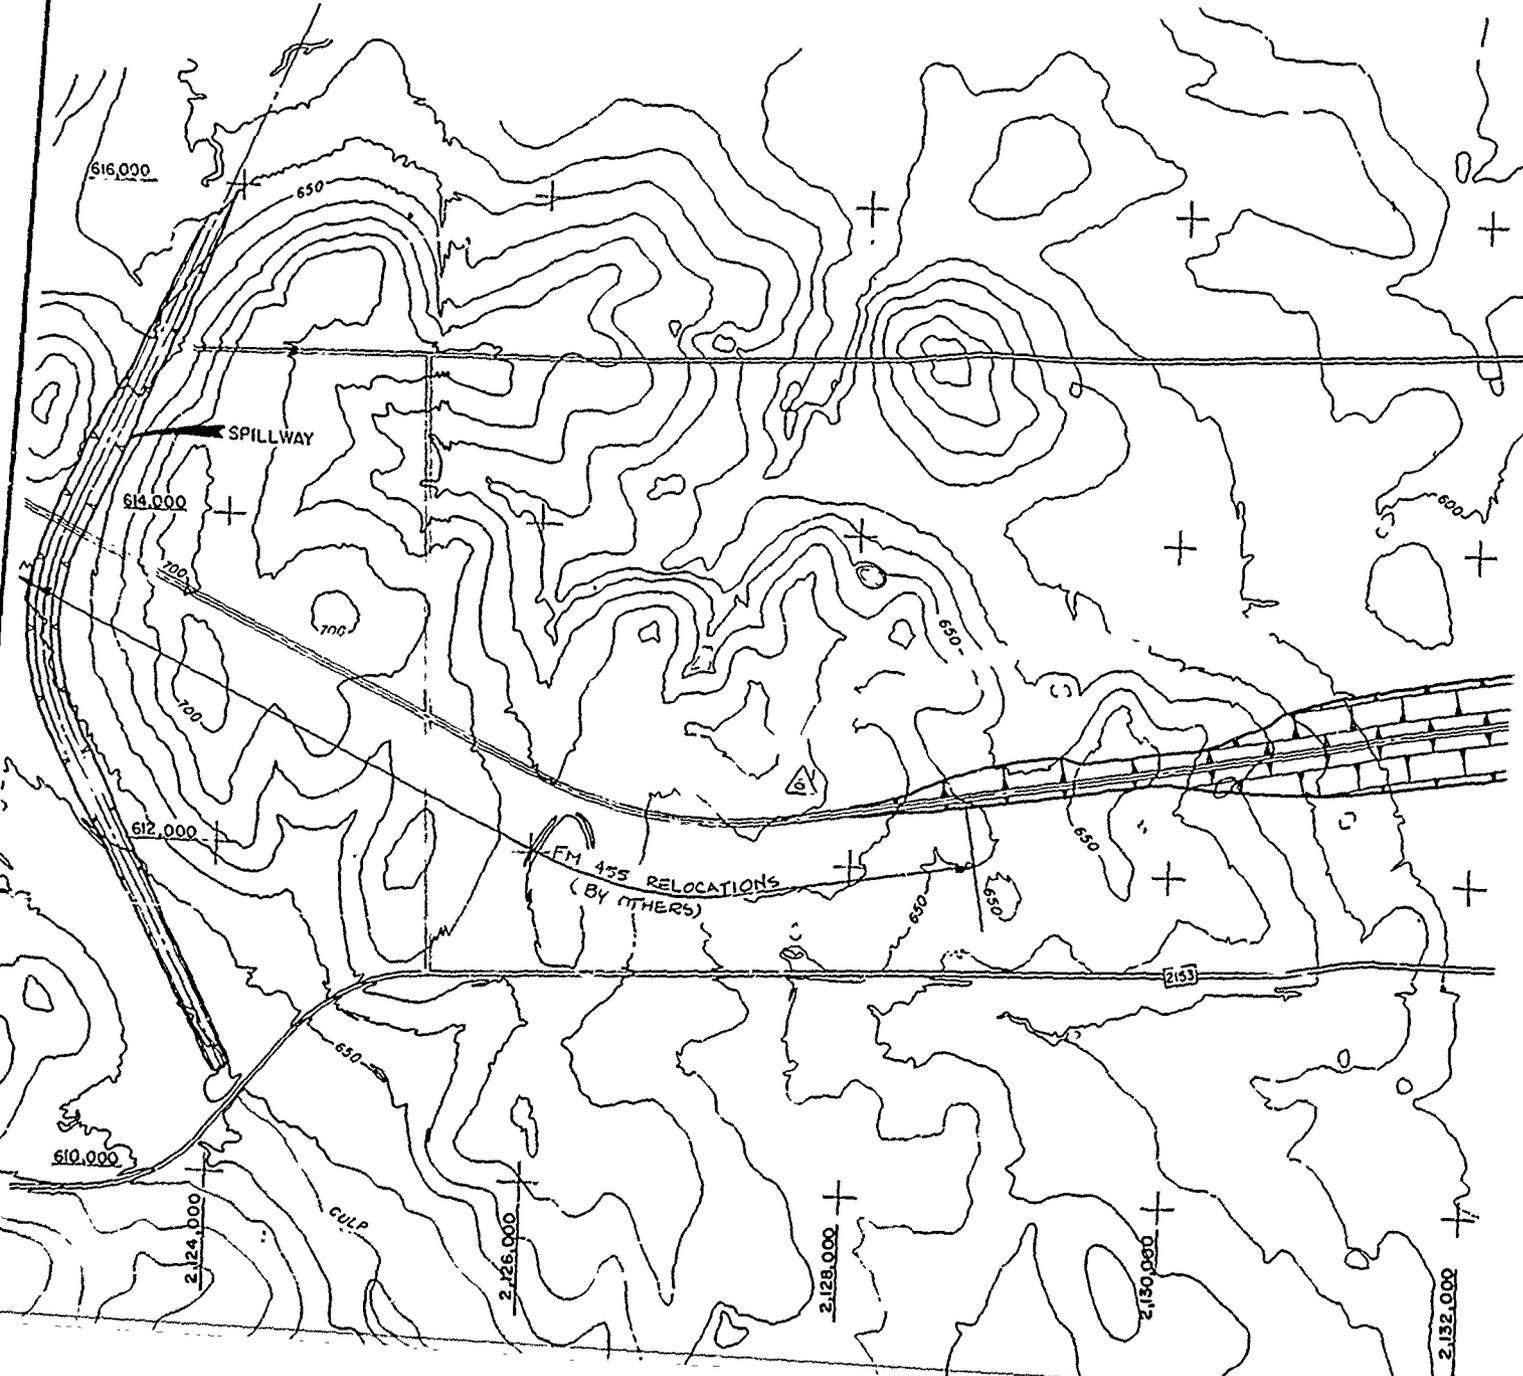

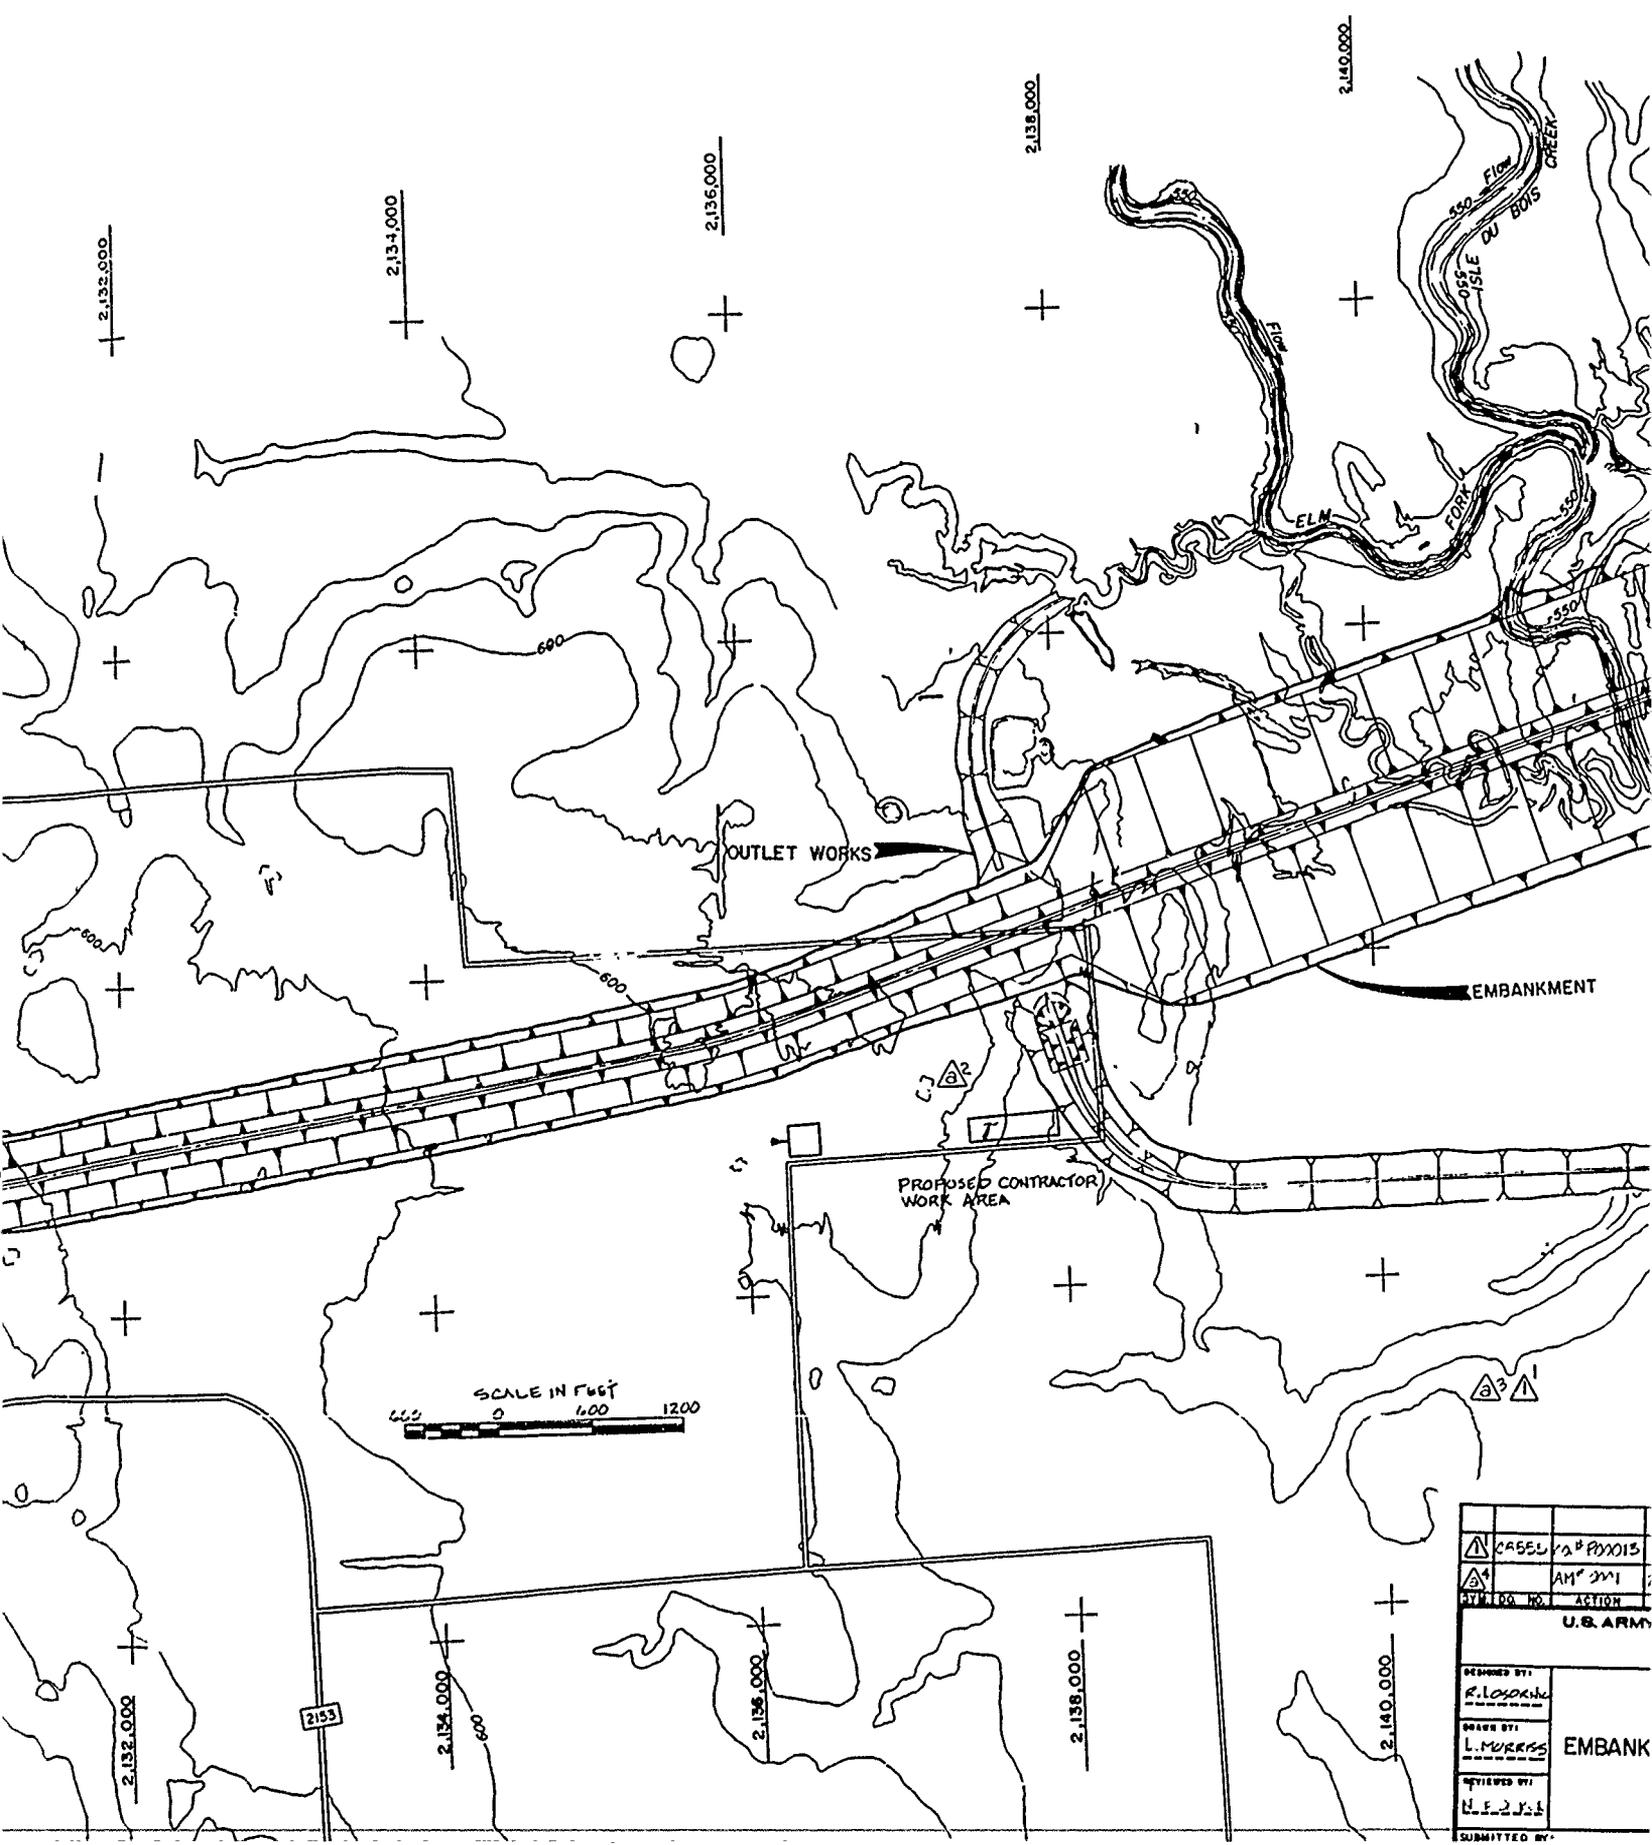

△	CASE NO. 2153
△	AM 211
△	ACTION
U.S. ARMY	
DESIGNED BY:	R. LOSORNE
DRAWN BY:	L. MURRES
APPROVED BY:	H. E. J. J.
SUBMITTED BY:	
EMBANK	

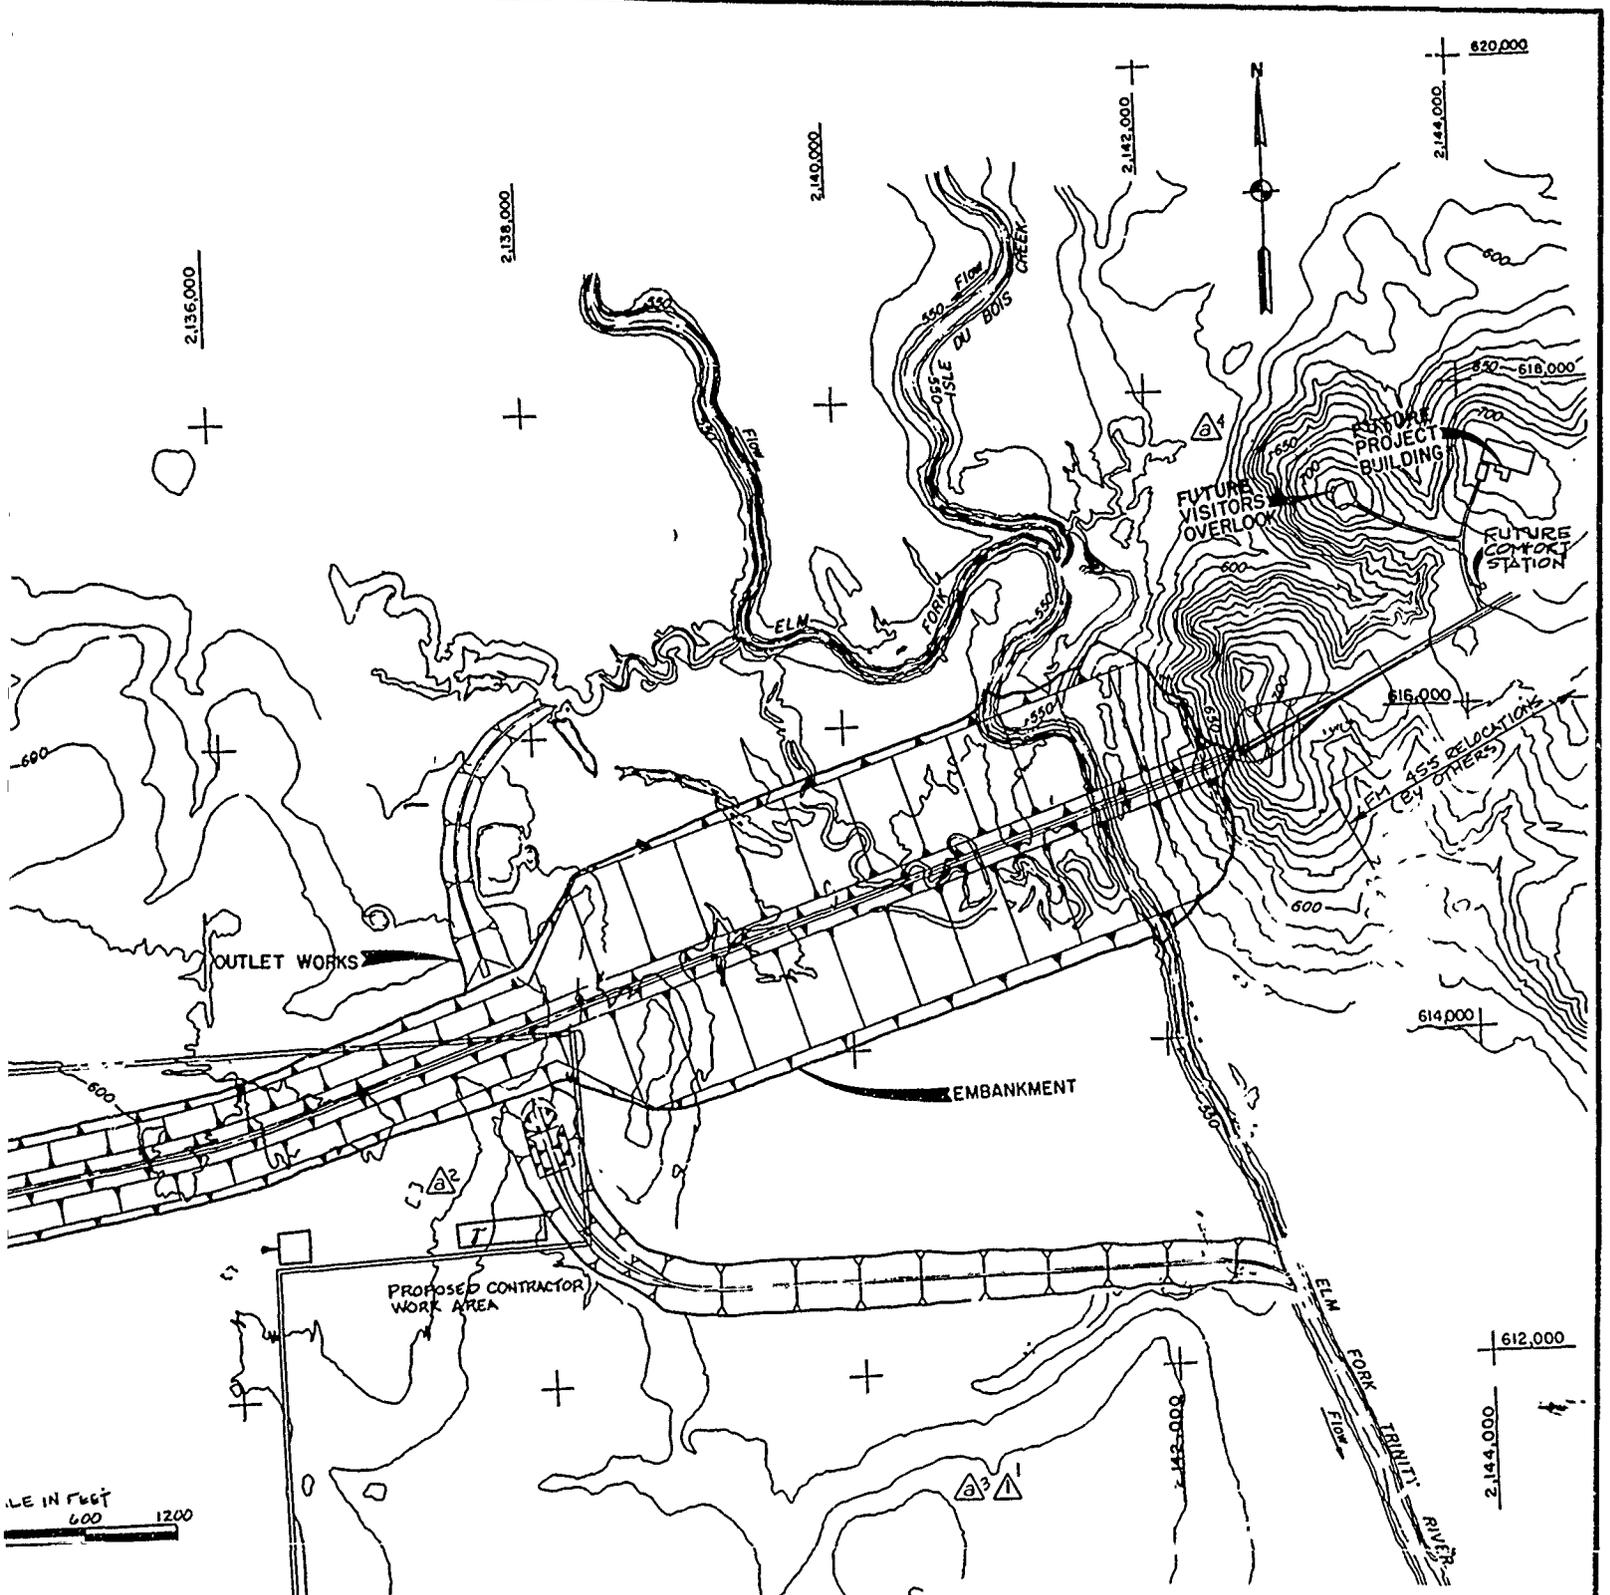

DESIGNED BY: R. LOSORNO	DATE: 10 FEB 84	REVISION: REVISED NOTE
DRAWN BY: L. MORRIS	DATE: 2 APR 82	REVISION: AUGDED NOTE & RELOCATED CONTRACTOR WORK AREA
CHECKED BY: L. F. J. J.	DATE:	REVISION:
SUBMITTED BY: L. F. J. J.	DATE:	REVISION:
U.S. ARMY ENGINEER DISTRICT, FORT WORTH CORPS OF ENGINEERS FORT WORTH, TEXAS		
RAY ROBERTS LAKE ELM FORK, TRINITY RIVER, TEXAS EMBANKMENT, SPILLWAY AND OUTLET WORKS GENERAL PLAN		
INVESTIGATION NO.:	DATE:	DATE:
CONTRACT NO.:	DATE:	DATE:


LEGEND

- 3F 3-INCH FISHTAIL BORING
- 8A 8-INCH AUGER BORING
- 3S 3-INCH SHELBY TUBE
- 4C 4-INCH CORE BORING
- 6C 6-INCH CORE BORING
- 6U 6-INCH DENISON BORING
- ==== COUNTY ROAD (GRAVEL)
- ==== FARM TO MARKET ROAD (PAVED)
- ⊗ GRAVEL PIT



- QAL ALLUVIUM
- QT FLUVIATILE TERRACE DEPOSIT
- KWB WOODBINE FORMATION
- KGY GRAYSON FORMATION
- KMS MAIN STREET FORMATION
- KPP PAWPAW FORMATION
- GEOLOGIC CONTACT (DASHED)
- ⊗ STOCK TANK

NOTES:

1. SEE PLATES III-6 THROUGH III-32 FOR DETAILED LOGS OF BORINGS.
2. GEOLOGY COMPILED FROM SUBSURFACE EXPLORATION AND SURFACE MAPPING.

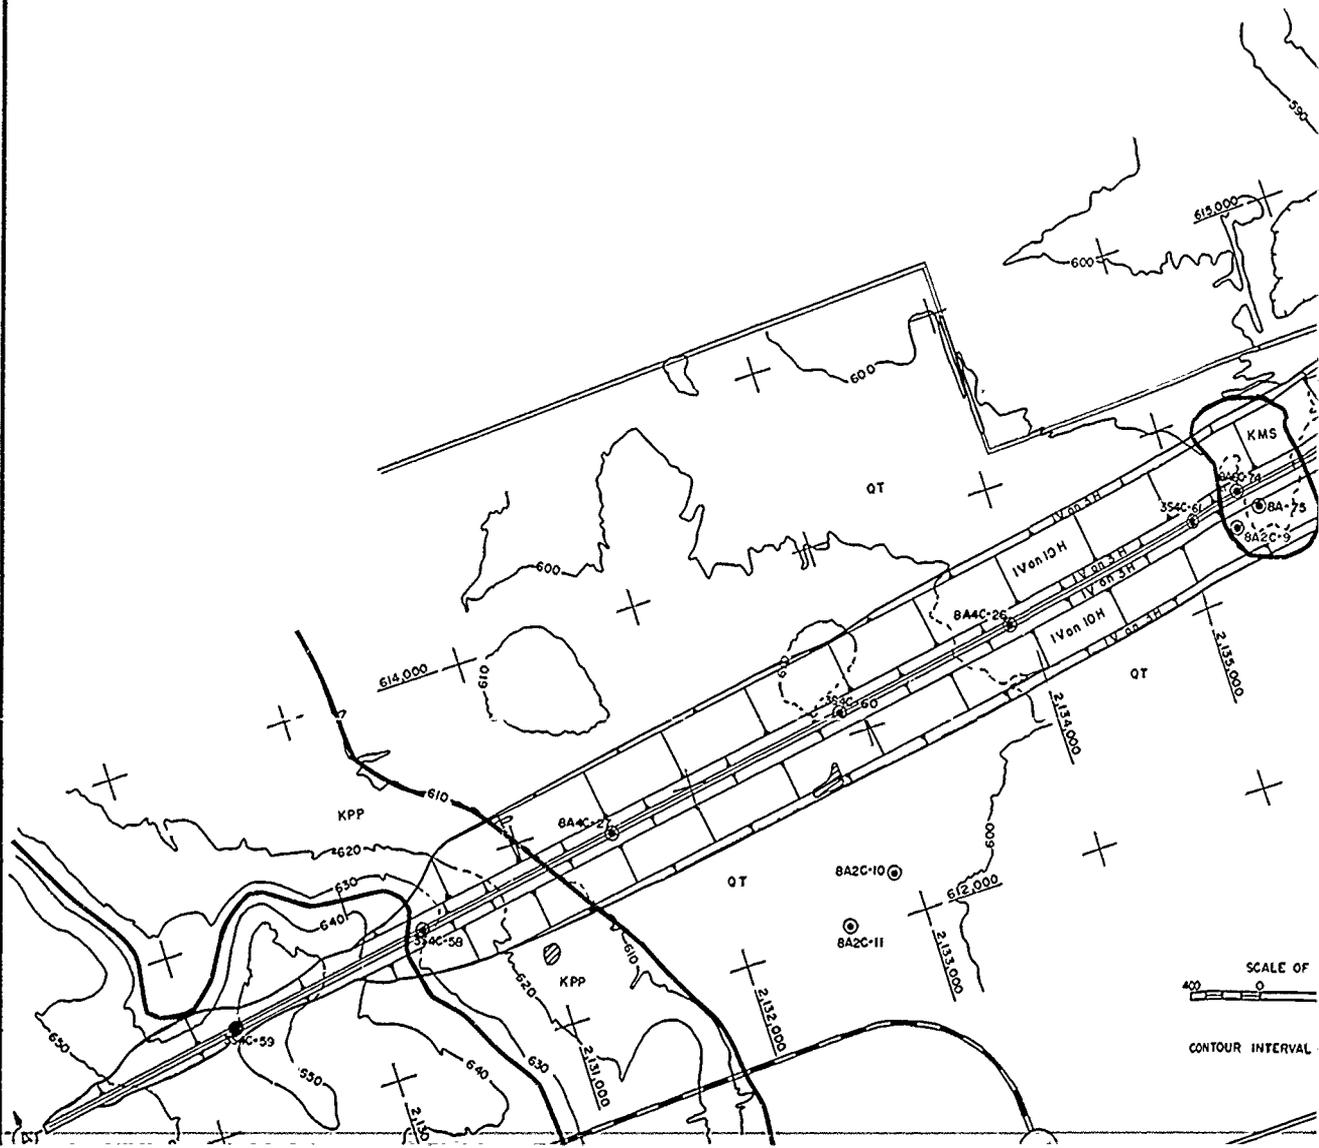



- ALLUVIUM
- FLUVIATILE TERRACE DEPOSIT
- WOODBINE FORMATION
- GRAYSON FORMATION
- MAIN STREET FORMATION
- PAWPAW FORMATION
- GEOLOGIC CONTACT (DASHED WHERE INFERRED)
- STOCK TANK

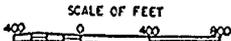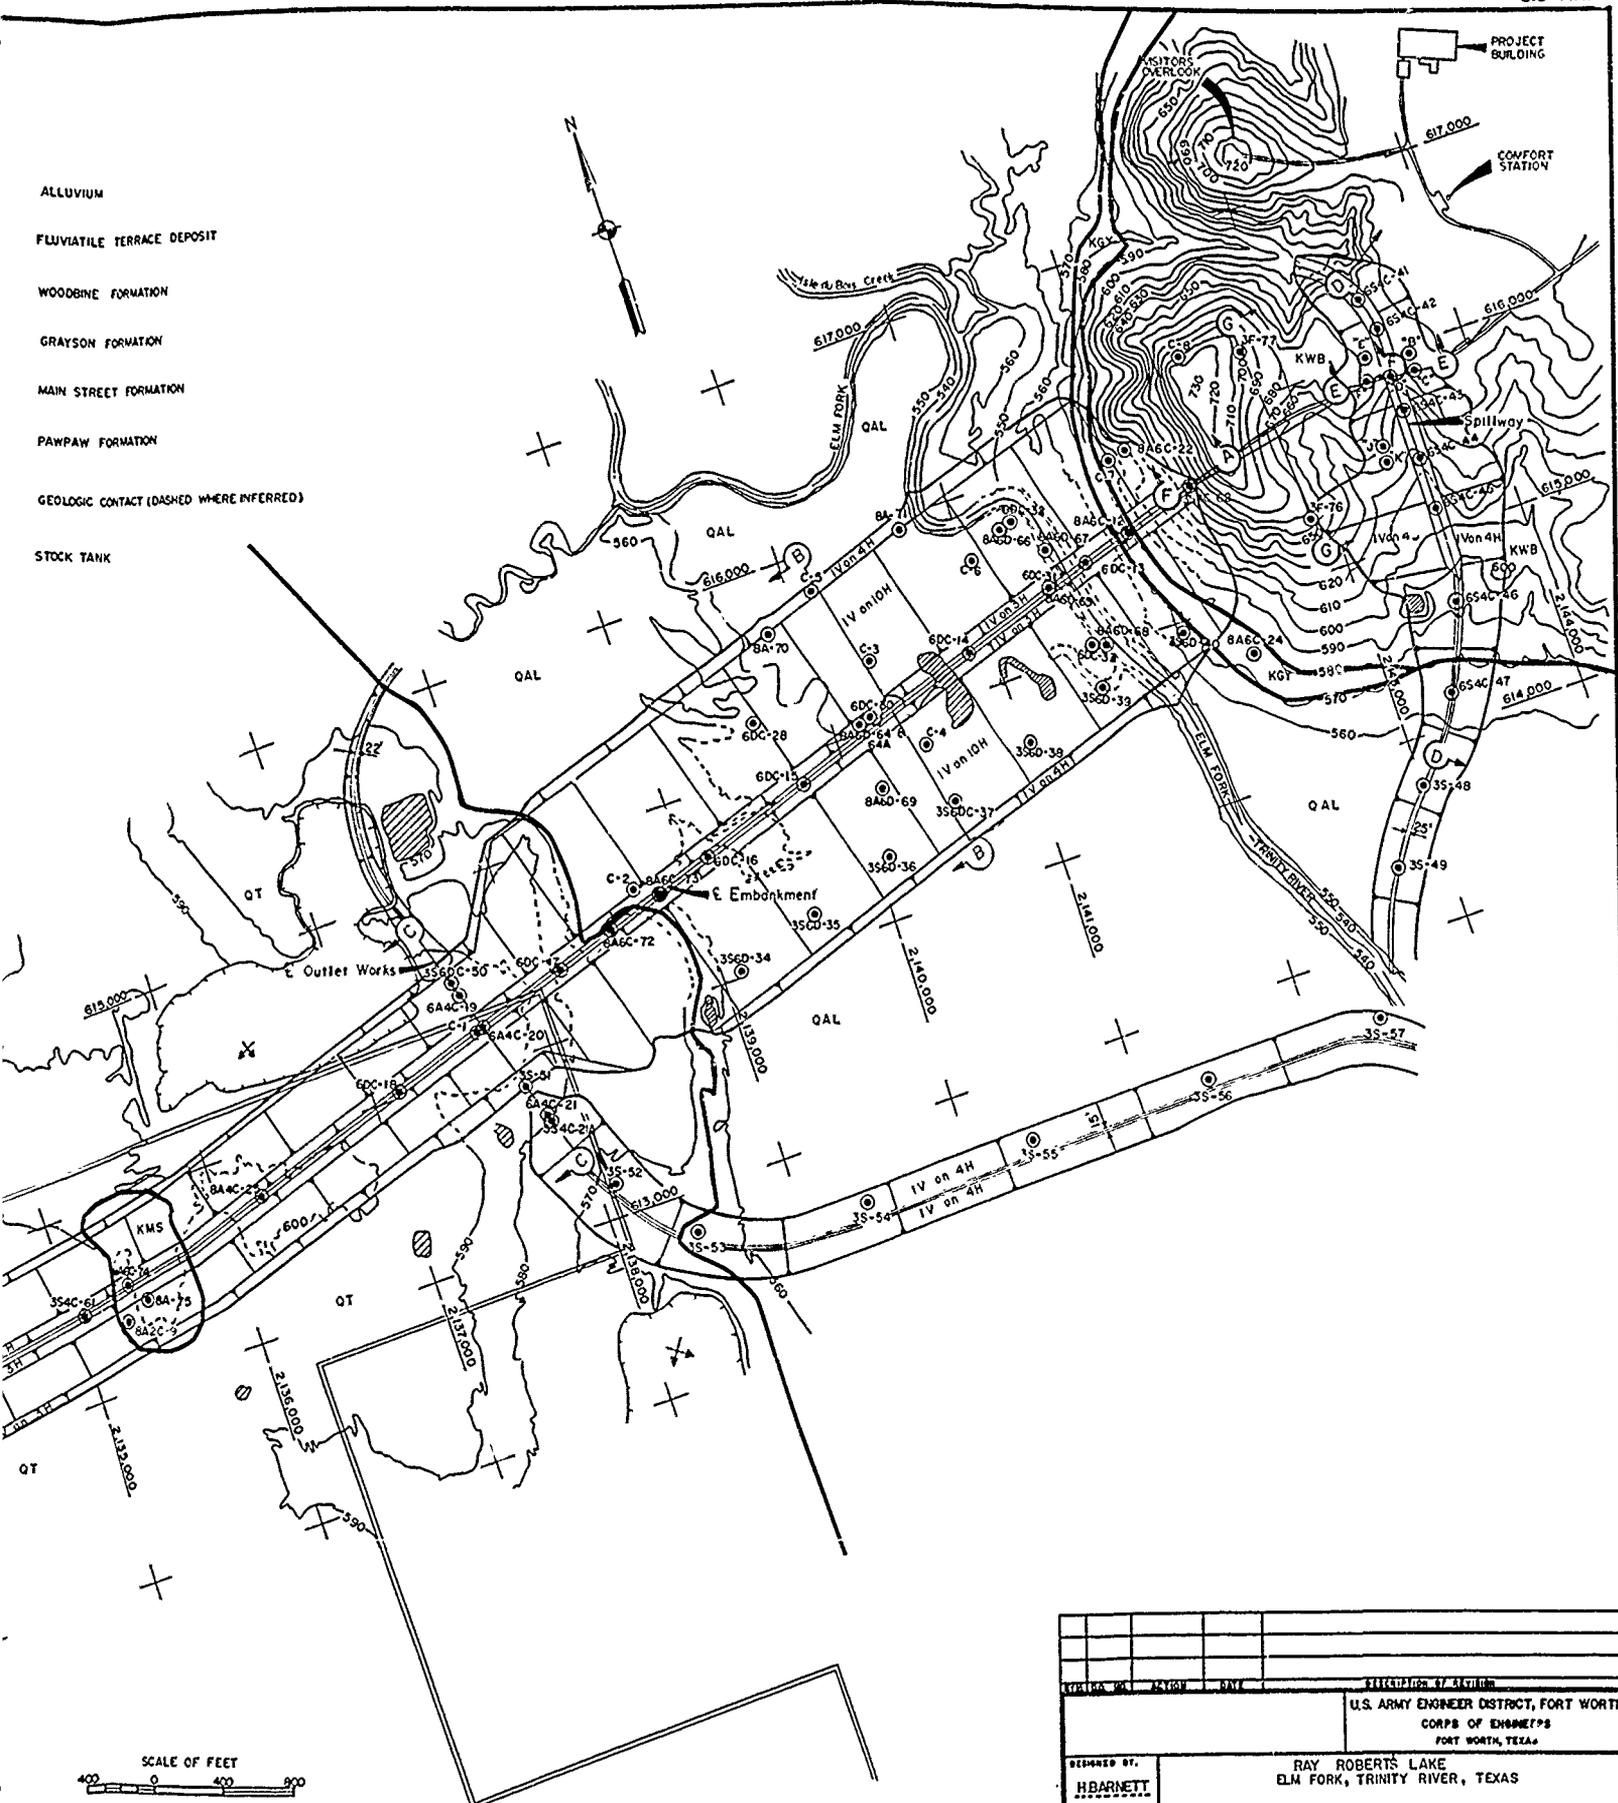


CONTOUR INTERVAL - 10 FEET


DESIGNED BY: H. BARNETT		RAY ROBERTS LAKE ELM FORK, TRINITY RIVER, TEXAS	
DRAWN BY: C. KIRBY		FOUNDATION REPORT	
REVIEWED BY: R. BEHM		DAM SITE GEOLOGY	
SUBMITTED BY: ROBERT C. BEHM		SOL. NO.	DATED:
		CONTR. NO.	REFERENCE NO.

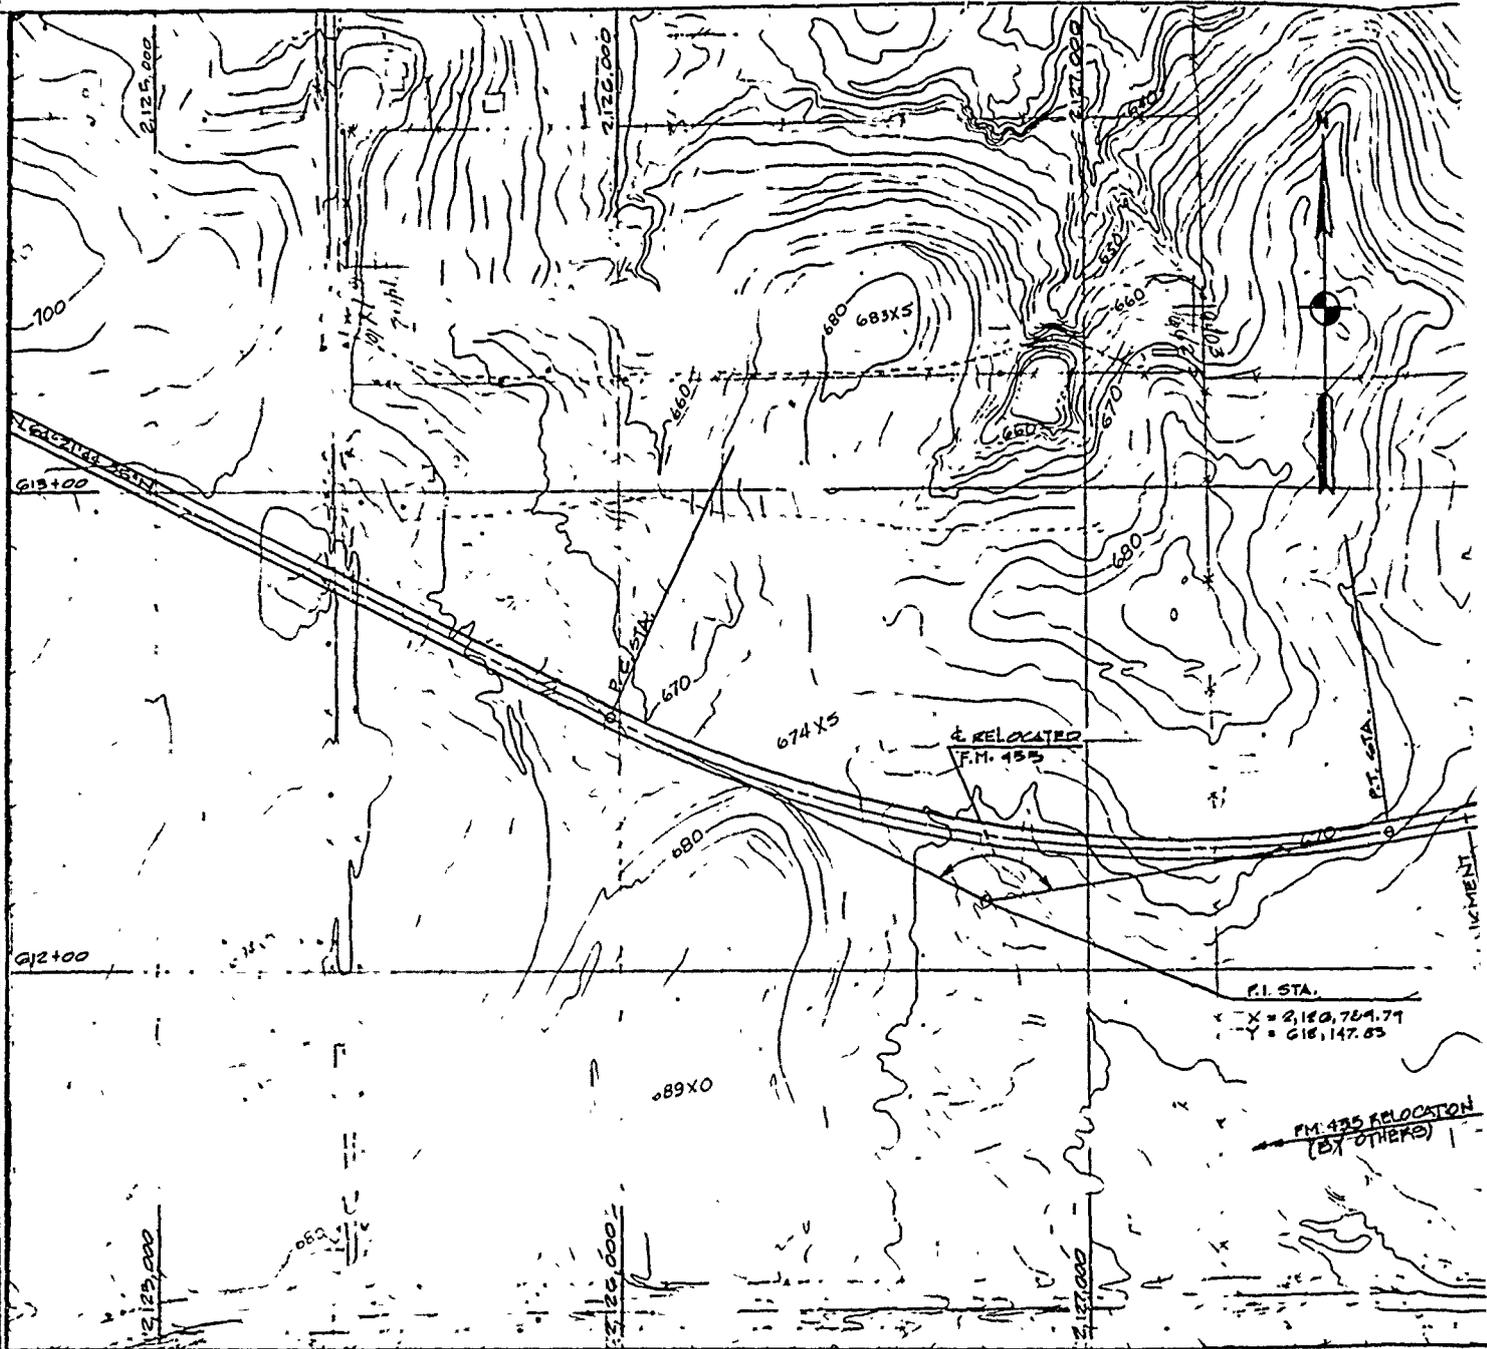

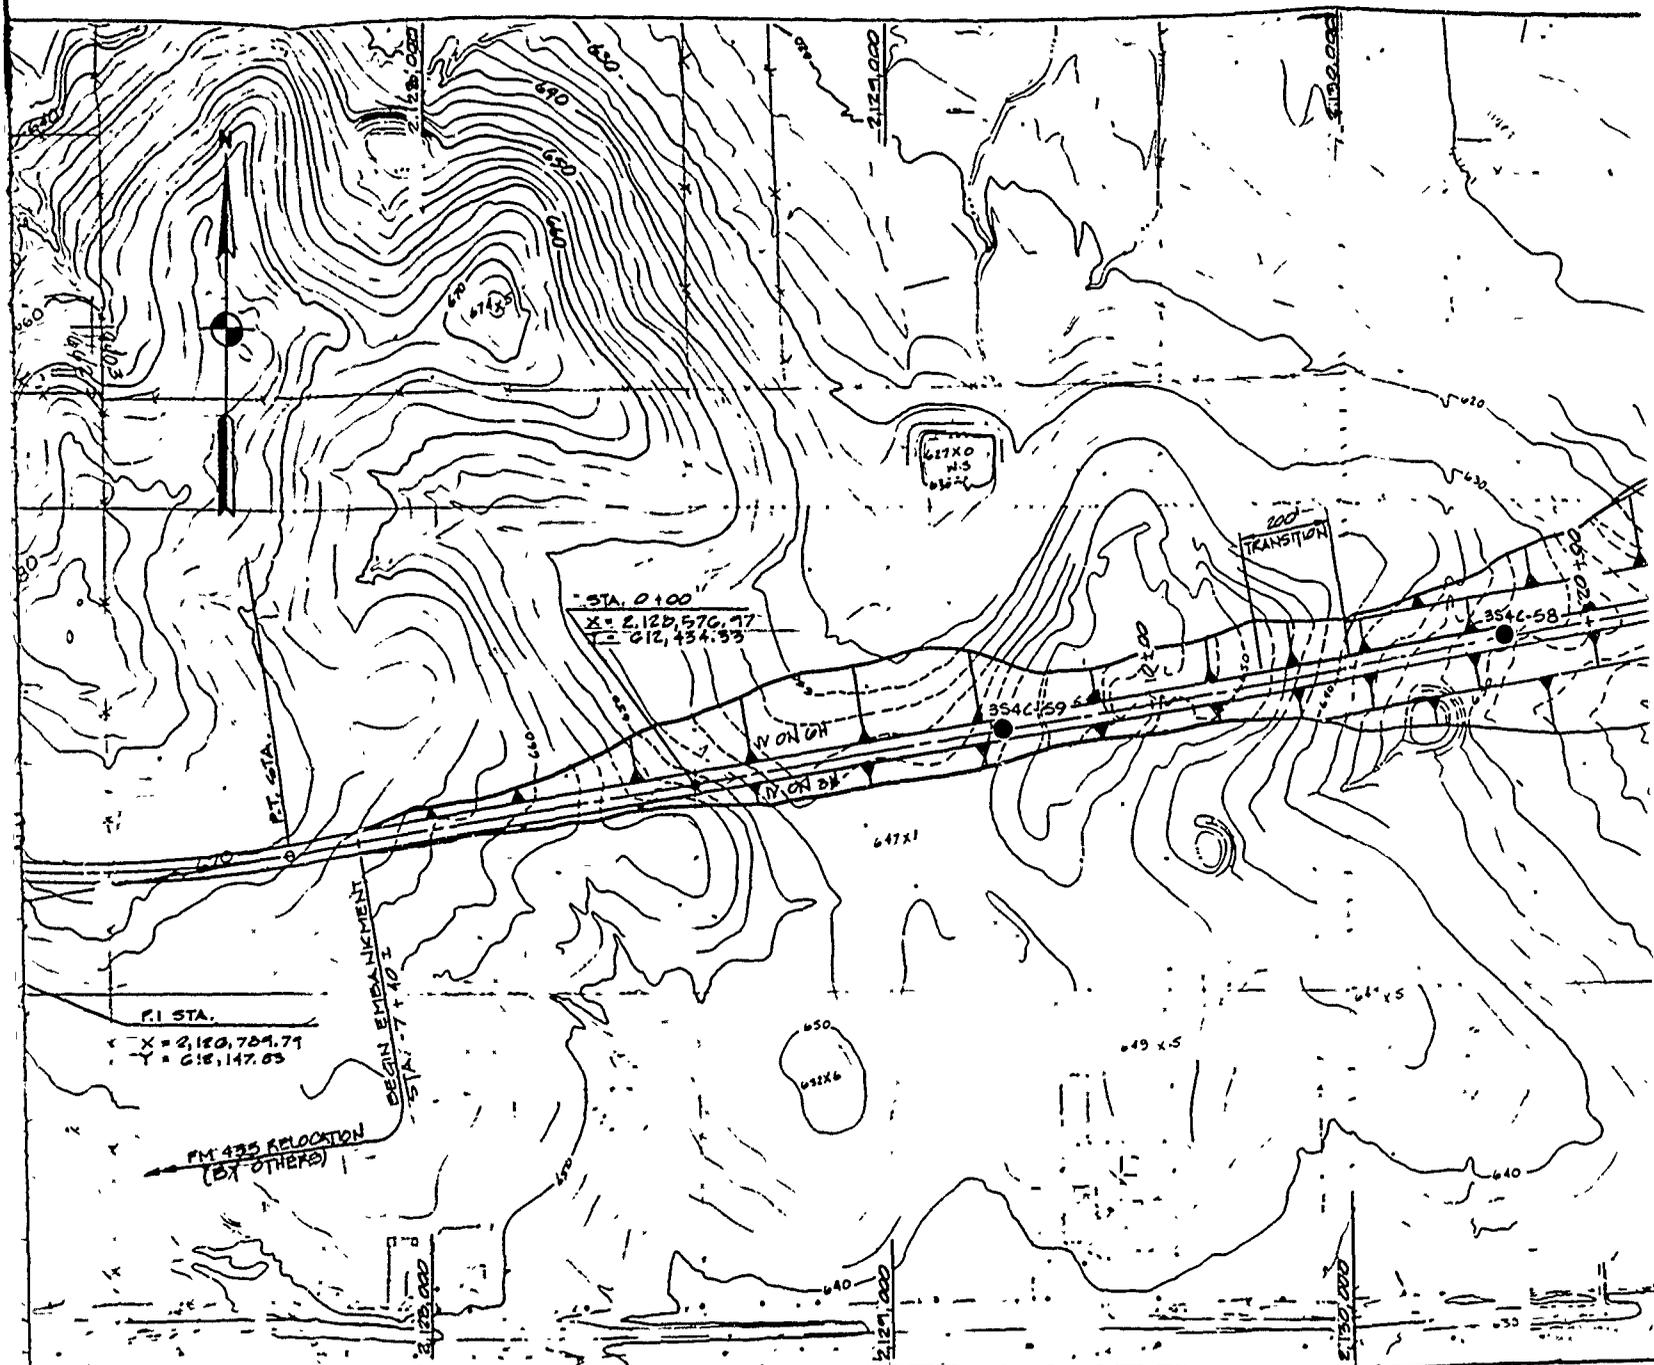

PLAN

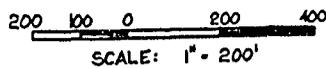

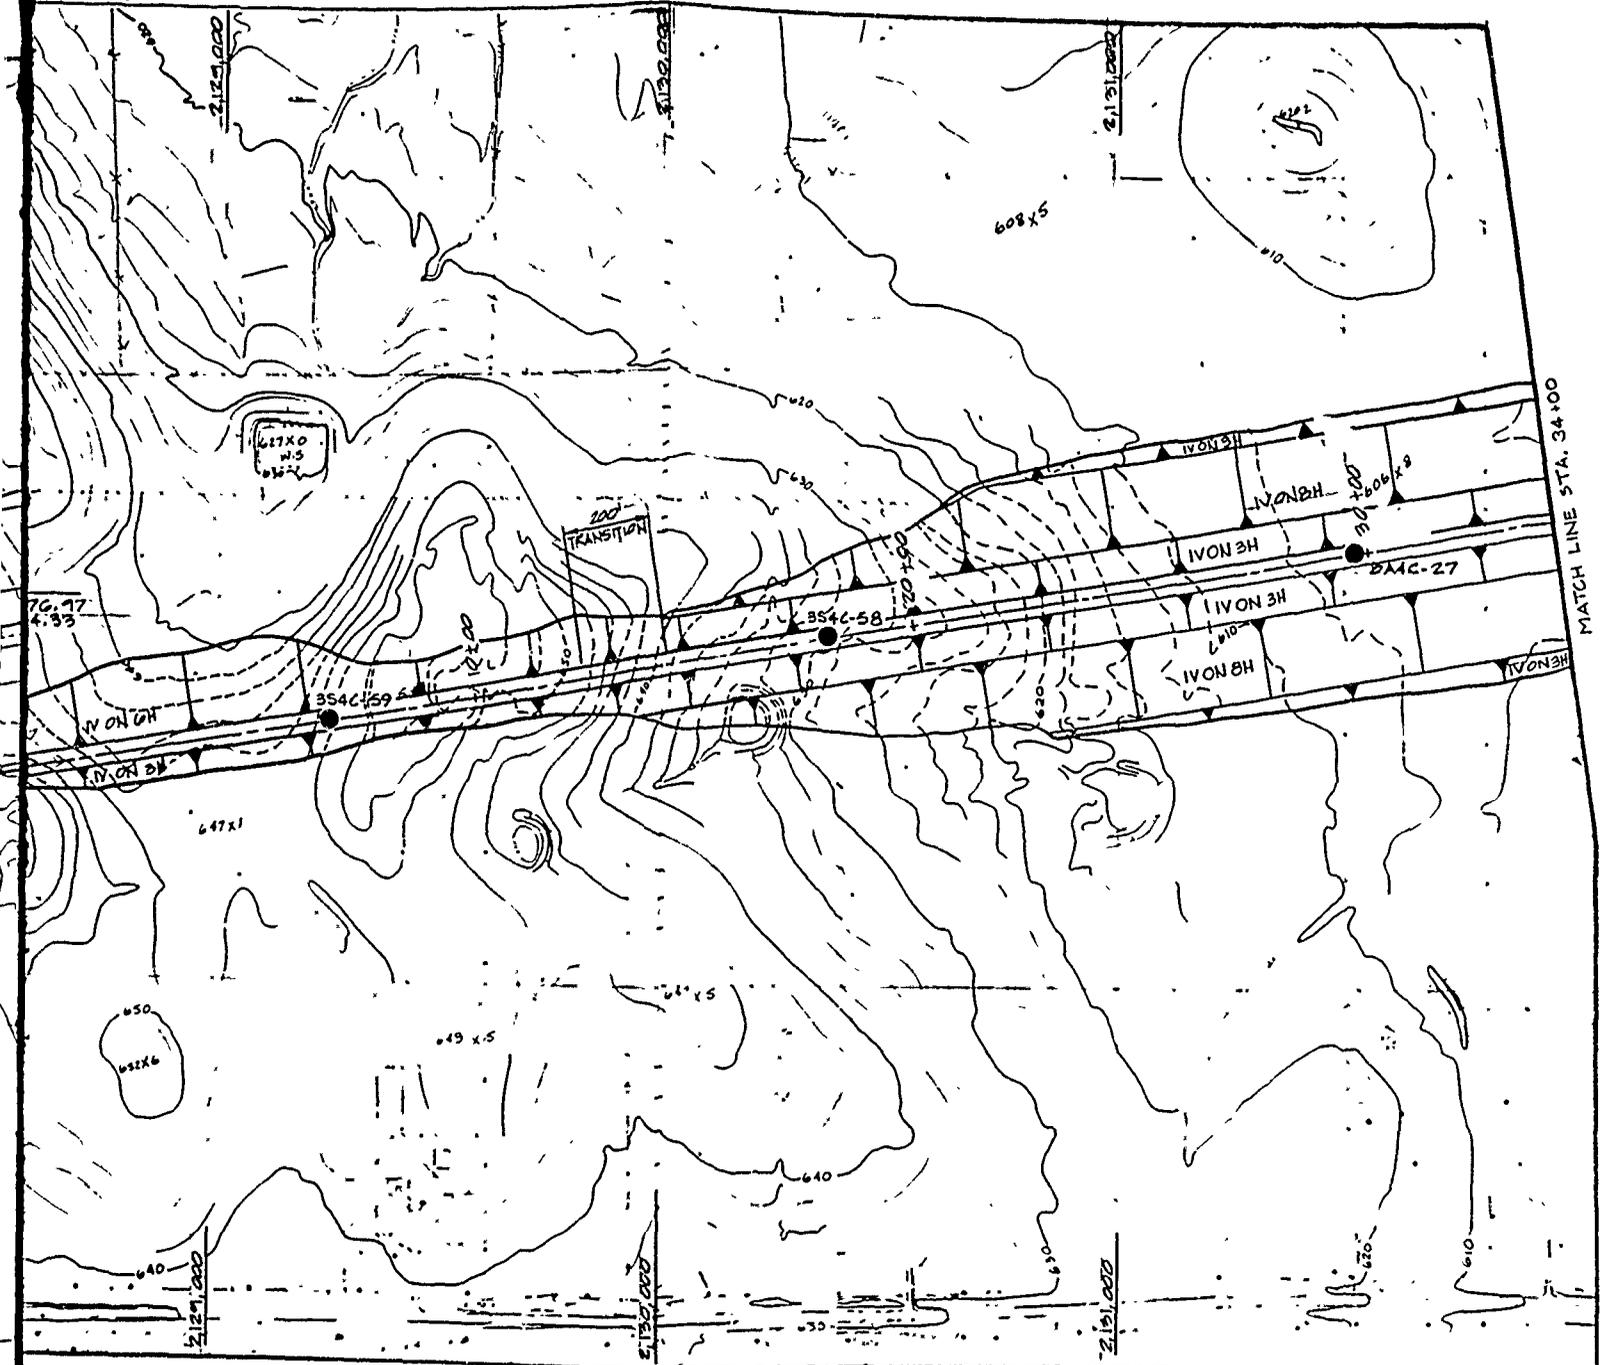

RECORD DRAWING-WORK AS BUILT

REVISION NO.	ACTION	DATE	DESCRIPTION OF REVISION

U.S. ARMY ENGINEER DISTRICT, FORT WORTH
CORPS OF ENGINEERS
FORT WORTH, TEXAS

DESIGNED BY:
A. BRANCH

DRAWN BY:
R. BAILEY


REVIEWED BY:
A. BRANCH

SUBMITTED BY:
H. KARBS

RAY ROBERTS LAKE
ELM FORK, TRINITY RIVER, TEXAS

EMBANKMENT
PLAN OF BORINGS I

INVITATION NO. DACW 63-82-C-0026 DATE: MAR 81
CONTRACT NO. DACW 63-82-C-0026

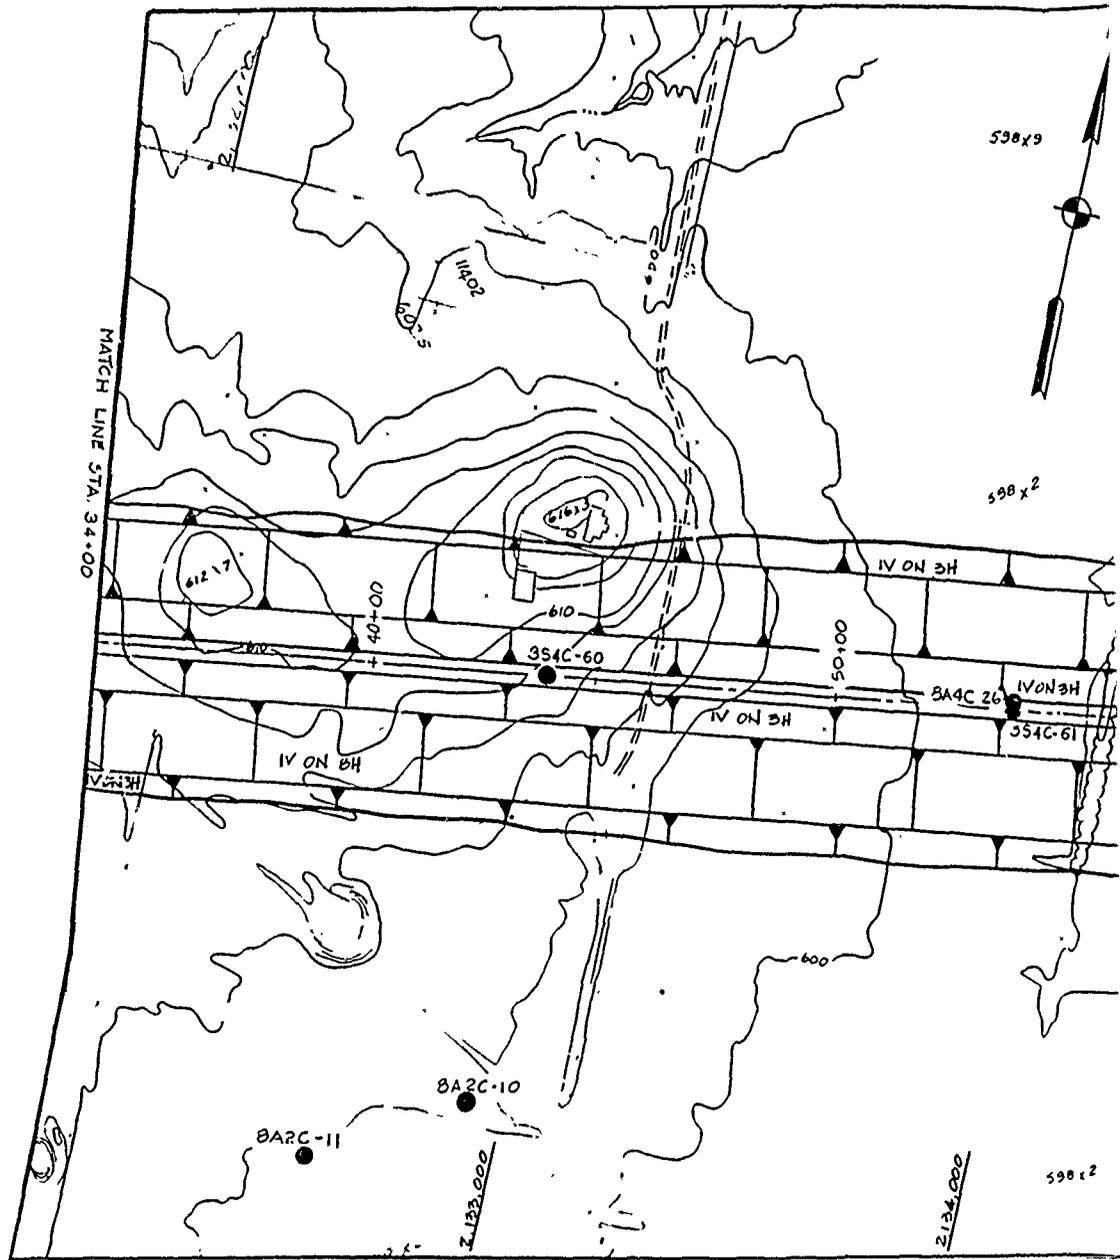

MATCH LINE STA. 34+00

598x9

598x2



612.17

40+00

610

354C-60

50+00

IV ON BH

8A2C 26

IV ON BH

354C-61

IV ON BH

IV ON BH

600


8A2C-10

8A2C-11


2122.000

2124.000


598x2

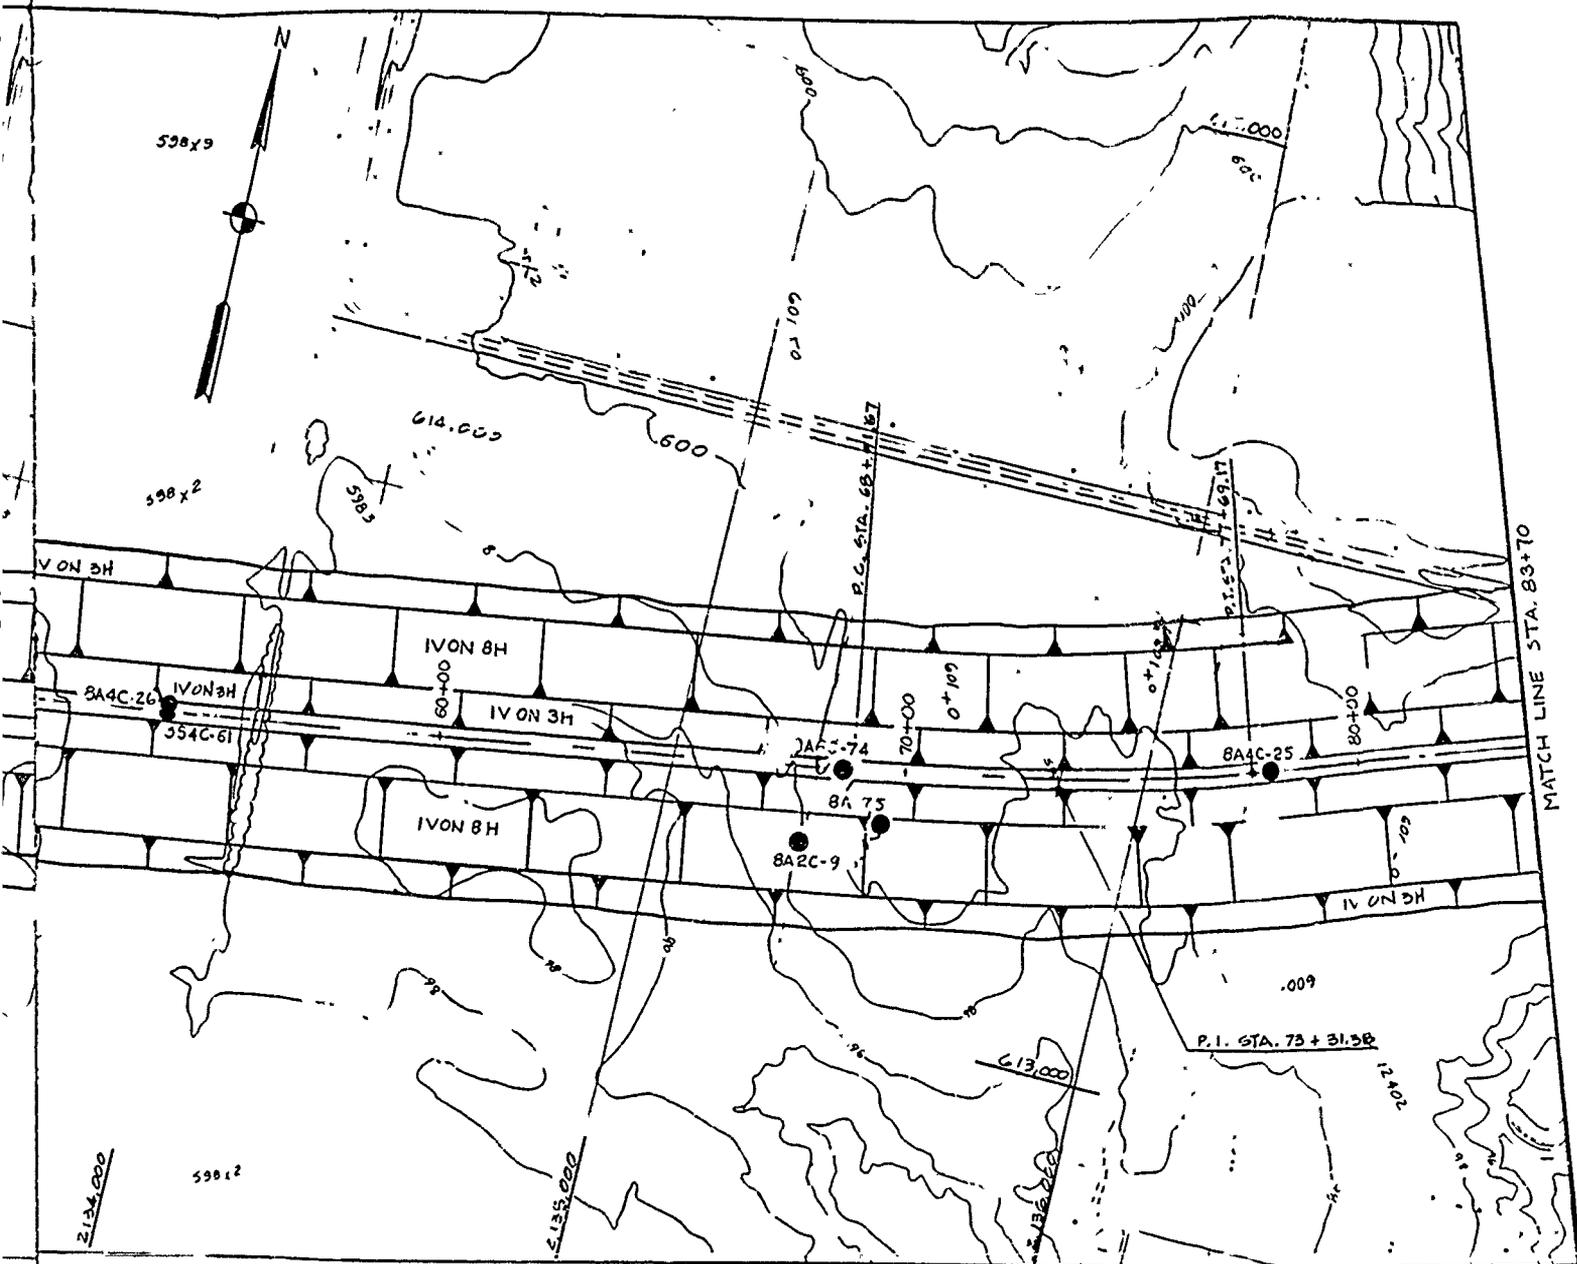

PLAN

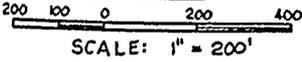


BY
A
P
A

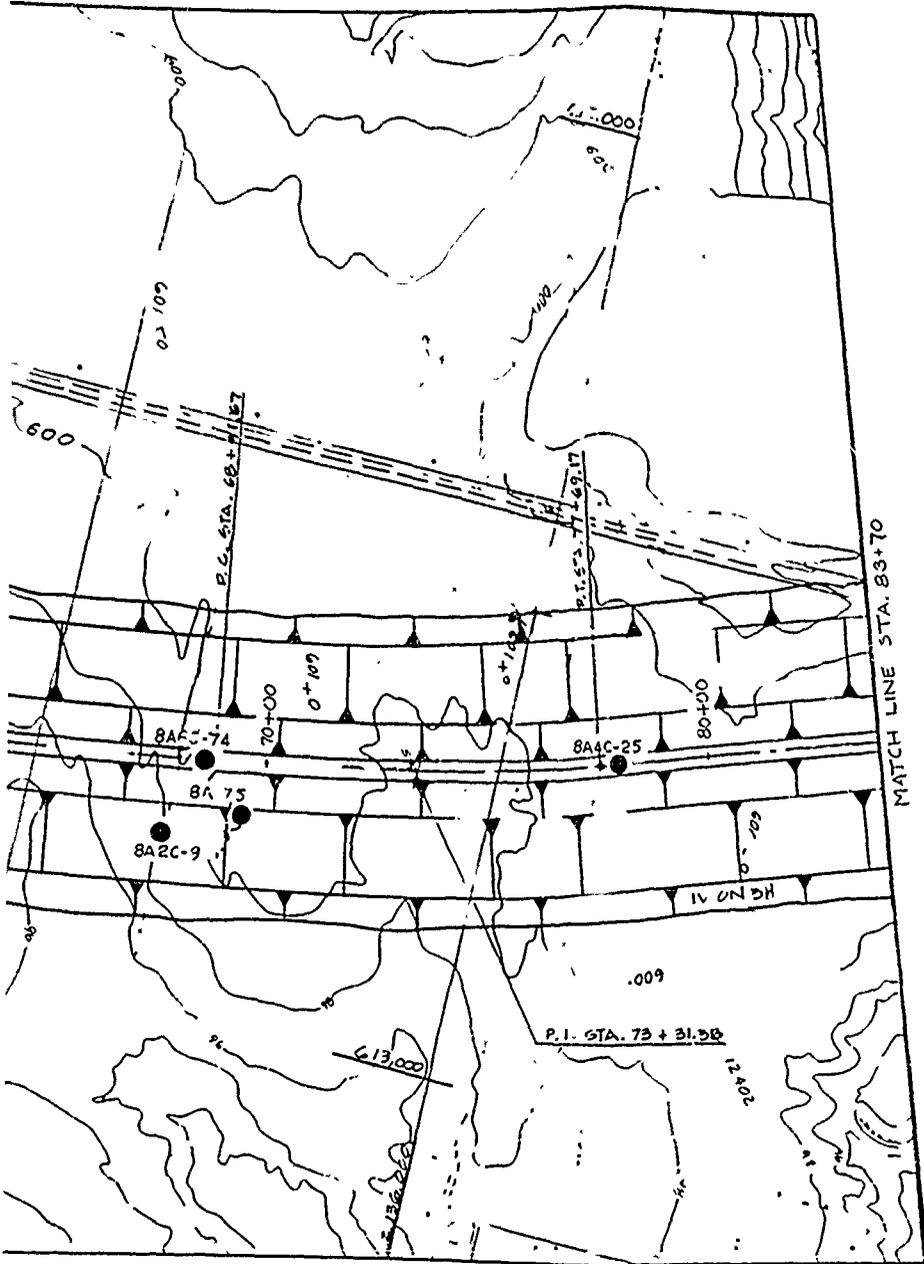

RECORD DRAWING-WORK AS BUILT

STATION
BAR

REV. NO.	ACTION	DATE	DESCRIPTION OF REVISION
U.S. ARMY ENGINEER DISTRICT, FORT WORTH CORPS OF ENGINEERS FORT WORTH, TEXAS			
DESIGNED BY:	RAY ROBERTS LAKE ELM FORK, TRINITY RIVER, TEXAS EMBANKMENT PLAN OF BORINGS II		
DRAWN BY:			
CHECKED BY:			
REVIEWED BY:			
SUBMITTED BY:			
INVITATION NO. DA-C-63-82-B-22			DATE: MAR 1959

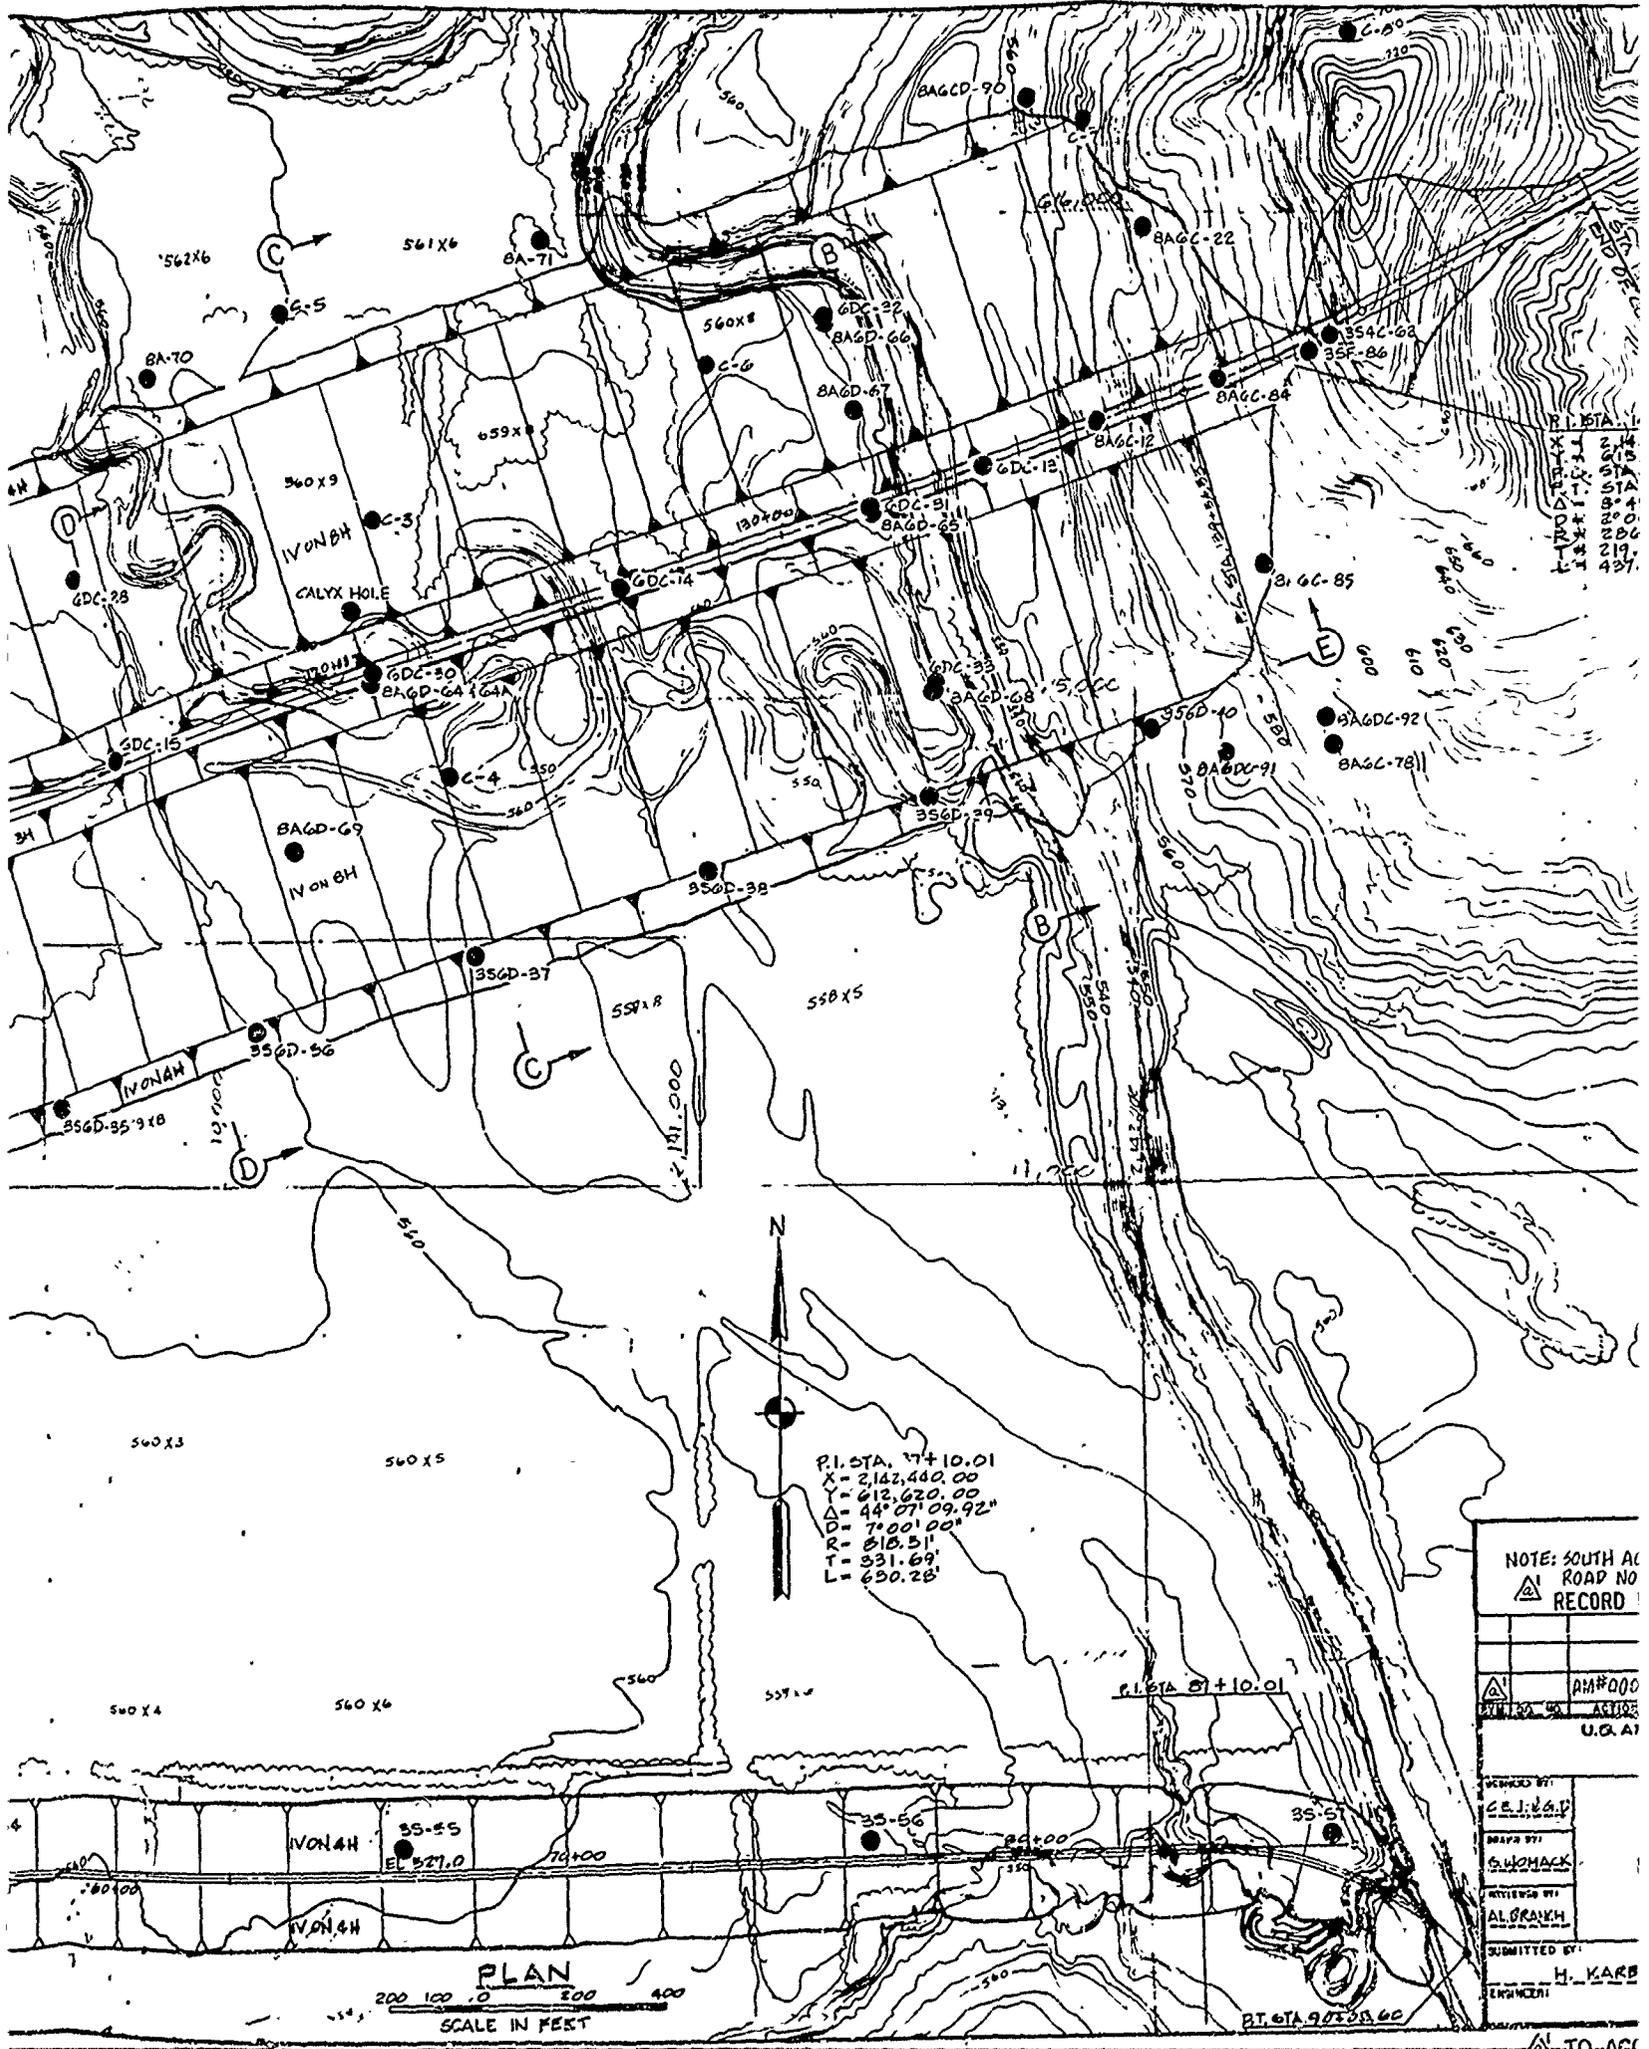

P.I. STA. 17+10.01
 214
 STA
 215
 STA
 216
 STA

P.I. STA. 17+10.01
 X = 2,142,400.00
 Y = 612,620.00
 Δ = 44° 07' 09.92"
 D = 700' 00"
 R = 818.31'
 T = 331.69'
 L = 650.28'


P.I. STA. 27+10.01

NOTE: SOUTH AC ROAD NO RECORD

DESIGNED BY	CEJ:GAP
DRAWN BY	SWHACK
REVIEWED BY	AL GRAMM
SUBMITTED BY	H. KARB
ENGINEER	ENRNER

PLAN
 200 100 0 100 200 400
 SCALE IN FEET

P.I. STA. 90+55.00

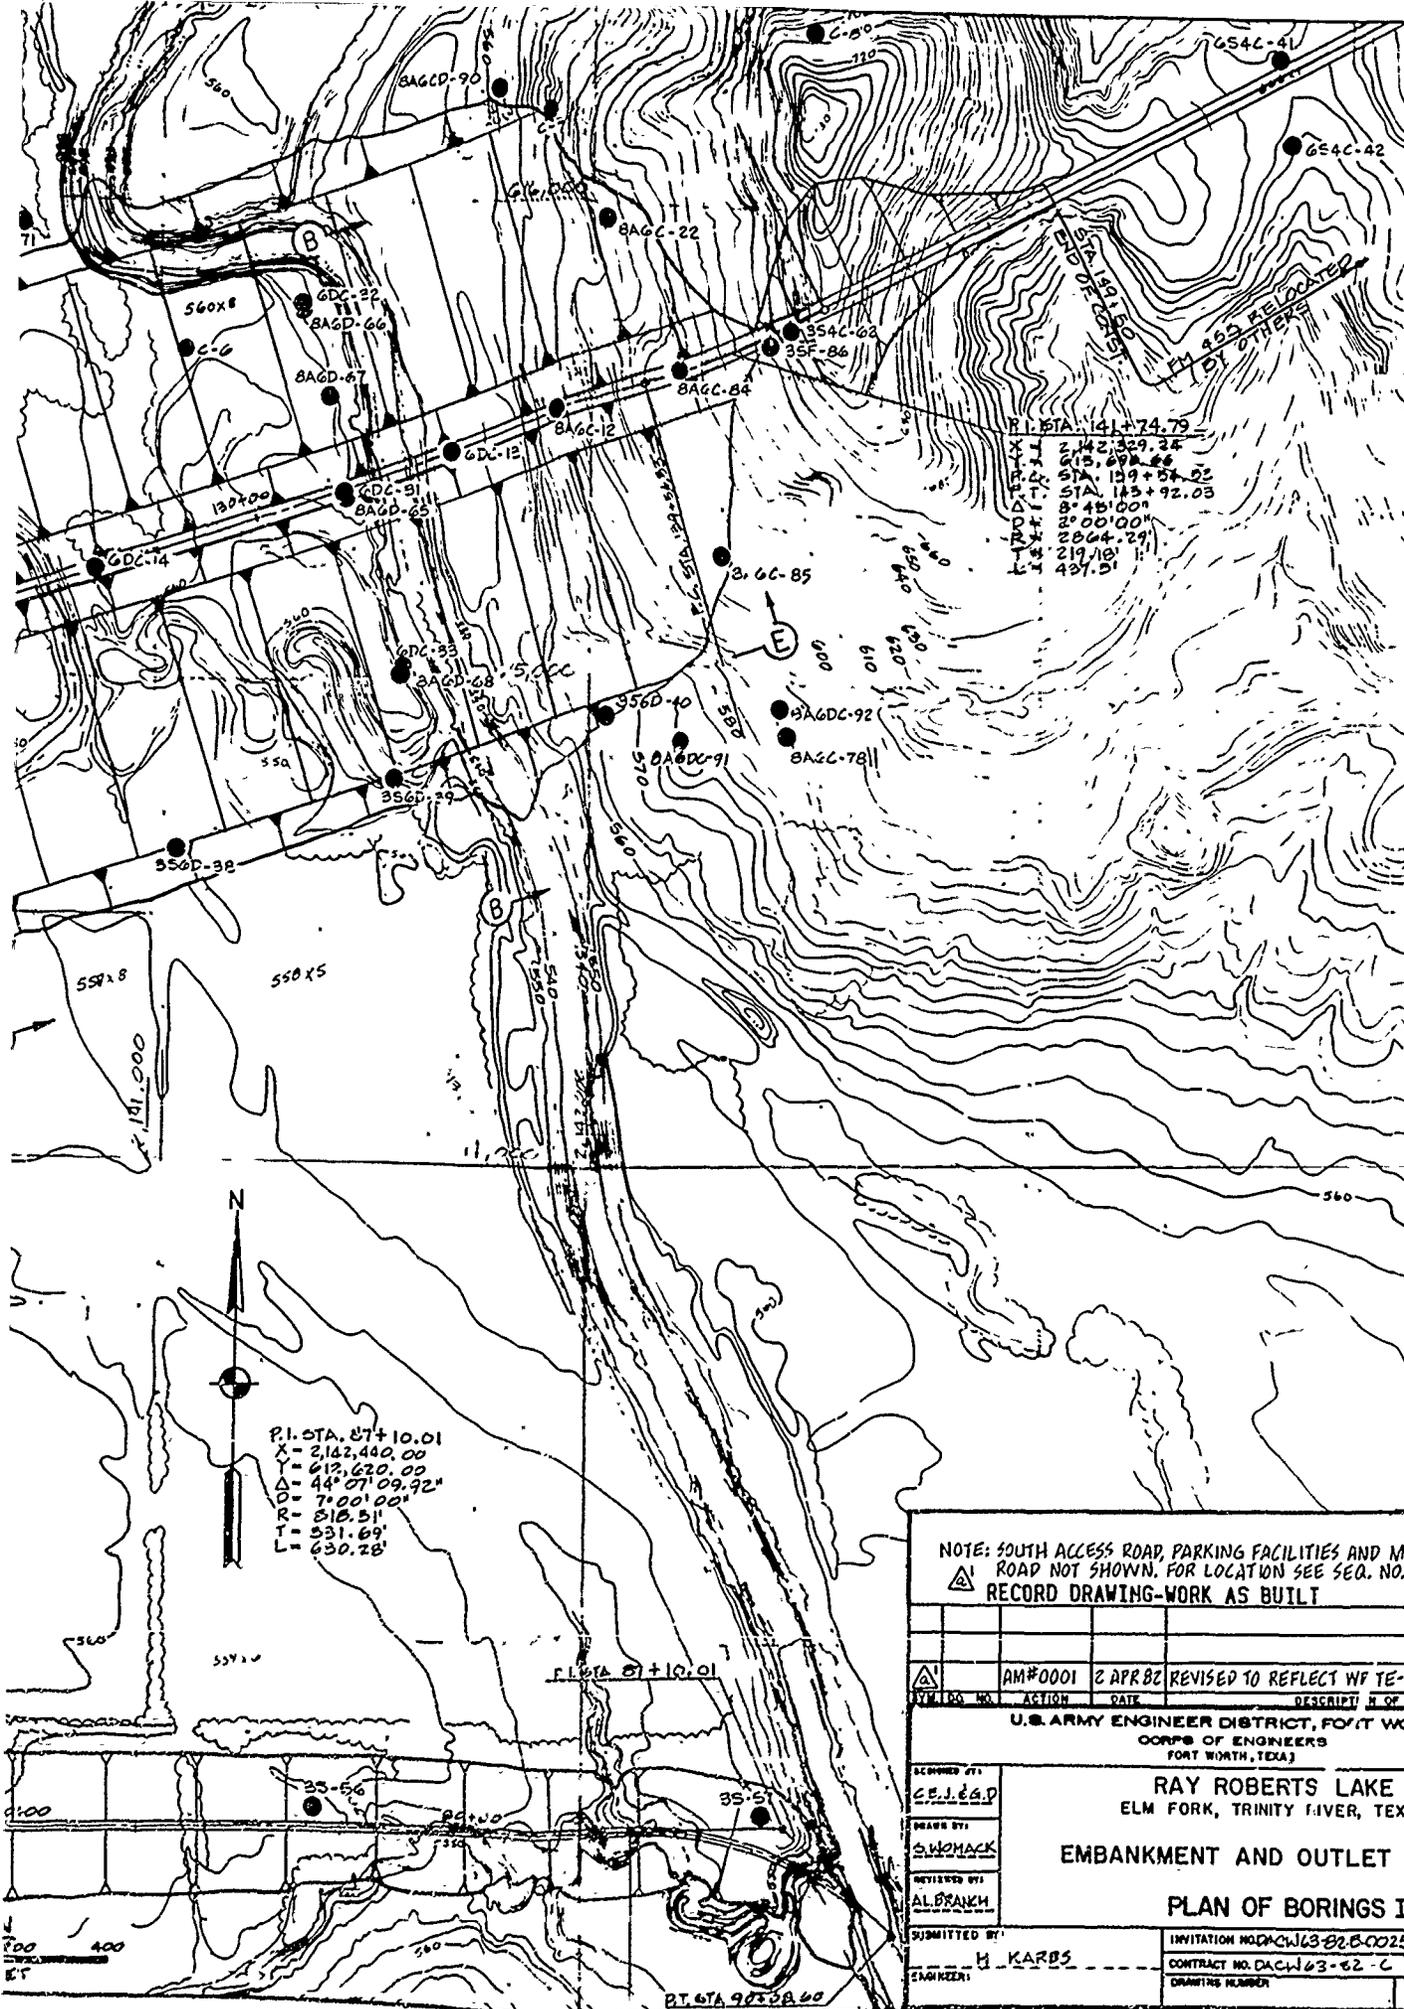

P.I. STA. 141+74.79
 X = 2,142,329.25
 Y = 575,878.86
 STA. 139+54.22
 X = 2,143,921.03
 Y = 575,878.86
 Δ = 8°45'00"
 L = 219.10'
 R = 437.5'

P.I. STA. 87+10.01
 X = 2,122,440.00
 Y = 612,620.00
 Δ = 44°07'09.92"
 L = 7,001.00'
 R = 518.51'
 T = 531.69'
 L = 630.28'

NOTE: SOUTH ACCESS ROAD, PARKING FACILITIES AND MAINTENANCE ROAD NOT SHOWN. FOR LOCATION SEE SEQ. NO. 157 AND 158. RECORD DRAWING-WORK AS BUILT

WORKING NO.	ACTION	DATE	DESCRIPTION OF REVISION
AM#0001	REVISED TO REFLECT WF TE-IN CHANGE	2 APR 82	

U.S. ARMY ENGINEER DISTRICT, FORT WORTH
 CORPS OF ENGINEERS
 FORT WORTH, TEXAS


RAY ROBERTS LAKE
 ELM FORK, TRINITY RIVER, TEXAS
 EMBANKMENT AND OUTLET WORKS
 PLAN OF BORINGS III

DESIGNED BY: CE J. LEAD
 DRAWN BY: S. W. MACK
 REVIEWED BY: AL. BRANK
 SUBMITTED BY: H. KARBS


INVITATION NO. DACW 63-82-C-0025	DATE: MAR, 1982
CONTRACT NO. DACW 63-82-C-0083	SEQUENCE NO. 5
DRAWING NUMBER	SHEET NO. OF

TO ACCOMPANY FOUNDATION REPORT


CONTRACT NO. DACW 63-82-C-0083

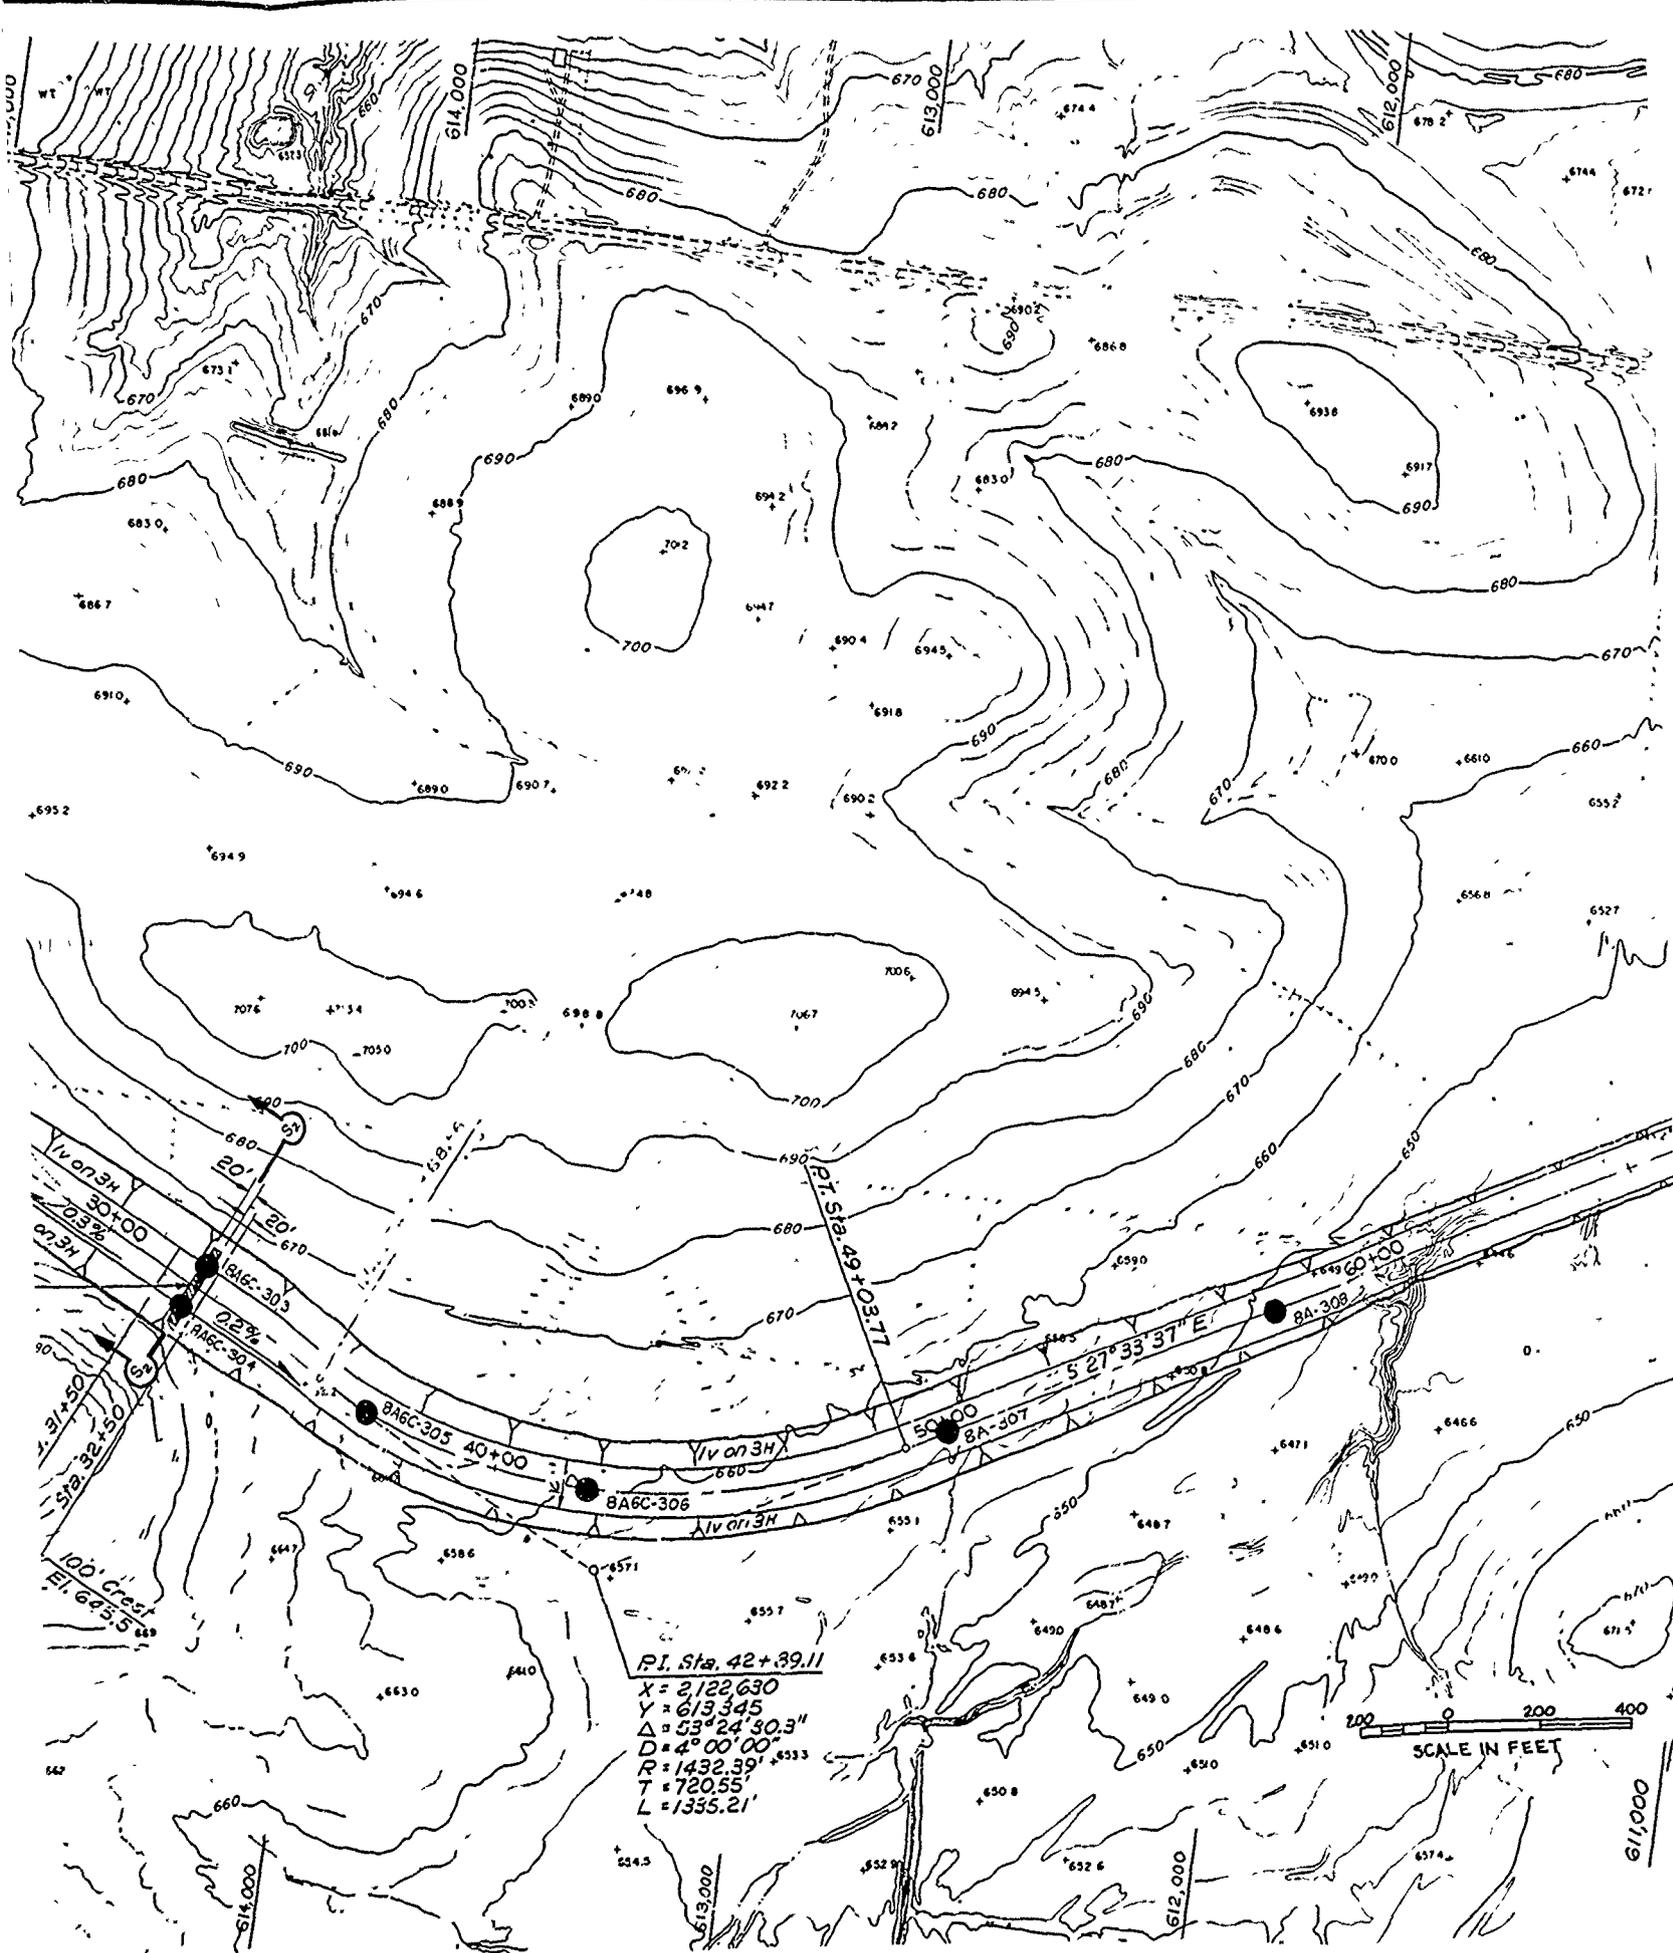

P.I. Sta. 42+39.11
 X = 2122.630
 Y = 613.345
 $\Delta = 53^{\circ}24'30.3''$
 $D = 4^{\circ}00'00''$
 R = 1432.39'
 T = 720.55'
 L = 1335.21'

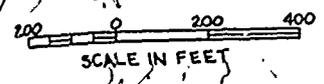

RECORD DRAWING-WORK AS BUILT

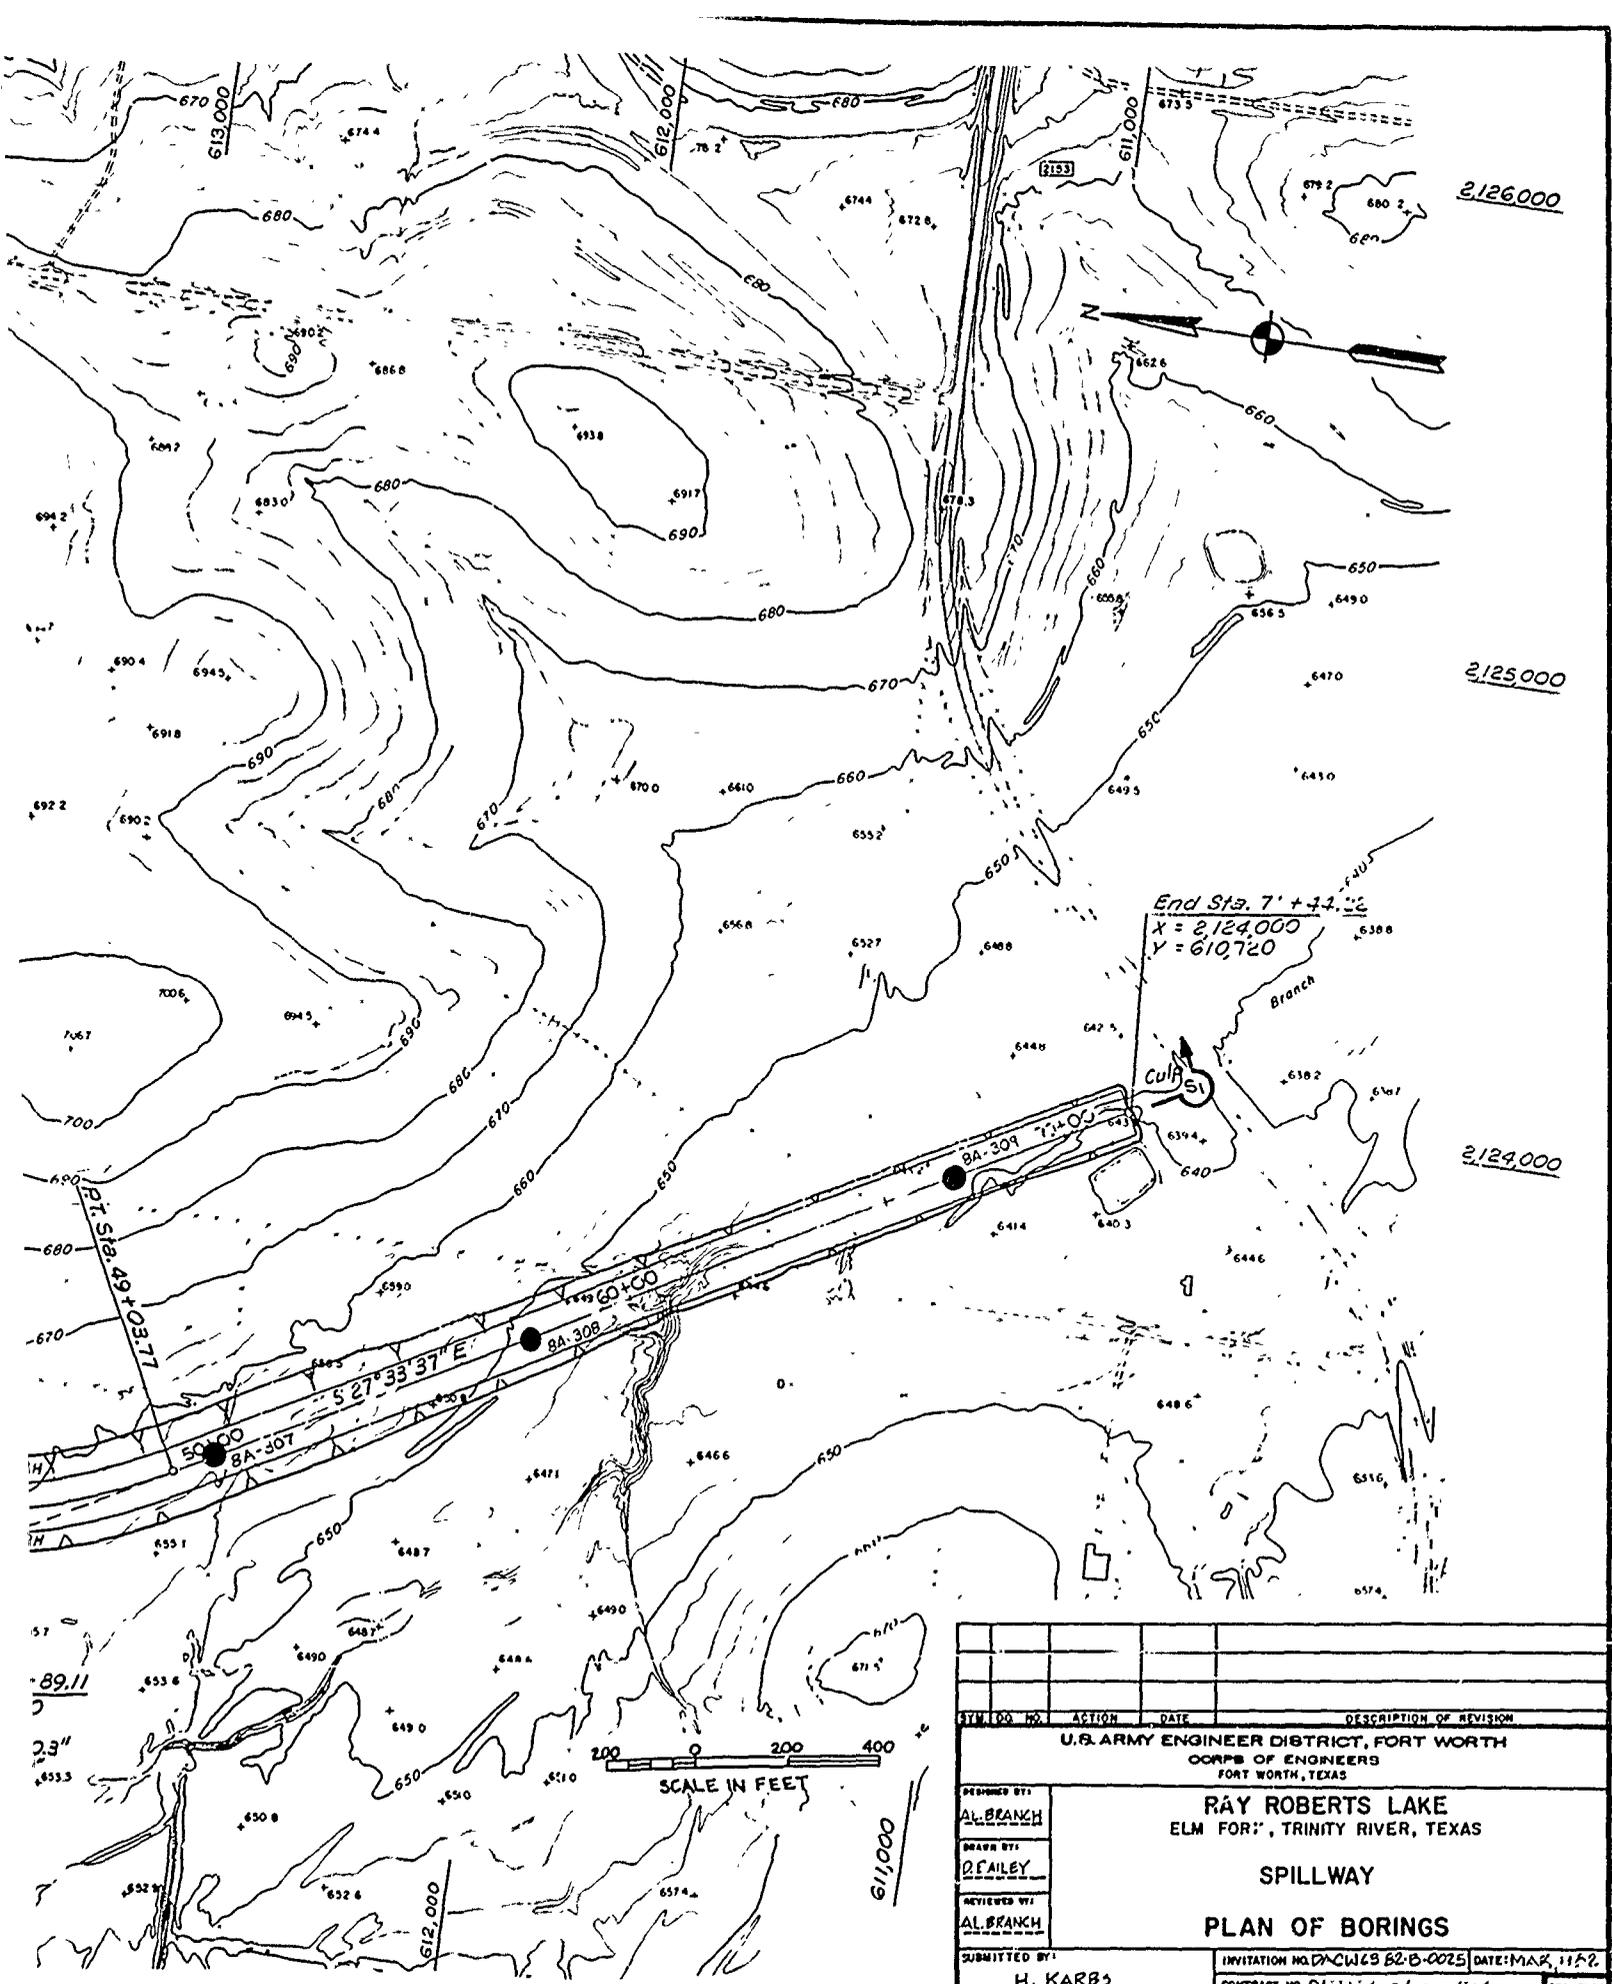

RECORD DRAWING-WORK AS BUILT

SYMBOL NO.	ACTION	DATE	DESCRIPTION OF REVISION
U.S. ARMY ENGINEER DISTRICT, FORT WORTH CORPS OF ENGINEERS FORT WORTH, TEXAS			
DESIGNED BY: AL BRANCH	RAY ROBERTS LAKE ELM FOR, TRINITY RIVER, TEXAS SPILLWAY PLAN OF BORINGS		
DRAWN BY: FAILEY			
REVIEWED BY: AL BRANCH			
SUBMITTED BY: H. KARBS	INVITATION NO. DACW49 82-B-0025	DATE: MAR 11 1982	SEQUENCE NO. 7
CONTRACT NO. DAJ402-74-2-0112		SHEET NO. OF	7

TO ACCOMPANY FOUNDATION REPORT

CONTRACT NO. DAJ402-74-2-0112

UNITED STATES ENGINEER OFFICE
ENGINEERING DIVISION
FIELD INVESTIGATIONS SECTION
GALVESTON, TEXAS

LOG OF CORE DRILLING

Site Aubrey Dam

Hole No. _____

Date 20 August 1946

Site Aubrey Sheet 24 of 2

Hole No. C-1 Drill No. _____ Location U.S.L. Sta. 4724

Type of Bit _____ Elevation of Top of Hole 597.2'

Size of Core 2-inch Depth of Overburden 16.0'

Method of Arb. Sampling Earth Auger Elevation of Top of Bedrock 581.2'

Set _____ of _____ Casing _____ Pulled Casing Top () No ()

Depth to Water Table _____ Elevation of Water Table _____

Total Depth of Hole 97.0' Elevation of Bottom of Hole 500.2'

Overburden Sampling 16.0' Core Drilling 81.0' % Recovery _____


Date Hole Started 8 January 1946 Date Hole Completed 6 January 1946

Number of Jars/Tubes 1 Marked Upper Elm Creek G.L. Sta. 4700

Number of Boxes 7 Marked Upper Elm Creek G.L. Sta. 4700

Classified by _____ Submitted by _____


BOX NOS	RUNS	LOSSES	DEPTH	ELEV.	CLASSIFICATION AND REMARKS
			0.0'	597.2'	
			8.0'	589.2'	0.0' to 8.0' CLAY, sandy, rust to dark brown.
			16.0'	581.2'	8.0' to 16.0' SAND, clayey, tan.
			19.4'	577.8'	16.0' to 19.4' Limestone, fossiliferous, earthy, brown to tan, surface or near surface outcrops of this material have been colored by iron oxide.
			28.0'	569.2'	19.4' to 28.0' SHALE, sandy. - core washed away.
			32.0'	565.2'	28.0' to 32.0' SHALE, blue, stained by iron oxide.
			47.0'	500.2'	32.0' to 47.0' SHALE, compact, laminated, soft, thin shell seams.

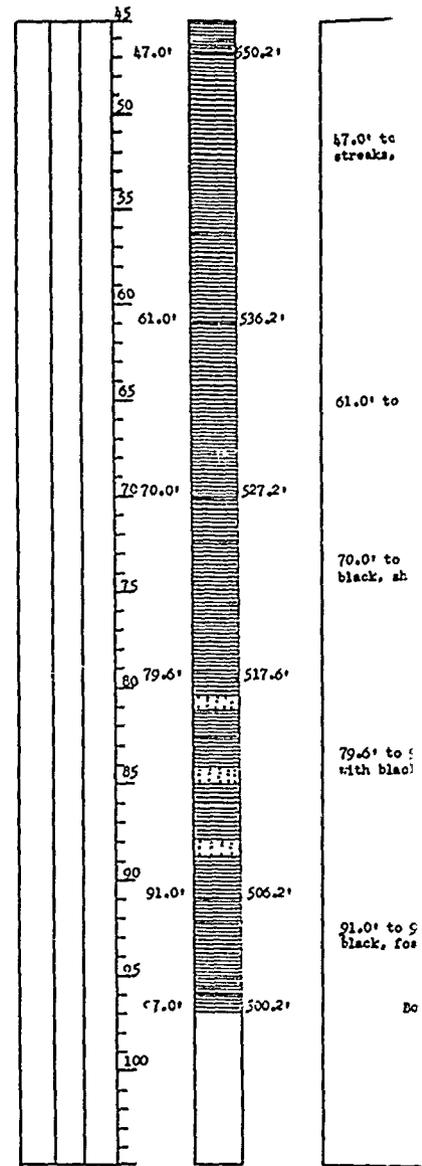

UNITED STATES ENGINEER OFFICE
ENGINEERING DIVISION
FIELD INVESTIGATIONS SECTION
GALVESTON, TEXAS

LOG OF CORE DRILLING

Site Aubrey Date 20 August 1946
Sheet 1 of 2
Hole No. C-2 Drill No. _____ Location C.L. Sta. 11/27
Type of Bit _____ Elevation of Top of Hole 562.0'
Size of Core 2-Inch Depth of Overburden 28.0'
Method of Obs. Sampling Earth Auger Elevation of Top of Bedrock 534.0'
Set _____ of _____ Casing Pulled Casing Yes () No ()
Depth to Water Table _____ Elevation of Water Table _____
Total Depth of Hole 68.0' Elevation of Bottom of Hole 494.0'
Overburden Sampling 28.0' Core Drilling 40.0' % Recovery _____
Date Hole Started 4 January 1939 Date Hole Completed 6 January 1939
Number of Jars/Tubes 1 Marked Upper Elm Creek C.L. Sta. 11/27
Number of Boxes 2 Marked Upper Elm Creek C.L. Sta. 11/27
Classified by _____ Submitted by _____

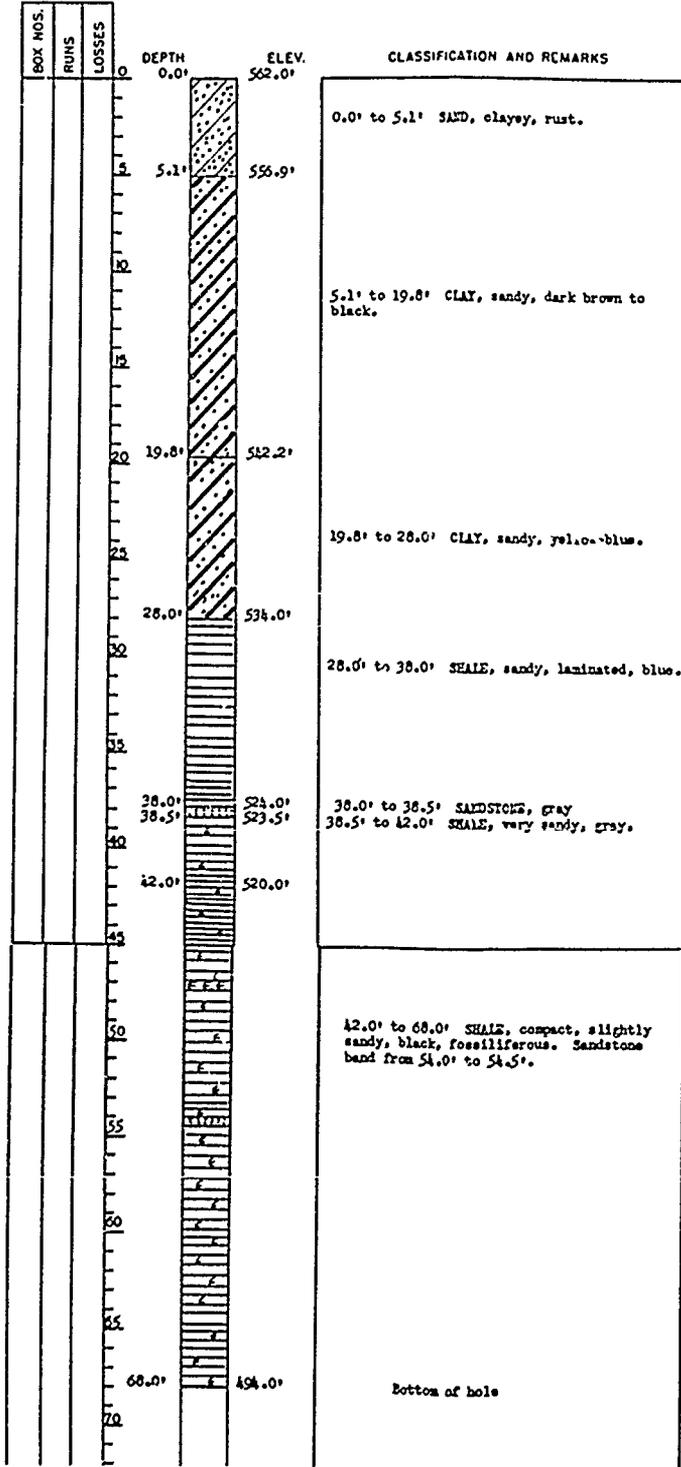

RECORD DRAWING-WORK AS BUILT

SYMBOL NO.	ACTION	DATE	DESCRIPTION OF REV. SIGN.
U.S. ARMY ENGINEER DISTRICT, FORT WORTH CORPS OF ENGINEERS FORT WORTH, TEXAS			
DESIGNED BY	RAY ROBERTS LAKE ELM FORK, TRINITY RIVER, TEXAS EMBANKMENT, SPILLWAY AND OUTLET WORKS LOGS OF BORINGS C-1 AND C-2		
DRAWN BY			
REVIEWED BY			
SUBMITTED BY			
ENGINEER	INVITATION NO. DACW63-820 C025	DATE MAR, 1942	SEQUENCE NO.
	CONTRACT NO. DACW63-82-C-6093		
	DRAWING NUMBER	SHEET NO.	

TO ACCOMPANY FOUNDATION REPORT

INSTR. NO. DA-100-2-52 C 100-3


UNITED STATES ENGINEER OFFICE
ENGINEERING DIVISION
FIELD INVESTIGATIONS SECTION
GALVESTON, TEXAS

LOG OF CORE DRILLING

Date 20 August 1946

Site Aubrey Sheet 1 of 2
C.L. Sta. 28700

Hole No. C-1 Drill No. _____ Location In _____
Type of Bit _____ Elevation of Top of Hole 559.2'
Size of Core 2-Inch Depth of Overburden 85.0'
Method of Ovb. Sampling Earth Auger Elevation of Top of Bedrock 514.2'
Set _____ of Casing Pulled Casing Yes () No ()
Depth to Water Table _____ Elevation of Water Table _____
Total Depth of Hole 67.0' Elevation of Bottom of Hole 592.2'
Overburden Sampling 45.0' Core Drilling 22.0' Recoveries _____
Date Hole Started 7 January 1939 Date Hole Completed 10 January 1939
Number of Jars/Tubes 1 Marker Upper Elm Creek C.L. Sta. 28400
Number of Boxes 1 Marker Lower Elm Creek C.L. Sta. 28400
Classified by _____ Submitted by _____

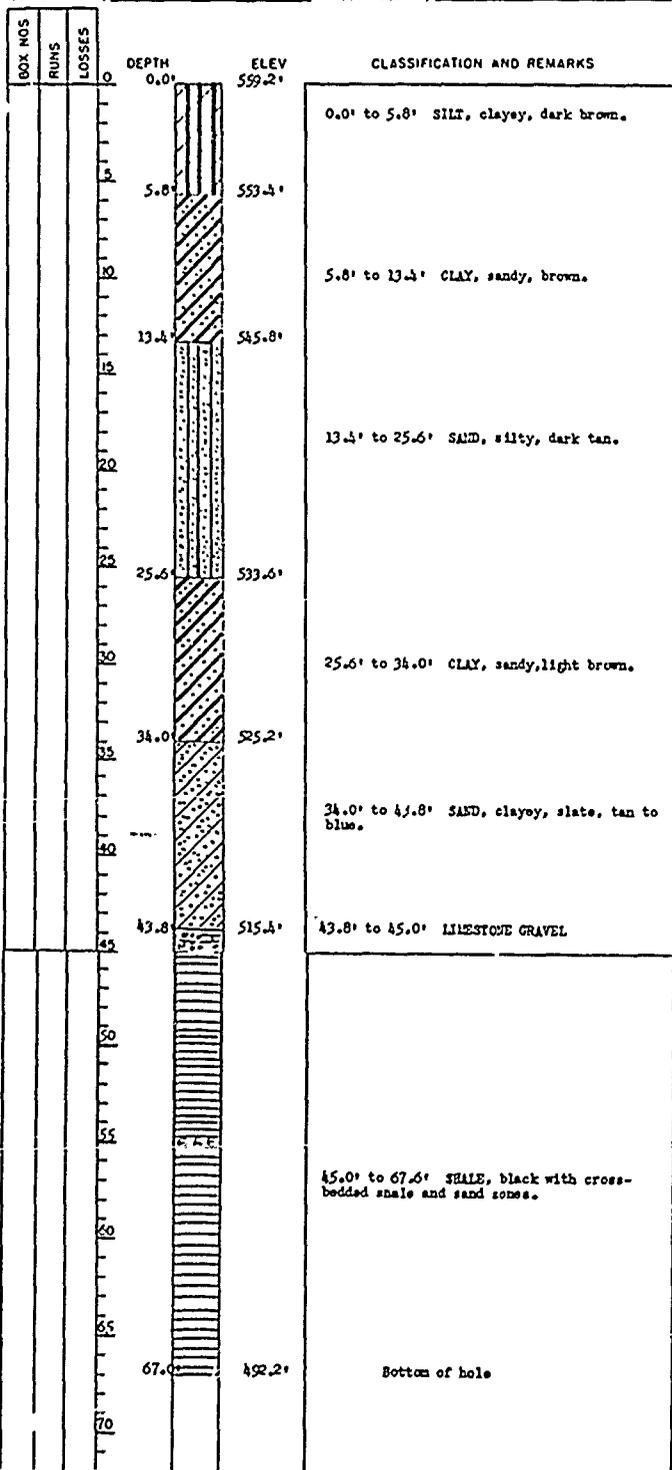


UNITED STATES ENGINEERING DIVISION
FIELD INVESTIGATIONS SECTION
GALVESTON, TEXAS

LOG OF CORE

Site Aubrey

Hole No. C-4 Drill No. _____ Location In _____
Type of Bit _____ Elevation of Top of Hole _____
Size of Core 2-Inch Depth of Overburden _____
Method of Ovb. Sampling Earth Auger Elevation of Top of Bedrock _____
Set _____ of Casing Pulled Casing Yes () No ()
Depth to Water Table _____ Elevation of Water Table _____
Total Depth of Hole 82.0' Elevation of Bottom of Hole _____
Overburden Sampling 16.0' Core Drilling _____ Recoveries _____
Date Hole Started 6 January 1939 Date Hole Completed _____
Number of Jars/Tubes 2 Marker _____
Number of Boxes 1 Marker _____
Classified by _____ Submitted by _____

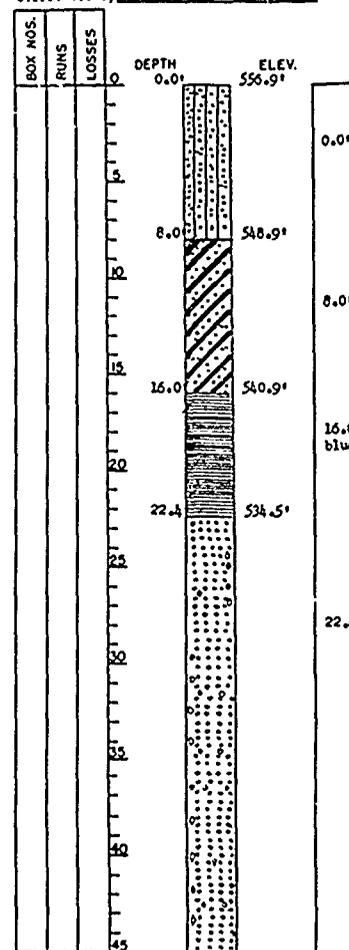


UNITED STATES ENGINEER OFFICE
ENGINEERING DIVISION
FIELD INVESTIGATIONS SECTION
GALVESTON, TEXAS

LOG OF CORE DRILLING

Date 20 August 1946

Site Aubrey C.L. Sta. 28735 500' below.

Hole No. C-4 Drill No. _____ Location No. _____
 Type of Bit _____ Elevation of Top of Hole 556.9'
 Size of Core 2-Inch Depth of Overburden 16.0'
 Method of Ovb. Sampling Wash Lucas Elevation of Top of Bedrock 530.9'
 Set _____ of _____ Casing Pulled Casing Yes () No ()
 Depth to Water Table _____ Elevation of Water Table _____
 Total Depth of Hole 82.0' Elevation of Bottom of Hole 478.9'
 Overburden Sampling 16.0' Core Drilling 76.0' Recovery _____
 Date Hole Started 6 January 1939 Bit Hole Completed 10 January 1939
 Number of Jars/Tubes 2 Marked Upper Elm Creek 500' below 28700
 Number of Boxes 1 Marked Upper Elm Creek 500' below 28700
 Classified by _____ Submitted by _____

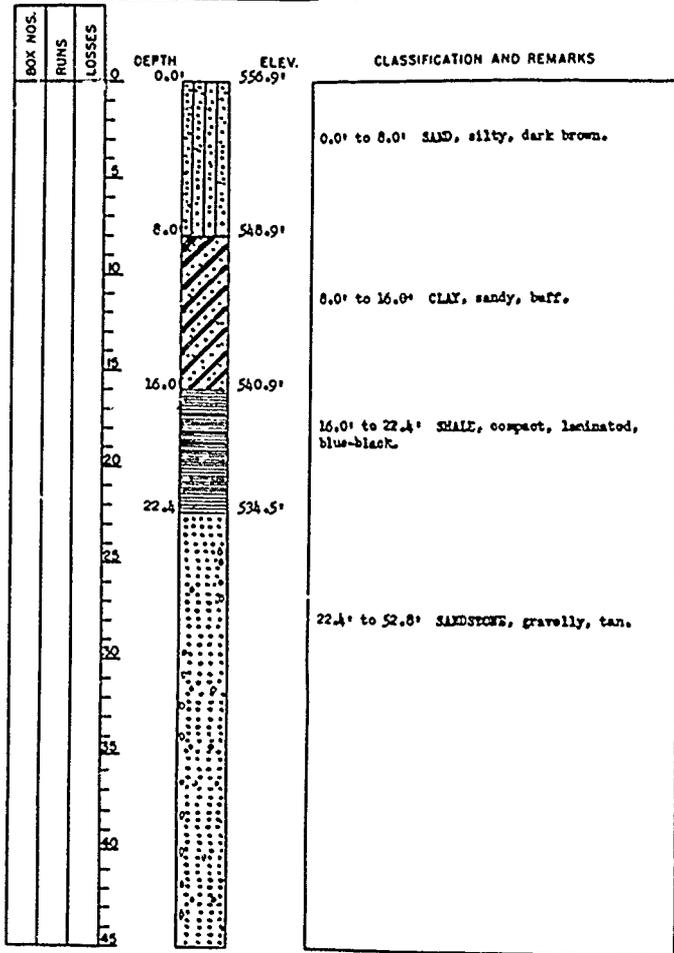


LOG OF CORE DRILLING CONTINUATION 3rd


Site Aubrey

Hole No. C-4

Sheet 2 of 2

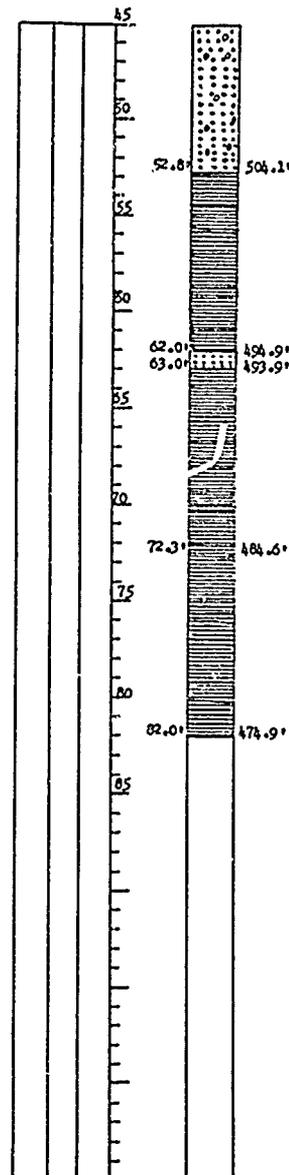

NOTE:
 Additional subsurface explorations indicate top of rock shown on this boring is in error. Material from 16.0 to 22.4 is probably clay. Sandstone shown from 22.4 to 52.8 is probably sand. The geologic section reflects these changes. Nov. 1935

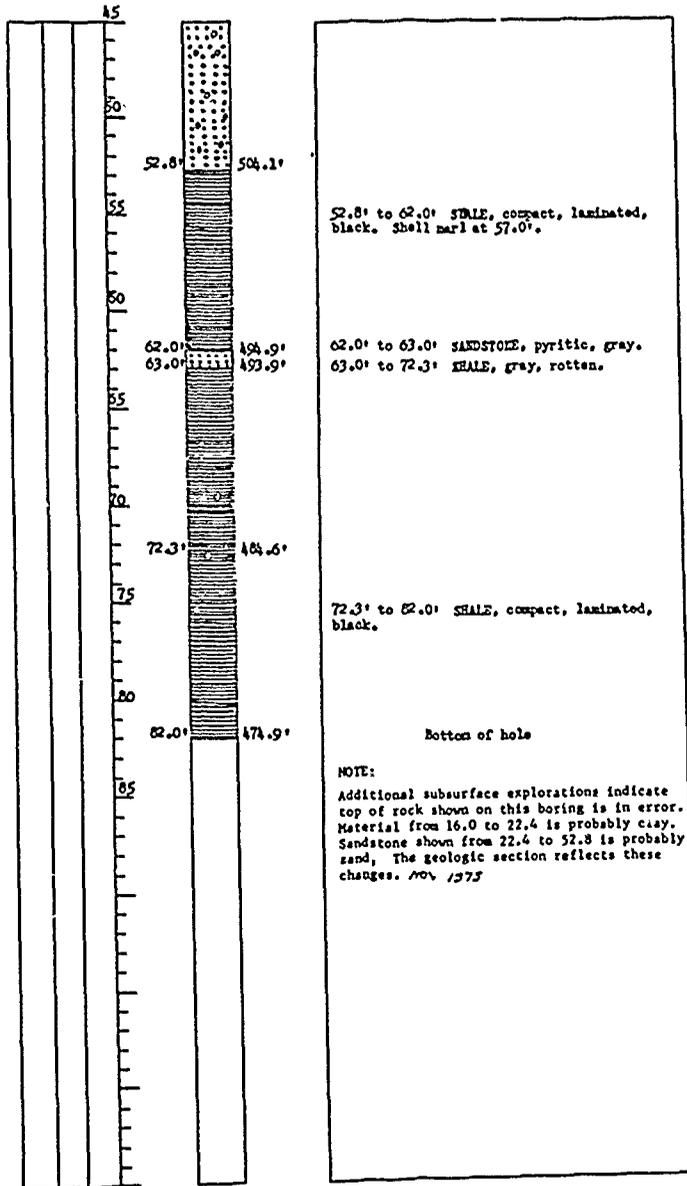


RECORD DRAWING-WORK AS BUILT

SYM	QC NO	ACTION	DATE	DESCR OF WORK	REV	SYM
U.S. ARMY ENGINEER DISTRICT, FORT WORTH CORPS OF ENGINEERS FORT WORTH, TEXAS						
DESIGNED BY:	RAY ROBERTS LAKE ELM FORK, TRINITY RIVER, TEXAS EMBANKMENT, SPILLWAY AND OUTLET WORKS LOGS OF BORINGS C-3 AND C-4					
DRAWN BY:						
REVIEWED BY:						
SUBMITTED BY:	INVITATION NO. DACW 63-82-B-0025	DATE	MAR, 1982			
ENGINEER	CONTRACT NO. DACW 63-72-C-0782	DRAWING NUMBER	SHEET NO. OF	9		

UNITED STATES ENGINEER OFFICE
ENGINEERING DIVISION
FIELD INVESTIGATIONS SECTION
GALVESTON, TEXAS

LOG OF CORE DRILLING


Site Aubrey Date 20 August 1946
 Hole No. C-5 Drill No. 1 Location 500' above Gal. Sta. 28700
 Type of Bit 2-Inch Elevation of Top of Hole 560.3'
 Size of Core 2-Inch Depth of Overburden 37.0'
 Method of Ovb. Sampling Earth Auger Elevation of Top of Bedrock 523.3'
 Set of Casing Pulled Casing Yes () No ()
 Depth to Water Table 68.0' Elevation of Water Table _____
 Total Depth of Hole 68.0' Elevation of Bottom of Hole 492.3'
 Overburden Sampling 37.0' Core Drilling 31.0' % Recovery _____
 Date Hole Started 18 January 1939 Date Hole Completed 20 January 1939
 Number of Jars/Tubes None Marked _____
 Number of Boxes 1 Marked Upper Elm Creek 500' Above Sta. 28700
 Classified by _____ Submitted by _____

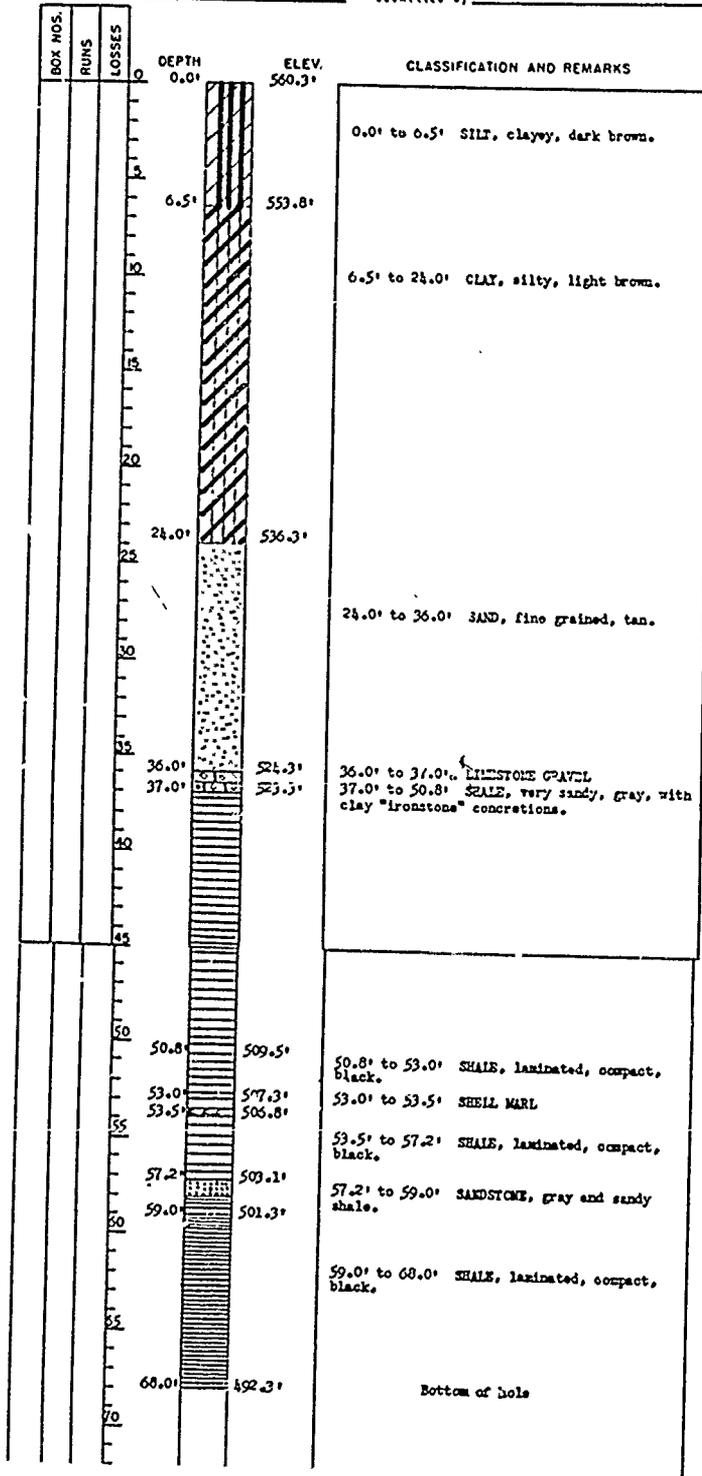

UNITED STATES ENGINEER OFFICE
ENGINEERING DIVISION
FIELD INVESTIGATIONS SECTION
GALVESTON, TEXAS

LOG OF CORE DRILLING

Site Aubrey Location 500' above Gal. Sta. 28700
 Hole No. C-6 Drill No. 1 Elevation of Top of Hole _____
 Type of Bit 2-Inch Depth of Overburden _____
 Size of Core 2-Inch Elevation of Top of Bedrock _____
 Method of Ovb. Sampling Earth Auger Pulled Casing Yes () No ()
 Set of Casing Elevation of Water Table _____
 Depth to Water Table _____ Elevation of Bottom of Hole _____
 Total Depth of Hole 68.0' Core Drilling _____ % Recovery _____
 Overburden Sampling 37.0' Date Hole Started 16 January 1939
 Date Hole Started _____ Date Hole Completed _____
 Number of Jars/Tubes None Marked _____
 Number of Boxes 1 Marked Upper Elm Creek 500' Above Sta. 28700
 Classified by _____ Submitted by _____

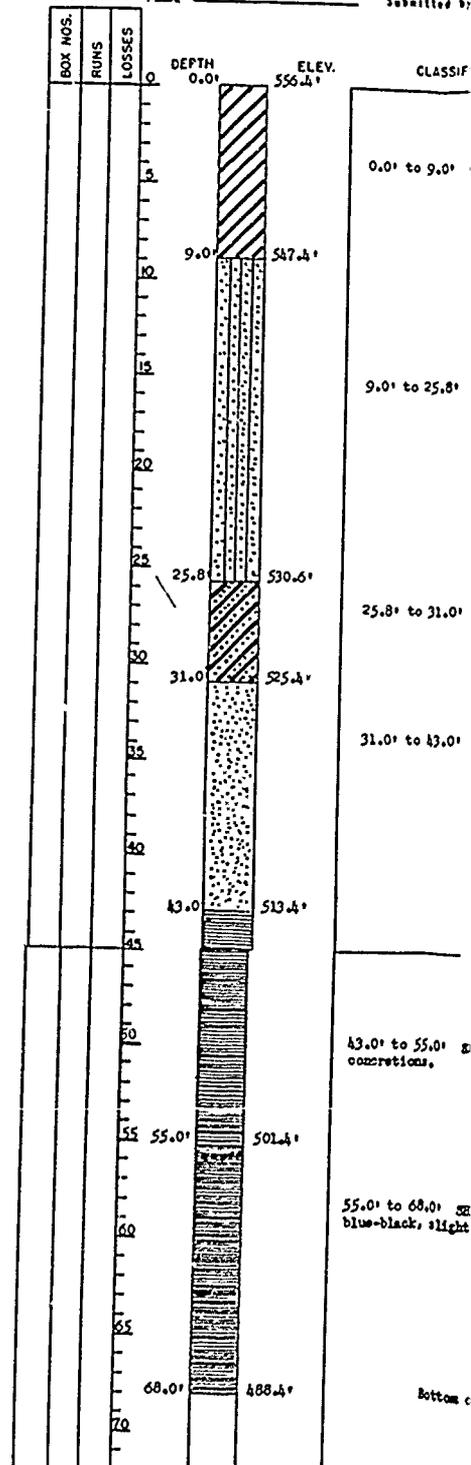


UNITED STATES ENGINEER OFFICE
ENGINEERING DIVISION
FIELD INVESTIGATIONS SECTION
GALVESTON, TEXAS

LOG OF CORE DRILLING

Date 20 August 1946

Site Aubrey Sheet 1 of 2
C.L. Sta. 36400
Hole No. C-6 Drill No. _____ Location In _____
Type of Bit _____ Elevation of Top of Hole 556.4'
Size of Core 2-inch Depth of Overburden 43.0'
Method of Overburden Sampling Earth Auger Elevation of Top of Bedrock 513.4'
Set _____ of _____ Casing Pulled Casing Top () No ()
Depth to Water Table _____ Elevation of Water Table _____
Total Depth of Hole 68.0' Elevation of Bottom of Hole 488.4'
Overburden Sampling 43.0' Core Drilling 25.0' Recovery _____
Date Hole Started 16 January 1939 Date Hole Completed 18 January 1939
Number of Jars/Tubes None Marked Upper Elm Creek C.L. Sta. 36400
Classified by _____ Submitted by _____

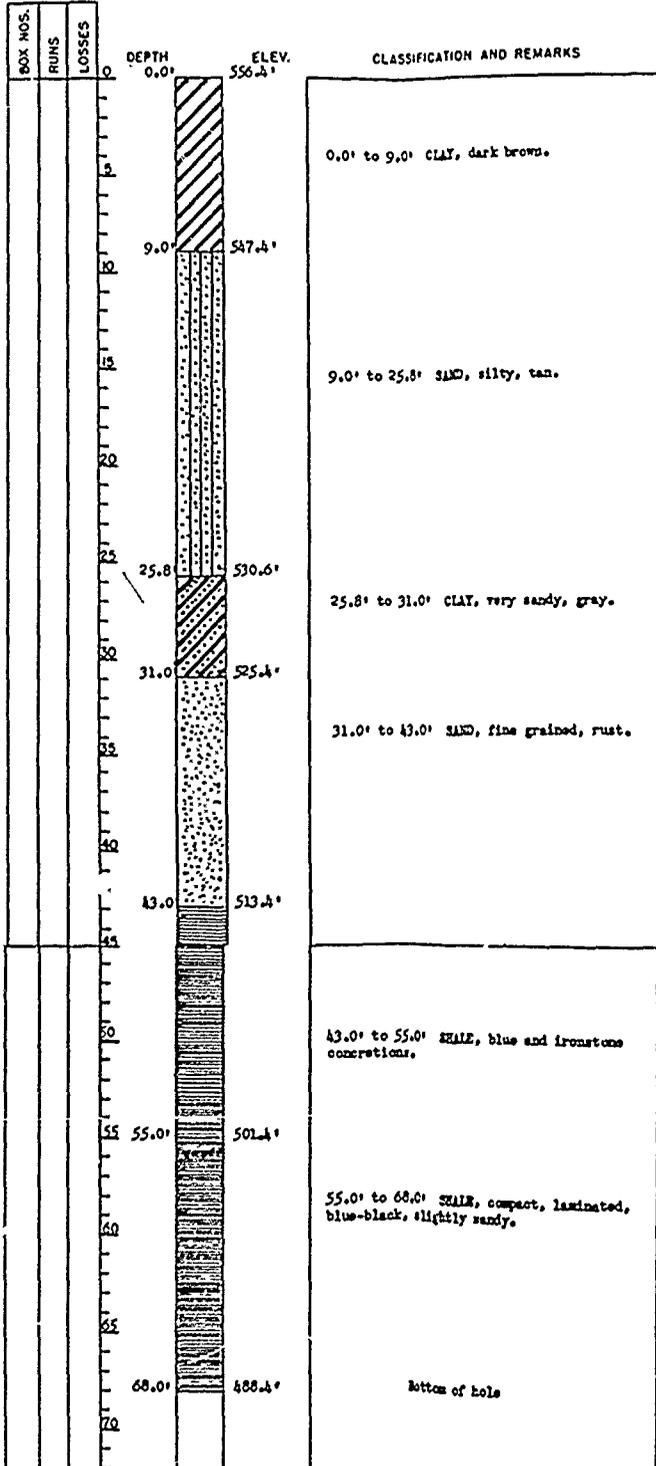


UNITED STATES ENGINEER OFFICE
ENGINEERING DIVISION
FIELD INVESTIGATIONS SECTION
GALVESTON, TEXAS

LOG OF CORE DRILLING

Date 20 August 1946

Site Aubrey Sheet 1 of 2
C.L. Sta. 45400
Hole No. C-7 Drill No. _____ Location In _____
Type of Bit _____ Elevation of Top of Hole 590.9'
Size of Core 2-inch Depth of Overburden 28.0'
Method of Overburden Sampling Earth Auger Elevation of Top of Bedrock 562.9'
Set _____ of _____ Casing Pulled Casing Top () No ()
Depth to Water Table _____ Elevation of Water Table _____
Total Depth of Hole 95.0' Elevation of Bottom of Hole 495.9'
Overburden Sampling 28.0' Core Drilling 67.0' Recovery _____
Date Hole Started 12 January 1939 Date Hole Completed 16 January 1939
Number of Jars/Tubes 1 Marked Upper Elm Creek C.L. Sta. 45400
Classified by _____ Submitted by _____

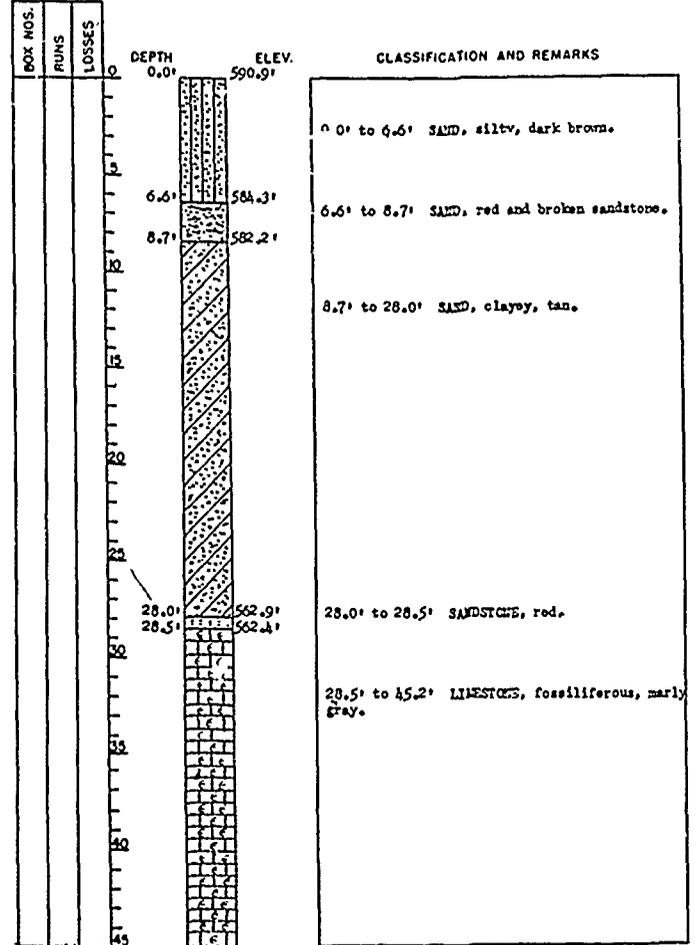

UNITED STATES ENGINEER OFFICE
ENGINEERING DIVISION
FIELD INVESTIGATIONS SECTION
GALVESTON, TEXAS

LOG OF CORE DRILLING

Date 20 August 1966
Sheet 1 of 2
Site Aubrey C.L. Sta. 45780
Drill No. C-7
Location In C.L. Sta. 45780
Elevation of Top of Hole 500.01
Depth of Overburden 28.01
Elevation of Top of Bedrock 522.91
Pulled Casing Yes () No ()
Elevation of Water Table 505.01
Elevation of Bottom of Hole 505.01
Core Drilling 67.01 % Recovery
Date Hole Completed 16 January 1939
Marked Upper Elm Creek C. L. Sta. 45780
Marked Lower Elm Creek C. L. Sta. 45780
Submitted by

Box No. C-7
Type of Bit
Size of Core 2-Inch
Method of Adv. Sampling Earth Auger
Depth to Water Table
Total Depth of Hole 95.01
Overburden Sampling 28.01
Date Hole Started 12 January 1939
Number of Jars/Tubes 1
Number of Boxes 2
Classified by



SM28-C-2

LOG OF CORE DRILLING CONTINUATION SHEET

Site Aubrey

Hole No. C-7

Sheet 2 of 2

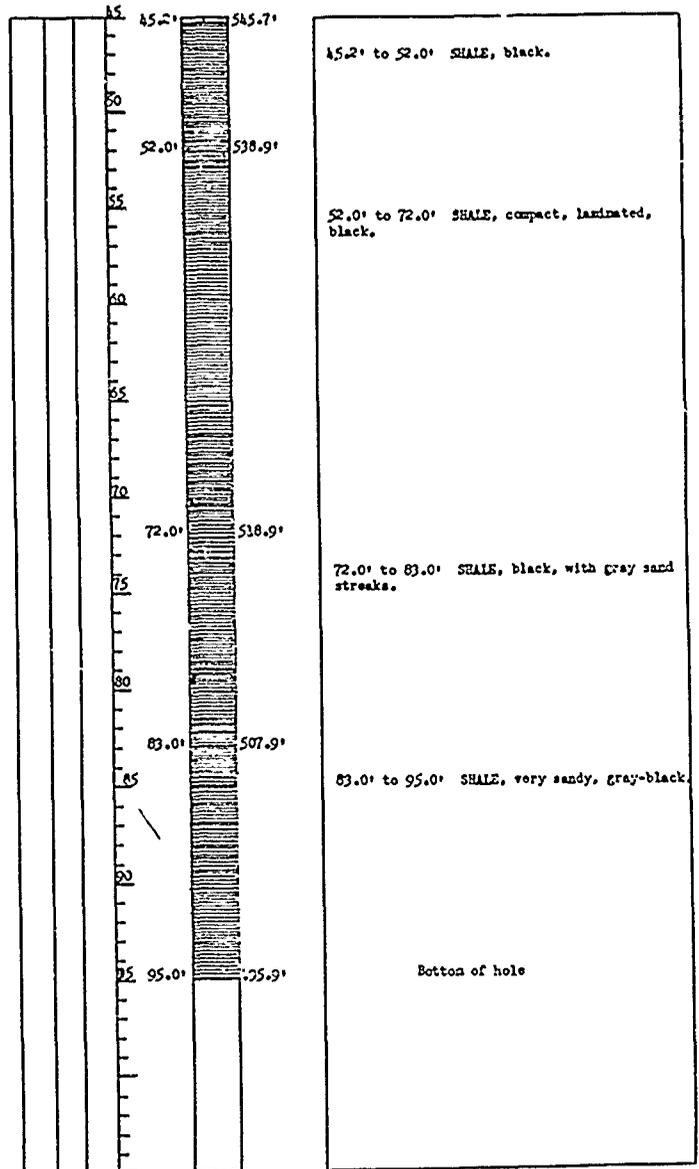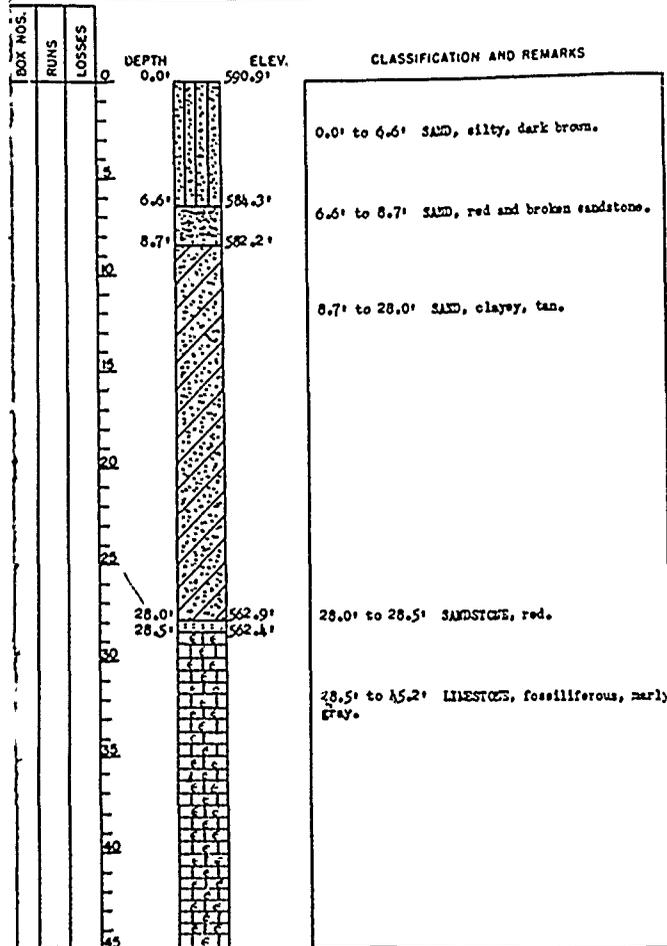

RECORD DRAWING-WORK AS BUILT

DESIGNED BY	RAY ROBERTS LAKE		
DRAWN BY	ELM FORK, TRINITY RIVER, TEXAS		
REVIEWED BY	EMBANKMENT, SPILLWAY AND		
	OUTLET WORKS		
	LOGS OF BORINGS		
	C-5, C-6 AND C-7		
SUBMITTED BY	INVITATION NO. DACW63-82-B-0025	DATE	MAR, 1962
ENGINEER	CONTRACT NO. DACW63-92-C-0095	SHEET NO.	10
	DRAWING NUMBER	OF	


TO ACCOMPANY FOUNDATION REPORT

SWR-C-1.

UNITED STATES ENGINEER OFFICE
ENGINEERING DIVISION
FIELD INVESTIGATIONS SECTION
GALVESTON, TEXAS

LOG OF CORE DRILLING


Site Aubrey Date 20 August 1946
 Hole No. C-8 Drill No. _____ Location Co. Ls. Sta. 51236
 Type of Bit _____ Elevation of Top of Hole 723.2'
 Size of Core 2-inch Depth of Overburden 17.0'
 Method of Ovb. Sampling Earth Auger Elevation of Top of Sadrack 706.2'
 Set _____ of Casing Pulled Casing Yes () No ()
 Depth to Water Table _____ Elevation of Water Table _____
 Total Depth of Hole 217.0' Elevation of Bottom of Hole 506.2'
 Overburden Sampling 17.0' Core Drilling 200.0' % Recovery _____
 Date Hole Started 12 January 1939 Date Hole Completed 30 January 1939
 Number of Jars/Tubes 1 Marked Upper Elm Creek C.L. Sta. 51236
 Number of Boxes 4 Marked Upper Elm Creek C.L. Sta. 51236
 Classified by _____ Submitted by _____

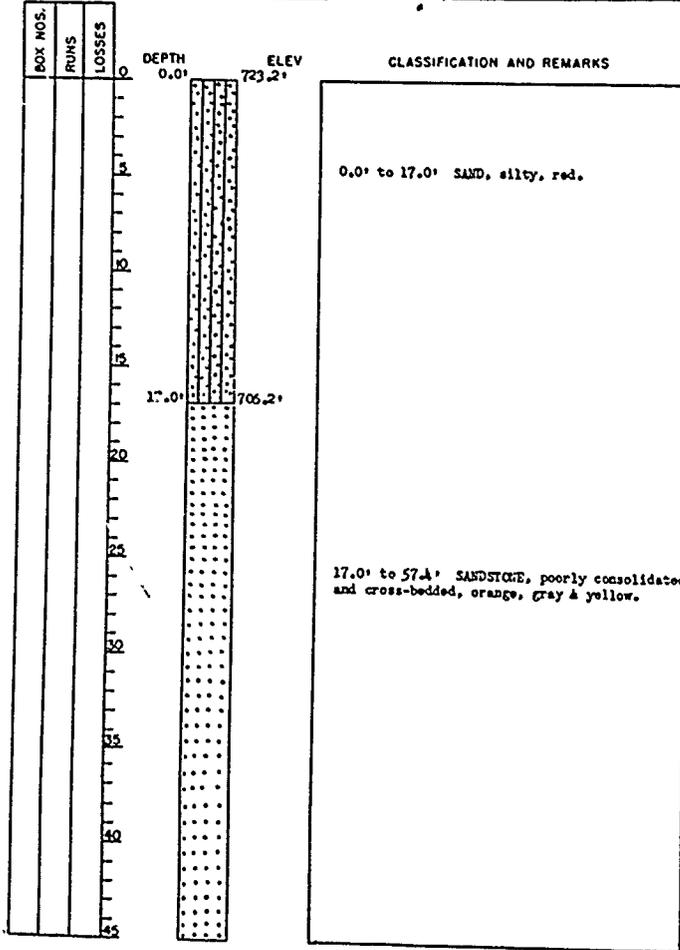

SWR-C-2.

LOG CORE DRILLING CONTINUATION SV

Site Aubrey Hole No. C-8

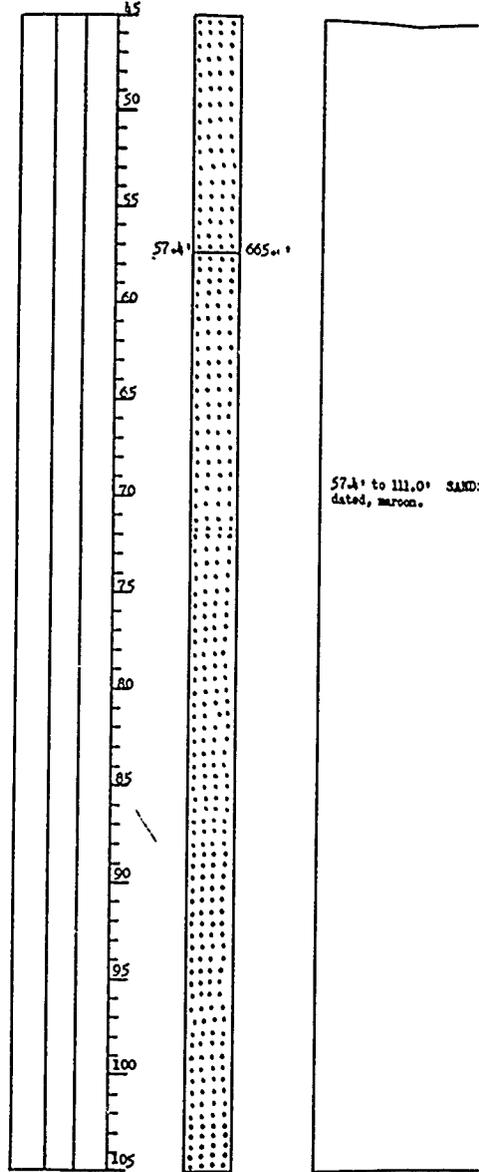

Hole No. C-8





Sheet 2 of 3



Site Aubrey

Hole No. C-8

Sheet 2 of 3

Site Aubrey

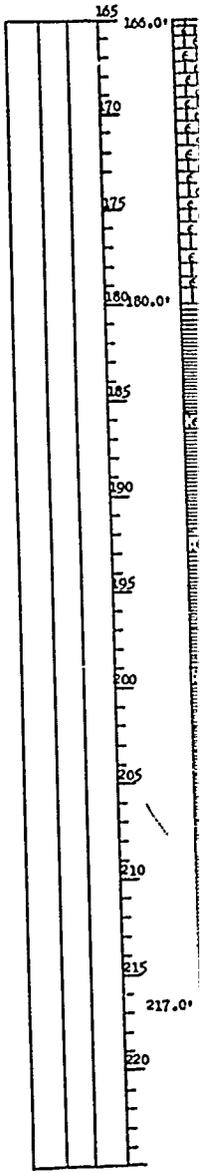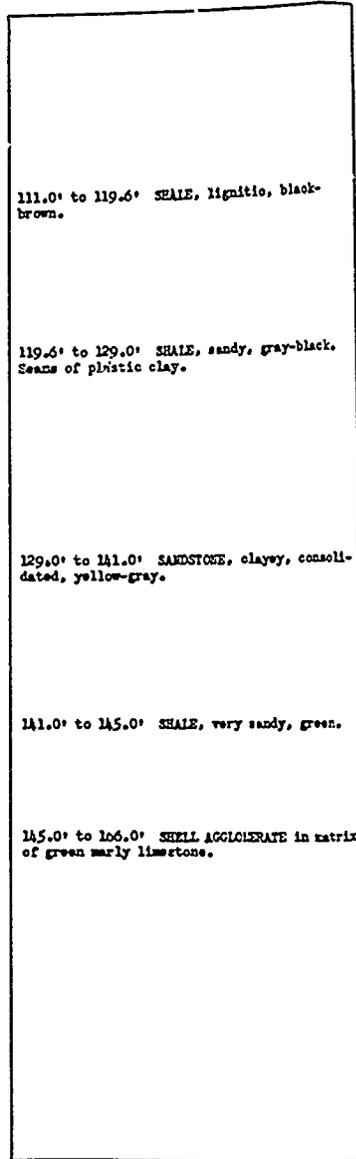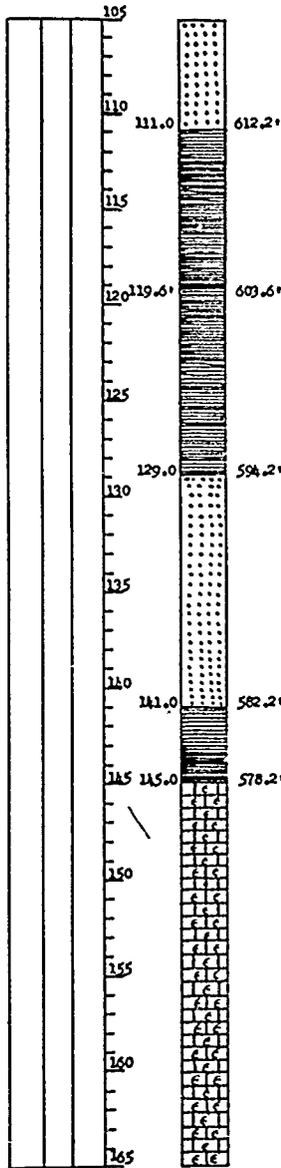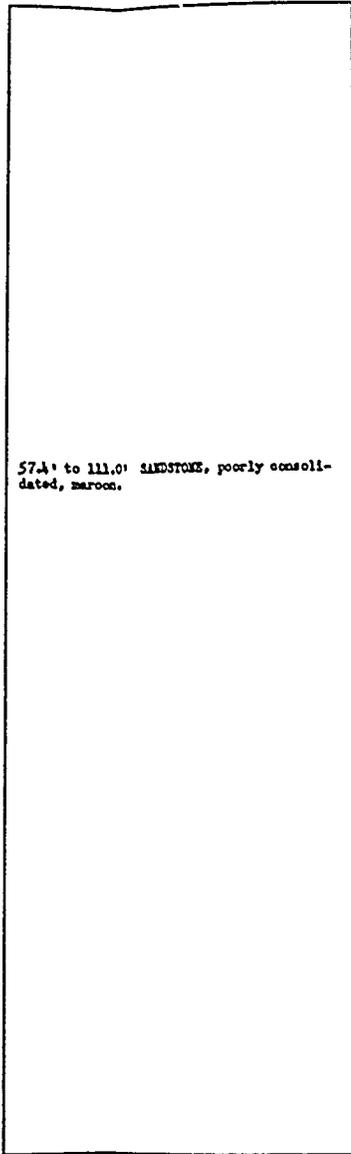

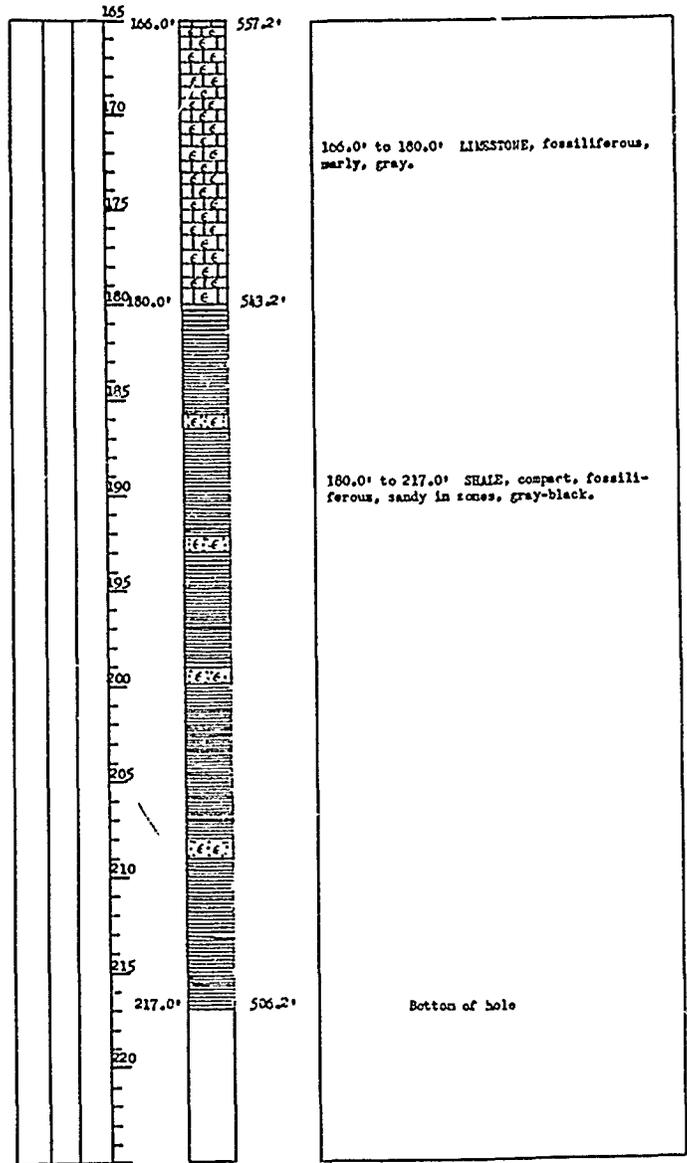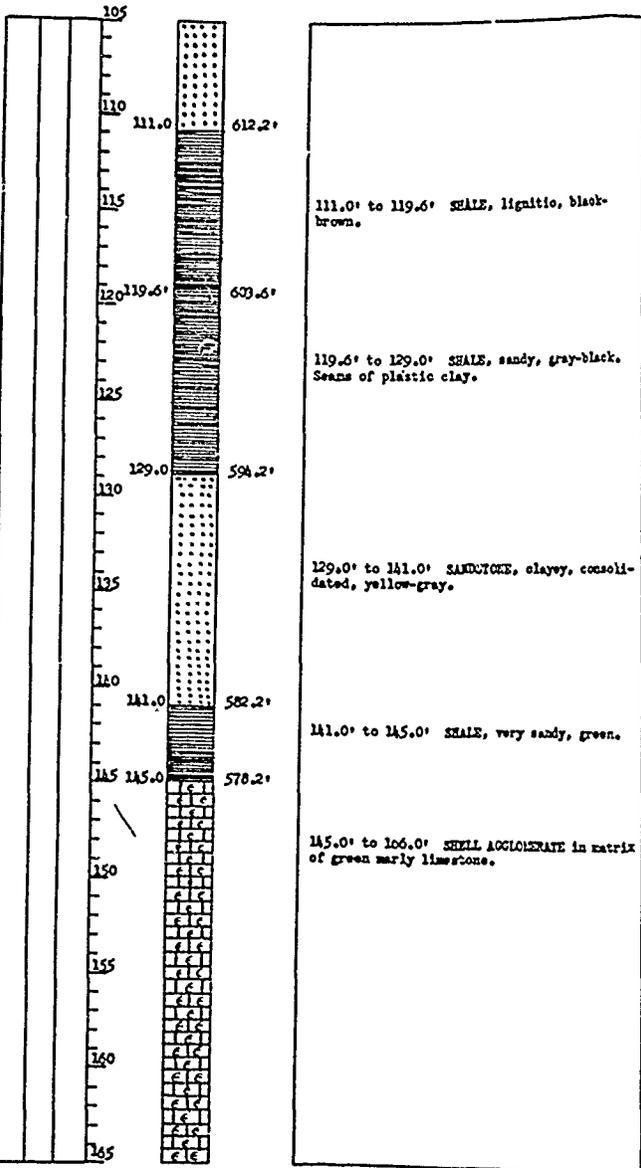

RECORD DRAWING - WORK AS BUILT

SYM	LOG NO	ACTION	DATE	DESCRIPTION OF REVISION
U.S. ARMY ENGINEER DISTRICT, FORT WORTH CORPS OF ENGINEERS FORT WORTH, TEXAS				
DESIGNED BY	RAY ROBERTS LAKE ELM FORK, TRINITY RIVER, TEXAS EMBANKMENT, SPILLWAY AND OUTLET WORKS LOGS OF BORINGS C-8			
DRAWN BY				
REVIEWED BY				
SUBMITTED BY				
ENGINEER	INVITATION NO. DACW63-82-B-0025	DATE: MAR, 1982	SEQUENCE NO. 11	
	CONTRACT NO. DACW63-72-C-0092		SHEET NO. OF 11	
	DRAWING NUMBER			

TO ACCOMPANY FOUNDATION REPORT

Hole No. 8A2C-9

DRILLING LOG			INSTALLATION		SHEET 1 OF 3 SHEETS	
1. PROJECT Aubrey Dam Site			Port Worth District		No. 8" Auger 2" Core Bbl	
2. LOCATION (Commodity or Feature)			II. DATE FOR ELEVATION (Month/Day/Year)		III. DATE FOR ELEVATION (Month/Day/Year)	
3. DRILLING AGENCY Corps of Engineers			IV. MANUFACTURER'S DESIGNATION - DRILL Falling 1500		V. TOTAL NO. OF OVERBURDEN SAMPLES TAKEN	
4. HOLE NO. (As shown on drawing note) and site number 8A2C-9			VI. TOTAL NUMBER CORE BOXES		VII. ELEVATION GROUND WATER	
5. NAME OF DRILLER R. M. Dunn			VIII. DATE HOLE STARTED		IX. DATE HOLE COMPLETED	
6. DIRECTION OF HOLE <input checked="" type="checkbox"/> Vertical <input type="checkbox"/> Inclined <input type="checkbox"/> Dev. from vert.			X. ELEVATION TOP OF HOLE		XI. TOTAL CORE RECOVERY FOR BORING	
7. THICKNESS OF OVERBURDEN			XII. SIGNATURE OF INSPECTOR			
8. DEPTH DRILLED INTO ROCK						
9. TOTAL DEPTH OF HOLE						
ELEVATION	DEPTH	LEGEND	CLASSIFICATION OF MATERIALS (Description)	1. CORE RECOVERY	2. CORE BOX NO.	REMARKS (Drilling time, water loss, depth of weathering, etc., if significant)
596.0'	4.5'		Start 2" core 4.5' to 3.9' limestone, marly, hard, siliceous, massive weathered, dark red oxidized streak from 8.0' to 8.4', gray to buff	75	Box 1	*Ground water elevation undetermined Jar Sample Depths A- 0.0 to 3.6' B- 3.6 to 4.3'
591.6'	8.9'		8.9 to 12.3 clay, shaly, sand lenses thru out, weathered, slightly laminated, tan to gray	80		
588.2'	12.3'		NOTE: Base of weathering zone	86		
30			12.3 to 96.5' shale, clayey, sandy, firm to medium hard, very fossiliferous, laminated, dark gray	86		
			NOTE: Medium hard sandstone streaks at following depths: 16.7 to 16.9 24.7 to 25.3 40.0 to 40.4 43.1 to 43.3 48.0 to 48.4 55.0 (Siltstone)	86	Box 2	
0				90		
				97		

ELEVATION	DEPTH	LEGEND	CLASSIFICATION OF MATERIALS (Description)	1. CORE RECOVERY	2. CORE BOX NO.
504.0'	96.5'		96.5' to 100.0' LIMESTONE sandy, hard, massive, fossiliferous, gray	100	Box 4
			100' to 106.0' SHALE, clayey firm, laminated, gray	40	Box 5
494.5'	106.0'		T. D. 106.0'		

3. CORE RECOVERY %	4. BOX NO.	5. REMARKS (Drilling time, water flow, depth of weathering, etc., if significant)
84	Box 3	
92		
90	Box 4	
88		
100		
40	Box 5	

Hole No. **8A2C-10**

DRILLING LOG		INSTALLATION		SHEET 1 OF 2 (INSETS)		
PROJECT: Southwestern		NAME: Fort Worth District		DATE: Aug 21		
LOCATION: Aubrey Dam Site		NO. AND TYPE OF BIT: 8" Auger 2" Core bit		DATE OF LOGGING: Aug 21		
DRILLING AGENCY: Corps of Engineers		MATERIALS: HSE		DESIGNATION OF DRILL: Falling 1500		
NAME OF DRILLER: R. M. Dunn		TOTAL NO. OF OVERBURDEN SAMPLES TAKEN: 3		UNDISTURBED: 0		
HOLE NO. (As shown on drawing and file number): 8A2C-10		TOTAL NUMBER CORE BOIES: 2		ELEVATION GROUND WATER: 0		
DIRECTION OF HOLE: <input checked="" type="checkbox"/> VERTICAL <input type="checkbox"/> INCLINED _____ DEG. FROM VERT.		DATE MOLE STARTED: 15 Dec 60		DATE MOLE COMPLETED: 15 Dec 60		
THICKNESS OF OVERBURDEN: 19.5		ELEVATION TOP OF HOLE: 610.8		TOTAL CORE RECOVERY FOR BORING: 50		
DEPTH DRILLED INTO ROCK: 45.5		SIGNATURE OF INSPECTOR: _____				
TOTAL DEPTH OF HOLE: 60.0						
ELEVATION	DEPTH	LEGEND	CLASSIFICATION OF MATERIALS (Description)	SCORE RECOVERY	BOX OR SAMPLE NO.	REMARKS (Drilling time, water flow, depth of weathering, etc., if significant)
						*Ground water elevation on 16 Dec 1960 was (8.0)
					A	
					D	Jar Sample Depths: A - 0.0' to 5.5' B - 5.5' to 10.4' C - 10.4' to 13.8'
					C	
596.3'	14.5'		Start 2" Core 14.5'			
			14.5' to 25.8' clay, shaly, firm, fine sand lenses thru out, soft sandstone; streak at 16.8, and 22.1, very hard limestone boulder at 17.6'; gray to yellow	72	Box 1	
				75		
585.0'	25.0'		25.8' to 41.8' SHALE, clayey firm weathering stains in upper 3.0'; sandy, laminated small fossils thru out dark gray	100		
			NOTE: Base of weathering at 29.0'. Lime seam at 35.0' which is 0.1 thick	90		
				95		
569.0'	41.8'		41.8' to 43.3' SAND, clayey, firm-almost sandstone, distinct bedding, fine to medium gray	100		
567.5'	43.3'		43.3' to 60.0' SHALE, clayey sandy firm to medium hard lime boulder at 44.8, very fossiliferous from 47.0 to 51.0, laminated, 4' sandstone at 58.0', dark gray	100		
				97	Box 2	
550.8'	60.0'		T. D. 60.0'			

Hole No. **8A2C-11**

DRILLING LOG		INSTALLATION		SHEET 1 OF 2 (INSETS)		
PROJECT: Southwestern		NAME: Fort Worth District		DATE: Aug 21		
LOCATION: Aubrey Dam Site		NO. AND TYPE OF BIT: 8" Auger 2" Core bit		DATE OF LOGGING: Aug 21		
DRILLING AGENCY: Corps of Engineers		MATERIALS: HSE		DESIGNATION OF DRILL: Falling 1500		
NAME OF DRILLER: R. M. Dunn		TOTAL NO. OF OVERBURDEN SAMPLES TAKEN: 3		UNDISTURBED: 0		
HOLE NO. (As shown on drawing and file number): 8A2C-11		TOTAL NUMBER CORE BOIES: 2		ELEVATION GROUND WATER: 0		
DIRECTION OF HOLE: <input checked="" type="checkbox"/> VERTICAL <input type="checkbox"/> INCLINED _____ DEG. FROM VERT.		DATE MOLE STARTED: 15 Dec 60		DATE MOLE COMPLETED: 15 Dec 60		
THICKNESS OF OVERBURDEN: 7.0		ELEVATION TOP OF HOLE: 610.8		TOTAL CORE RECOVERY FOR BORING: 50		
DEPTH DRILLED INTO ROCK: 23.6		SIGNATURE OF INSPECTOR: _____				
TOTAL DEPTH OF HOLE: 30.6						
ELEVATION	DEPTH	LEGEND	CLASSIFICATION OF MATERIALS (Description)	SCORE RECOVERY	BOX OR SAMPLE NO.	REMARKS (Drilling time, water flow, depth of weathering, etc., if significant)
						*Ground water elevation on 16 Dec 1960 was (8.0)
					A	
					D	Jar Sample Depths: A - 0.0' to 5.5' B - 5.5' to 10.4' C - 10.4' to 13.8'
					C	
605.2'	7.0'		Start 2" core 7.0'			
			7.0' to 14.4' clay, sandy, firm to medium very weathered, horizontal fractures, yellow to tan			
597.8'	14.4'		14.4' to 15.8' sandstone medium hard, fine to grain, massive, tan to gray			
596.4'	15.8'		15.8' to 22.5' shale, firm to medium hard, containing seams of sand and shale, weathered to gray.			NOTE: Base of weathering zone
589.7'	22.3'		22.5' to 30.6' shale, clayey, firm laminated, marine fossils, dark gray			T. D. 30.6'
581.6'	30.6'		T. D. 30.6'			

ENG FORM 1836 MAR 57 PREVIOUS EDITIONS ARE OBSOLETE

DESIGNED BY	_____
DRAWN BY	_____
REVIEWED BY	_____
SUBMITTED BY	_____
ENGINEER	_____

TO ACCOMPLISH

Hole No. **8A2C-10**

PROJECT Southwestern	INSTALLATION Fort Worth District	SHEET 1 of 2 sheets
1. PROJECT		
2. LOCATION (Commissary or Station)		
3. DRILLING AGENCY Corps of Engineers		
4. HOLE NO. (As shown on drawing and hole number)		
5. NAME OF DRILLER R. Dunn		
6. DIRECTION OF HOLE VERTICAL		
7. THICKNESS OF OVERBURDEN		
8. DEPTH DRILLED INTO ROCK		
9. TOTAL DEPTH OF HOLE		
10. DATE HOLE STARTED		
11. ELEVATION TOP OF HOLE		
12. TOTAL CORE RECOVERY FOR BORING		
13. SIGNATURE OF INSPECTOR		

DEPTH	LEGEND	CLASSIFICATION OF MATERIALS (Description)	SOIL CORE RECOVERY (%)	BOX OR SAMPLE NO.	REMARKS (Drilling time, water loss, depth of weathering, etc.; if significant)
0.0					*Ground water elevation on 16 Dec 1960 was 8.0'
0.0				A	
0.0				B	Jar Sample Depths: A - 0.0' to 5.5' B - 5.5' to 10.4' C - 10.4' to 13.8'
0.0				C	
4.5		Start 2" Core 14.5'			
16.5		16.5' to 25.8' clay, shaly, firm, fine sand lenses thru out, soft sandstone; streak at 16.8, and 22.1, very hard limestone boulder at 17.6'; gray to yellow	72	Box 1	
25.8		25.8' to 41.8' SHALE, clayey firm weathering stains in upper 3.0'; sandy, laminated small fossils thru out dark gray	75		
29.0		NOTE: Base of weathering at 29.0'. Lime seam at 35.0' which is 0.1' thick	100		
41.8		41.8' to 43.3' SAND, clayey, firm-almost sandstone, distinct bedding, fine to medium gray.	90		
43.3		43.3' to 60.0' SHALE, clayey, sandy firm to medium hard lime boulder at 44.8, very fossiliferous from 47.0 to 51.0, laminated, 4' sandstone at 58.0', dark gray	95		
60.0		T. D. 60.0'	97	Box 2	

Hole No. **8A2C-11**

PROJECT Southwestern	INSTALLATION Fort Worth District	SHEET 1 of 1 sheets
1. PROJECT		
2. LOCATION (Commissary or Station)		
3. DRILLING AGENCY Corps of Engineers		
4. HOLE NO. (As shown on drawing and hole number)		
5. NAME OF DRILLER R. Dunn		
6. DIRECTION OF HOLE VERTICAL		
7. THICKNESS OF OVERBURDEN		
8. DEPTH DRILLED INTO ROCK		
9. TOTAL DEPTH OF HOLE		
10. DATE HOLE STARTED		
11. ELEVATION TOP OF HOLE		
12. TOTAL CORE RECOVERY FOR BORING		
13. SIGNATURE OF INSPECTOR		

ELEVATION	DEPTH	LEGEND	CLASSIFICATION OF MATERIALS (Description)	SOIL CORE RECOVERY (%)	BOX OR SAMPLE NO.	REMARKS (Drilling time, water loss, depth of weathering, etc.; if significant)
605.2	7.0		7.0' to 14.4' clay, shaly, sandy, firm to medium hard, very weathered, horizontal fractures, yellow to tan	100		*Ground water elevation on 19 Dec 60 (10') Jar Sample Depths A - 0.0 to 3.5' B - 3.5' to 6.5'
597.8	14.4		14.4' to 15.8 sandstone, medium hard, fine to medium grain, massive, tan to gray	70		
596.4	15.8		15.8' to 22.5 shale, sandy, firm to medium hard, alternating seams of sand stone and shale, weathered tan to gray.	75		
589.7	22.5		NOTE: Base of weathering zone	95		
581.6	30.6		22.5' to 30.6 shale, clayey, sandy, firm laminated, few marine fossils, dark gray	88		
			T. D. 30.6'			

ENG FORM 1836 PREVIOUS EDITIONS ARE OBSOLETE PROJECT HOLE NO

RECORD DRAWING-WORK AS BUILT

DESIGNED BY	RAY ROBERTS LAKE ELM FORK, TRINITY RIVER, TEXAS		
DRAWN BY	EMBANKMENT, SPILLWAY AND OUTLET WORKS		
REVIEWED BY	LOGS OF BORINGS 8A2C-9, 8A2C-10, AND 8A2C-11		
SUBMITTED BY	INVITATION NO. DACW 63-22-B-0026	DATE: MAR 1962	SEQUENCE NO.
ENGINEER	CONTRACT NO. DACW 63-97-C-0093	DRAWING NUMBER	SHEET NO. 12

TO ACCOMPANY FOUNDATION REPORT

CONTINUED ON DACW 63-97-C-0093

DRILLING LOG		Southwestern		INSTALLATION		Fort Worth		SHEET 1 of 2 SHEETS	
PROJECT		Aubrey Dam Site No. 1		NO. SIZE AND TYPE OF BIT		8" auger, 5" carboloy, 0		DIAMOND	
LOCATION		Sta. 134.70 - Centerline		DATE FOR ELEVATION		5/77			
DRILLING AGENCY		Corps of Engineers		MANUFACTURER'S DESIGNATION OF DRILL		Falline 1500			
HOLE NO. FOR WHICH THIS LOG WAS MADE		816C-12		TOTAL NO. OF CORE SAMPLES TAKEN		5		0	
NAME OF DRILLER		Schonover		ELEVATION GROUND WATER		0000			
DIRECTION OF HOLE		VERTICAL		DATE HOLE STARTED		12 Nov 71		COMPLETED 4 Nov 71	
THICKNESS OF OVERBURDEN		13.7		ELEVATION TOP OF HOLE					
DEPTH DRILLED INTO ROCK		37.3		TOTAL CORE RECOVERY FOR BORING		96.8%			
TOTAL DEPTH OF HOLE		51.0		SIGNATURE OF INSPECTOR		H. W. ...			

ELEVATION	DEPTH	LEGEND	CLASSIFICATION OF MATERIALS (Description)	NO. OF CORE SAMPLES TAKEN	REMARKS (Drilling time, water loss, depth of casing, etc., if applicable)
0.0'	0.0'		SAND - - -	A	1. After completion, hole was bailed to 43.5'. Same level after 24 hours.
0.0	10.0		0.0 to 10.0 - fine to medium grained, trace clay, medium compact, all. moist, red.	B	
10.0	13.7		10.0 to 13.7 - fine to medium grained, trace of fine-grained, well-rounded gravel (-5%), medium compact to dense, all. moist, red.	C	2. Jars: A. 0.0 to 4.7 B. 4.7 to 5.2 C. 5.2 to 6.4 D. 6.4 to 10.0 E. 10.0 to 13.7
13.7	13.7		--- Refusal w/auger @ 13.7'	D	3. Cartons: 1. 14.2 to 15.1 2. 18.3 to 19.3 3. 23.5 to 24.5 4. 29.0 to 30.0 5. 35.7 to 36.7 6. 42.9 to 43.9 7. 48.3 to 49.1
13.7	13.7		13.7' to 26.4'	E	
13.7	18.7		13.7 to 23.3 - shaley, highly fossilif., m. hard, thick-bedded, unfractured and unjointed, all. stained to 22.0', gray.	L 1	4. 8" casing set to 14.3'.
18.7	23.3		23.3 to 26.4 - very hard, diamond bit used in this section.	2	5. Drilling methods: 1. 0.0 to 13.7 - 8" auger. 2. 13.7 to 23.3 - 6" carboloy 3. 23.3 to 26.4 - 6" diamond 4. 26.4 to 51.0 - 6" carboloy.
26.4	26.4		26.4' to 51.0'	3	
26.4	35.8		SANDS, non-calc., m. hard, no visible bedding, unjointed and unfractured, occas. siltstone concretions, black.	G. 1.1	
35.8	38.1			G. 0.4	
38.1	41.2			G. 0.3	
41.2	47.2			38.1	
47.2	51.0			L 0.6	
51.0	51.0			G. 0.7	
51.0	51.0			L 0.8	
51.0	51.0		T.D. - 51.0'	51.0	

DRILLING LOG		Southwestern		INSTALLATION		Fort Worth		SHEET 2 of 2 SHEETS	
PROJECT		Aubrey Dam Site No. 1		NO. SIZE AND TYPE OF BIT		8" auger, 5" carboloy, 0		DIAMOND	
LOCATION		Sta. 134.70 - Centerline		DATE FOR ELEVATION		5/77			
DRILLING AGENCY		Corps of Engineers		MANUFACTURER'S DESIGNATION OF DRILL		Falline 1500			
HOLE NO. FOR WHICH THIS LOG WAS MADE		816C-12		TOTAL NO. OF CORE SAMPLES TAKEN		5		0	
NAME OF DRILLER		Schonover		ELEVATION GROUND WATER		0000			
DIRECTION OF HOLE		VERTICAL		DATE HOLE STARTED		12 Nov 71		COMPLETED 4 Nov 71	
THICKNESS OF OVERBURDEN		43.0		ELEVATION TOP OF HOLE					
DEPTH DRILLED INTO ROCK		52.2		TOTAL CORE RECOVERY FOR BORING		95.2%			
TOTAL DEPTH OF HOLE		95.2		SIGNATURE OF INSPECTOR		H. W. ...			

ELEVATION	DEPTH	LEGEND	CLASSIFICATION OF MATERIALS (Description)	NO. OF CORE SAMPLES TAKEN	REMARKS (Drilling time, water loss, depth of casing, etc., if applicable)
0.0'	0.0'		CLAY - - -		
0.0	6.6		0.0 to 6.6 - non-calc., moist, stiff to hard, scattered rootlets, black.		
6.6	12.6		6.6 to 12.6 - non-calc., moist, all. sandy, hard, scattered rootlets, dk. brown.		
12.6	22.6		12.6 to 22.6 - calc., sandy, hard to 22.6', stiff from 22.6' to 24.6', moist, tan.		
22.6	28.6		22.6' to 28.6'		
28.6	28.6		SAND, all. clayey, non-calc., moist, medium compact, tan.		
28.6	39.6		28.6' to 39.6'		
39.6	39.6		CLAY, sandy, all. calc., moisture increasing with depth, hardness decreasing with depth, saturated from 36.6', tan.		
39.6	39.6		-- Drilled into sandy gravel @ 39.6' with d. bbl. -- -- Start 8" auger @ 39.6' --		
39.6	43.0		39.6' to 43.0'		
43.0	43.0		GRAVEL, fine to medium grained, sandy, water-bearing, loose to medium dense.		

1	INSTALLATION	Port Worth
2	SIZE AND TYPE OF BIT	8" SUGAR, 6" d.b., 6" ESTHOL
3	DATE	Starting 1900
4	TOTAL LENGTH OF OPEN	19
5	TOTAL NUMBER CORP. BOIES	9
6	DATE	18 Nov 71
7	ELEVATION TOP OF HOLE	592.79
8	TOTAL CORE RECOVERY FOR BONES	88.5%
9	NAME OF INSPECTOR	[Signature]

DEPTH	DESCRIPTION OF MATERIALS	REMARKS
0.0 to 2.6'	1. After completion, hole was bailed to 90.0'. Water level will be set in at later date.	
2.6 to 6.6'	2. Jar: A. 0.0 to 2.6	
6.6 to 12.6'	3. Denison samples: 1. 2.6 to 4.6 2. 4.6 to 6.6 3. 6.6 to 8.6 4. 8.6 to 10.6 5. 10.6 to 12.6	
12.6 to 28.6'	4. Cartons: 1. 4.6 to 47.6 2. 47.6 to 51.8 3. 51.8 to 60.2 4. 60.2 to 65.7 5. 65.7 to 72.5 6. 72.5 to 77.9 7. 77.9 to 85.4 8. 85.4 to 94.4	
28.6 to 39.6'	5. 8" casing set to 43.0'	
39.6 to 43.0'	6. Drilling methods: 1. 0.0 to 2.6 - sugar 2. 2.6 to 39.6 - 6" d.b.	

ELEVATION	DEPTH	LEGEND	CLASSIFICATION OF MATERIALS	REMARKS
45.0'	45.0'	[Symbol]	Augered into primary material 43.0' - Set casing to 45.0', cleaned out, and started 6" core at 45.0'	3. 39.6 to 45.0 - auger 4. 45.0 to 95.2 - 6" carbonyl.
45.0'	45.0' to 93.4'	[Symbol]	SHALE, non-calc. to sil. calc. with depth, m. hard black to gray.	NOTE: Actual core loss from 45.0' to 53.2' was 14.6%. Hole tap for depth at 53.2'. Loss possibly occurred from 50.5 to 52.0, drilling was very rough in this zone. 53.2 to 95.2 - core recovery was 98%
45.0'	45.0 to 57.2	[Symbol]	45.0 to 57.2 - thin to medium bedded, with core separating at sand seams listed below.	
57.2'	57.2 to 93.4	[Symbol]	57.2 to 93.4 - core recovered from bb'l. as continuous stalks	
57.2'	57.2 to 61.2	[Symbol]	Sandstone, fine-grained, friable, laminated, following depths: 45.0 to 45.3, 45.6 (0.1) 51.3 to 52.3, 53.3 (0.1) 54.2 (0.1), 55.4 (0.1) 55.6 (0.1)	
61.2'	61.2 to 61.7	[Symbol]	61.2 to 61.7 - zone of numerous broken shells.	
61.2'	61.2 to 61.7	[Symbol]	61.2 to 61.7 - zone of numerous broken shells.	*** Marker bed - see 60C-14 at 56.2 to 56.8
62.8'	62.8 to 93.4	[Symbol]	From 62.8 to 93.4 - occas. thin, poorly-defined, friable sandstone seams.	
93.4'	93.4 to 95.2'	[Symbol]	LIMESTONE, shaley, sil. nodular, fossilif., hard gray.	*** Marker bed see 60C-14 at 88.4'
95.2'	95.2'	[Symbol]	T.D. - 95.2'	

SYNOPSIS	
DESIGNED BY	
REVISION BY	
REVIEWED BY	
SUBMITTED BY	
APPROVED BY	

ELEVATION	DEPTH	LEGEND	CLASSIFICATION OF MATERIALS (Description)	SCORE RECORDED BY	BOX OR SAMPLE NO.	REMARKS (Drilling time, water loss, depth of penetration, etc.)
			-- Augered into primary material @ 43.0' -- Set casing to cleaned out, and started 6" core @ 45.0'			3. 39.6 to 45.0 - surty L. 45.0 to 95.2 - 6" carbology.
	45.0'		45.0' to 93.4'	hsc		
			SHALE, non-calc. to all calc. with depth, m. hard, black to gray.	L c7	1	NOTE: Actual core loss from 45.0' to 53.2' was 12.6%. Hole top for depth at 53.2'. Loss possibly occur from 50.5 to 52.0, drilling was very rough in this zone.
	50.0		45.0 to 57.2 - thin to medium bedded, with core separating at sand seams listed below.	L c5		53.2 to 95.2 - core recovery was 98%
			57.2 to 93.4 - core removed from bb'l. as continuous stalks	53.2 09	2	
			Sandstone, fine-grained, friable, laminated, @ following depths: 45.0 to 45.3, 45.6 (0.1) 51.3 to 52.3, 53.3 (0.1) 54.2 (0.1), 55.4 (0.1) 55.6 (0.1)	57.2 09	3	
	50.0		@ 58.8' - 0.05 seam of broken shells.	L c12		
			61.2 to 61.7 - zone of numerous broken shells	L c12	4	*** Marker bed - see 6DC-14 at 56.2 to 56.8
			From 62.8' to 93.4' - occas. thin, poorly- defined, friable sand seams.	L 11 62.8	5	
	70.0			G 04		
				73.2	6	
				L c1		
				77.2		
				G c1	7	
				81.2		
				L 01		
				85.2	8	
				L 02		
				89.2		
				L 03	9	
			93.4' to 95.2'	93.4 95.2		*** Marker bed see 6DC-14 at 88.4'
			LIMESTONE, shaley, all. nodular, fossilif., hard gray.	93.4 95.2		
			T.D. - 95.2' -			

RECORD DRAWING - WINK & RUIJL

SYMBOL NO.		ACTION		DATE		DESCRIPTION OF REV. NO.	
U.S. ARMY ENGINEER DISTRICT, FORT WORTH CORPS OF ENGINEERS FORT WORTH, TEXAS							
DESIGNED BY	RAY ROBERTS LAKE ELM FORK, TRINITY RIVER, TEXAS EMBANKMENT, SPILLWAY AND OUTLET WORKS LOGS OF BORINGS 8A6C-12 AND 6DC-13						
DRAWN BY							
REVIEWED BY							
SUBMITTED BY	INVITATION NO. SACWDS-820-0025		DATE MAR. 1982				
ENGINEER	CONTRACT NO. SACWDS-F4C-0013		SHEET NO.		13		

TO ACCOMPANY FOUNDATION REPORT

DRILLING LOG		Southwestern		Installation		Fort Worth		SHEET 1 of 3 SHEETS	
PROJECT		Aubrey Dam Site No. 1		LOG SITE AND TYPE OF BIT		8" ALUM., 6" d.b., 6" Core			
LOCATION (Coordinates or Name)				LOG SITE ELEVATION (TO CENTER OF WELL)					
DRILLING AGENCY		Corps of Engineers		BENCHMARK IDENTIFICATION OF WELL		Falling 1500			
WELL NO. (As shown on existing plans and site number)		60C-14		TOTAL NO. OF CUTS		DISTURBED		UNDISTURBED	
				BURDEN IN PILES TAKEN		16		17	
NAME OF DRILLER		Suitts		TOTAL NUMBER CORE BORES		--		--	
DIRECTION OF HOLE		Vertical		ELEVATION GROUND WATER		6000			
				DATE MOLE		28 Sep 71		1 Oct 71	
THICKNESS OF OVERBURDEN		45.3		ELEVATION TOP OF HOLE		559.5			
DEPTH DRILLED INTO ROCK		44.7		TOTAL CORE RECOVERY FOR BORING		99.0%			
TOTAL DEPTH OF HOLE		90.0		SIGNATURE OF SUPERVISOR		James D. Williams			

ELEVATION	DEPTH	LEGEND	CLASSIFICATION OF MATERIALS (Description)	NO. OF CORE RECOVERED	NO. OF SAMPLES	REMARKS (Drilling time, water loss, depth of measurement, etc., all as applicable)
0.0'	38.6'		CLAY - - -	A	1	1. After completion, was bailed to 89.0' casing; was pulled. hour water check -
0.0	18.6		calc., moist, hard, scattered rootlets to 8.6', tan.	2	2. Jars: A. 0.0 to 2.6	
18.6	38.6		calc., sandy, stiff, with hardness decreasing with depth, moist to very moist, tan.	3	3. Denison cans:	
				4	1. 2.6 to 4.6	
				5	2. 4.6 to 6.6	
				6	3. 6.6 to 8.6	
				7	4. 8.6 to 10.6	
				8	5. 10.6 to 12.6	
				9	6. 12.6 to 14.6	
				10	7. 14.6 to 16.6	
				11	8. 16.6 to 18.6	
				12	9. 18.6 to 20.6	
				13	10. 20.6 to 22.6	
				14	11. 22.6 to 24.6	
				15	12. 24.6 to 26.6	
				16	13. 26.6 to 28.6	
				17	14. 28.6 to 30.6	
				18	15. 30.6 to 32.6	
				19	16. 32.6 to 34.6	
				20	17. 34.6 to 36.6	
				21	18. 36.6 to 38.6	
				22	4. Penetrator tests on bottom of cans:	
				23	Cans 1 thru 7 - 4.5	
				24	8. 2.75	
				25	9. 1.75	
				26	10. 2.5	
				27	11. 2.0	
				28	12. 1.5	
				29	13. 1.25	
				30	14. 1.0	
				31	15. 2.0	
				32	16. 1.0	
				33	17. N.A.	
				34	5. All core was wrapped in aluminum foil and placed in cartons. Depths shown on p. 2	
				35	6. 8" casing set to 46.0'.	

ELEVATION	DEPTH	LEGEND	CLASSIFICATION OF MATERIALS (Description)	SCORE
38.6'	44.2'		SAND and GRAVEL, (recovered only trace in bottom of can 17.), logged by drill action and cutting.	51.2
			--- Drilled into primary material @ 44.2', set casing to 46.0', cleaned out, and started 8" core @ 47.2' -	51.2
47.2'	88.1'		SPALE, all. to non-calc., sandy, hard (pen. # 4.5) thin to medium bedded to 75.1', thick-bedded from 75.1' to 88.4', unjointed and unfractured, unweathered, gray.	55.2
			Sedimentary features:	59.2
			Sandstone beds at the following depths:	59.2
			47.5 to 47.8, 48.0 to 48.2, 48.5 to 48.9, 49.4 to 49.5, 50.7 to 51.1, 51.3 to 51.6, 59.1 to 59.3, 62.8 to 62.9, 64.8 to 65.0, 65.6 to 65.8, 67.4 to 67.6, 70.8 to 70.9, 71.3 to 71.5, 73.0 to 73.1, 74.7 to 74.9, 79.1 to 79.2, 81.2 to 81.4. Most beds were soft and crumbly, crushed with moderate amount of finger pressure.	71.2
			56.2 to 56.8 - highly fossiliferous section, very calc. Possible marker bed - see 60C-15	71.2
			Structural features:	75.2
			None	79.2
88.4'	90.0'		LIMESTONE, all. shaly, nodular, fossiliferous, hard, gray.	83.2
			T.D. - 90.0' -	90.0

Core was separated at the following:

47.5, 47.9, 48.3, 49.0, 49.4, 50.0, 51.0, 51.1, 51.4, 51.6, 53.2, 54.0, 59.0, 60.1, 61.2, 62.0, 62.8, 63.0, 64.8, 65.0, 65.6, 67.2, 67.4, 71.3, 71.5, 72.0, 74.6, 74.9, 75.1, was removed as continuous talks

POSITION Southwestern	INSTALLATION Fort Worth	SHEET 2 OF 2 SHEETS
NO. 1	SIZE AND TYPE OF BIT 8" SURF, 6" d.b., 6" carbide core	
	MANUFACTURER'S DESIGNATION OF DRILL Palling 1500	
LINEAR 6DC-15	TOTAL NO. OF OVERBURDEN SAMPLES TAKEN 16	UNSTUPPED 16
	TOTAL NUMBER CORE BORES 5	
	ELEVATION GROUND WATER 6000	
	DATE HOLE STARTED 21 Sept. 71	DATE HOLE STOPPED 24 Sept. 71
	ELEVATION TOP OF HOLE 588.48	
	TOTAL CORE RECOVERY FOR BORING 41.0%	
	SIGNATURE OF INSPECTOR <i>Blues...</i>	

CLASSIFICATION OF MATERIAL (Description)	1. CORE RECOVERY %	2. BOR OR SAMPLE NO.	REMARKS (Drilling time, water used, depth of penetration, etc., if significant)
0.0' to 38.7'		A	1. After completion, casing pulled, and hole bailed to 55.0'. Water check after 24 hrs. was 24.0'.
CLAY, calc., sil. moist to 6.7', with gradual moisture increase with depth, hard to 8.7' with strength decreasing with depth (Note penetrometer tests in remarks column), brown to tan.		1	2. Jars: A. 0.0 to 2.7 Jar samples taken from Denison bb'l shoe except where noted by an asterisk.
		2	
		3	
		4	
		5	3. Denison cans. Depth Pen. test
		6	1. 2.7 - 4.7 4.5
		7	2. 4.7 - 6.7 4.25
		8	3. 6.7 - 8.7 4.5
		9	4. 8.7 - 10.7 4.25
		10	5. 10.7 - 12.7 "
		11	6. 12.7 - 14.7 "
		12	7. 14.7 - 16.7 3.75
		13	8. 16.7 - 18.7 "
		14	9. 18.7 - 20.7 "
		15	10. 20.7 - 22.7 "
		16	11. 22.7 - 24.7 3.0
		17	12. 24.7 - 26.7 "
		18	13. 26.7 - 28.7 "
		19	14. 28.7 - 30.7 2.75
		20	15. 30.7 - 32.7 1.75
		21	16. 32.7 - 34.7 1.75
		22	Note: Can #8 - sample slipped out on initial retrieve and was not covered on second attempt. Can #15 - poor recovery. Lost 1.0'
		23	
		24	4. Cartons: 1. 41.1 to 41.9
		25	2. 47.5 to 48.5
		26	3. 52.2 to 53.2
		27	4. 56.8 to 57.7
		28	5. 58.5 to 59.5
		29	5. 8" casing set to 40.0'.
		30	6. Drilling methods: 1. 0.0 to 2.7 - 8" auger 2. 2.7 to 40.7 - d. bit 3. 40.7 to 61.2 - 6" core
34.7' to 38.7' - no recovery except for a fine to med. grained sand from 38.2' to 38.7' loose, trace clay, gray.		31	
--- Drilled into primary material @ 38.7', set casing to 40.0', cleaned out, and started 6" core @ 40.7' ---		32	
40.7' to 61.2'	40.7	40.7	
SPALLS, sil. to non-calc. sandy, hard (pen. 4.5), medium to thin-bedded, unjointed and unfractured (except where noted) unweathered, gray.	45.2	1	Structural features: In the upper 10ft., core seems to have a slight dip (approx. 5°).
Sedimentary features: Sandstone at the following depths: 42.6 to 43.3 - laminated shaly, sil. fissile, crumbly. 43.3 to 44.0 - scattered concretions. 53.2 to 53.4 - laminated, shaly, sil. fissile. 55.0 to 56.1 - laminated, shaly, sil. fissile.	49.2	2	0.2' fracture with poorly formed slickensides at 56.2'.
48.5 to 49.1 - highly fossilif. (broken shells), calc. possible marker bed	57.2	3	
T.D. - 61.2'	61.2	5	See 6DC-14, 56.2 to 57.8

RECORD DRAWING - JOHN A. HULL

DESIGNED BY	U.S. ARMY ENGINEER DISTRICT, FORT WORTH CORPS OF ENGINEERS FORT WORTH, TEXAS		
DRAWN BY	RAY ROBERTS LAKE ELM FORK, TRINITY RIVER, TEXAS EMBANKMENT, SPILLWAY AND OUTLET WORKS LOGS OF BORINGS 6 DC-14 AND 6 DC-15		
REVIEWED BY	INVESTIGATION NO. DACW63-82-E-0025	DATE MAR. 1982	SEQUENCE NO. 14
SUBMITTED BY	CONTRACT NO. DACW63-82-C-0083	DRAWING NUMBER	SHEET NO. 14

TO ACCOMPANY FOUNDATION REPORT

DRILLING LOG

WELL NO. 60C-16

PROJECT: AUBREY DAM SITE NO. 1

LOCATION: (Coordinates or Stationing)

DRILLING AGENCY: Goff's of Engineers

HOLE NO. (As shown on drawing sheet and log number): 60C-17

NAME OF DRILLER: Schoonover

DIRECTION OF HOLE: VERTICAL INCLINED (SEE FROM VIEW)

THICKNESS OF OVERBURDEN: 35.0'

DEPTH DRILLED INTO ROCK: 12.0'

TOTAL DEPTH OF HOLE: 50.0'

INSTALLATION: Fort Worth

MICROTYPE OF BIT: 8" ALUMINUM

MANUFACTURER'S DESIGNATION OF DRILL: Palling 1500

TOTAL NO. OF CORES OBTAINED: 1

TOTAL NUMBER CORE BOSES: 4

ELEVATION OF GROUND WATER: 0.00

DATE HOLE STARTED: 17 Sept. 71

THICKNESS OF OVERBURDEN: 23.5'

DEPTH DRILLED INTO ROCK: 26.5'

TOTAL DEPTH OF HOLE: 50.0'

CLASSIFICATION OF MATERIALS

ELEVATION: 559.66

DEPTH: 0.0'

LEGEND: A

CLASSIFICATION OF MATERIALS: CLAY; SILTY, S&M; MOIST; HARD; ROOT ZONE; DARK BROWN

REMARKS: I. DRILLING: 8" FLIGHT AUGER. 0.0' - 2.6' 6" DENISON. 2.6' - 32.6' NOTE: SAMPLES BECAME DISTURBED AT 24.0' - 28.0' & AT 30.0' - 32.0'. THE SAMPLES WERE TAKEN 8" FLIGHT AUGER. 32.6' - 41.0' CLEANED OUT WITH 10" AUGER & SET CASING TO 41.0'. CLEANED OUT WITH 8" AUGER TO 42.0'. 6" CORE BARREL. 42.0' - 50.0'

II. SAMPLES: A: 4.6' B: 6.6' C: 8.6' D: 10.6' E: 12.6' F: 14.6' G: 16.6' H: 18.6' I: 20.6' J: 22.6' K: 24.6' L: 26.6' - 28.6' M: 30.6' - 32.6' N: 32.6' - 37.0' O: 38.0' - 40.5' P: 40.5' - 42.0' L: 2.6' - 4.6' 2: 4.6' - 6.6' 3: 6.6' - 8.6' 4: 8.6' - 10.6' 5: 10.6' - 12.6' 6: 12.6' - 14.6' 7: 14.6' - 16.6' 8: 16.6' - 18.6' 9: 18.6' - 20.6' 10: 20.6' - 22.6' 11: 22.6' - 24.6' 12: 24.6' - 30.6' C-1: 41.0' - 45.0' C-2: 45.0' - 50.0'

III. WATER LEVEL: FLOWING BUILT TO 24.0' IN K. SEPT. 71 & CHECKED AFTER 24 HOURS. WATER LEVEL AT 24.0'

IV. DEPTH & WIDTH: MAX. WIDTH TO 38.0'

V. MISC: POCKET PENETROMETER READINGS ARE IN COLUMN 6. ALSO THE SAMPLES WERE TAKEN FROM DENISON SHALE.

CLASSIFICATION OF MATERIALS: CLAY; SILTY, S&M; MOIST; HARD; ROOT ZONE; DARK BROWN

CLASSIFICATION OF MATERIALS: CLAY; WITH TRACE OF SILT; W/ CALC. NODULES; W/ ORGANIC MATTER; MOIST; HARD; BROWN

CLASSIFICATION OF MATERIALS: CLAY; SILTY, S&M; W/ CALC. NODULES; MOIST; V. STIFF; BROWN TO CLAY BROWN

CLASSIFICATION OF MATERIALS: CLAY; WITH TRACE OF SILT; FINE SAND; MOIST; V. STIFF; BROWN-TAN

CLASSIFICATION OF MATERIALS: CLAY; SILTY, S&M; MOIST; V. STIFF; BROWN-TAN

CLASSIFICATION OF MATERIALS: SAND; CLAYEY; W/ SOFT GRAVEL; FINE TO MED GRAIN; MOD. FINE

CLASSIFICATION OF MATERIALS: SAND; RUST BROWN; 38.0' TO 40.5'

CLASSIFICATION OF MATERIALS: SANDSTONE; SHADY SHALE; UNWEATHERED; SORT THIN SS. PLACES ALTERNATING WITH SORT SANDY SHALE; MOIST; BLUE GRAY

CLASSIFICATION OF MATERIALS: SHALE; ESS. UNWEATHERED; W/ SANDY LAMINATIONS; W/ SCAT. SIL. CONCRETIONS; MOIST; SIL. MOIST; SORT (POCK CLASS); BLUE GRAY

CLASSIFICATION OF MATERIALS: T.D. 50.0'

DRILLING LOG

WELL NO. 60C-16

PROJECT: AUBREY DAM SITE NO. 1

LOCATION: (Coordinates or Stationing)

DRILLING AGENCY: Goff's of Engineers

HOLE NO. (As shown on drawing sheet and log number): 60C-17

NAME OF DRILLER: Schoonover

DIRECTION OF HOLE: VERTICAL INCLINED (SEE FROM VIEW)

THICKNESS OF OVERBURDEN: 23.5'

DEPTH DRILLED INTO ROCK: 26.5'

TOTAL DEPTH OF HOLE: 50.0'

INSTALLATION: Fort Worth

MICROTYPE OF BIT: 8" ALUMINUM

MANUFACTURER'S DESIGNATION OF DRILL: Palling 1500

TOTAL NO. OF CORES OBTAINED: 1

TOTAL NUMBER CORE BOSES: 4

ELEVATION OF GROUND WATER: 0.00

DATE HOLE STARTED: 17 Sept. 71

THICKNESS OF OVERBURDEN: 23.5'

DEPTH DRILLED INTO ROCK: 26.5'

TOTAL DEPTH OF HOLE: 50.0'

CLASSIFICATION OF MATERIALS

ELEVATION: 559.66

DEPTH: 0.0'

LEGEND: A

CLASSIFICATION OF MATERIALS: 0.0' to 5.5'

REMARKS: SAND, fine-grained, clayey, hard, sil. moist, brown.

CLASSIFICATION OF MATERIALS: 5.5' to 22.0'

REMARKS: CLAY, sandy, non-calc., sil. moist, hard, mottled tan and gray.

CLASSIFICATION OF MATERIALS: 22.0' to 23.5'

REMARKS: CLAY, calc., w/ scattered gravel and well-rounded siltstone concretions, moist, medium to stiff, tan.

CLASSIFICATION OF MATERIALS: 26.2' to 50.0'

REMARKS: SHALE, sandy, non-calc., hard (penetrometer 4.5), thin-bedded, fossilifer, unjointed and unfractured to T.D., unweathered, gray.

CLASSIFICATION OF MATERIALS: Sandstone concretions avg. 0.1' in thickness at the following depths: 28.5', 29.3', 30.3', 31.2', 37.9'

CLASSIFICATION OF MATERIALS: Shaley sandstone beds at the following depths: 27.0 to 27.4 - laminar 36.8 to 37.1 - " 42.0 to 42.9 - " and all fissile. Zone badly washed by core bit, action.

T.D. - 50.0'

REMARKS: 1. After core bit was pulled, 45.0' with 2" check. 2. Jar A. 0.0 to 2.7 to 4.7 to 6.7 to 8.7 to 10.7 to 12.7 to 14.7 to 16.7 to 18.7 to 20.7 to 22.7 to 24.7 to 26.7 to 28.7 to 30.7 to 32.7 to 34.7 to 36.7 to 38.7 to 40.7 to 42.7 to 44.7 to 46.7 to 48.7 to 50.0'

REMARKS: 4. Cartons: 1. 27.4 to 28.5 2. 31.6 to 33.1 3. 38.8 to 43.8 4. 49.0 to 50.0'

REMARKS: 5. Shale west 24.9'.

REMARKS: 6. 8" casing 25.0'.

REMARKS: 7. Drilling 1. 0.0 to 2.7 2. 2.7 to 22.7 3. 22.7 to 24.9 4. 26.2 to 50.0'

Hole No. 6DC-17

DRILLING LOG		Division	INSTALLATION	SHEET 1 of 2 SHEETS
PROJECT Aubrey Dam Site No. 1		SWD	FWD 129	
LOCATION (Continence or Stream)		PROJECT Aubrey Dam		
DRILLING AGENCY Corps of Engineers		MANUFACTURER'S DESIGNATION OF DRILL PAILING 1500		
HOLE NO. (As shown on drawing sheet and file number)		TOTAL NO. OF OVERBURDEN SAMPLES TAKEN		
6DC-17		1		
NAME OF DRILLER Schoonover		TOTAL NUMBER CORE BOXES		
DIRECTION OF HOLE Vertical		ELEVATION GROUND WATER		
THICKNESS OF OVERBURDEN 23.5		DATE MOLE		
DEPTH DRILLED INTO ROCK 26.5		17 Sept. 71		
TOTAL DEPTH OF HOLE 50.0		COMPLETED		
ELEVATION		20 Sept. 71		
DEPTH		ELEVATION TOP OF HOLE		
LEGEND		TOTAL CORE RECOVERED: 100		
CLASSIFICATION OF MATERIALS (Description)		SIGNATURE OF INSPECTOR		
0.0' to 5.5'		REMARKS		
SAND, fine-grained, clayey, hard, sil. moist, brown		1. After completion, hole was bailed to 45.0' with casing pulled. 24 hour check		
5.5' to 22.0'		2. Jar		
CLAY, sandy, non-calc., sil. moist, hard, mottled tan and gray		A. 0.0 to 2.7		
① 14.7' - increase in moisture content to base of overburden		3. Denison cans:		
from 18.7' to 22.0' - calc.		1. 2.7 to 4.7		
22.0' to 23.5'		2. 4.7 to 6.7		
CLAY, calc., w/ scattered gravel and well-rounded siltstone concretions, moist, medium to stiff, tan		3. 6.7 to 8.7		
-- Augured into primary material @ 23.5', set casing to 25.0', cleaned out, and started 6" core @ 25.2'		4. 8.7 to 10.7		
26.2' to 50.0'		5. 10.7 to 12.7		
SHALE, sandy, non-calc., hard (penetrometer 4.5), thin-bedded, fossilif., unjointed and unfractured to T.D., unweathered, gray		6. 12.7 to 14.7		
		7. 14.7 to 16.7		
		8. 16.7 to 18.7		
		9. 18.7 to 20.7		
		10. 20.7 to 22.7		
		Note: Jar samples taken from shoe at each sample depth.		
		4. Cartons:		
		1. 27.4 to 28.4		
		2. 31.6 to 32.6		
		3. 38.8 to 39.7		
		4. 43.8 to 44.5		
		5. 49.0 to 50.0		
		5. Shale weathered to 24.9'.		
		6. 8" casing set to 25.0'.		
		7. Drilling methods:		
		1. 0.0 to 2.7 - auger		
		2. 2.7 to 22.7 - d. b.		
		3. 22.7 to 26.2 - auger		
		4. 26.2 to 50.0 - 6" core		
		Sandstone concretions avg. 0.1' in thickness at the following depths: 28.5', 29.3', 30.3', 31.2', 37.9.		
		Silty sandstone beds at the following depths:		
		27.0 to 27.4 - laminated		
		36.8 to 37.1 - "		
		42.0 to 42.9 - " and sil. fissile. Zone badly washed by core bbl. action.		
		T.D. - 50.0' -		

Hole No. 6DC-18

DRILLING LOG		Division	INSTALLATION	SHEET 1 of 1 SHEETS
PROJECT Aubrey Dam		SWD	FWD 129	
LOCATION (Continence or Stream)		PROJECT Aubrey Dam		
DRILLING AGENCY USC&A		MANUFACTURER'S DESIGNATION OF DRILL PAILING 1500		
HOLE NO. (As shown on drawing sheet and file number)		TOTAL NO. OF OVERBURDEN SAMPLES TAKEN		
6DC-18		8		
NAME OF DRILLER G. Schuchler		TOTAL NUMBER CORE BOXES		
DIRECTION OF HOLE Vertical		ELEVATION GROUND WATER		
THICKNESS OF OVERBURDEN 18.2		DATE MOLE		
DEPTH DRILLED INTO ROCK 11.8		7 SEPT. 71		
TOTAL DEPTH OF HOLE 30.0		COMPLETED		
ELEVATION		20 SEPT. 71		
DEPTH		ELEVATION TOP OF HOLE		
LEGEND		TOTAL CORE RECOVERED FOR BORING		
CLASSIFICATION OF MATERIALS (Description)		SIGNATURE OF INSPECTOR		
0.0' to 1.0'		REMARKS		
FINE SAND, STIFF, SIL. MOIST		I. DRILLING:		
ROOT SOIL, DARK BROWN		8" RIGHT AUGER		
1.0' to 6.6'		0.0' - 1.6'		
CLAY; W/ TRACE OF FINE SAND		6" DELUSION		
E. STIFF, W/ CARBON STAINS, MOIST, V. STIFF DOWN TO HARD		1.6' - 19.6'		
RUST BROWN		8" RIGHT AUGER		
6.6' to 10.0'		19.6' - 20.0'		
CLAY; SANDY, W/ CARBON STAINS, MOIST, V. STIFF, RUST BROWN		CLEANED OUT WITH 10" AUGER & SET CASING TO 20.0'		
10.0' to 18.6'		CLEANED OUT CASING TO 21.2'		
CLAY; SANDY, W/ CARBON STAINS, MOIST, V. STIFF, RUST BROWN		6" CORE BARREL: 21.1' - 30.0'		
18.6' to 20.0'		II. SAMPLES:		
SAND - GRAVEL; GRADED SAND, W/ FINE TO COARSE GRAVEL, W/ TRACE OF FINE SAND, RUST COL.		A. 0.0 - 1.0'		
18.2' to 30.0' T.D.		B. 3.6'		
SAMPLE; MOD. WEATH. DOWN TO RES. UNWEATH.; W/ SANDY LAMINATIONS & OCCASIONAL SANDSTONE FLECKS; W/ PURPLE IRONSTONE CONCRETIONS IN UPPER THREE FEET; W/ TIGHT FRACTURES IN WEATH. ZONE; SIL. MOIST, SORT (ROCK CLASS); WEATH. SOME PRISON GRAY BROWN W/ RUST YELLOW UNWEATH. ZONE IS BLISH GRAY.		C. 5.6'		
18.2' - 25.2' MOD. WEATH.		D. 7.6'		
25.2' - 30.2' SIL. WEATH.		E. 9.6'		
27.2' - 27.4' W. S. FLAG		F. 12.6'		
27.4' IRONSTONE CONCRETION		G. 12.6' - 14.6'		
T.D. 30.0'		H. 14.6' - 18.2'		
		I. 18.2' - 21.2'		
		J. 21.2' - 30.0'		
		K. 30.0' - 31.2'		
		L. 31.2' - 32.6'		
		M. 32.6' - 34.0'		
		N. 34.0' - 35.4'		
		O. 35.4' - 36.8'		
		P. 36.8' - 38.2'		
		Q. 38.2' - 39.6'		
		R. 39.6' - 41.0'		
		S. 41.0' - 42.4'		
		T. 42.4' - 43.8'		
		U. 43.8' - 45.2'		
		V. 45.2' - 46.6'		
		W. 46.6' - 48.0'		
		X. 48.0' - 49.4'		
		Y. 49.4' - 50.0'		
		NOTE: LOST SAMPLE FROM 9.6' - 10.6'. DENISON SAMPLE DESTROYED FROM 12.6' - 14.6'; TOOK JAR SAMPLE C-1, 22.4' - 23.4'. 2:26.2' - 27.2'		
		III. WATER LEVEL - BORING BAILED TO 29.2' ON 21st OF 85th & LEFT OPEN 24 HOURS; WATER LEVEL AT 15.6'		
		IV. DEPTH OF WEATH.: MOD. WEATH. TO 28.2'		
		V. MISC. POLYMER PENETRATING READINGS IN COLUMN 'P'. AND JAR SAMPLES WERE TAKEN FROM DENISON SHOE.		
ENG FORM 1836 PREVIOUS EDITIONS MAY BE USED		PROJECT Aubrey Dam		HOLE NO. 6DC-18

Hole No. 644C-20

DRILLING LOG		INSTALLATION	
Project: Southwestern		Port: Fort Worth	
1. PROJECT: Aubrey Dam Site		10. USE AND TYPE OF BIT: 6" SURGE, 4" CARBOLITE	
2. LOCATION (Compass or Plane): Right abutment - stilling basin		11. DATE OF ELEVATION DETERMINATION: 5/22	
3. DRILLING ASPECT: Corps of Engineers		12. MANUFACTURER'S DESIGNATION OF DRILL: Rolling 36	
4. HOLE NO. (As shown on drawing sheet and site number): 644C-20		13. TOTAL NO. OF CORES: 5 (Intertubed) BUREAU SAMPLES TAKEN: 0	
5. NAME OF DRILLER: Crosman		14. TOTAL NUMBER CORE BOXES: 5	
6. DIRECTION OF HOLE: <input checked="" type="checkbox"/> VERTICAL <input type="checkbox"/> INCLINED		15. ELEVATION GROUND WATER: 5886	
7. THICKNESS OF OVERBURDEN: 31.7		16. DATE MOLE: 18 May 72 (Started) 18 May 72 (Completed)	
8. DEPTH DRILLED INTO ROCK: 20.5		17. ELEVATION TOP OF MOLE: 576.95	
9. TOTAL DEPTH OF HOLE: 52.2		18. TOTAL CORE RECOVERY FOR BORING: 88.0%	
19. NAME OF USER OF LOG: John R. Blumh		20. DATE OF LOG: 18 May 72	

ELEVATION	DEPTH	REMARKS	CLASSIFICATION OF MATERIALS (Description)	CORE NO.	BOX NO.	REMARKS (Drilling time, core loss, depth of overburden, etc., if significant)
0.0'	19.0'	****	CLAY - -	A		1. After completion, ho was balled to 42.1'. 3" I.D. perforated plastic casing was placed to T.D.
0.0'	1.3'		0.0' to 1.3' - sli. calc. moist, stiff, brown.	B		
1.3'	4.1'		1.3' to 4.1' - non-calc., moist, stiff, mottled, brown, tan.	C		
4.1'	7.8'		4.1' to 7.8' - increase in sand content, med., moist, tan.	D		2. Jars: A. 0.0 to 1.0 B. 2.0 to 3.0 C. 5.0 to 6.0 D. 10.0 to 11.0 E. 15.0 to 16.0
7.8'	19.0'		7.8' to 19.0' - non-calc., moist, stiff, tan.	E		Jar samples selected from continuous shell tube samples through overburden.
19.0'	21.8'	19.0	19.0' to 21.8' Limestones, stained, n. hard jointed, tan.			3. Cartons: 1. 21.8 to 22.8 2. 26.2 to 27.2 3. 30.0 to 31.0 4. 33.6 to 34.6 5. 42.5 to 43.4
21.8'	47.0'	21.0	21.8' to 47.0' SHALE - -	1		4. Weathered to 22.8
21.8'	22.8'	6.05	21.8 to 22.8' - sli. calc., stiff, weathered, tan.			
22.8'	47.0'	0.5	22.8' to 47.0' - sli. calc., stiff to hard, unjointed and unfractured except from 24.0 to 24.5, sli. sandy, gray.	2		
24.0'	24.5'	0.5				
24.5'	36.0'	0.5		3		
36.0'	36.1'	0.1	36.0' to 36.1' - highly fossilif.	4		
36.1'	47.0'	0.6		5		
47.0'	47.0'	47.0	T.D. = 47.0'			

Hole No. 644C-21

DRILLING LOG		INSTALLATION	
Project: Southwestern		Port: Fort Worth	
1. PROJECT: Aubrey Dam Site		10. USE AND TYPE OF BIT: 6" SURGE, 4" CARBOLITE	
2. LOCATION (Compass or Plane): Right abutment - stilling basin		11. DATE OF ELEVATION DETERMINATION: 5/22	
3. DRILLING ASPECT: Corps of Engineers		12. MANUFACTURER'S DESIGNATION OF DRILL: Rolling 1500	
4. HOLE NO. (As shown on drawing sheet and site number): 644C-21		13. TOTAL NO. OF CORES: 8 (Intertubed) BUREAU SAMPLES TAKEN: 0	
5. NAME OF DRILLER: Crosman		14. TOTAL NUMBER CORE BOXES: 5	
6. DIRECTION OF HOLE: <input checked="" type="checkbox"/> VERTICAL <input type="checkbox"/> INCLINED		15. ELEVATION GROUND WATER: 5886	
7. THICKNESS OF OVERBURDEN: 31.7		16. DATE MOLE: 18 May 72 (Started) 18 May 72 (Completed)	
8. DEPTH DRILLED INTO ROCK: 20.5		17. ELEVATION TOP OF MOLE: 581.04	
9. TOTAL DEPTH OF HOLE: 52.2		18. TOTAL CORE RECOVERY FOR BORING: 88.0%	
19. NAME OF USER OF LOG: John R. Blumh		20. DATE OF LOG: 18 May 72	

ELEVATION	DEPTH	REMARKS	CLASSIFICATION OF MATERIALS (Description)	CORE NO.	BOX NO.	REMARKS (Drilling time, core loss, depth of overburden, etc., if significant)
0.0'	23.7'	****	CLAY, non-calc., sandy, moist, stiff, tan to gray.	A		1. After hole was and 3" I plastic, to T.D.
0.0'	1.3'			B		
1.3'	4.1'			C		
4.1'	7.8'			D		2. Jars: A. 0.0 to 1.0 B. 2.0 to 3.0 C. 5.0 to 6.0 D. 10.0 E. 15.0 F. 20.0 G. 25.0 H. 29.0
7.8'	28.2'		23.7' to 28.2' SAND, clayey, moist, n. dense, tan and gray.	E		Jar samples selected from continuous shell tube samples through overburden.
28.2'	29.2'	20.0	28.2' to 29.2' GRAVEL, sandy, max. size -3/4", well-rounded, moist, tan.	F		3. Cartons: 1. 36.2 2. 42.1 3. 45.2 4. 50.0
29.2'	29.2'			G		4. Primary, not weathered
29.2'	31.7'		- - Drilled into unweathered primary material @ 29.2'	H		
31.7'	31.7'		- - Start 6" core @ 31.7'			
31.7'	31.7'	31.7	31.7' to 32.2' SHALE, sli. calc., unves. n. hard, thick-bedded, sli. sandy, some jointed zones below 42.1', gray.	1		
32.2'	32.2'	0.5		2		
32.2'	40.6'	0.4	40.6' to 42.1' - SANDSTONE, soft, with SHALE laminae, tan.	3		
40.6'	42.1'	1.5		4		
42.1'	42.1'	0.5		5		
42.1'	52.2'	10.1	T.D. = 52.2'			

NG LOG Southwestern
 Installation Fort Worth
 Aubrey Dam Site No. 1
 Subunit - stilling basin
 6440-21
 5 May 72
 5 May 72
 31.7
 20.5
 52.2

DEPTH	LEGEND	CLASSIFICATION OF MATERIALS	REMARKS
0.0' to 35.7'	A	CLAY, non-calc., sandy, moist, stiff, tan to gray.	1. After completion, hole was bailed to 46.0' and 3" I.D. perforated plastic pipe was placed to T.D.
23.7' to 28.2'	B	SAND, clayey, moist, m. dense, tan and gray.	2. Jars: A. 0.0 to 1.0 B. 2.0 to 3.0 C. 5.0 to 6.0 D. 10.0 to 11.0 E. 15.0 to 16.0 F. 20.0 to 21.0 G. 25.0 to 26.0 H. 29.0 to 30.2 Jar samples were selected from continuous shaly tube samples through overburden.
28.2' to 29.2'	C	GRAVEL, sandy, max. size 3/4", well-rounded, moist, tan.	3. Cartons: 1. 36.2 to 37.2 2. 42.1 to 43.1 3. 45.2 to 46.2 4. 50.0 to 50.9 Primary material was not weathered.
31.7' to 52.2'	D	SHALE, sil. calc., unves. n. hard, thick-bedded, sil. sandy, some jointed zones below 42.1', gray.	4. Primary material was not weathered.
40.6' to 42.1'	E	SANDSTONE soft, with SHALE laminae, tan.	
T.D. - 52.2'	F		

Drilling Log Southwestern Fort Worth
 Aubrey Dam Site No. 1
 Not Shown Y 217, R24 Y 613, 607
 Corps of Engineers
 354C-21A
 Bill Stanton
 Trinity Engineering Testing Corporation
 30.6
 69.4
 100.0
 3" Shelby Tube
 DAMCO Model 1250
 11
 See Note 2
 12-6-72
 12-13-72
 579.74
 93.2
 See Note 1 under "Remarks"

ELEVATION	DEPTH	LEGEND	CLASSIFICATION OF MATERIALS	% CORE RECOVERY	BOX OR SAMPLE NO.	REMARKS
577.74	2	Brown Clay		100	W1	3" Shelby Tube
				100	W2	Samples 0.0'-28.0'
				100	W3	JAR SAMPLES
573.74	6	Reddish Brown Sandy Clay		100	W4	1. 2.0'-3.0'
				100	W5	2. 6.0'-7.0'
				100	W6	3. 10.0'-11.0'
				100	W7	4. 14.0'-15.0'
				100	W8	5. 18.0'-19.0'
				100	W9	6. 22.0'-23.0'
				100	W10	7. 26.0'-27.0'
				100	W11	8. 30.0'-31.0'
				100	W12	WRAP SAMPLES
				100	W13	1. 0.0'-1.0'
				100	W14	2. 1.0'-2.0'
				100	W15	3. 3.0'-4.5'
				100	W16	4. 4.5'-6.0'
				100	W17	5. 7.0'-8.5'
				100	W18	6. 8.5'-10.0'
				100	W19	7. 11.0'-12.5'
				100	W20	8. 12.5'-14.0'
				100	W21	9. 15.0'-16.5'
				100	W22	10. 16.5'-18.0'
				100	W23	11. 19.0'-20.0'
				100	W24	12. 20.0'-21.0'
				100	W25	13. 21.0'-22.0'
				100	W26	14. 23.0'-24.0'
				100	W27	15. 24.0'-25.0'
				100	W28	16. 25.0'-26.0'
				100	W29	17. 27.0'-28.0'
				90%	Box 1	Moist at 18.0'-22.5'
				90%	Box 2	Wet at 22.5'-30.6'
				40.0	R-3	Set Tub at 28.0' and Cleaned Hole to 30.0'
				90%	Box 2	3" Shelby Tube Sample 30.0'-31.0' (Continued)
				90%	Box 2	Began Coring w/4" bbl. at 31.0'
				45.0	Box 3	CARTON SAMPLES
				50.0	R-5	1. 33.6'-34.5'
				86%	Box 4	2. 36.7'-37.7'
				55.0	R-6	3. 40.9'-41.8'
				84%	Box 5	4. 45.6'-46.5'
				60.0	R-7	5. 49.1'-49.7'
				86%	Box 6	6. 50.7'-51.5'
				84%	Box 7	7. 57.3'-57.8'
				84%	Box 8	8. 61.2'-61.7'
				84%	Box 9	9. 67.8'-68.7'
				84%	Box 10	10. 70.0'-70.9'
				84%	Box 11	11. 77.0'-77.9'
				84%	Box 12	12. 83.6'-84.5'
				84%	Box 13	13. 85.0'-85.9'
				84%	Box 14	14. 90.0'-90.9'
				84%	Box 15	15. 93.4'-94.3'
				84%	Box 16	16. 98.0'-98.9'
				84%	Box 17	BOXES
				84%	Box 18	1. 31.0'-36.7'
				84%	Box 19	2. 36.7'-43.5'
				84%	Box 20	3. 43.5'-49.1'
				84%	Box 21	4. 49.1'-56.6'
				84%	Box 22	5. 56.6'-64.4'
				84%	Box 23	6. 64.4'-71.3'
				84%	Box 24	7. 71.3'-77.9'
				84%	Box 25	8. 77.9'-82.8'
				84%	Box 26	9. 82.8'-90.9'
				84%	Box 27	10. 90.9'-96.3'
				84%	Box 28	11. 96.3'-100.0'

Note No. 3S4C-21A

Division Southwestern	INSTALLATION Fort Worth	SHEET 03 OF 3 SHEETS
No. 1 of 12,124	NO. SIZE AND TYPE OF BIT 3" Shelby & 4" Core	
Y: 613,500	DATE OF ELEVATION MSL	
	11. NAME OF USER'S DESIGNATION OF WELL DAMCO Model 1250	
	12. TOTAL NO. OF CORES 7	17
	13. TOTAL NUMBER CORE BOXES 11	
	14. ELEVATION GROUND WATER See Note 2	
	15. DATE MOLE STARTED 12-6-72	COMPLETED 12-13-72
	16. ELEVATION TOP OF MOLE 579.74	
	17. TOTAL CORE RECOVERY FOR BORING 93.2	
	18. SIGNATURE OF INSPECTOR See Note 1 under "Remarks"	

CLASSIFICATION OF MATERIALS (Designated)	% CORE RECOV. EST.	BOX OR SAMPLE NO.	REMARKS (Drilling time, water loss, depth of weathering, etc., if significant)
Brown Clay	100	W1	3" Shelby Tube
2.0'	100	W2	Samples 0.0'-28.0'
Reddish Brown Sandy Clay	100	W3	JAR SAMPLES
6.0'	100	W4	1. 2.0'-3.0'
Tan Silty Clay w/Sand Lenses	100	W5	2. 6.0'-7.0'
	100	W6	3. 10.0'-11.0'
	100	W7	4. 14.0'-15.0'
	100	W8	5. 18.0'-19.0'
	100	W9	6. 22.0'-23.0'
	100	W10	7. 26.0'-27.0'
	100	W11	8. 30.0'-31.0'
	100	W12	WRAP SAMPLES
	100	W13	1. 0.0'-1.0'
	100	W14	2. 1.0'-2.0'
	100	W15	3. 3.0'-4.5'
	100	W16	4. 4.5'-6.0'
	100	W17	5. 7.0'-8.5'
	100	W18	6. 8.5'-10.0'
	100	W19	7. 11.0'-12.5'
	100	W20	8. 12.5'-14.0'
	100	W21	9. 15.0'-16.5'
	100	W22	10. 16.5'-18.0'
	100	W23	11. 19.0'-20.0'
	100	W24	12. 20.0'-21.0'
	100	W25	13. 21.0'-22.0'
	100	W26	14. 23.0'-24.0'
	100	W27	15. 24.0'-25.0'
	100	W28	16. 25.0'-26.0'
	100	W29	17. 27.0'-28.0'
	100	W30	Moist at 18.0'-22.5'
	100	W31	Wet at 22.5'-30.6'
	100	W32	Set Tub at 28.0' and Cleaned Hole to 30.0'
	100	W33	3" Shelby Tube Sample 30.0'-31.0'
	100	W34	(Continued)
	100	W35	Began Coring w/4" bbl. at 31.0'
	100	W36	CARTON SAMPLES
	100	W37	1. 33.6'-34.5'
	100	W38	2. 36.7'-37.7'
	100	W39	3. 40.9'-41.8'
	100	W40	4. 45.6'-46.5'
	100	W41	5. 49.1'-49.7'
	100	W42	6. 50.7'-51.5'
	100	W43	7. 57.3'-57.8'
	100	W44	8. 61.2'-61.7'
	100	W45	9. 67.8'-68.7'
	100	W46	10. 70.0'-70.9'
	100	W47	11. 77.0'-77.9'
	100	W48	12. 83.6'-84.5'
	100	W49	13. 85.0'-85.9'
	100	W50	14. 90.0'-90.9'
	100	W51	15. 93.4'-94.3'
	100	W52	16. 98.0'-98.9'
	100	W53	BOXES
	100	W54	1. 31.0'-36.7'
	100	W55	2. 36.7'-43.5'
	100	W56	3. 43.5'-49.1'
	100	W57	4. 49.1'-56.6'
	100	W58	5. 56.6'-64.4'
	100	W59	6. 64.4'-71.3'
	100	W60	7. 71.3'-77.9'
	100	W61	8. 77.9'-82.8'
	100	W62	9. 82.8'-90.9'
	100	W63	10. 90.9'-96.3'
	100	W64	11. 96.3'-100.0'

ELEVATION	DEPTH	LOGGED	CLASSIFICATION OF MATERIALS (Designated)	% CORE RECOV. EST.	BOX OR SAMPLE NO.	REMARKS (Drilling time, water loss, depth of weathering, etc., if significant)
483.44	94			93.0	R-14	Box 10
479.74	96		96.3'-100.0'	92.5	R-15	Box 11
	98		LIMESTONE, Gray, Hard, Unweathered	100.0		
	100		Total Depth = 100.0'			

Note 1:
Soils Logged By:
A. J. Simpson,
Trinity Engineering
Testing Corporation;
Primary Logged By:
Marr and Marple,
Corps of Engineers,
Fort Worth District
Note 2:
Installed 2" Plastic
Pipe from 581.34
to _____ for ground
water observations.

RECORD DRAWING-WORK AS BUILT

SYMBOL NO.	ACTION	DATE	DESCRIPTION OF REVISION
U.S. ARMY ENGINEER DISTRICT, FORT WORTH CORPS OF ENGINEERS FORT WORTH, TEXAS			
DESIGNED BY:	RAY ROBERTS LAKE ELM FORK, TRINITY RIVER, TEXAS EMBANKMENT, SPILLWAY AND OUTLET WORKS LOGS OF BORINGS 6A4C-20, 6A4C-21, AND 3S4C-21A		
DRAWN BY:			
REVIEWED BY:			
SUBMITTED BY:	INVITATION NO. DACW63-82-B-0025 DATE: MAR, 1982		
ENGINEER:	CONTRACT NO. DACW63-92-C-0083	DRAWING NUMBER	SEQUENCE NO. 16

TO ACCOMPANY FOUNDATION REPORT

Hole No. **BA6C-22**

DRILLING LOG		Division	Installation	SHEET 1
Southwestern		Southwestern	Port Worth	of 2 SHEETS
PROJECT: Aubrey Dam Site		HOLE NO. AND TYPE OF BIT: 6" AUBREY 6" CARBOLITE 6" diamond		
LOCATION: Intake structure		HOLE NO. AND TYPE OF BIT: 6" AUBREY 6" CARBOLITE 6" diamond		
DRILLING AGENCY: Corps of Engineers		INSTALLATION: Filling 1500		
HOLE NO. (As shown on drawing sheet and log number): BA6C-22		TOTAL NO. OF CORES: 8		
NAME OF DRILLER: Schoonover		ELEVATION GROUND WATER: 28.5 17.2 17.2		
DIRECTION OF HOLE: <input checked="" type="checkbox"/> Vertical <input type="checkbox"/> Inclined		DATE MADE: 4 May 72		
THICKNESS OF OVERBURDEN: 8.0		ELEVATION TOP OF HOLE: 593.5		
DEPTH DRILLED INTO ROCK: 40.5		TOTAL CORE RECOVERY FOR BORING: 96.5		
TOTAL DEPTH OF HOLE: 48.5		SIGNATURE OF INSPECTOR: <i>Raymond E. ...</i>		

ELEVATION	DEPTH	LEGEND	CLASSIFICATION OF MATERIALS (Description)	REMARKS (Including core number, depth of weathering, etc., if significant)
0.0'	2.6'	A	SAND, sli. clayey, fine to med. grained, sli. moist brown.	1. After completion, bore was bailed to 45.0' and 2 1/2" I.D. perforated pipe was placed in hole.
2.6'	8.0'	B	CLAY, sandy, moist, medium red to tan.	2. Jars:
8.0'	10.0'	C	CLAY-SHALE, calc., moist, stiff, tan.	A. 0.0 to 2.6 B. 2.6 to 6.5 C. 6.5 to 8.0 D. 8.0 to 9.0 E. 9.0 to 10.0
10.0'	10.0'	D	-- Start 6" core @ 10.0'	
10.0'	19.0'	E	CLAY-SHALE, calc., highly jointed, m. hard, numerous rootlets, open, highly-stained joint from 14.1 to 15.3, tan and gray.	3. Cartons:
19.0'	19.0'	L	-- Transitional weathering contact @ 19.0'	1. 10.0 to 11.0 2. 17.2 to 18.2 3. 22.6 to 23.6 4. 27.7 to 28.7 5. 38.4 to 39.4 6. 45.2 to 46.2
19.0'	36.9'	L	SHALE, calc., jointed and stained to 22.6', thick bedded, fossilif., gray	4. Weathered to 19.0'
36.9'	36.9'	L	-- Start 4" core @ 20.0'	5. Base of jointing at 22.6'
36.9'	30.9'	G	SHALE, calc., jointed and stained to 22.6', thick bedded, fossilif., gray	
30.9'	30.9'	G	SHALE, soft - moderately hard, moist, interbedded with scattered, thin sandstone seams.	
30.9'	36.9'	G	SHALE, calc., m. hard, modular Limestones pieces, hard.	
36.9'	36.9'	G	-- Transitional contact @ 36.9'	
36.9'	43.6'	L	LIMESTONE --	
43.6'	43.6'	L	36.9' to 42.1' - m. hard fossilif., shaly, gray	
43.6'	43.6'	L	42.1' to 43.6' - sandy, fossilif., shaly, HARD gray.	
43.6'	47.2'	L	SHALE, calc., m. hard, scattered LIMESTONE concretions, gray.	
47.2'	47.2'	L	43.6' to 43.8' SILTSTONE, m. hard, tan.	
47.2'	48.5'	L	47.2' to 48.5'	
48.5'	48.5'	L	NO RECOVERY	
48.5'	48.5'	L	2.D. 48.5'	

Hole No. **BA6C-23**

DRILLING LOG		Division	Installation	SHEET 1
Southwestern		Southwestern	Port Worth District	of 2 SHEETS
PROJECT: Aubrey Dam		HOLE NO. AND TYPE OF BIT: 6" AUBREY 6" CARBOLITE 6" diamond		
LOCATION: Sta 78+00, West Abutment C L		HOLE NO. AND TYPE OF BIT: 6" AUBREY 6" CARBOLITE 6" diamond		
DRILLING AGENCY: USACE-C		INSTALLATION: Filling 350		
HOLE NO. (As shown on drawing sheet and log number): BA6C-23		TOTAL NO. OF CORES: 8		
NAME OF DRILLER: Jay Creman		ELEVATION GROUND WATER: 28.5 17.2 17.2		
DIRECTION OF HOLE: <input checked="" type="checkbox"/> Vertical <input type="checkbox"/> Inclined		DATE MADE: 9 May 72		
THICKNESS OF OVERBURDEN: 19.0'		ELEVATION TOP OF HOLE: 593.5		
DEPTH DRILLED INTO ROCK: 51.0'		TOTAL CORE RECOVERY FOR BORING: 96.5		
TOTAL DEPTH OF HOLE: 70.6		SIGNATURE OF INSPECTOR: <i>Raymond E. ...</i>		

ELEVATION	DEPTH	LEGEND	CLASSIFICATION OF MATERIALS (Description)	REMARKS (Including core number, depth of weathering, etc., if significant)
0.0'	17.6'	A	CLAY-lean, sandy-fine; silty; dry.	
0.6'	0.6'	B	@ 0.6 - becomes moist.	
1.7'	1.7'	B	@ 1.7' - becomes stiff, well consolidated, fat	
5.3'	5.3'	C	@ 5.3' - becomes gravelly limestone, hard, max size 1"; lean, with color change.	
13.6'	13.6'	D	@ 13.6' - becomes very lean with more sand fines	
17.6'	17.6'	F	17.6 to 19.0'	
19.0'	19.0'	G	SHALE - hard, angular limestone size 1-1/2"; sand coarse; silty; moist; brown, gray, & yellowish-brown	
20.0'	20.0'	L	-- Start 4" core at 20.0'	
20.0'	69.2'	L	20.0' to 69.2'	
20.0'	2500'	L	20.0' - 2500' - weathered, oxide stains, yellow-brown & gray.	
24.8'	24.8'	L	24.6' - 24.8' SANDSTONE, fine, argillaceous, moderately cemented.	
25.0'	25.0'	L	25.0 - 33.3' - Predom dark gray with oxide staining limited to bedding planes.	
29.6'	29.6'	L	28.2 - 29.6' - Fossiliferous Sandstone	
32.8'	32.8'	L	29.6 - 32.8' - Sandstone	
32.8'	32.8'	L	32.8 - 33.2' - Sandstone	

Western	INSTALLATION Fort Worth District	SHEET 1 of 2 SHEETS
C.L.	10. SIZE AND TYPE OF BIT 4" Core Barrel	
84C-25	11. DATE OF ELEVATION MEASUREMENT	
	12. MANUFACTURER'S DESIGNATION OF DRILL Falling 350	
	13. TOTAL NO. OF CORES UNDISTURBED 7	UNDISTURBED 8
	14. TOTAL NUMBER CORE BOARDS 8	
	15. ELEVATION GROUND WATER	
	16. DATE MOLE STARTED 25 May 72	COMPLETED 26 May 72
	17. ELEVATION TOP OF MOLE 600.66	
	18. TOTAL CORE RECOVERY FOR BORING	
	19. SIGNATURE OF INSPECTOR Raymond E. Hagen	

CLASSIFICATION OF MATERIALS (Description)	1. CORE RECOVERY %	2. BOX OR SAMPLE NO.	REMARKS (Drilling time, water loss, depth of casing, etc. if significant)
17.6'		A	JAR SAMPLES
lean, sandy-fine; dry.		B	A - 0.02' to 1.0'
becomes moist.		C	B - 3.0' to 4.0'
- becomes stiff,		D	C - 6.0' to 7.0'
consolidated, fat		E	D - 9.0' to 10.0'
- becomes gravelly		F	E - 12.0' to 13.0'
tone, hard, max		G	F - 15.0' to 16.0'
1"; lean, with			G - 18.0' to 19.5'
change.			CARTON SAMPLES
ish brown.			1 - 22.3' to 23.3'
- becomes very			2 - 29.4' to 30.4'
sh more sand fines			3 - 34.0' to 35.0'
			4 - 36.4' to 37.4'
			5 - 46.9' to 47.9'
			6 - 49.0' to 49.8'
			7 - 52.0' to 53.0'
			8 - 58.8' to 59.8'
			PENTROMETER BLOWS
			13.6' to 14.1' - 43
			14.1' to 15.1' - 72
			Sec casing to 20.0'
			and started coring
			at that depth.
18.3'			
hard, rounded &			
limestone; max			
1/2"; sandy-fine to			
silty; mottled-			
ray, & yellowish-			
" core at 20.0'----			
69.2'			
silt - moderately			
st, interbedded			
stared, thin			
seams.			
Box 1			
100' -			
red, oxide stains,			
brown & gray.			
4.8' - SANDSTONE,			
argillaceous,			
ely cemented.			
" - Predom			
ay with			
aining limited			
ing Planes.			
6' - Fossiliferous			
8' - Sandstone			
12' - Sandstone			
Box 3			
Box 4			
Box 5			
Box 6			
Box 7			
Box 8			

ELEVATION	DEPTH	LEADER	CLASSIFICATION OF MATERIALS (Description)	1. CORE RECOVERY %	2. BOX OR SAMPLE NO.	REMARKS (Drilling time, water loss, depth of casing, etc. if significant)
	40		33.3'-69.2' Unweathered, dark gray, moderately hard.	41.5		
	50		36.5'-36.8' - SANDSTONE, moderately hard, moderately cemented, very fine, thinly bedded, light gray-tan.	46.5		
	60		37.3'-37.6' - Fossiliferous SANDSTONE	55.5		
	70		46.7-47.4' - SANDSTONE	55.5		
			47.9-48.4' - "			
			50.4-50.6' - "			
			53.5-54.2' - "			
			54.6-54.9' - "			
			55.3-55.4' - "			
			56.4-56.5' - "			
			57.8-58.1' - "			
			58.2-58.7' - "			
			61.4-61.6' - "			
			62.9-64.4' - Fossiliferous SANDSTONE	55.5		
			64.4-64.9' - "			
			66.6-66.9' - SANDSTONE	40.7		
			67.0-67.6' - "			
			67.6-68.0' - "			
			68.5-68.7' - "			
			7.0 72.0'			

Unable to obtain
Carton samples
for last 10' of hole
due to fragmentation
of core

SYM	DD	NO
DESIGNED BY		
DRAWN BY		
REVIEWED BY		
SUBMITTED BY		
ENGINEER		

ELEVATION	DEPTH	LEGEND	CLASSIFICATION OF MATERIALS (Description)	LOG RECOVERY	BOX OR SAMPLE NO.	REMARKS (Depth, water level, depth of penetration, etc.)
	40		33.3'-69.2' Unweathered, dark gray, moderately hard.	41.5		
				L-1.0		
			36.5'-36.8' - SANDSTONE, moderately hard, moderately cemented, very fine, thinly bedded, light gray-tan.	46.5		
			37.3-37.6' - Fossiliferous	G-0.3	5	
			46.7-47.6' - SANDSTONE			
			47.9-48.4' - "		6	
	50		50.4-50.6' - "	50.5		
			53.5-54.2' - "			
			54.6-54.9' - "			
			55.3-55.4' - "	L-0.9		
			56.4-56.5' - "		7	
			57.8-58.1' - "			
			58.2-58.7' - "			
			61.4-61.6' - "			
			62.9-64.4' - "	55.5		Unable to obtain Cordon samples for last 10' of hole due to fragmentation of core
			64.4-64.9' - Fossiliferous			
			66.6-66.9' - SANDSTONE	L-0.7		
			67.0-67.6' - "			
			67.6-68.0' - "			
			68.5-68.7' - "		8	
	60			62.5		
				L-0.2		
				65.5		
				G-0.8		
	70		7.0 70.0'	70.0		

DWG FORM 1036 PREVIOUS EDITIONS ARE OBSOLETE. PROJECT: Aubrey Dam. SCALE: 846C-25

RECORD DRAWING-WORK AS BUILT

ITEM	NO.	ACTION	DATE	DESCRIPTION OF REVISION
U.S. ARMY ENGINEER DISTRICT, FORT WORTH CORPS OF ENGINEERS FORT WORTH, TEXAS				
DESIGNED BY:	RAY ROBERTS LAKE ELM FORK, TRINITY RIVER, TEXAS EMBANKMENT, SPILLWAY AND OUTLET WORKS LOGS OF BORINGS 846C-22 AND 844C-25			
DRAWN BY:				
REVIEWED BY:				
SUBMITTED BY:	INVITATION NO. DACW63-82-B-0025	DATE	MAR, 1982	
ENGINEER:	CONTRACT NO. DACW63-82-C-0083	DRAWING NUMBER	SHEET NO.	SEQUENCE NO.
			17	17

TO ACCOMPANY FOUNDATION REPORT

CONTRACT NO. DACW63-82-B-0025

8A-4C-26

DRILLING LOG
 PROJECT: Aubrey Dam
 LOCATION: Sta 29+50 West Abundant C.L.
 DRILLING AGENCY: USACE-C
 HOLE NO: 8A-4C-26
 NAME OF DRILLER: Jay Creeman
 DIRECTION OF HOLE: Vertical
 THICKNESS OF OVERBURDEN: 30.5'
 DEPTH DRILLED INTO ROCK: 24.5'
 TOTAL DEPTH OF HOLE: 55.0'

ELEVATION	DEPTH	LEGEND	CLASSIFICATION OF MATERIALS (Description)	CORE RECOVERY %	BOX OR SAMPLE NO.	REMARKS (Including time, hour of day, depth of overburden, etc., if significant)
	0.0'		CLAY-dry, lean, loose, sandy-fine; dark grayish brown.		A	JAR SAMPLES
	0.0'				B	A - 0.0' to 1.0'
	0.0'				C	B - 3.0' to 4.0'
	0.0'				D	C - 6.0' to 7.0'
	0.0'				E	D - 9.0' to 10.0'
	0.0'				F	E - 12.0' to 13.0'
	0.0'				G	F - 15.0' to 16.0'
	0.0'				H	G - 18.0' to 19.0'
	0.0'				I	H - 21.0' to 22.0'
	0.0'				J	I - 24.0' to 25.0'
	0.0'					J - 27.0' to 28.6'
	0.0'					CARTON SAMPLES
	0.0'					1 - 33.4' to 34.3'
	0.0'					2 - 39.0' to 40.0'
	0.0'					3 - 43.5' to 44.6'
	0.0'					4 - 51.0' to 52.0'
	0.0'					Set casing to 30.5'.
	0.0'					Started coring at 31.5' (upper gravel deposit chewed up core - no recovery).
	0.0'					PENELOMETER TEST
	0.0'					26.9 to 27.4 - 50 Blows
	0.0'					27.4 to 28.4 - 97 "
	0.0'					Bailed Hole to 51.3'.
	0.0'					Direct Measure of Depth 53.5'
	0.0'					SHALE, moderately hard, moist, dark gray, fissile, unweathered (except for oxide staining to 33.1), non-jointed.
	0.0'					31.5-31.6 SANDSTONE, argillaceous, moderately hard, moderately cemented, thin bedded, oxide stained.
	0.0'					31.8-32.6 SANDSTONE
	0.0'					35.2-44.1 Interbedded with thin, very fine, thin bedded, tan-lt gray sandstone seams.
	0.0'					36.8-37.0 SANDSTONE
	0.0'					39.3-40.0 SANDSTONE
	0.0'					39.8-40.0 Fossiliferous
	0.0'					41.8-42.4 SANDSTONE
	0.0'					42.8-43.8 "
	0.0'					44.0-44.1 "
	0.0'					46.9-49.8 Slightly fossiliferous throughout.
	0.0'					46.9-47.3 Sandy with fossil detritus
	0.0'					49.4-49.8 Very fossiliferous, very well cemented, claystone - nodules from 49.4 - 49.6.
	0.0'					T.O. 55.0'

DRILLING LOG
 PROJECT: Aubrey Dam
 LOCATION: Sta 29+50 West Abundant C.L.
 DRILLING AGENCY: USACE-C
 HOLE NO: 8A-4C-27
 NAME OF DRILLER: Jay Creeman
 DIRECTION OF HOLE: Vertical
 THICKNESS OF OVERBURDEN: 28.0'
 DEPTH DRILLED INTO ROCK: 16.9'
 TOTAL DEPTH OF HOLE: 40.0'

ELEVATION	DEPTH	LEGEND	CLASSIFICATION OF MATERIALS (Description)	CORE RECOVERY %	BOX OR SAMPLE NO.	REMARKS
	0.0'		CLAY-fat, moist, sandy-fine to coarse; very dark gray.			
	0.0'		@ 2.1' - becomes soft, wet			
	0.0'		@ 5.2' - becomes stiff with more coarse sand (lime nodules) with color change to grayish-brown			
	0.0'		@ 11.1' - Color change to mottled-yellowish brown, gray, and red.			
	0.0'		@ 15.0' - loses coarse sand and becomes lean.			
	0.0'		@ 17.6' - becomes gravelly, well rounded, hard, max size 1/2"			
	0.0'		20.6' to 23.7' - GRAVEL-hard, rounded, max size 2"; clayey, very lean sandy-fine to coarse; yellowish brown.			
	0.0'		Started 4" core at 25.0'.			
	0.0'		26.5' to 26.7' SANDSTONE, fine-grained, soft, tan, friable, stained.			
	0.0'		26.7' to 32.7' SHALE, sandy, moderately hard, gray to brown, slightly stained, moderately hard sandstone bed at 29.3' to 29.4'.			
	0.0'		32.7' to 40.0' SHALE, moderately hard, dark gray, fresh.			
	0.0'		TOTAL DEPTH - 40.0'.			

ENG FORM 1836 MAR 71 PREVIOUS EDITIONS ARE OBSOLETE. (TRANSLUCENT) PROJECT: Aubrey

Male No. 8AAC-27

Southwestern

Fort Worth District 1-9

4" Core Barrel

MSL

Falling Model 44

6DC-28

Boyd Lane Trinity Engineering Testing Corporation

27 May 72

407.03

40.0'

Raymond T. Nagen

LEGEND	CLASSIFICATION OF MATERIALS (Description)	SCORE PERCENT	BOX OR SAMPLE NO.	REMARKS (Drilling time, color logs, depth of penetration, etc., at 20 ft/min)
	0.0' to 20.6' - CLAY-fac, moist, sandy-fine to coarse; very dark gray.		A	Jar Samples A - 0.0' to 1.0' B - 3.0' to 4.0' C - 46.0' to 7.0' D - 9.0' to 10.0' E - 12.0' to 13.0' F - 13.0' to 16.0' G - 18.0' to 19.0' H - 21.0' to 22.0'
	@ 2.1' - becomes soft, wet		B	
	@ 5.2' - becomes stiff with more coarse sand (line nodules) with color change to grayish-brown		C	
	@ 11.1' - color change to mottled-yellowish brown, gray, and red.		D	
	@ 15.0' - loses coarse sand and becomes lean.		E	Set casing to 25.0'. Started coring at this depth.
	@ 17.6' - becomes gravelly, well rounded, hard, max size 1/2".		F	Bailed hole to 37.2'.
	20.6' to 23.7' - GRAVEL-hard, rounded, max size 2", clayey, very lean; sandy-fine to coarse; yellowish brown.		G	
	Started 4" core at 25.0'.		H	
	26.5' to 26.7' SANDSTONE, fine-grained, soft, tan, friable, stained.	15.0		
	26.7' to 32.7' SHALE, sandy, moderately hard, gray to brown, slightly stained, moderately hard sandstone bed at 29.3' to 29.4'.	14.5 16.5 10.0 18.5		
	32.7' to 40.0' SHALE, moderately hard, dark gray, fresh.	16.3		
	TOTAL DEPTH - 40.0'.			

PREVIOUS EDITIONS ARE OBSOLETE. PROJECT: Aubrey Dam. HOLE NO.: 8AAC-27

Male No. 6DC-28

Southwestern

Fort Worth

Aubrey Dam Site No. 1

Not Shown

6DC-28

Boyd Lane Trinity Engineering Testing Corporation

11-14-72

558.84

100.0

See Note 1 under "Remarks"

ELEVATION	DEPTH	LEGEND	CLASSIFICATION OF MATERIALS (Description)	% CORE RECOVERY	BOX OR SAMPLE NO.	REMARKS (Drilling time, color logs, depth of penetration, etc., at 20 ft/min)
556.84	2		Dark Brown Clay		J1	Used 8" Auger from 0.0'-3.0'
	4		Tan Clay	100	D1	Used 6" d, b, from 3.0'-38.0'
	6			100	D2	Jar sample taken from shoe of each Denison sample.
550.34	8		8.5'	100	D3	JAR SAMPLES
	10		Tan Sandy Clay	100	D4	1. 0.0'-3.0'
	12			100	D5	2. 5.0'
	14			100	D6	3. 7.0'
	16		16.5'	100	D7	4. 9.0'
542.34	18		Tan Clay	100	D8	5. 11.0'
	20		21.0'	100	D9	6. 13.0'
537.84	22		Tan Sandy Clay	100	D10	7. 15.0'
	24		25.0'	100	D11	8. 17.0'
533.84	26		Tan Sand and Gravel	50	D12	9. 19.0'
	28		29.0'	75	D13	10. 21.0'
529.84	30		Tan Gravel and Sand	25	D14	11. 23.0'
	32			75	D15	12. 25.0'
	34			75	D16	13. 27.0'
522.84	36		36.0'	0		14. 29.0'
	38		36.0'-44.9' SHALE, Mod. Hard, Non-Jointed, Laminated, Dark (Continued)	100	D17	15. 31.0'
	40		Gray, Often Sandy w/Thin Sandstone Seams.	R-1 100%	Box 1	16. 33.0'
	42		39.3'-41.5', Sand, Fine-Med.-Grained, Well-Compacted, Gray, Scat. Thin Tan Siltstone Nodules.	R-2 100%	Box 2	17. 35.0'
513.94	44		41.7'-42.9', Sand w/Scat. Siltstone Nodules.	48.0		CLEANED OUT FROM 35.5'-36.0'
	46		43.0'-44.1', Sand Seams.	R-3 100%	Box 3	Set casing to 36.0'
	48		44.1'-44.5', Sandstone, Well-Cemented, Mod. Hard, Med.-Fine-Grained, Sil. Friable, Gray.	53.0		Began coring w/6" bbl. at 38.0'
	50		44.5'-44.9', Sand w/Siltstone Nodules	R-4 100%	Box 4	
	52		44.9'-60.0'	58.0		
	54		SHALE, Mod. Hard, Non-Jointed, Laminated, Dark Gray, w/Sand Seams at 46.8-47.5, 52.9-53.0, 54.95-57.9, 58.5-60.0, 47.8'-48.0', Fossiliferous Zone.	R-5 100%	Box 5	
498.84	56					
	58					
	60					
			Total Depth = 60.0'			

CARTON SAMPLES

- 39.8'-40.8'
- 43.8'-44.8'
- 50.0'-50.8'
- 55.3'-56.3'
- 58.8'-59.8'

Note 1:
Soils Logged by: A. J. Simpson, Trinity Engineering Testing Corporation;
Primary Logged By: Marr, Corps of Engineers, Fort Worth District

Note 2:
Installed 4" Plastic Pipe from 560.34 to 529.74 for ground-water observations.

Memo No. 6DC-28

DRILLING LOG	Division: Southwestern	Installation: Fort Worth	Sheet 1 of 2
PROJECT: Subrey Dam Site No. 1	NO. SIZE AND TYPE OF BIT: 8" A.S., 6" Den, 6" Core		
LOCATION (Continuation of Form No. 1): 2, 119, 250 V: 415 255	DATE FOR ELEVATION DATA: 12-7-72		
DRILLING AGENCY: Corps of Engineers	MSL		
DATE OF DRILLER: 6DC-28	Falling Model 44		
DRILLER: Trinity Engineering Testing Corporation	NO. TOTAL NO. OF CORES: 18		
	NO. UNDISTURBED BONDH SAMPLES TAKEN: 16		
	NO. TOTAL NUMBER CORE BOXES: 5		
	NO. ELEVATION GROUND WATER: See Note 2		
	NO. DATE MOLE: 11-14-72		
	NO. COMPLETED: 12-7-72		
	NO. ELEVATION TOP OF HOLE: 558.84		
	NO. TOTAL CORE RECOVERY FOR BORING: 100.0		
	NO. SIGNATURE OF INSPECTOR: See Note 1 under "Remarks"		

DEPTH	LEGEND	CLASSIFICATION OF MATERIALS (Description)	% CORE RECOVERY	BOX OR SAMPLE NO.	REMARKS (Depth, nature, etc. of strata and formations, etc., of significance)
0-2.0'		Dark Brown Clay		J1	Used 8" Auger from 0.0'-3.0'
2.0'-3.0'		Tan Clay	100	D1	Used 6" d.b. from 3.0'-38.0'
3.0'-4.0'			100	D2	Jar sample taken from shoe of each Denison sample.
4.0'-8.5'			100	D3	JAR SAMPLES
8.5'-10.0'		Tan Sandy Clay	100	D4	1. 0.0'-3.0'
10.0'-12.0'			100	D5	2. 5.0'
12.0'-14.0'			100	D6	3. 7.0'
14.0'-16.0'			100	D7	4. 9.0'
16.0'-18.0'			100	D8	5. 11.0'
18.0'-20.0'			100	D9	6. 13.0'
20.0'-22.0'			100	D10	7. 15.0'
22.0'-24.0'			100	D11	8. 17.0'
24.0'-26.0'			100	D12	9. 19.0'
26.0'-28.0'			100	D13	10. 21.0'
28.0'-30.0'			100	D14	11. 23.0'
30.0'-32.0'			100	D15	12. 25.0'
32.0'-34.0'			100	D16	13. 27.0'
34.0'-36.0'			100	D17	14. 29.0'
36.0'-44.9'		SHALE, Mod. Hard, Non-Jointed, Laminated, Dark (Continued) Gray, Often Sandy w/Thin Sandstone Seams.	100%	R-1 Box 1	15. 31.0'
44.9'-46.0'		39.3'-41.5', Sand, Fine-Med.-Grained, Well-Compacted, Gray, Scat. Thin Tan Siltstone Nodules.	100%	R-2 Box 2	16. 33.0'-35.0'
46.0'-48.0'		41.7'-42.9', Sand w/Scat. Siltstone Nodules.	100%	R-3 Box 3	17. 35.0'-38.0'
48.0'-50.0'		43.0'-44.1', Sand Seams.	100%	R-4 Box 4	
50.0'-52.0'		44.1'-44.5', Sandstone, Well-Cemented, Mod. Hard, Med.-Fine-Grained, Sil. Friable, Gray.	100%	R-5 Box 5	
52.0'-54.0'		44.5'-44.9', Sand w/Siltstone Nodules	100%		
54.0'-56.0'		44.9'-60.0'	100%		
56.0'-58.0'		SHALE, Mod. Hard, Non-Jointed, Laminated, Dark Gray, w/Sand Seams at: 46.8-47.5, 52.9-53.0, 54.95-57.9, 58.5-60.0, 47.8'-48.0', Fossiliferous Zone.	100%		
58.0'-60.0'		Total Depth = 60.0'			

DENISON SAMPLES

- 3.0'-5.0'
- 5.0'-7.0'
- 7.0'-9.0'
- 9.0'-11.0'
- 11.0'-13.0'
- 13.0'-15.0'
- 15.0'-17.0'
- 17.0'-19.0'
- 19.0'-21.0'
- 21.0'-23.0'
- 23.0'-25.0'
- 25.0'-27.0'
- 27.0'-29.0'
- 29.0'-31.0'
- 31.0'-33.0'
- 33.0'-35.0'
- 35.0'-38.0'

CARTON SAMPLES

- 39.8'-40.8'
- 43.8'-44.8'
- 50.0'-50.8'
- 55.3'-56.3'
- 58.8'-59.8'

Note 1:
Soils Logged By: A. J. Simpson, Trinity Engineering Testing Corporation;

Primary Logged By:
Marr, Corps of Engineers, Fort Worth District

Note 2:
Installed 4" Plastic Pipe from 560.34 to 529.74 for ground-water observations.

RECORD DRAWING-WORK AS BUILT

SYM	DC	NO	ACTION	DATE	DESCRIPTION OF REVISION
U.S. ARMY ENGINEER DISTRICT, FORT WORTH CORPS OF ENGINEERS FORT WORTH, TEXAS					
RAY ROBERTS LAKE ELM FORK, TRINITY RIVER, TEXAS EMBANKMENT, SPILLWAY AND OUTLET WORKS LOGS OF BORINGS 8A4C-26, 8A4C-27, AND 6 DC-28					
DESIGNED BY:	RAY ROBERTS LAKE				
DRAWN BY:	ELM FORK, TRINITY RIVER, TEXAS				
REVIEWED BY:	EMBANKMENT, SPILLWAY AND				
	OUTLET WORKS				
	LOGS OF BORINGS				
	8A4C-26, 8A4C-27, AND 6 DC-28				
SUBMITTED BY:	INVESTIGATION NO. DACW 63-82-B-0025				DATE: MAR, 1982
ENGINEER	CONTRACT NO. DACW 63-82-C-0083				SEQUENCE NO. 18
	DRAWING NUMBER				SHEET NO. OF 18

TO ACCOMPANY FOUNDATION REPORT

CONTRACT NO. DACW 63-82-C-0083

DEPTH	LOG NO.	CLASSIFICATION OF MATERIALS (Description)	% CORE RECOVERED	LOG OF SAMPLE NO.	REMARKS (Drilling notes, water level, depth of water, etc., if applicable)
					<p>Note 1: Soils Logged By: A. J. Simpson, Trinity Engineering Testing Corporation;</p> <p>Primary Logged By: Green and Marr, Corps of Engineers, Fort Worth District.</p> <p>Note 2: Installed 4" Plastic Pipe from 558.50 to 520.50 for ground- water observations.</p>

1836-A (MODIFIED) PROJECT: Aubrey Dam Site No. 1 LOG NO.: 6DC-30

DRILLING LOG		Location		Date	
PROJECT		DISTRICT		DATE	
Aubrey Dam Site No. 1		Southwestern		Fort Worth	
X-2 141 403 Y-615 378 Sta. 132+00		6DC-31		12-18-72	
Corps of Engineers		Boyd Lane		12-29-72	
Trinity Engineering Testing Corporation		See Note 2			
ELEVATION OF SURFACE		ELEVATION OF TOP OF SOLE		ELEVATION OF BOTTOM OF SOLE	
558.50		555.18		511.6	
TOTAL DEPTH OF SOLE		TOTAL DEPTH OF SOLE		TOTAL DEPTH OF SOLE	
90.0'		90.0'		90.0'	
DEPTH	ELEVATION	DESCRIPTION OF MATERIALS	PERCENT RECOVERED	LOG NO.	REMARKS
2	556.30	Brown Clay	0	J1	Used 8" Auger from 0.0'-23.0'
4	552.30	5.0'	50	D1	Used 6" Denison bbl. 3.0'-40.0'
6	546.30	Brown Sandy Clay	100	D2	Jar sample taken from shoe of each Denison sample.
8		9.0'	100	D3	JAR SAMPLES
10		Brown Silty Clay w/Sand Lenses	100	D4	1. 0.0'-3.0'
12			80	D5	2. 5.0'
14	540.30		100	D6	3. 7.0'
16		Brown Silty Sand w/Clay Lenses	90	D7	4. 9.0'
18			100	D8	5. 11.0'
20			100	D9	6. 13.0'
22	532.30		50	D10	7. 15.0'
24	530.30	Tan and Gray Sandy Clay w/Silt Lenses	100	D11	8. 17.0'
26			50	D12	9. 19.0'
28		Tan and Gray Silty Clay w/Iron Ore	75	D13	10. 21.0'
30			90	D14	11. 23.0'
32	522.30		100	D15	12. 25.0'
34		Gray Silty Sand w/Scattered Gravel	90	D16	13. 27.0'
36			100	D17	14. 29.0'
38	516.30		0		15. 31.0'
40		39.0'-45.0' SHALE	40	D18	16. 33.0'
42		39.0'-45.0' SHALE, Mod. Hard, Dk. Gray Thin-Bedded-Massive, w/Num. Lt. Gray Sand Pockets and Lenses	100%	Box 1	17. 35.0'
44	510.30	43.4' Siltstone Nods., Hard Tan	100%	Box 2	18. 38.0'-40.0'
46		45.0'-55.6' Shale & Sandstone, Alt. Bed w/occas. Sand Lenses	100%	Box 3	Reamed from 0.0'-38.0' w/8" bit.
48		Shale is Gray, Massive, Mod. Hard, Sandy Unweathered	100%	Box 4	Began coring w/6" core bbl. at 40.0'
50	499.70	55.6'-64.0' Sandstone is Fine-Med. Gray, "Tall Cemented"	100%	Box 5	Set 8" casing to 44.0'
52		Shale, Mod. Hard-Hard, Dk. Gray Laminated, Unweathered	100%	Box 6	CARTON SAMPLES
54		58.6'-59.4' Fossiliferous sand Soft-Mod. Hard, Calc.	100%	Box 7	1. 42.3'-43.3'
56	491.30	64.0'-75.4' Shale & Sandstone, Alt. Bed w/occas. Sand Lenses	100%	Box 8	2. 46.2'-46.8'
58		Shale is Mod Hard-Hard, Dk. Gray, Laminated	69.0	Box 9	3. 51.6'-52.6'
60			100%	Box 10	4. 56.5'-57.5'
62			100%	Box 11	5. 61.2'-62.2'
64			100%	Box 12	6. 64.7'-65.7'
66			100%	Box 13	7. 72.8'-73.8'
68			100%	Box 14	8. 75.4'-76.4'
70			100%	Box 15	9. 80.3'-81.3'
72			100%	Box 16	10. 85.5'-86.5'
74	479.30	75.4'-75.4'	74.0	Box 17	Note 1: Soils Logged By: A. J. Simpson, Trinity Engineering Testing Corporation
76		75.4'-90.0'	100%	Box 18	Primary Logged By: Green and Marr, Corps of Engineers, Fort Worth District
78		Shale, Gray-Dk. Gray, Mod. Hard-Hard, Laminated Calc.	79.0	Box 19	Note 2: Installed 4" plastic pipe from 556.6 to 511.6 for ground- water observations.
80			100%	Box 20	
82			100%	Box 21	
84			100%	Box 22	
86			100%	Box 23	
88			100%	Box 24	
90	465.30	90.0'	100%	Box 25	
Total Depth = 90.0 Feet					

1834-A (MODIFIED) PROJECT: Aubrey Dam Site No. 1 LOG NO.: 6DC-31

DESIGNED BY	
DRAWN BY	
REVIEWED BY	
SUBMITTED BY	
ENGINEER	

TO ACCO...

BILLING LOG		PROJECT		LOCATION		DATE	
Aubrey Dam Site No. 1		Southwestern		Fort Worth		1962	
X-2, 131, 403, 2415, 278- Sta. 132400		6DC-31		12-18-72		12-29-72	
Corps of Engineers		Boyd Lane Trinity Engineering Testing Corporation		Fall Line Model 44		19	
6DC-31		See Note 2		Elevation above datum		555.38	
19.0'		51.0'		100.0'		100.0'	
90.0'		See Note 1 under "Remarks"					
ELEVATION	DEPTH	LESSON	EXPLANATION OF MATERIALS	PERCENT	TEST	REMARKS	REMARKS
550.38	2		Brown Clay	0	J1	Used 8" Auger from 0.0'-3.0'	
	4			50	D1	Used 6" Denison bbl. 3.0'-10.0'	
546.38	6		Brown Sandy Clay	100	D2	Jar sample taken from shoe of each Denison sample.	
	8			100	D3	JAR SAMPLES	
540.38	10		Brown Silty Clay w/Sand Lenses	100	D4	1. 0.0'-3.0'	
	12			80	D5	2. 5.0'	
	14			100	D6	3. 7.0'	
	16			90	D7	4. 9.0'	
	18			100	D8	5. 11.0'	
	20			100	D9	6. 13.0'	
532.38	22		Brown Silty Sand w/Clay Lenses	50	D10	7. 15.0'	
	24			100	D11	8. 17.0'	
530.38	26		Tan and Gray Sandy Clay w/Silt Lenses	100	D12	9. 19.0'	
	28			75	D13	10. 21.0'	
	30			90	D14	11. 23.0'	
522.38	32		Tan and Gray Silty Clay w/Iron Ore	50	D15	12. 25.0'	
	34			100	D16	13. 27.0'	
	36			100	D17	14. 29.0'	
516.38	38		Gray Silty Sand w/Scattered Gravel	0		15. 31.0'	
	40			40	D18	16. 33.0'	
	42		39.0'-45.0' SHALE	R-1		17. 35.0'	
510.38	44		SHALE, Mod. Hard, Dk. Gray Thin-Bedded-Massive, w/Num. Lt. Gray Sand Pockets and Lenses	100%	Box 1	18. 37.0'	
	46		43.4' Siltstone Nods., Hard Tan	R-2		19. 39.0'	
	48		45.0'-55.6' Shale & Sandstone, Alt. Bed w/occas. Sand Lenses	100%	Box 2	20. 41.0'	
	50		Shale is Gray, Massive, Mod. Hard, Sandy Unweathered	R-3		21. 43.0'	
499.78	52		Sandstone is Fine-Med. Grs Soft-Mod. Hard, Gray-Lt. Gray, Well Cemented	100%	Box 3	22. 45.0'	
	54		55.6'-64.0' Shale, Mod. Hard-Hard, Dk. Gray Laminated, Unweathered	R-4		23. 47.0'	
	56		58.6'-59.4' Fossiliferous zone Soft-Mod. Hard, Calc	R-5		24. 49.0'	
491.38	58		64.0'-75.4' Shale & Sandstone, Alt. Bed w/occas. Sand Lenses	100%	Box 4	25. 51.0'	
	60		Shale is Mod Hard-Hard, Dk. Gray, Laminated	R-6		26. 53.0'	
	62			100%	Box 5	27. 55.0'	
	64			69.0	R-7	28. 57.0'	
	66			100%	Box 6	29. 59.0'	
479.38	68		75.4'-90.0' Shale, Gray-Dk. Gray, Mod. Hard-Hard, Laminated Calc.	R-8		30. 61.0'	
	70			100%	Box 7	31. 63.0'	
	72			100%	Box 8	32. 65.0'	
	74			79.0	R-9	33. 67.0'	
	76			100%	Box 9	34. 69.0'	
	78			100%	Box 10	35. 71.0'	
	80			89.0	R-10	36. 73.0'	
	82			100%	Box 11	37. 75.0'	
	84			100%	Box 12	38. 77.0'	
	86			89.0	R-11	39. 79.0'	
465.38	88			100%	Box 13	40. 81.0'	
	90			100%	Box 14	41. 83.0'	
		Total Depth = 90.0 Feet					

1834-A (MODIFIED) Aubrey Dam Site No. 1 6DC-31

RECORD DRAWING-WORK AS BUILT

SYM		DO	NO	ACTION	DATE	DESCRIPTION OF REVISION
U.S. ARMY ENGINEER DISTRICT, FORT WORTH CORPS OF ENGINEERS FORT WORTH, TEXAS						
DESIGNED BY:	RAY ROBERTS LAKE					
DRAWN BY:	ELM FORK, TRINITY RIVER, TEXAS					
REVIEWED BY:	EMBANKMENT, SPILLWAY AND					
REVISIONS:	OUTLET WORKS					
DATE:	LOGS OF BORINGS					
NO.:	6DC-30 AND 6DC-31					
SUBMITTED BY:	INVITATION NO. DACW 63-82-B 0025		DATE		MAR, 1962	
ENGINEER:	CONTRACT NO. DACW 63-72-C-0093		SEQUENCE NO.		19	
	DRAWING NUMBER		SHEET NO.		OF	

TO ACCOMPANY FOUNDATION REPORT

CONTRACT NO. DACW 63-82-B 0025

Memo No 356DC 32

DRILLING LOG		DIVISION		INSTALLATION		TEST	
PROJECT		Southwestern		Fort Worth		of 2	
Aubrey Dam Site No. 1		Not Shown Y 2141 310 Y 415 790		MSL		MSL	
DRILLING AGENCY		Trinity Engineering Testing Corporation		Falline Model 44		3	
CORPORATION		356DC 32		16		22	
DIRECTION OF HOLE		SEE FROM VEAT		12-30 72		1-4-73	
THICKNESS OF OVERBURDEN		41.5		557.05		100.0	
DEPTH DRILLED INTO ROCK		18.5		See Note 1 under "Remarks"			
TOTAL DEPTH OF HOLE		60.0					
ELEVATION	DEPTH	LEGEND	CLASSIFICATION OF MATERIALS	NO. OF CORE RECON. CUT	NO. OF SAMPLES	REMARKS	REMARKS
555.05	2		Brown Clay 2.0'	100	W1	3" Shelby Tube Samples	
	4		Brown Sandy Clay	100	W2	0.0'-20.0'	
	6			100	W3	Denison bbl. Samples	
	8			100	W4	20.0'-44.0'	
	10			100	W5	Jar Samples Nos. 6	
	12			100	W6	- 16 were taken	
	14			100	W7	from the shoe of	
	16			100	W8	the Denison sample.	
	18		Brown Silty Sand	100	W9	JAR SAMPLES	
	20			100	W10	1. 2.0'-3.0'	
	22			100	W11	2. 6.0'-7.0'	
	24			100	W12	3. 10.0'-11.0'	
	26			100	W13	4. 14.0'-15.0'	
	28			100	W14	5. 18.0'-19.0'	
	30			100	W15	6. 22.0'	
	32			100	W16	7. 24.0'	
	34			100	W17	8. 26.0'	
	36			100	W18	9. 28.0'	
	38			100	W19	10. 30.0'	
	40			75	D1	11. 32.0'	
	42			100	D2	12. 34.0'	
	44			100	D3	13. 38.0'	
	46			100	D4	14. 40.0'	
	48			100	D5	15. 42.0'	
	50			50	D6	16. 44.0'	
	52			100	D7	Reamed hole to 42.0'	
	54			0	Lost Sam.	w/8" bit.	
	56			50	D8	Set 8" casing to 42.0'	
	58			50	D9	Used 6" core bbl.	
	60			0	Lost Sam.	from 44.0'-60.0'	
				50	D9	WRAP SAMPLES	
				65	D10	1. 0.0'-1.0'	
				75	D11	2. 1.0'-2.0'	
				R-1	Box 1	3. 3.0'-4.5'	
				100%	Box 1	4. 4.5'-6.0'	
				49.0	R-2	5. 7.0'-8.5'	
				100%	Box 2	6. 8.5'-10.0'	
				54.0	R-3	7. 11.0'-12.5'	
				100%	Box 3	8. 12.5'-14.0'	
				59.0	R-3	9. 15.0'-16.5'	
				100%	Box 3	10. 16.5'-18.0'	
				59.0	R-3	11. 19.0'-20.0'	
				59.0	R-3	DENISON SAMPLES	
				100%	Box 3	1. 20.0'-22.0'	
				100%	Box 3	2. 22.0'-24.0'	
				100%	Box 3	3. 24.0'-26.0'	
				100%	Box 3	4. 26.0'-28.0'	
				100%	Box 3	5. 28.0'-30.0'	
				100%	Box 3	6. 30.0'-32.0'	
				100%	Box 3	7. 32.0'-34.0'	
				100%	Box 3	8. 36.0'-38.0'	
				100%	Box 3	9. 38.0'-40.0'	
				100%	Box 3	10. 40.0'-42.0'	
				100%	Box 3	11. 42.0'-44.0'	
				100%	Box 3	CARTON SAMPLES	
				100%	Box 3	1. 45.3'-46.2'	
				100%	Box 3	2. 52.6'-53.6'	
				100%	Box 3	3. 57.3'-58.1'	
				100%	Box 3	NOTE 1:	
				100%	Box 3	Soils Logged By:	
				100%	Box 3	A. J. Simpson,	
				100%	Box 3	Trinity Engineering	
				100%	Box 3	Testing Corporation	
				100%	Box 3	Primary Logged By:	
				100%	Box 3	Green and Marr,	
				100%	Box 3	Corps of Engineers,	
				100%	Box 3	Fort Worth District	
				100%	Box 3	NOTE 2:	
				100%	Box 3	Installed 4" plastic	
				100%	Box 3	pipe from 559.25 to	
				100%	Box 3	516.25 for ground-	
				100%	Box 3	water observations.	

Memo No. 6DC-33

DRILLING LOG		DIVISION		INSTALLATION		TEST	
PROJECT		Southwestern		Fort Worth		of 2	
Aubrey Dam Site No. 1		Not Shown Y 2141 310 Y 415 790		MSL		MSL	
DRILLING AGENCY		Trinity Engineering Testing Corporation		Falline Model 44		3	
CORPORATION		356DC 32		16		22	
DIRECTION OF HOLE		SEE FROM VEAT		12-30 72		1-4-73	
THICKNESS OF OVERBURDEN		41.5		557.05		100.0	
DEPTH DRILLED INTO ROCK		18.5		See Note 1 under "Remarks"			
TOTAL DEPTH OF HOLE		60.0					
ELEVATION	DEPTH	LEGEND	CLASSIFICATION OF MATERIALS	NO. OF CORE RECON. CUT	NO. OF SAMPLES	REMARKS	REMARKS
554.29	2		Brown Clay	100	D1	Used 8" Auger from	
	4			100	D2	0.0'-3.0'	
	6			100	D3	Used 6" Denison	
	8			100	D4	bbl. from 3.0'-	
	10			100	D5	44.0'	
	12			100	D6	Jar sample taken	
	14			100	D7	from shoe of each	
	16			100	D8	Denison sample.	
	18			100	D9	JAR SAMPLES	
	20			100	D10	1. 0.0'-3.0'	
	22			100	D11	2. 5.0'	
	24			100	D12	3. 7.0'	
	26			100	D13	4. 9.0'	
	28			100	D14	5. 11.0'	
	30			100	D15	6. 13.0'	
	32			100	D16	7. 15.0'	
	34			100	D17	8. 17.0'	
	36			100	D18	9. 19.0'	
	38			100	D19	10. 21.0'	
	40			100	D20	11. 23.0'	
	42			100	D21	12. 25.0'	
	44			100	D22	13. 27.0'	
	46			100	D23	14. 29.0'	
	48			100	D24	15. 31.0'	
	50			100	D25	16. 33.0'	
	52			100	D26	17. 37.0'	
	54			100	D27	18. 39.0'	
	56			100	D28	19. 41.0'	
	58			100	D29	20. 41.5'	
	60			100	D30	Denison SAMPLES	
				100	D31	1. 3.0'-5.0'	
				100	D32	2. 5.0'-7.0'	
				100	D33	3. 7.0'-9.0'	
				100	D34	4. 9.0'-11.0'	
				100	D35	5. 11.0'-13.0'	
				100	D36	6. 13.0'-15.0'	
				100	D37	7. 15.0'-17.0'	
				100	D38	8. 17.0'-19.0'	
				100	D39	9. 19.0'-21.0'	
				100	D40	10. 21.0'-23.0'	
				100	D41	11. 23.0'-25.0'	
				100	D42	12. 25.0'-27.0'	
				100	D43	13. 27.0'-29.0'	
				100	D44	14. 29.0'-31.0'	
				100	D45	15. 31.0'-33.0'	
				100	D46	16. 35.0'-37.0'	
				100	D47	17. 37.0'-39.0'	
				100	D48	18. 39.0'-41.0'	
				100	D49	Set Casing to 41.5'	
				100	D50	Began Coring w/6"	
				100	D51	bbl. at 44.0'	
				100	D52	CARTON SAMPLES	
				100	D53	1. 47.9'-48.6'	
				100	D54	2. 52.0'-53.0'	
				100	D55	3. 55.2'-56.0'	
				100	D56	NOTE 1:	
				100	D57	Soils Logged By:	
				100	D58	A. J. Simpson,	
				100	D59	Trinity Engineering	
				100	D60	Testing Corporation;	
				100	D61	Primary Logged By:	
				100	D62	Corps of Engineers,	
				100	D63	Fort Worth District	
				100	D64	NOTE 2:	
				100	D65	Installed 4" plastic	
				100	D66	pipe from 563.3 to	
				100	D67	519.1 for ground-	
				100	D68	water observations.	

Memo No. 1824-A

DRILLING LOG		DIVISION		INSTALLATION		TEST	
PROJECT		Southwestern		Fort Worth		of 2	
Aubrey Dam Site No. 1		Not Shown Y 2141 310 Y 415 790		MSL		MSL	
DRILLING AGENCY		Trinity Engineering Testing Corporation		Falline Model 44		3	
CORPORATION		356DC 32		16		22	
DIRECTION OF HOLE		SEE FROM VEAT		12-30 72		1-4-73	
THICKNESS OF OVERBURDEN		41.5		557.05		100.0	
DEPTH DRILLED INTO ROCK		18.5		See Note 1 under "Remarks"			
TOTAL DEPTH OF HOLE		60.0					
ELEVATION	DEPTH	LEGEND	CLASSIFICATION OF MATERIALS	NO. OF CORE RECON. CUT	NO. OF SAMPLES	REMARKS	REMARKS
554.29	2		Brown Clay	100	D1	Used 8" Auger from	
	4			100	D2	0.0'-3.0'	
	6			100	D3	Used 6" Denison	
	8			100	D4	bbl. from 3.0'-	
	10			100	D5	44.0'	
	12			100	D6	Jar sample taken	
	14			100	D7	from shoe of each	
	16			100	D8	Denison sample.	
	18			100	D9	JAR SAMPLES	
	20			100	D10	1. 0.0'-3.0'	
	22			100	D11	2. 5.0'	
	24			100	D12	3. 7.0'	
	26			100	D13	4. 9.0'	
	28			100	D14	5. 11.0'	
	30			100	D15	6. 13.0'	
	32			100	D16	7. 15.0'	
	34			100	D17	8. 17.0'	
	36			100	D18	9. 19.0'	
	38			100	D19	10. 21.0'	
	40			100			

356D-34
 SHEET NO. 20
 356D-34

ELEVATION		DEPTH	LEGEND	CLASSIFICATION OF MATERIALS (Designated)	% CORE RECOVERY	SOIL OR SANDS NO.	REMARKS (Disturbance, main logs, depth of weathering, etc., if significant)
546.58	2			Dark Brown Clay		W1	Boring advanced with 3" Shelby tube from 0.0'-40.5'. Cleaned out 40.5'-41.0'.
	4					W2	
	6					W3	
	8					W4	
	10					J2	Used 6" Denison barrel 41.0'-47.0'. Set 8" casing to 45.0' depth.
	12					W5	Encountered moisture at 23.0' and water at 38.0'.
	14					W6	
	16			Brown Clay w/Silt		W7	
	18					W8	
	20					J4	JAR SAMPLES
	22					W9	1. 2.0'-3.0'
	24					W10	2. 6.0'-7.0'
	26					W11	3. 10.0'-11.0'
	28					J5	4. 14.0'-15.0'
	30					W12	5. 18.0'-19.0'
	32					W13	6. 22.0'-23.0'
	34					J6	7. 26.0'-27.0'
	36					W14	8. 30.0'-31.0'
	38					W15	9. 34.0'-35.0'
	40					J7	10. 38.0'-39.0'
	42					W16	11. 43.0'
	44					W17	12. 45.0'
	46					J8	13. 47.0'
	48					W18	DENISON SAMPLES
						W19	1. 41.0'-43.0'
						W20	2. 43.0'-45.0'
						J9	3. 45.0'-47.0'
						W21	WRAP SAMPLES
					75%	D1	1. 0.0'-1.0'
					100%	D2	2. 1.0'-2.0'
						D3	3. 3.0'-4.0'
							4. 4.5'-6.0'
							5. 7.0'-8.5'
							6. 8.5'-10.0'
							7. 11.0'-12.5'
							8. 12.5'-14.0'
							9. 15.0'-16.5'
							10. 16.5'-18.0'
							11. 19.0'-20.5'
							12. 20.5'-22.0'
							13. 23.0'-24.5'
							14. 24.5'-26.0'
							15. 27.0'-28.5'
							16. 28.5'-30.0'
							17. 31.0'-32.5'
							18. 32.5'-34.0'
							19. 35.0'-36.5'
							20. 36.5'-38.0'
							21. 39.0'-40.5'

Note 1:
 Soils logged by:
 A. J. Simpson,
 Trinity Engineering
 Testing Corporation.

Note 2:
 4" plastic pipe in-
 stalled from
 for groundwater
 observations.

RECORD DRAWING-WORK AS BUILT

SYM	DOC NO	ACTION	DATE	DESCRIPTION OF REVISION
U.S. ARMY ENGINEER DISTRICT, FORT WORTH CORPS OF ENGINEERS FORT WORTH, TEXAS				
DESIGNED BY	RAY ROBERTS LAKE ELM FORK, TRINITY RIVER, TEXAS EMBANKMENT, SPILLWAY AND OUTLET WORKS LOGS OF BORINGS 3S6DC-32, 6DC-33, 3S6D-34, AND 3S6D-35			
APPROVED BY				
REVIEWED BY				
SUBMITTED BY	INVITATION NO. DACW63-82 B-0025 DATE MAR, 1982			
ENGINEER	CONTRACT NO. DACW63-82 C 0043			SEQUENCE NO. 20
	DRAWING NUMBER		SHEET NO.	OF 20

TO ACCOMPANY FOUNDATION REPORT

UNTRACT NO. DACW63-82 C 0043

Hole No. 356D-36

DRILLING LOG		INSTALLATION				
PROJECT: Fort Worth		SHEET 1 of 2 sheets				
NO. SITE AND TYPE OF BIT: 3" Shelby, 6" Denison		MSL				
CO. DATA: MSL		Falling Model 44				
NO. TOTAL NO. OF OVERBURDEN SAMPLES TAKEN: 14		NO. TOTAL NUMBER CORE BOSES: 0				
NO. ELEVATION GROUND WATER: See Note 2		NO. DATE MOLE: 1-29-73				
NO. THICKNESS OF OVERBURDEN: 44.0'		NO. ELEVATION TOP OF MOLE: 557.89				
NO. DEPTH OF LIES INTO ROCK: 2.0'		NO. TOTAL CORE RECOVERY FOR BORING: See Note 1 under "Remarks"				
NO. TOTAL DEPTH OF HOLE: 46.0'		NO. SIGNATURE OF INSPECTOR: See Note 1 under "Remarks"				
ELEVATION	DEPTH	LEGEND	CLASSIFICATION OF MATERIALS (Description)	NO. CORE RECOVERY	NO. OF SAMPLES	REMARKS (Drilling time, water loss, depth of penetration, etc.)
549.38	2		Brown Clay		W1	Drilling
	4		Brown Clay		W2	3" Shelby; 0.0'-26.0',
	6		Brown Clay		W3	Cleaned out
	8		Brown Clay		W4	Set 26.0' of 8" casing
	10		Brown Clay		W5	6" d. b. from 26.0'-
	12		Brown Clay		J2	46.0'. Advanced casing
	14		Brown Clay		J3	to 45.0'.
	16		Brown Clay		J4	WRAP SAMPLES
	18		Brown Clay		J5	1. 0.0'-1.0'
	20		Brown Clay		J6	2. 1.0'-2.0'
	22		Brown Clay		J7	3. 3.0'-4.5'
	24		Brown Clay		J8	4. 4.5'-6.0'
	26		Brown Clay		J9	5. 7.0'-8.5'
	28		Brown Clay		J10	6. 8.5'-10.0'
	30		Brown Clay		J11	7. 11.0'-12.5'
	32		Brown Clay		J12	8. 12.5'-14.0'
	34		Brown Clay		J13	9. 15.0'-16.5'
	36		Brown Clay		J14	10. 16.5'-18.0'
	38		Brown Clay		J15	11. 19.0'-20.5'
	40		Brown Clay		J16	12. 20.5'-22.0'
	42		Brown Clay		J17	13. 23.0'-24.5'
	44		Brown Clay		J18	JAR SAMPLES
	46		Brown Clay		J19	1. 2.0'-3.0'
543.88	28		Tan and Brown Clay w/ Calcareous Particles	100%	D1	2. 6.0'-7.0'
	30		Tan and Brown Clay w/ Calcareous Particles	100%	D2	3. 10.0'-11.0'
	32		Tan and Brown Clay w/ Calcareous Particles	100%	D3	4. 14.0'-15.0'
	34		Tan and Brown Clay w/ Calcareous Particles	100%	D4	5. 18.0'-19.0'
	36		Tan and Brown Clay w/ Calcareous Particles	100%	D5	6. 22.0'-23.0'
	38		Tan and Brown Clay w/ Calcareous Particles	100%	D6	7. 28.0'
	40		Tan and Brown Clay w/ Calcareous Particles	100%	D7	8. 30.0'
	42		Tan and Brown Clay w/ Calcareous Particles	100%	D8	9. 32.0'
	44		Tan and Brown Clay w/ Calcareous Particles	100%	D9	10. 34.0'
529.88	28		Tan and Light Gray Sandy Clay	100%	D10	11. 36.0'
	30		Tan and Light Gray Sandy Clay	100%	D11	12. 38.0'
	32		Tan and Light Gray Sandy Clay	100%	D12	13. 40.0'
	34		Tan and Light Gray Sandy Clay	100%	D13	14. 42.0'
	36		Tan and Light Gray Sandy Clay	100%	D14	15. 44.0'
	38		Tan and Light Gray Sandy Clay	100%	D15	16. 46.0'
	40		Tan and Light Gray Sandy Clay	100%	D16	DENISON SAMPLES
	42		Tan and Light Gray Sandy Clay	100%	D17	1. 26.0'-28.0'
	44		Tan and Light Gray Sandy Clay	100%	D18	2. 28.0'-30.0'
	46		Tan and Light Gray Sandy Clay	100%	D19	3. 30.0'-32.0'
			Tan and Light Gray Sandy Clay	100%	D20	4. 32.0'-34.0'
			Tan and Light Gray Sandy Clay	100%	D21	5. 34.0'-36.0'
			Tan and Light Gray Sandy Clay	100%	D22	6. 36.0'-38.0'
			Tan and Light Gray Sandy Clay	100%	D23	7. 38.0'-40.0'
			Tan and Light Gray Sandy Clay	100%	D24	8. 40.0'-42.0'
			Tan and Light Gray Sandy Clay	100%	D25	9. 42.0'-44.0'
			Tan and Light Gray Sandy Clay	100%	D26	10. 44.0'-46.0'

Note 1:
Soils logged by:
A. J. Simpson,
Trinity Engineering
Testing Corporation.

Note 2:
Install 4" plastic pipe
from 559.18 to 513.18
for groundwater
observations.

Boring was advanced to
26.0 feet below the
ground surface prior
to using drilling fluid
and groundwater was
encountered at the
18.0-foot depth.

Hole

DRILLING LOG		INSTALLATION				
PROJECT: Southwestern		SHEET 1 of 2 sheets				
NO. SITE AND TYPE OF BIT: 3" Shelby, 6" Denison		MSL				
CO. DATA: MSL		Falling Model 44				
NO. TOTAL NO. OF OVERBURDEN SAMPLES TAKEN: 15		NO. TOTAL NUMBER CORE BOSES: 0				
NO. ELEVATION GROUND WATER: See Note 2		NO. DATE MOLE: 1-20-73				
NO. THICKNESS OF OVERBURDEN: 44.0'		NO. ELEVATION TOP OF MOLE: 556.0				
NO. DEPTH OF LIES INTO ROCK: 2.0'		NO. TOTAL CORE RECOVERY FOR BORING: See Note 1 under "Remarks"				
NO. TOTAL DEPTH OF HOLE: 46.0'		NO. SIGNATURE OF INSPECTOR: See Note 1 under "Remarks"				
ELEVATION	DEPTH	LEGEND	CLASSIFICATION OF MATERIALS (Description)	NO. CORE RECOVERY	NO. OF SAMPLES	REMARKS (Drilling time, water loss, depth of penetration, etc.)
553.68	2		Brown Clay		W1	DRILLING
	4		Brown Clay		W2	3" Shelby
	6		Brown Clay		W3	Cleaned
	8		Brown Clay		W4	31.0'-46
	10		Brown Clay		W5	WRAP
	12		Brown Clay		W6	1. 0.0'
	14		Brown Clay		W7	2. 1.0'
	16		Brown Clay		W8	3. 3.0'
	18		Brown Clay		W9	4. 4.0'
	20		Brown Clay		W10	5. 7.0'
	22		Brown Clay		W11	6. 8.0'
	24		Brown Clay		W12	7. 11.0'
	26		Brown Clay		W13	8. 12.0'
	28		Brown Clay		W14	9. 15.0'
	30		Brown Clay		W15	10. 16.0'
	32		Brown Clay		W16	11. 19.0'
	34		Brown Clay		W17	12. 20.5'
	36		Brown Clay		W18	13. 23.0'
	38		Brown Clay		W19	14. 24.5'
	40		Brown Clay		W20	15. 27.0'
	42		Brown Clay		W21	16. 28.5'
	44		Brown Clay		W22	JAR SA
	46		Brown Clay		W23	1. 2.0'
549.68	2		Tan Silty Clay		J1	2. 6.0'
	4		Tan Silty Clay		J2	3. 10.0'
	6		Tan Silty Clay		J3	4. 14.0'
	8		Tan Silty Clay		J4	5. 18.0'
	10		Tan Silty Clay		J5	6. 22.0'
	12		Tan Silty Clay		J6	7. 26.0'
	14		Tan Silty Clay		J7	8. 30.0'
	16		Tan Silty Clay		J8	9. 33.0'
	18		Tan Silty Clay		J9	10. 35.0'
	20		Tan Silty Clay		J10	11. 37.0'
	22		Tan Silty Clay		J11	12. 38.0'
	24		Tan Silty Clay		J12	13. 38.0'
	26		Tan Silty Clay		J13	14. 42.0'
	28		Tan Silty Clay		J14	15. 42.0'
	30		Tan Silty Clay		J15	16. 46.0'
	32		Tan Silty Clay		J16	DENISON
	34		Tan Silty Clay		J17	1. 31.0'
	36		Tan Silty Clay		J18	2. 33.0'
	38		Tan Silty Clay		J19	3. 35.0'
	40		Tan Silty Clay		J20	4. 37.0'
	42		Tan Silty Clay		J21	5. 40.0'
	44		Tan Silty Clay		J22	6. 44.0'
	46		Tan Silty Clay		J23	Set 8" casing

Note 1:
Soils logged
A. J. Simpson,
Trinity Eng
Testing Co

Note 2:
Installed 4"
pipe from
511.68 for
water obser

Division		Installation	
Southwestern		Fort Worth	
No. 1		Aubrey Dam Site No. 1	
4.471 Sta. 121+00/619'R		3" Shelby & 6" d. b.	
MSL		MSL	
Falling Model 44		Falling Model 44	
356DC-37		356DC-38	
Boyd Lane		Boyd Lane	
Testing Corporation		Trinity Engineering Testing Corporation	
1-20-73		1-20-73	
44.0'		44.0'	
2.0'		2.0'	
46.0'		46.0'	
CLASSIFICATION OF MATERIALS		CLASSIFICATION OF MATERIALS	
Brown Clay		Brown Clay	
3.0'		3.0'	
Tan Silty Clay		Tan Silty Clay	
7.0'		7.0'	
Light Brown Silty Clay		Light Brown Silty Clay	
11.0'		11.0'	
Tan and Brown Silty Clay		Tan and Brown Silty Clay	
0.0'		0.0'	
Tan Silty Sandy Clay		Tan Silty Sandy Clay	
0.0'		0.0'	
Tan Clayey Sand		Tan Clayey Sand	
2.0'		2.0'	
Tan Silty Sand		Tan Silty Sand	
1.0'		1.0'	
Tan Sand and Gravel		Tan Sand and Gravel	
1.0'		1.0'	
Tan Sand and Gravel		Tan Sand and Gravel	
0.0'		0.0'	
Gray Shale		Gray Shale	
0.0'		0.0'	
Total Depth = 46.0 Feet		Total Depth = 45.5 Feet	

Note 1:
Soils logged by:
A. J. Simpson,
Trinity Engineering
Testing Corporation.

Note 2:
Installed 4" plastic
pipe from 557.68 to
511.68 for ground-
water observations.

Division		Installation	
Southwestern		Fort Worth	
Aubrey Dam Site No. 1		Aubrey Dam Site No. 1	
Not Shown		Not Shown	
Corps of Engineers		Corps of Engineers	
356D-38		356D-38	
Boyd Lane		Boyd Lane	
Trinity Engineering Testing Corporation		Trinity Engineering Testing Corporation	
1-20-73		1-20-73	
44.0'		44.0'	
2.0'		2.0'	
46.0'		46.0'	
CLASSIFICATION OF MATERIALS		CLASSIFICATION OF MATERIALS	
Dark Brown Clay		Dark Brown Clay	
3.0'		3.0'	
Brown Clay		Brown Clay	
8.5'		8.5'	
Light Brown Silty Clay		Light Brown Silty Clay	
26.0'		26.0'	
Tan Sandy Clay		Tan Sandy Clay	
28.5'		28.5'	
Tan Sand w/Gravel		Tan Sand w/Gravel	
36.0'		36.0'	
Tan Sand and Gravel		Tan Sand and Gravel	
44.0'		44.0'	
Gray Shale		Gray Shale	
45.5'		45.5'	
Total Depth = 45.5 Feet		Total Depth = 45.5 Feet	

Note 1:
Soils logged by:
A. J. Simpson,
Trinity Engineering
Testing Corporation.

Note 2:
Installed 4" plastic
pipe from
for groundwater
observations.

Division		Installation	
Southwestern		Fort Worth	
Aubrey Dam Site No. 1		Aubrey Dam Site No. 1	
Not Shown		Not Shown	
Corps of Engineers		Corps of Engineers	
356D-38		356D-38	
Boyd Lane		Boyd Lane	
Trinity Engineering Testing Corporation		Trinity Engineering Testing Corporation	
1-20-73		1-20-73	
44.0'		44.0'	
2.0'		2.0'	
46.0'		46.0'	
CLASSIFICATION OF MATERIALS		CLASSIFICATION OF MATERIALS	
Dark Brown Clay		Dark Brown Clay	
3.0'		3.0'	
Brown Clay		Brown Clay	
8.5'		8.5'	
Light Brown Silty Clay		Light Brown Silty Clay	
26.0'		26.0'	
Tan Sandy Clay		Tan Sandy Clay	
28.5'		28.5'	
Tan Sand w/Gravel		Tan Sand w/Gravel	
36.0'		36.0'	
Tan Sand and Gravel		Tan Sand and Gravel	
44.0'		44.0'	
Gray Shale		Gray Shale	
45.5'		45.5'	
Total Depth = 45.5 Feet		Total Depth = 45.5 Feet	

RECORD DRAWING-WORK AS BUILT

Division	Southwestern	INSTALLATION	Fort Worth	SHEET	1	OF 2 SHEETS
PROJECT	Dam Site No. 1	NO. SIZE AND TYPE OF BIT	3" Shelby, 6" d.b.	DATE FOR ELEVATION	1-18-73	MSL
LOCATION	Not Shown	MANUFACTURER'S DESIGNATION OF DRILL	Falling Model 44	TOTAL NO. OF OVERBURDEN SAMPLES TAKEN	11	UNDISTURBED
DRILLING AGENCY	Corps of Engineers	MANUFACTURER'S DESIGNATION OF DRILL	Falling Model 44	TOTAL NO. OF OVERBURDEN SAMPLES TAKEN	19	UNDISTURBED
HOLE NO. FOR IDENTIFICATION ON DRAWING	356D-38	NAME OF DRILLER	Boyd Lane	TOTAL NUMBER CORE BORES	0	
DIRECTION OF HOLE	Vertical	TRINITY ENGINEERING TESTING CORPORATION		ELEVATION GROUND WATER	See Note 2	
DATE HOLE	1-18-73	DATE HOLE	1-20-73	ELEVATION TOP OF HOLE	559.07	
THICKNESS OF OVERBURDEN	44.0'	DEPTH DRILLED INTO ROCK	1.5'	TOTAL CORE RECOVERY FOR BORING	---	
TOTAL DEPTH OF HOLE	45.5'	SIGNATURE OF INSPECTOR		See Note 1 under "Remarks"		

DEPTH	LEGEND	CLASSIFICATION OF MATERIALS (Description)	% CORE RECOVERY	NO. OF SAMPLES	REMARKS (Drilling time, water loss, depth of overburden, etc., if significant)
0-3.0'		Dark Brown Clay		W1, W2, J1, W3	3" Shelby tube samples from 0.0'-30.0'. Boring was advanced to 30.0' prior to using drilling fluid.
3.0-8.5'		Brown Clay		W4, J2, W5	Water at 20.5'. 6" d.b. from 30.0'-45.5'.
8.5-26.0'		Light Brown Silty Clay		W6, J3, W7, W8, J4, W9, W10, W11, W12, J7, W13, W14	Set 8" casing to 44.0'. WRAP SAMPLES: 1. 0.0'-1.0', 2. 1.0'-2.0', 3. 3.0'-4.5', 4. 4.5'-6.0', 5. 7.0'-8.5', 6. 8.5'-10.0', 7. 11.0'-12.5', 8. 12.5'-14.0', 9. 15.0'-16.5', 10. 16.5'-18.0', 11. 19.0'-20.5', 12. 20.5'-22.0', 13. 23.0'-24.5', 14. 24.5'-26.0'.
26.0-28.5'		Tan Sandy Clay		J8, W15, W16	15. 27.0'-28.5', 16. 28.5'-30.0'.
28.5-36.0'		Tan Sand w/Gravel	100% D1, 100% D2, 0%	D1, D2	DENISON SAMPLES: 1. 30.0'-32.0', 2. 32.0'-34.0', 3. 42.0'-44.0', 4. 44.0'-45.5'.
36.0-44.0'		Tan Sand and Gravel	0%, 10% J11	J11	JAR SAMPLES: 1. 2.0'-3.0', 2. 6.0'-7.0', 3. 10.0'-11.0', 4. 14.0'-15.0', 5. 18.0'-19.0', 7. 22.0'-23.0', 8. 26.0'-27.0', 9. 32.0', 10. 34.0', 11. 38.0'-40.0', 12. 44.0', 13. 45.5'.
44.0-45.5'		Gray Shale	100% D4	D4	
Total Depth = 45.5 Feet					

Note 1: Soils logged by: A. J. Simpson, Trinity Engineering Testing Corporation.

Note 2: Installed 4" plastic pipe from for groundwater observations.

RECORD DRAWING-WORK AS BUILT

Division	Southwestern	INSTALLATION	Fort Worth	SHEET	2	OF 2 SHEETS
PROJECT	Aubrey Dam Site No. 1	NO. SIZE AND TYPE OF BIT	3" Shelby, 6" d.b.	DATE FOR ELEVATION	1-16-73	MSL
LOCATION	Not Shown	MANUFACTURER'S DESIGNATION OF DRILL	Falling Model 44	TOTAL NO. OF OVERBURDEN SAMPLES TAKEN	11	UNDISTURBED
DRILLING AGENCY	Corps of Engineers	MANUFACTURER'S DESIGNATION OF DRILL	Falling Model 44	TOTAL NO. OF OVERBURDEN SAMPLES TAKEN	19	UNDISTURBED
HOLE NO. FOR IDENTIFICATION ON DRAWING	356D-39	NAME OF DRILLER	Boyd Lane	TOTAL NUMBER CORE BORES	0	
DIRECTION OF HOLE	Vertical	TRINITY ENGINEERING TESTING CORPORATION		ELEVATION GROUND WATER	See Note 2	
DATE HOLE	1-16-73	DATE HOLE	1-17-73	ELEVATION TOP OF HOLE	560.61	
THICKNESS OF OVERBURDEN	45.5'	DEPTH DRILLED INTO ROCK	1.5'	TOTAL CORE RECOVERY FOR BORING	---	
TOTAL DEPTH OF HOLE	47.0'	SIGNATURE OF INSPECTOR		See Note 1 under "Remarks"		

DEPTH	LEGEND	CLASSIFICATION OF MATERIALS (Description)	% CORE RECOVERY	NO. OF SAMPLES	REMARKS (Drilling time, water loss, depth of overburden, etc., if significant)
0-4.5'		Dark Brown Clay		W1, W2, J1, W3	3" Shelby tube samples from 0.0'-34.0'. 6" d.b. samples from 34.0'-47.0'. Boring was advanced to 34.0' prior to using drilling fluid.
4.5-27.0'		Brown Silty Clay		W4, J2, W5, W6, J3, W7, W8, J4, W9, W10, W11, W12, J7, W13, W14	Set 8" casing to 46.0'. WRAP SAMPLES: 1. 0.0'-1.0', 2. 1.0'-2.0', 3. 3.0'-4.5', 4. 4.5'-6.0', 5. 7.0'-8.5', 6. 8.5'-10.0', 7. 11.0'-12.5', 8. 12.5'-14.0', 9. 15.0'-16.5', 10. 16.5'-18.0', 11. 19.0'-20.5', 12. 20.5'-22.0', 13. 23.0'-24.5', 14. 24.5'-26.0', 15. 27.0'-28.5', 16. 28.5'-30.0', 17. 31.0'-32.5', 18. 32.5'-34.0'.
27.0-39.5'		Tan Sandy Clay		J8, W15, W16	15. 27.0'-28.5', 16. 28.5'-30.0', 17. 31.0'-32.5', 18. 32.5'-34.0'.
39.5-45.5'		Tan Clayey Sand		J9, W17, W18	DENISON SAMPLES: 1. 34.0'-36.0', 2. 36.0'-38.0', 3. 38.0'-40.0', 4. 40.0'-42.0', 5. 42.0'-44.0', 6. 45.5'-47.0'.
45.5-515.11		Tan Sand and Gravel	75% D3, 85% D4, 90% D5, 33% J14	D3, D4, D5, J14	A jar sample was taken from the shoe of each denison barrel run. JAR SAMPLES: 1. 2.0'-3.0', 2. 6.0'-7.0', 3. 10.0'-11.0', 4. 14.0'-15.0', 5. 18.0'-19.0', 6. 22.0'-23.0', 7. 26.0'-27.0', 8. 30.0'-31.0', 9. 36.0', 10. 38.0', 11. 40.0', 12. 42.0', 13. 44.0', 14. 44.0'-45.5', 15. 47.0'.
515.11-513.61		Gray Shale	100% D6	D6	
Total Depth = 47.0 Feet					

Note 1: Soils logged by: A. J. Simpson, Trinity Engineering Testing Corporation.

DESIGNED BY:	RAY ROBERTS LAKE		
DRAWN BY:	ELM FORK, TRINITY RIVER, TEXAS		
CHECKED BY:	EMBANKMENT, SPILLWAY AND		
APPROVED BY:	OUTLET WORKS		
SUBMITTED BY:	LOGS OF BORINGS		
ENGINEER:	8S6D-36, 3S6DC-37, 3S6D-38, AND 3S6D-39		
INVESTIGATION NO. DACW63-82-B-0025		DATE MAR, 1982	
CONTRACT NO. DACW63-82-C-0023		SEQUENCE NO. 21	
DRAWING NUMBER		SHEET NO. OF	

TO ACCOMPANY FOUNDATION REPORT

CONTRACT NO. DACW63-82-C-0023

DRILLING LOG		SWITCHED ON		No. No. 354D-40	
PROJECT: Aubrey Dam Site No. 1		INSTALLATION: Fort Worth		SHEET 1 OF 2 SHEETS	
GRID COORDINATES: X = 2,142,040; Y = 616,930		MSL		NK-CORE	
CORPS OF ENGINEERS		DAMCO 1150		CORPS OF ENGINEERS	
BILL STATION: 354D-40		ELEVATION 640.04		DATE MOLE: 11-30-73	
TRINITY ENGINEERING TESTING CORPORATION		ELEVATION TOP OF MOLE: 640.04		DATE MOLE: 2-8-73	
THICKNESS OF OVERBURDEN: 15.0'		ELEVATION 640.04		DATE MOLE: 2-8-73	
DEPTH DRILLED INTO ROCK: 12.0'		ELEVATION 640.04		DATE MOLE: 2-8-73	
TOTAL DEPTH OF MOLE: 27.0'		ELEVATION 640.04		DATE MOLE: 2-8-73	
ELEVATION		DEPTH		CLASSIFICATION OF MATERIALS	
562.3	2	Brown Silty Sand	W1	DRILLING: 0.0'-9.0', 3" Shelby	
559.3	4	Brown Silty Sand w/Clay Lenses	B1	9.0'-17.0', 4" d.b.	
557.3	6	Red and Brown Clayey Sand	J2	17.0'-27.0', NX-CORE.	
556.3	8	Brown and Light Gray Clayey Sand	W2	Set tub at 9.0'.	
551.3	10	Gray Clay w/Sand Lenses and Iron Ore Particles	D1	WRAP SAMPLES:	
544.1	12	Tan Sandstone w/Shale Lenses	D2	1. 0.0'-2.0'	
539.3	14	Gray Shale	D3	2. 6.0'-8.0'	
	16		D4	3. 22.2'-22.9'	
	18		R-1	4. 23.5'-24.4'	
	20		Box 1	JAR SAMPLES:	
	22		R-2	1. 2.0'-4.0'	
	24		W3	2. 6.0'-8.0'	
	26		W4	3. 11.0'	
	28		W5	4. 13.0'	
			W6	5. 15.0'	
			W7	6. 17.0'	
			W8	Set 8" casing to the 17.0' depth.	
			W9	Note 1:	
			W10	Soils logged by:	
			W11	A. J. Simpson,	
			W12	Trinity Engineering	
			W13	Testing Corporation.	
			W14	Note 2:	
			W15	Installed 4" plastic	
			W16	pipe from 650.0 to	
			W17	631.0 for ground-	
			W18	water observations.	
			W19	Total Depth = 27.0 Feet	

ENG FORM 1836-A (MODIFIED) PROJECT: Aubrey Dam Site No. 1 356D-40

DRILLING LOG		SWITCHED ON		No. No. 354C-41	
PROJECT: Aubrey Dam Site No. 1		INSTALLATION: Fort Worth		SHEET 1 OF 2 SHEETS	
GRID COORDINATES: X = 2,142,525; Y = 616,930		MSL		NK-CORE	
CORPS OF ENGINEERS		DAMCO 1250		CORPS OF ENGINEERS	
BILL STATION: 354C-41		ELEVATION 660.20		DATE MOLE: 11-30-73	
TRINITY ENGINEERING TESTING CORPORATION		ELEVATION TOP OF MOLE: 660.20		DATE MOLE: 2-13-73	
THICKNESS OF OVERBURDEN: 49.0'		ELEVATION 660.20		DATE MOLE: 2-13-73	
DEPTH DRILLED INTO ROCK: 10.0'		ELEVATION 660.20		DATE MOLE: 2-13-73	
TOTAL DEPTH OF MOLE: 59.0'		ELEVATION 660.20		DATE MOLE: 2-13-73	
ELEVATION		DEPTH		CLASSIFICATION OF MATERIALS	
664.70	2	0.4' Brown Clayey Sand	B1	DRILLING: 0.0'-9.0', 3" Shelby	
660.20	4	Red Clayey Silty Sand	J1	9.0'-49.0', NX-CORE	
	6		W1	And 2" Split-Spoon	
	8		W2	49.0'-59.0', 4" CORE	
	10		W3	*All recovered NX-	
	12	Red and Orange Sand (Cemented)	W4	Core Samples were	
	14		J2	placed in PETCO's	
	16		R2	cardboard core box	
	18		B2	Set 6" casing to 49.0'	
	20		B3	depth. Sand washed	
	22		B4	away with drilling	
	24		B5	fluid.	
	26		B6	JAR SAMPLES:	
	28		B7	1. 2.0'-3.0'	
	30		B8	2. 6.0'-7.0'	
	32		B9	BAG SAMPLES:	
	34		B10	1. 0.0'-1.0'	
	36		B11	2. 7.0'-8.0'	
	38		B12	3. 8.0'-9.0'	
	40		B13	4. 18.0'-19.0'	
	42		B14	5. 23.0'-24.0'	
	44		B15	6. 28.0'-29.0'	
	46		B16	7. 33.0'-34.0'	
	48		B17	8. 38.0'-39.0'	
	50		B18	9. 43.0'-44.0'	
	52		B19	WRAP SAMPLES:	
	54		B20	1. 1.0'-2.0'	
	56		B21	2. 3.0'-4.0'	
	58		B22	3. 5.0'-6.0'	
	60		B23	4. 7.0'-8.0'	
			B24	5. 47.9'-48.5'	
			B25	CARTONS:	
			B26	1. 52.5'-53.4'	
			B27	BOXES:	
			B28	1. 49.0'-54.0'	
			B29	2. 54.0'-59.0'	
			B30	Note 1:	
			B31	Soils logged by:	
			B32	A. J. Simpson,	
			B33	Trinity Engineering	
			B34	Testing Corporation	
			B35	Primary logged by:	
			B36	Max F.	
			B37	Fort Worth District,	
			B38	Corps of Engineers	
			B39	Note 2:	
			B40	2" plastic pipe install	
			B41	from 666.2 to 616.2	
			B42	for groundwater ob-	
			B43	servations.	
			B44	Total Depth of Boring = 59.0'	

ENG FORM 1836-A (MODIFIED) PROJECT: Aubrey Dam Site No. 1 354C-41

Notes:
 1. See Note 2
 2. 1-7-73
 3. 662.00
 4. 31.8
 5. 354C-42

DRILLING LOG		Southwestern	Fort Worth
Aubrey Dam Site No. 1			
354C-42			
Corps of Engineers			
Bord Lane			
Trinity Engineering Testing Corporation			
See Note 2			
1-5-73			
556.34			
98.0			
See Note 1 under "Remarks"			
ELEVATION	DEPTH	SECTION	CLASSIFICATION OF MATERIALS
591.46	2		Tan and Brown Clay
	4		
	6		Tan Sandy Clay
	8		
	10		
	12		
582.36	14		Limestone Gravel, Weathered, Tan Mod.
	16		Hard
578.46	18		Shale and Sandstone, Predominantly Shale w/Num. Layers and Lenses of Sandstone and Siltstone Nodules.
	20		
	22		
	24		
568.96	90		Total Depth = 90.0 Feet

DRILLING LOG		Southwestern	Fort Worth
Aubrey Dam Site No. 1			
354C-42			
Corps of Engineers			
Bord Lane			
Trinity Engineering Testing Corporation			
See Note 2			
1-5-73			
556.34			
98.0			
See Note 1 under "Remarks"			
ELEVATION	DEPTH	SECTION	CLASSIFICATION OF MATERIALS
585.68	2		Brown Silty Clay
	4		Tan Sandy Clay
581.36	6		Tan and Brown Clay w/ Scattered Gravel
579.46	8		Limestone Gravel, Mod. Hard, Weath., Tan w/Num. Clay, Lenses, Tan and Stained.
575.66	10		Shale, Gray, Mod. Hard, w/Occasional Sand and Sandstone Seams
567.16	12		
562.66	14		
	16		
	18		
	20		
RECORD DRAWING-WORK AS BUILT

U.S. ARMY ENGINEER DISTRICT, FORT WORTH
 CORPS OF ENGINEERS
 FORT WORTH, TEXAS

DESIGNED BY: RAY ROBERTS LAKE
 DRAWN BY: ELM FORK, TRINITY RIVER, TEXAS
 REVIEWED BY: EMBANKMENT, SPILLWAY AND
 LOGS OF BORINGS
 356D-40, 354C-41, 354C-42, 356DC-50 AND 35-51

SUBMITTED BY: INVITATION NO. DACW63-82-B-0025 DATE MAR, 1982
 CONTRACT NO. DACW63-82-C-0083
 DRAWING NUMBER: SHEET NO. 22

TO ACCOMPANY FOUNDATION REPORT

Hole No. 35-52

DRILLING: Division Southwestern		INSTALLATION: Fort Worth		SHEET: 1 OF 1 SHEETS	
PROJECT: Aubrey Dam Site No. 1		HOLE NO. AND TYPE OF BIT: 3" Shelby tube		DATE: 1-23-73	
LOCATION: Not Shown		M.S.L. DATE FOR ELEVATION DATA: MSL		DATE OF SURVEY: 1-23-73	
DRAWN BY: Corps of Engineers		FALLING MODEL: 44		TOTAL NO. OF OVERBURDEN SAMPLES TAKEN: 7	
HOLE NO. AS SHOWN ON DRAWING: 35-52		TOTAL NUMBER CORE BOXES: 0		ELEVATION GROUND WATER: See Note 2	
NAME OF DRILLER: Boyd Lane		ELEVATION TOP OF HOLE: 568.34		DATE MOLE: 1-23-73	
TRINITY ENGINEERING TESTING CORPORATION		TOTAL CORE RECOVERY FOR BORING: See Note 1		SIGNATURE OF INSPECTOR: See Note 1 under "Remarks"	
THICKNESS OF OVERBURDEN: 17.5'		DEPTH DRILLED INTO ROCK: 1.5'		TOTAL DEPTH OF HOLE: 19.0'	

ELEVATION	DEPTH	LEGEND	CLASSIFICATION OF MATERIALS (Description)	SCORE RECOVERY (%)	BOX OR SAMPLE NO.	REMARKS (Drilling time, water level, depth of measuring, etc., if significant)
566.34	2		Brown Sandy Clay		W1	Boring was advanced to 15.0' prior to using drilling fluid. Water at 12.5'. All samples taken with 3" Shelby tube, except B2, which is a washed sample.
	4		Brown and Tan Sandy Clay w/Iron Ore		W2	
562.34	6		6.0'		W3	
	8		Brown and Light Gray Sandy Clay w/Iron Ore		W4	
560.04	10		Tan Clayey Silty Sand w/Gravel		W5	
	12				B1	
	14				J3	
	16				W6	
550.84	17.5'				W7	
	18		Gray Shale		J4	
549.34	19.0'		Total Depth = 19.0 Feet		B2	
					W8	
					J5	
					W9	
					B3	

PROJECT: **Aubrey Dam Site No. 1** HOLE NO.: **35-52**

Hole No. 35-53

DRILLING: Division Southwestern		INSTALLATION: Fort Worth		SHEET: 1 OF 1 SHEETS	
PROJECT: Aubrey Dam Site No. 1		HOLE NO. AND TYPE OF BIT: 3" Shelby		DATE: 1-23-73	
LOCATION: X=2,138,455; Y=612,795		M.S.L. DATE FOR ELEVATION DATA: MSL		DATE OF SURVEY: 1-23-73	
DRAWN BY: Corps of Engineers		FALLING MODEL: 44		TOTAL NO. OF OVERBURDEN SAMPLES TAKEN: 3	
HOLE NO. AS SHOWN ON DRAWING: 35-53		TOTAL NUMBER CORE BOXES: 0		ELEVATION GROUND WATER: See Note 2	
NAME OF DRILLER: Boyd Lane		ELEVATION TOP OF HOLE: 562.37		DATE MOLE: 1-23-73	
TRINITY ENGINEERING TESTING CORPORATION		TOTAL CORE RECOVERY FOR BORING: See Note 1		SIGNATURE OF INSPECTOR: See Note 1 under "Remarks"	
THICKNESS OF OVERBURDEN: 12.5'		DEPTH DRILLED INTO ROCK: 4.5'		TOTAL DEPTH OF HOLE: 17.0'	

ELEVATION	DEPTH	LEGEND	CLASSIFICATION OF MATERIALS (Description)	SCORE RECOVERY (%)	BOX OR SAMPLE NO.	REMARKS (Drilling time, water level, depth of measuring, etc., if significant)
	2		Brown Sandy Clay w/Gravel		W1	Used 3" Shelby tube for all samples.
	4				W2	
	6		7.0'		J1	
555.37	8		Brown and Light Gray Sandy Clay w/Scattered Gravel and Calcareous Particles		W3	
	10				W4	
	12		12.5'		J2	
549.87	14		Light Gray and Yellow Weathered Shale w/Silt Layers		W5	
	16		16.0'		W6	
546.37	17.0'		Gray Shale w/Sandstone Lenses		W7	
545.37	17.0'		Total Depth = 17.0 Feet		W8	
					J4	
					W9	
					B1	

PROJECT: **Aubrey Dam Site No. 1** HOLE NO.: **35-53**

ENG FORM 1836 PREVIOUS EDITIONS ARE OBSOLETE
MAR 71 (MODIFIED) (TRANSLUCENT)

PROJECT: **Aubrey Dam Site No. 1** HOLE NO.: **35-52**

ENG FORM 1836 PREVIOUS EDITIONS ARE OBSOLETE
MAR 71 (MODIFIED) (TRANSLUCENT)

PROJECT: **Aubrey Dam Site No. 1** HOLE NO.: **35-53**

Note 1:
Soils logged by:
A. J. Simpson,
Trinity Engineering
Testing Corporation.

Note 2:
Groundwater was
encountered at 12.5'.

Note 1:
Soils logged by:
A. J. Simpson,
Trinity Engineering
Testing Corporation.

Note 2:
Boring was advanced
to 17.0 feet depth with
out using drilling fluid -
and groundwater was not
encountered same net
depth.

Notes No. 35-54

PROJECT: Aubrey Dam Site No. 1

LOCATION: X = 2,139,350; Y = 612,635

DATE: 1-23-73

DEPTH: 562.37

INSPECTOR: A. J. Simpson

REMARKS: Under "Remarks"

WRAP SAMPLES

- 0.0' - 1.0'
- 1.0' - 2.0'
- 3.0' - 4.0'
- 4.5' - 6.0'
- 7.0' - 8.5'
- 8.5' - 10.0'
- 11.0' - 12.0'
- 12.5' - 14.0'
- 15.0' - 16.5'

JAR SAMPLES


- 2.0' - 3.0'
- 6.0' - 7.0'
- 10.0' - 11.0'
- 14.0' - 15.0'

BAG SAMPLE


- 16.5' - 17.0'

Note 1: Soils logged by A. J. Simpson, Trinity Engineering Testing Corporation.

Note 2: Boring was advanced to 20.0 feet depth without using drilling fluid and groundwater was encountered near that depth.

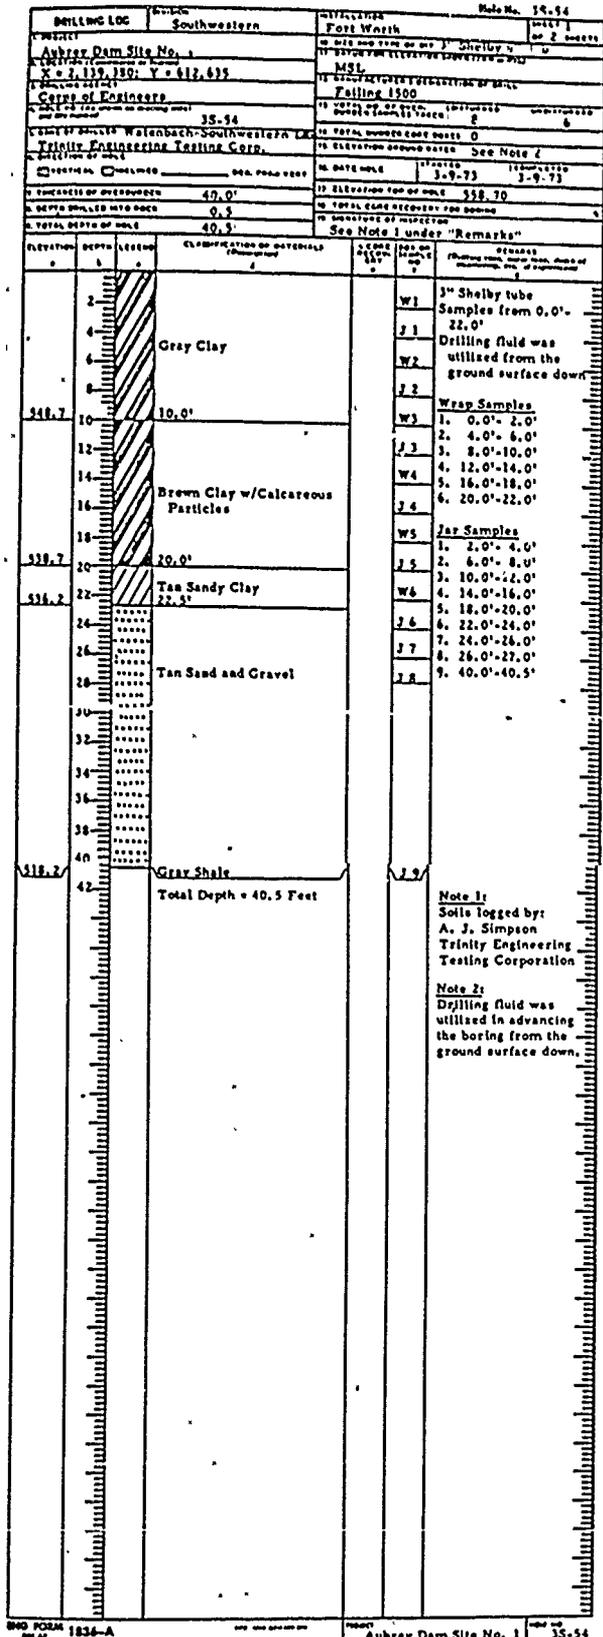

DRILLING LOG 1834-A (MODIFIED) Aubrey Dam Site No. 1 35-54

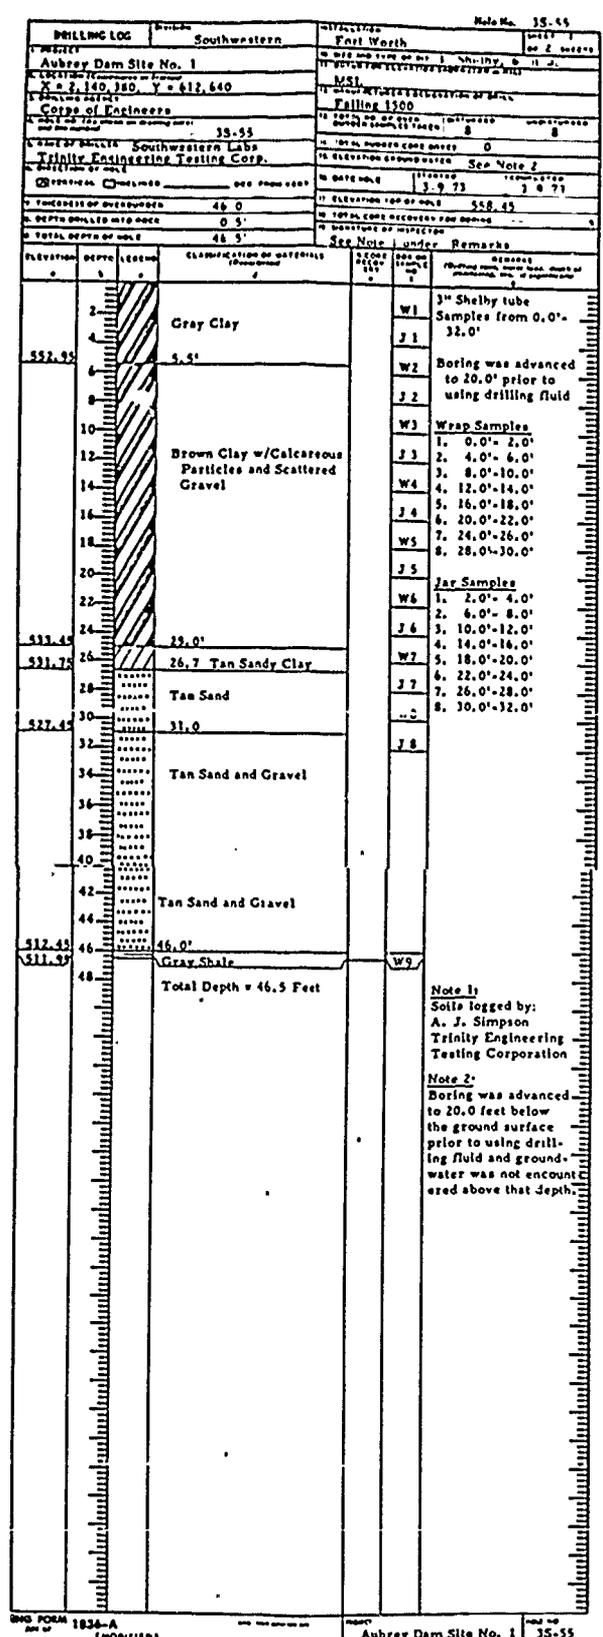

DRILLING LOG 1834-A (MODIFIED) Aubrey Dam Site No. 1 35-55

PROJECT: Aubrey Dam Site No. 1

LOCATION: X = 2,140,350; Y = 612,640

DATE: 1-23-73

DEPTH: 558.42

INSPECTOR: A. J. Simpson

REMARKS: Under "Remarks"

WRAP SAMPLES

- 0.0' - 2.0'
- 4.0' - 6.0'
- 8.0' - 10.0'
- 12.0' - 14.0'
- 16.0' - 18.0'
- 20.0' - 22.0'
- 24.0' - 26.0'
- 28.0' - 30.0'

JAR SAMPLES

- 2.0' - 4.0'
- 6.0' - 8.0'
- 10.0' - 12.0'
- 14.0' - 16.0'
- 18.0' - 20.0'
- 22.0' - 24.0'
- 26.0' - 28.0'
- 30.0' - 32.0'

Note 1: Soils logged by A. J. Simpson, Trinity Engineering Testing Corporation.

Note 2: Boring was advanced to 20.0 feet below the ground surface prior to using drilling fluid and groundwater was not encountered above that depth.

DRILLING LOG 1834-A (MODIFIED) Aubrey Dam Site No. 1 35-55

Map No. 35-54	
Sheet 1	Sheet 2
PROJECT: Aubrey Dam Site No. 1	
X = 2,140,380; Y = 612,640	
Falling 1900	
Corps of Engineers	
35-55	
Southwestern Labs	
Trinity Engineering Testing Corp.	
Elevation of ground surface 552.70	
Elevation of water table 550.45	
Total depth of hole 46.5'	
See Note 1 under "Remarks"	
DEPTH	REMARKS
W1	3" Shelby tube
J1	Samples from 0.0'-32.0'
W2	Drilling fluid was utilized from the ground surface down
J2	Wrap Samples
W3	1. 0.0'-2.0'
J3	2. 4.0'-6.0'
W4	3. 8.0'-10.0'
J4	4. 12.0'-14.0'
W5	5. 16.0'-18.0'
J5	6. 20.0'-22.0'
W6	Jar Samples
J6	1. 2.0'-4.0'
W7	2. 4.0'-8.0'
J7	3. 10.0'-12.0'
W8	4. 14.0'-16.0'
J8	5. 18.0'-20.0'
W9	6. 22.0'-24.0'
J9	7. 24.0'-26.0'
W10	8. 26.0'-28.0'
J10	9. 40.0'-40.5'
Note 1: Soils logged by: A. J. Simpson, Trinity Engineering Testing Corporation	
Note 2: Drilling fluid was utilized in advancing the boring from the ground surface down.	

Map No. 35-55				
Sheet 1	Sheet 2			
PROJECT: Aubrey Dam Site No. 1				
X = 2,140,380; Y = 612,640				
Falling 1900				
Corps of Engineers				
35-55				
Southwestern Labs				
Trinity Engineering Testing Corp.				
Elevation of ground surface 552.70				
Elevation of water table 550.45				
Total depth of hole 46.5'				
See Note 1 under "Remarks"				
ELEVATION	DEPTH	LEGEND	CLASSIFICATION OF MATERIALS	REMARKS
552.95	2		Gray Clay	3" Shelby tube
	4			Samples from 0.0'-32.0'
	6			Boring was advanced to 20.0' prior to using drilling fluid
	8			Wrap Samples
	10			1. 0.0'-2.0'
	12		Brown Clay w/Calcareous Particles and Scattered Gravel	2. 4.0'-6.0'
	14			3. 8.0'-10.0'
	16			4. 12.0'-14.0'
	18			5. 16.0'-18.0'
	20			6. 20.0'-22.0'
	22			7. 24.0'-26.0'
	24			8. 28.0'-30.0'
551.45	26		25.0'	Jar Samples
551.75	26		26.7'	1. 2.0'-4.0'
	28		Tan Sand	2. 4.0'-8.0'
552.45	30		31.0'	3. 10.0'-12.0'
	32		Tan Sand and Gravel	4. 14.0'-16.0'
	34			5. 18.0'-20.0'
	36			6. 22.0'-24.0'
	38			7. 26.0'-28.0'
	40			8. 30.0'-32.0'
	42		Tan Sand and Gravel	
	44			
552.45	46		46.0'	Total Depth = 46.5 Feet
551.95	48		Gray Shale	
Note 1: Soils logged by: A. J. Simpson, Trinity Engineering Testing Corporation				
Note 2: Boring was advanced to 20.0 feet below the ground surface prior to using drilling fluid and ground-water was not encountered above that depth.				

Map No. 35-54				
Sheet 1	Sheet 2			
PROJECT: Aubrey Dam Site No. 1				
X = 2,141,190; Y = 612,640				
Falling 1900				
Corps of Engineers				
35-55				
Southwestern Labs				
Trinity Engineering Testing Corp.				
Elevation of ground surface 552.70				
Elevation of water table 550.45				
Total depth of hole 43.0'				
See Note 1 under "Remarks"				
ELEVATION	DEPTH	LEGEND	CLASSIFICATION OF MATERIALS	REMARKS
550.7	2		Gray Clay	3" Shelby tube
	4			Samples from 0.0'-30.0'
	6			Drilled out and took Shelby tube samples 10.0'-43.0'
	8			Wrap Samples
	10			1. 0.0'-2.0'
	12		Brown Clay w/Calcareous Particles	2. 4.0'-6.0'
	14			3. 8.0'-10.0'
	16			4. 10.0'-12.0'
	18			5. 12.0'-14.0'
	20			6. 14.0'-16.0'
	22			7. 16.0'-18.0'
	24			8. 18.0'-20.0'
	26			9. 20.0'-22.0'
	28			10. 22.0'-24.0'
550.2	26		26.5'	11. 26.0'-28.0'
527.7	28		Tan Clayey Sand	12. 28.0'-30.0'
	30		29.0'	Jar Samples
	32		Tan Silty Sand	1. 2.0'-4.0'
	34			2. 4.0'-8.0'
	36			3. 8.0'-10.0'
	38			4. 12.0'-14.0'
	40			5. 16.0'-18.0'
	42			6. 20.0'-22.0'
	44			7. 24.0'-26.0'
	46			8. 28.0'-30.0'
	48			9. 34.0'-36.0'
	50			10. 38.0'-39.0'
	52			11. 41.0'-43.0'
Note 1: Soils logged by: A. J. Simpson, Trinity Engineering Testing Corporation				
Note 2: Boring was advanced to 30.0 feet below the ground surface prior to using drilling fluid and ground-water was not encountered above that depth.				

RECORD DRAWING-WORK AS BUILT

REV	NO	ACTION	DATE	DESCRIPTION OF REVISION
U.S. ARMY ENGINEER DISTRICT, FORT WORTH CORPS OF ENGINEERS FORT WORTH, TEXAS				
DESIGNED BY:	RAY ROBERTS LAKE			
DRAWN BY:	ELM FORK, TRINITY RIVER, TEXAS			
REVIEWED BY:	EMBANKMENT, SPILLWAY AND			
	OUTLET WORKS			
	LOGS OF BORINGS			
	3S-52, 3S-53, 3S-54, 3S-55 AND 3S-56			
SUBMITTED BY:	INVITATION NO. DACW63-82B-0023	DATE:	MAR, 1982	
ENGINEER:	CONTRACT NO. DACW63-82-C-0073	SHEET NO.	23	
	DRAWING NUMBER	OF		

TO ACCOMPANY FOUNDATION REPORT

DRILLING LOG		Southwestern		Fort Worth	
Aubrey Dam Site No. 1					
X42, 130.371, Y 6112.723, Sta. 18423					
Falling 1500					
MSL					
Bill Stanton					
Trinity Engineering Testing Corporation					
3-13-73					
Elevation top of hole 534.5					
Elevation ground surface 534.5					
See Note 1 under Remarks					
Elevation	Depth	Lesson	Classification of Material	Notes	Remarks
549.5	2.0'	1	Gray Clay	W1	3" Shelby tube
	4.0'	2		W2	Samples from 0.0' - 22.0'
	6.0'	3		W3	Standard Penetration
	8.0'	4		W4	Values
	10.0'	5		W5	No. Blows
	12.0'	6		W6	Depth Per Foot
	14.0'	7		W7	22.0-23.5 33
	16.5'	8	Brown Clay w/Calcareous Particles	W8	Wrap Samples
	18.0'	9		W9	1. 0.0' - 2.0'
	20.0'	10		W10	2. 2.0' - 4.0'
	22.0'	11		W11	3. 4.0' - 6.0'
	24.0'	12		W12	4. 6.0' - 8.0'
	26.0'	13		W13	5. 8.0' - 10.0'
	28.0'	14		W14	6. 10.0' - 12.0'
	30.0'	15		W15	7. 12.0' - 14.0'
	32.0'	16		W16	8. 14.0' - 16.0'
	34.0'	17		W17	9. 16.0' - 18.0'
	36.0'	18		W18	10. 18.0' - 20.0'
	38.0'	19		W19	11. 20.0' - 22.0'
	40.0'	20		W20	Wrap Samples
	42.0'	21		W21	1. 0.0' - 2.0'
	44.0'	22		W22	2. 2.0' - 4.0'
	46.0'	23		W23	3. 4.0' - 6.0'
	48.0'	24		W24	4. 6.0' - 8.0'
	50.0'	25		W25	5. 8.0' - 10.0'
	52.0'	26		W26	6. 10.0' - 12.0'
	54.0'	27		W27	7. 12.0' - 14.0'
	56.0'	28		W28	8. 14.0' - 16.0'
	58.0'	29		W29	9. 16.0' - 18.0'
	60.0'	30		W30	10. 18.0' - 20.0'
	62.0'	31		W31	11. 20.0' - 22.0'
	64.0'	32		W32	Wrap Samples
	66.0'	33		W33	1. 0.0' - 2.0'
	68.0'	34		W34	2. 2.0' - 4.0'
	70.0'	35		W35	3. 4.0' - 6.0'
	72.0'	36		W36	4. 6.0' - 8.0'
	74.0'	37		W37	5. 8.0' - 10.0'
	76.0'	38		W38	6. 10.0' - 12.0'
	78.0'	39		W39	7. 12.0' - 14.0'
	80.0'	40		W40	8. 14.0' - 16.0'
	82.0'	41		W41	9. 16.0' - 18.0'
	84.0'	42		W42	10. 18.0' - 20.0'
	86.0'	43		W43	11. 20.0' - 22.0'
	88.0'	44		W44	Wrap Samples
	90.0'	45		W45	1. 0.0' - 2.0'
	92.0'	46		W46	2. 2.0' - 4.0'
	94.0'	47		W47	3. 4.0' - 6.0'
	96.0'	48		W48	4. 6.0' - 8.0'
	98.0'	49		W49	5. 8.0' - 10.0'
	100.0'	50		W50	6. 10.0' - 12.0'
	102.0'	51		W51	7. 12.0' - 14.0'
	104.0'	52		W52	8. 14.0' - 16.0'
	106.0'	53		W53	9. 16.0' - 18.0'
	108.0'	54		W54	10. 18.0' - 20.0'
	110.0'	55		W55	11. 20.0' - 22.0'
	112.0'	56		W56	Wrap Samples
	114.0'	57		W57	1. 0.0' - 2.0'
	116.0'	58		W58	2. 2.0' - 4.0'
	118.0'	59		W59	3. 4.0' - 6.0'
	120.0'	60		W60	4. 6.0' - 8.0'
	122.0'	61		W61	5. 8.0' - 10.0'
	124.0'	62		W62	6. 10.0' - 12.0'
	126.0'	63		W63	7. 12.0' - 14.0'
	128.0'	64		W64	8. 14.0' - 16.0'
	130.0'	65		W65	9. 16.0' - 18.0'
	132.0'	66		W66	10. 18.0' - 20.0'
	134.0'	67		W67	11. 20.0' - 22.0'
	136.0'	68		W68	Wrap Samples
	138.0'	69		W69	1. 0.0' - 2.0'
	140.0'	70		W70	2. 2.0' - 4.0'
	142.0'	71		W71	3. 4.0' - 6.0'
	144.0'	72		W72	4. 6.0' - 8.0'
	146.0'	73		W73	5. 8.0' - 10.0'
	148.0'	74		W74	6. 10.0' - 12.0'
	150.0'	75		W75	7. 12.0' - 14.0'
	152.0'	76		W76	8. 14.0' - 16.0'
	154.0'	77		W77	9. 16.0' - 18.0'
	156.0'	78		W78	10. 18.0' - 20.0'
	158.0'	79		W79	11. 20.0' - 22.0'
	160.0'	80		W80	Wrap Samples
	162.0'	81		W81	1. 0.0' - 2.0'
	164.0'	82		W82	2. 2.0' - 4.0'
	166.0'	83		W83	3. 4.0' - 6.0'
	168.0'	84		W84	4. 6.0' - 8.0'
	170.0'	85		W85	5. 8.0' - 10.0'
	172.0'	86		W86	6. 10.0' - 12.0'
	174.0'	87		W87	7. 12.0' - 14.0'
	176.0'	88		W88	8. 14.0' - 16.0'
	178.0'	89		W89	9. 16.0' - 18.0'
	180.0'	90		W90	10. 18.0' - 20.0'
	182.0'	91		W91	11. 20.0' - 22.0'
	184.0'	92		W92	Wrap Samples
	186.0'	93		W93	1. 0.0' - 2.0'
	188.0'	94		W94	2. 2.0' - 4.0'
	190.0'	95		W95	3. 4.0' - 6.0'
	192.0'	96		W96	4. 6.0' - 8.0'
	194.0'	97		W97	5. 8.0' - 10.0'
	196.0'	98		W98	6. 10.0' - 12.0'
	198.0'	99		W99	7. 12.0' - 14.0'
	200.0'	100		W100	8. 14.0' - 16.0'
	202.0'	101		W101	9. 16.0' - 18.0'
	204.0'	102		W102	10. 18.0' - 20.0'
	206.0'	103		W103	11. 20.0' - 22.0'
	208.0'	104		W104	Wrap Samples
	210.0'	105		W105	1. 0.0' - 2.0'
	212.0'	106		W106	2. 2.0' - 4.0'
	214.0'	107		W107	3. 4.0' - 6.0'
	216.0'	108		W108	4. 6.0' - 8.0'
	218.0'	109		W109	5. 8.0' - 10.0'
	220.0'	110		W110	6. 10.0' - 12.0'
	222.0'	111		W111	7. 12.0' - 14.0'
	224.0'	112		W112	8. 14.0' - 16.0'
	226.0'	113		W113	9. 16.0' - 18.0'
	228.0'	114		W114	10. 18.0' - 20.0'
	230.0'	115		W115	11. 20.0' - 22.0'
	232.0'	116		W116	Wrap Samples
	234.0'	117		W117	1. 0.0' - 2.0'
	236.0'	118		W118	2. 2.0' - 4.0'
	238.0'	119		W119	3. 4.0' - 6.0'
	240.0'	120		W120	4. 6.0' - 8.0'
	242.0'	121		W121	5. 8.0' - 10.0'
	244.0'	122		W122	6. 10.0' - 12.0'
	246.0'	123		W123	7. 12.0' - 14.0'
	248.0'	124		W124	8. 14.0' - 16.0'
	250.0'	125		W125	9. 16.0' - 18.0'
	252.0'	126		W126	10. 18.0' - 20.0'
	254.0'	127		W127	11. 20.0' - 22.0'
	256.0'	128		W128	Wrap Samples
	258.0'	129		W129	1. 0.0' - 2.0'
	260.0'	130		W130	2. 2.0' - 4.0'
	262.0'	131		W131	3. 4.0' - 6.0'
	264.0'	132		W132	4. 6.0' - 8.0'
	266.0'	133		W133	5. 8.0' - 10.0'
	268.0'	134		W134	6. 10.0' - 12.0'
	270.0'	135		W135	7. 12.0' - 14.0'
	272.0'	136		W136	8. 14.0' - 16.0'
	274.0'	137		W137	9. 16.0' - 18.0'
	276.0'	138		W138	10. 18.0' - 20.0'
	278.0'	139		W139	11. 20.0' - 22.0'
	280.0'	140		W140	Wrap Samples
	282.0'	141		W141	1. 0.0' - 2.0'
	284.0'	142		W142	2. 2.0' - 4.0'
	286.0'	143		W143	3. 4.0' - 6.0'
	288.0'	144		W144	4. 6.0' - 8.0'
	290.0'	145		W145	5. 8.0' - 10.0'
	292.0'	146		W146	6. 10.0' - 12.0'
	294.0'	147		W147	7. 12.0' - 14.0'
	296.0'	148		W148	8. 14.0' - 16.0'
	298.0'	149		W149	9. 16.0' - 18.0'
	300.0'	150		W150	10. 18.0' - 20.0'
	302.0'	151		W151	11. 20.0' - 22.0'
	304.0'	152		W152	Wrap Samples
	306.0'	153		W153	1. 0.0' - 2.0'
	308.0'	154		W154	2. 2.0' - 4.0'
	310.0'	155		W155	3. 4.0' - 6.0'
	312.0'	156		W156	4. 6.0' - 8.0'
	314.0'	157		W157	5. 8.0' - 10.0'
	316.0'	158		W158	6. 10.0' - 12.0'
	318.0'	159		W159	7. 12.0' - 14.0'
	320.0'	160		W160	8. 14.0' - 16.0'
	322.0'	161		W161	9. 16.0' - 18.0'
	324.0'	162		W162	10. 18.0' - 20.0'
	326.0'	163		W163	11. 20.0' - 22.0'
	328.0'	164		W164	Wrap Samples
	330.0'	165		W165	1. 0.0' - 2.0'
	332.0'	166		W166	2. 2.0' - 4.0'
	334.0'	167		W167	3. 4.0' - 6.0'
	336.0'	168		W168	4. 6.0' - 8.0'
	338.0'	169		W169	5. 8.0' - 10.0'
	340.0'	170		W170	6. 10.0' - 12.0'
	342.0'	171		W171	7. 12.0' - 14.0'
	344.0'	172		W172	8. 14.0' - 16.0'
	346.0'	173		W173	9. 16.0' - 18.0'
	348.0'	174		W174	10. 18.0' - 20.0'
	350.0'	175		W175	11. 20.0' - 22.0'
	352.0'	176		W176	Wrap Samples
	354.0'	177		W177	1. 0.0' - 2.0'
	356.0'	178		W178	2. 2.0' - 4.0'
	358.0'	179		W179	3. 4.0' - 6.0'
	360.0'	180		W180	4. 6.0' - 8.0'
	362.0'	181		W181	5. 8.0' - 10.0'
	364.0'	182		W182	6. 10.0' - 12.0'
	366.0'	183		W183	7. 12.0' - 14.0'
	368.0'	184		W184	8. 14.0' - 16.0'
	370.0'	185		W185	9. 16.0' - 18.0'
	372.0'	186		W186	10. 18.0' - 20.0'
	374.0'	187		W187	11. 20.0' - 22.0'
	376.0'</				

Well Worth		Notes	
1	2	3	4
100	W1	3" Shelby tube samples 0.0'-21.0'	
100	W2	JAR SAMPLES	
100	W3	1. 2.0'-3.0'	
100	W4	2. 6.0'-7.0'	
100	W5	3. 10.0'-11.0'	
100	W6	4. 14.0'-15.0'	
100	W7	5. 18.0'-19.0'	
100	W8	BAG SAMPLES	
100	W9	1. 4.0'-5.0'	
100	W10	2. 8.0'-9.0'	
100	W11	3. 16.0'-17.0'	
100	W12	WRAP SAMPLES	
100	W13	1. 0.0'-1.0'	
100	W14	2. 1.0'-2.0'	
100	W15	3. 3.0'-4.0'	
100	W16	4. 5.0'-6.0'	
100	W17	5. 7.0'-8.0'	
100	W18	6. 9.0'-10.0'	
100	W19	7. 11.0'-12.0'	
100	W20	8. 12.0'-13.0'	
100	W21	9. 13.0'-14.0'	
100	W22	10. 15.0'-16.0'	
100	W23	11. 17.0'-18.0'	
100	W24	12. 19.0'-20.0'	
100	W25	13. 20.0'-21.0'	
R-1	Box 1	Cleaned out hole at 21.0' and set casing to 21.0'.	
R-2	Box 2	Started coring with 4" core barrel at 21.0'.	
R-3	Box 3		
R-4	Box 4		
R-5	Box 5		
R-297	Box 297		
R-298			

File No 354C-62

DRILLING LOC. AUBREY DAM SITE # 1	DIVISION SOUTHWESTERN	INSTALLATION FT. WORTH DIST.	SHEET OF 3 SHEETS
PROJECT AUBREY DAM SITE # 1	DATE 11-19-62	NO. AND TYPE OF BIT 2" CORE	NO. AND TYPE OF CORE NX CORE
LOCATION (Name of State) TX	COUNTY TARRANT	MANUFACTURER'S DESIGNATION OF DRILL M.S.L.	
DRIILLING AGENCY USCE		MANUFACTURER'S DESIGNATION OF DRILL DAMCO 1250	
WELL NO. (As shown on existing maps and site plan) 354C-62		TOTAL NO. OF OVER BURDEN SAMPLES TAKEN 15	
NAME OF DRILLER TRINITY ENGE TESTING CORP.		ELEVATION GROUND WATER	
DIRECTION OF HOLE <input checked="" type="checkbox"/> VERTICAL <input type="checkbox"/> INCLINED	REQ. FROM VERT.	DATE HOLE STARTED 11/21/62	DATE HOLE COMPLETED 11/23/62
THICKNESS OF OVERBURDEN 0		ELEVATION TOP OF HOLE 652.0	DEPTH TO TOP OF HOLE 652.35
DEPTH DRILLED INTO ROCK 120.0		TOTAL CORE RECOVERY FOR BORING 95%	
TOTAL DEPTH OF HOLE 120.0		SIGNATURE OF INSPECTOR Van Man	

ELEVATION	DEPTH	LEGEND	CLASSIFICATION OF MATERIALS (Description)	NO. OF CORE RECOVERY	REMARKS (During run, notes on loss, depth of weathering, etc., if significant)
	0.0 - 35.5'		SAND & SANDSTONE POORLY CEMENTED BUT TIGHT, MED-COARSE GRN, RED, TAN, AND GRAY, SCATT GRAVELS		DRILLING 3" SHELBY TUBE 0.0 - 3.0' FISH-TAIL BIT 3.0 - 16.0' NX-CORE BBL 16.0 - 19.0 (no recn) 2 1/2" ROCK BIT 19.0 - 24.0' 6" ROCK-BIT 24.0 - 30.0' 4" CORE-BBL 30.0 - 35.5' (no recn) 4" CORE-BBL 35.5 - 108' NX CORE BBL 108 - 120'
	35.5 - 50.0'		SAND & SANDSTONE MED.-COARSE GRN, SOFT, V. POORLY CEMENTED, GRAVELLY, TAN & GRAY		SAMPLES JAR 1: 2.0-2.5' 2: 3.0-3.5' 3: 10.0-11.0' 4: 29.0-30.0' 5: 35.5-36.0'
	50.0 - 51.5'		SAND & GRAVEL 3" FINE TAN, MED-COARSE GRN SAND, LOOSELY CONS, TAN & COOL		SAMPLES (cont) CARTON 1: 46.5-47.5' 2: 52.5-53.5' 3: 57.4-58.2' 4: 62.8-63.7' 5: 67.3-69.2' 6: 72.3-73.2' 7: 78.3-79.2' 8: 81.9-82.8' 9: 88.7-89.6' 10: 93.1-95.0' 11: 96.5-97.4' 12: 112.4-113.5' 13: 116.1-117.1'
	51.5 - 57.5'		SANDSTONE, HARD, WEATH, CRUMBLY, SOFT-MED HARD TAN & BROWN		
	57.5 - 58.0'		SHALE, HARD, SIL. SANDY, DK. GRAY		
	58.0 - 57.5'		SANDSTONE, GRAY, MOD. HARD, FINE-MED. GRN.		
	57.5 - 57.5'		SILTSTONE, HARD, TAN		
	57.5 - 81.0'		SANDSTONE, SHALY, LIGHTING, GRAY TO DK. GRAY, SOFT-MOD. HARD, MASSIVE, FINE-MED. GRN, OCCAS SILTSTONE NOS.		WATER LEVEL AFTER 36 HOURS WAS 65.6' NOTE: HOLE WAS PRESSURE TESTED

ELEVATION	DEPTH	LEGEND	CLASSIFICATION OF MATERIALS (Description)	NO. OF CORE RECOVERY	NO. OF SAMPLE NO.	REMARKS (During run, notes on loss, depth of weathering, etc., if significant)
	0.0 - 81.0'					
	81.0 - 91.5'		LIMESTONE, HARD, GRAY			
	91.5 - 106.0'		SHALE, MOD HARD, CALC, MASSIVE, GRAY			
	106.0 - 110.0'					
	110.0 - 120.0'		SHALE, MOD HARD, DARK GRAY TO BLACK, MASSIVE, SCAT FOSS. ZONES			
	120.0 - 120.0'		VERY FOSSILIFEROUS			

ENG FORM 1836 MAR 71 PREVIOUS EDITIONS ARE OBSOLETE.

PROJECT AUBREY DAM SITE # 1

CLASSIFICATION OF MATERIALS (Overburden)	1 CORE RECOVERY LAY	2 CORE SAMPLE NO.	REMARKS (Depth, core, water loss, depth of weathering, etc., if significant)
91.0-91.5 Limestonic nodules HARD, GRAY			
91.5-106.0 SHALE, MOD. HARD, CALD, MASSIVE, GRAY			
106.0-111.0 LIMESTONE, HARD, MASSIVE TO NODULAR, FOSSILIFEROUS, GRAY			
111.0-120.0 SHALE, MOD. HARD, DARK GRAY TO BLACK, MASSIVE, SCAT. FOSS. ZONES			
119.5-120.0 VERY FOSSILIFEROUS			
NOTES ARE OBSOLETE.			
PROJECT AUBREY DAM SITE #1		HOLE NO. 354C-62	

Hole No. 816D-64

DRILLING LOG		DIVISION		INSTALLATION		SHEET 1 OF 2 SHEETS	
PROJECT Aubrey Dam Site		Southwestern		Fort Worth			
LOCATION (Coordinates of Bureau)		10 SITE AND TYPE OF BIT 8" Siger, 6" d, 3" fishtail		11 MANUFACTURER'S DESIGNATION OF DRILL Falling 1500			
DRILLING AGENCY Corps of Engineers		HOLE NO. (As shown on drawing title) 816D-64		13 TOTAL NO. OF OVER BURDEN SAMPLES TAKEN 5		14 TOTAL NUMBER CORE BORES --	
NAME OF DRILLER Newhouse		DIRECTION OF HOLE <input checked="" type="checkbox"/> VERTICAL <input type="checkbox"/> INCLINED DEG. FROM VERT.		15 ELEVATION GROUND WATER		16 DATE HOLE STARTED 9 April 73 COMPLETED 11 April 73	
THICKNESS OF OVERBURDEN 44.0		DEPTH DRILLED INTO ROCK 57.0		17 ELEVATION TOP OF HOLE		18 TOTAL CORE RECOVERY FOR SPRING	
TOTAL DEPTH OF HOLE 101.0		SIGNATURE OF INSPECTOR		19		20	
ELEVATION	DEPTH	LEGEND	CLASSIFICATION OF MATERIALS (Description)	1 CORE RECOVERY	2 CORE SAMPLE NO.	REMARKS (Drifting, core, water loss, depth of weathering, etc., if significant)	
			0.0' to 24.0' CLAY - - - - - 0.0 to 4.0 - calc., moist, stiff, brown. 4.0 to 14.0 - calc., sandy, moist, stiff, brown. 14.0 to 19.0 - calc., scattered gravel, moist, stiff, brown. 19.0 to 24.0 - calc., moist, stiff, gray and tan.			1. Water level not determined. 2. Jars: A. 26.0 B. 28.0 C. 36.0 D. 38.0 E. 38.6 NOTE: All jar samples taken from shoe and catcher of denison sampler. 3. Denison cans: 1. 24.0 to 26.0 2. 34.0 to 36.0 3. 36.0 to 38.0 4. Hole squeezing badly at 27.0'. 4" plastic pipe set to 45.0'. Another offset from 6DC-30, Hole 816D-64A, will be drilled to obtain denison samples from 26.0 to 34.0. Offset bearings and elevations will be furnished after completion.	
			-- Start 6" d, bb'1 at 24.0' -- -- -- 24.0' to 26.0' CLAY, calc., moist, stiff, gray and tan.			5. Drilling: 0.0' to 24.0' - 8" siger - no sample taken. 24.0' to 38.6' - 6" d, bb'1. 38.6' to 101.0' - 3" fishtail.	
			26.0' to 34.0' NO RECOVERY -			6. Identification of materials from 38.6' to 101' based on cuttings and drill action.	
			34.0' to 37.3' CLAY, sandy, moist, med. stiff, gray and tan.		Can 1		
			37.3' to 38.6' SAND, gravelly, clayey, saturated, med. dense, tan. -- Refusal w/d, bb'1, at 38.6' -- Start 3" fish- tail at 38.6' -- -- --		Can 2 Can 3		
			38.6' to 44.0' SAND and GRAVEL, med. dense. -- Drilled into primary material at 44.0' -- -- --				
			44.0' to 101.0' SHALE, soft to m. hard w/LIMESTONE from 86.5' to 89.6'.			7. 2" log from 45' to 101'	
			T.D. - 101.0'		101.0 101.0		

DRILLING LOG	
PROJECT Aubrey Dam Site	
LOCATION (Coordinates of Bureau)	
DRILLING AGENCY Corps of Eng	
HOLE NO. (As shown on drawing title)	
NAME OF DRILLER Newhouse	
DIRECTION OF HOLE <input checked="" type="checkbox"/> VERTICAL <input type="checkbox"/> INCLIN	
THICKNESS OF OVERBURDEN	
DEPTH DRILLED INTO ROCK	
TOTAL DEPTH OF HOLE	
ELEVATION	DEPTH LEGEN

Hole No. 8A6D-64

Division Southwestern	INSTALLATION Fort Worth	SHEET 1 of 2 SHEETS
1. PROJECT Aubrey Dam Site	10. SIZE AND TYPE OF BIT 8" auger, 6" d. bb'l.	11. DATE FOR ELEVATION TO BE TAKEN fish-tail
2. DRILLING AGENCY Corps of Engineers	12. MANUFACTURER'S DESIGNATION OF DRILL Falling 1500	13. TOTAL NO. OF OVER-BURDEN SAMPLES TAKEN 5
3. HOLE NO. (As shown on drawing title and file number) 8A6D-64	14. TOTAL NUMBER CORE BORES --	15. ELEVATION GROUND WATER --
4. NAME OF DRILLER Fehouse	16. DATE MOLE 9 April 73	17. SIGNATURE OF INSPECTOR <i>James A. Christie</i>
5. DIRECTION OF MOLE <input checked="" type="checkbox"/> Vertical <input type="checkbox"/> Inclined	18. ELEVATION TOP OF MOLE 44.0	19. SIGNATURE OF INSPECTOR <i>James A. Christie</i>
6. THICKNESS OF OVERBURDEN --	19. TOTAL CORE RECOVERY FOR BORING 57.0	20. SIGNATURE OF INSPECTOR <i>James A. Christie</i>
7. DEPTH DRILLED INTO ROCK --	20. TOTAL CORE RECOVERY FOR BORING 101.0	
8. TOTAL DEPTH OF MOLE 36.0		

ELEVATION	DEPTH	LEGEND	CLASSIFICATION OF MATERIALS (Description)	NO. CORE RECOVERY (%)	BOX OR SAMPLE NO.	REMARKS (Omitting time, water level, depth of overburden, etc., if significant)
0.0' to 24.0'			CLAY - 0.0 to 4.0 - calc., moist, stiff, brown. 4.0 to 14.0 - calc., sandy, moist, stiff, brown. 14.0 to 19.0 - calc., scattered gravel, moist, stiff, brown. 19.0 to 24.0 - calc., moist, stiff, gray and tan. -- Start 6" d. bb'l at 24.0'			1. Water level not determined. 2. Jars: A. 26.0 B. 28.0 C. 36.0 D. 38.0 E. 38.6 NOTE: All jar samples taken from shoe and catcher of denison sampler. 3. Denison cans: 1. 24.0 to 26.0 2. 34.0 to 36.0 3. 36.0 to 38.0 4. Hole squeezing badly at 27.0'. 4" plastic pipe set to 45.0'. Another offset from 6D-30. Hole 8A6D-64A, will be drilled to obtain denison samples from 26.0 to 34.0. Offset bearings and elevations will be furnished after completion.
24.0' to 26.0'			CLAY, calc., moist, stiff, gray and tan.			5. Drilling: 0.0' to 24.0' - 8" auger - no sample taken. 24.0' to 38.6' - 6" d. bb'l. 38.6' to 101.0' - fish-tail.
26.0' to 34.0'			NO RECOVERY -			6. Identification of materials from 38.6' to 101' based on cuttings and drill action.
34.0' to 37.3'			CLAY, sandy, moist, med. stiff, gray and tan.			7. 7" log from 45' to 101'
37.3' to 38.6'		Can 1	SAND, gravelly, clayey, saturated, med. dense, tan. -- Refusal w/d. bb'l. at 38.6' - Start 3" fish-tail at 38.6'		Can 1	
38.6' to 44.0'		Can 2	SAND and GRAVEL, med. dense. -- Drilled into primary material at 44.0'		Can 2	
44.0' to 101.0'		Can 3	SHALE, soft to m. hard w/LIMESTONE from 86.5' to 89.6'		Can 3	
T.D. - 101.0'				101.0	101.0	

Hole No. 8A6D-64A

Division Southwestern	INSTALLATION Fort Worth	SHEET 1 of 1 SHEETS
1. PROJECT Aubrey Dam Site	10. SIZE AND TYPE OF BIT 8" auger, 6" d. bb'l.	11. DATE FOR ELEVATION TO BE TAKEN fish-tail
2. DRILLING AGENCY Corps of Engineers	12. MANUFACTURER'S DESIGNATION OF DRILL Falling 1500	13. TOTAL NO. OF OVER-BURDEN SAMPLES TAKEN 6
3. HOLE NO. (As shown on drawing title and file number) 8A6D-64A	14. TOTAL NUMBER CORE BORES --	15. ELEVATION GROUND WATER --
4. NAME OF DRILLER Fehouse	16. DATE MOLE 11 Apr 73	17. SIGNATURE OF INSPECTOR <i>James A. Christie</i>
5. DIRECTION OF MOLE <input checked="" type="checkbox"/> Vertical <input type="checkbox"/> Inclined	18. ELEVATION TOP OF MOLE 44.0	19. SIGNATURE OF INSPECTOR <i>James A. Christie</i>
6. THICKNESS OF OVERBURDEN --	19. TOTAL CORE RECOVERY FOR BORING --	20. SIGNATURE OF INSPECTOR <i>James A. Christie</i>
7. DEPTH DRILLED INTO ROCK --	20. TOTAL CORE RECOVERY FOR BORING --	
8. TOTAL DEPTH OF MOLE 36.0		

ELEVATION	DEPTH	LEGEND	CLASSIFICATION OF MATERIALS (Description)	NO. CORE RECOVERY (%)	BOX OR SAMPLE NO.	REMARKS (Omitting time, water level, depth of overburden, etc., if significant)
0.0' to 24.0'			CLAY, calc., moist, stiff, brown to gray and tan. -- Start 6" d. bb'l. at 24.0'			1. Water table not determined. 2. Jars: A. 26.0 B. 28.0 C. 30.0 D. 32.0 E. 34.0 F. 36.0 NOTE: Jar samples taken from shoe of denison bb'l.
24.0' to 34.0'			CLAY, calc., moist, med. stiff to stiff, sandy to 32.0' with sand increase at 32.0', tan and gray.			3. Denison Cans: 1. 24.0 to 26.0 2. 26.0 to 28.0 3. 28.0 to 30.0 4. 30.0 to 32.0 5. 32.0 to 34.0 6. 34.0 to 36.0
34.0' to 36.0'			SAND, sil. clayey, med. dense, saturated, medium to coarse grained, tan.			4. Drilling: 1. 0.0' to 24.0' - 8" auger 2. 24.0' to 36.0' - 6" d. bb'l.
T.D. - 36.0'					Can 1 Can 2 Can 3 Can 4 Can 5 Can 6	

ENG FORM 1836 PREVIOUS EDITIONS ARE OBSOLETE PROJECT Aubrey Dam Site 8A6D-64A

RECORD DRAWING-WORK AS BUILT

SYMBOL NO.	ACTION	DATE	DESCRIPTION OF REVISION
U.S. ARMY ENGINEER DISTRICT, FORT WORTH CORPS OF ENGINEERS FORT WORTH, TEXAS			
DESIGNED BY	RAY ROBERTS LAKE ELM FORK, TRINITY RIVER, TEXAS EMBANKMENT, SPILLWAY AND OUTLET WORKS LOGS OF BORINGS 3S4C-62, 3A6D-64, AND 8A6D-64A		
DRAWN BY			
REVIEWED BY			
SUBMITTED BY			
ENGINEER	INVITATION NO. DACW63-02-B-0025	DATE MAR. 1982	SEQUENCE NO. 25
	CONTRACT NO. DACW63-52-C-0093		
	DRAWING NUMBER	SHEET NO. OF	

TO ACCOMPANY FOUNDATION REPORT

UNIFORM NO. DACW63-52-C-0093

DRILLING LOG No. 46-155-tern 10-11-1973		INSTALLATION Fort Worth Dist 11 SIZE AND TYPE OF BIT 12 CATEGORY FOR ELEVATION (TOOTHEN = MSL)		SHEET 1 OF 3 SHEETS		
13 MANUFACTURER'S DESIGNATION OF DRILL Fallin-150		14 TOTAL NO. OF OVER-ROUNDER SAMPLES TAKEN 9		15 UNDISTURBED 8		
16 TOTAL NUMBER CORE BOXES 1		17 ELEVATION GROUND WATER (G.W.)		18 DATE MOLE 15 Apr 1973		
19 ELEVATION TOP OF HOLE 555.1		20 TOTAL CORE RECOVERY FOR BORING (2)		21 SIGNATURE OF SUPERVISOR [Signature]		
ELEVATION	DEPTH	LEGEND	CLASSIFICATION OF MATERIALS (Description)	NO. CORE RECOVERY	BOX OR SAMPLE NO.	REMARKS (Drilling time, water flow, depth of penetration, etc., if significant)
			0.0 - 17.0 CLAY 0.0 - 5.5 brown, med. moist, stiff 5.5 - 11.0 sandy, brown, moist, med stiff 11.0 - 15.0 brown, moist, stiff 15.0 - 17.0 sandy, brown, moist, stiff			Drilling 0.0 - 22.0 8" auger 22.0 - 40.0 6" d bbl 40.0 - 67.0 3" fishtail 67.0 - 97.5 2" corer
			17.0 - 26.2 SAND tan, med dense, sat'd, red to coarse gr, calc.			Jar samples A. 24.0 B. 26.0 C. 25.0 D. 30.0 E. 32.0 F. 33.8 G. 34.0 H. 36.0 I. 38.0
			26.2 - 31.0 CLAY moist, gray and tan, stiff to med stiff calc			Denison samples 1. 22.0 - 24.0 2. 24.0 - 25.0 3. 26.0 - 27.0 4. 28.0 - 30.0 5. 30.0 - 32.0 6. 32.0 - 34.0 7. 34.0 - 36.0 8. 36.0 - 38.0
			31.0 - 33.8 SAND tan, sat'd, med dense, red to coarse gr, calc			Water table 1. Apr, 73: adjacent hole, 65C-31 at 17.7'
			33.8 - 35.5 CLAY sandy, med stiff, gray, calc.			Note 8" casing to 6.5' Electric log
						D1 D2 D3 D4 D5 D6 D7 D8 no recovery

ELEVATION	DEPTH	LEGEND	CLASSIFICATION OF MATERIALS (Description)
555.1	0.0		15.5 - 30.2 SAND tan, sat'd, gravelly, med to coarse gr, med dense, calc
	19.2		19.2 - 17.0 SHALE dk, gray, med hard (rock classification unvet, non-jointed, sh, calc)
	15.2		15.2 - 55.0 significantly harder to fish tail.
	26.2		26.2 - 31.0 SAND tan, sat'd, med dense, red to coarse gr, calc
	31.0		31.0 - 33.8 SAND tan, sat'd, med dense, red to coarse gr, calc
	33.8		33.8 - 35.5 CLAY sandy, med stiff, gray, calc
	35.5		35.5 - 37.0 CLAY sandy, med stiff, gray, calc
	37.0		37.0 - 38.5 CLAY sandy, med stiff, gray, calc
	38.5		38.5 - 40.0 CLAY sandy, med stiff, gray, calc
	40.0		40.0 - 42.0 CLAY sandy, med stiff, gray, calc
	42.0		42.0 - 44.0 CLAY sandy, med stiff, gray, calc
	44.0		44.0 - 46.0 CLAY sandy, med stiff, gray, calc
	46.0		46.0 - 48.0 CLAY sandy, med stiff, gray, calc
	48.0		48.0 - 50.0 CLAY sandy, med stiff, gray, calc
	50.0		50.0 - 52.0 CLAY sandy, med stiff, gray, calc
	52.0		52.0 - 54.0 CLAY sandy, med stiff, gray, calc
	54.0		54.0 - 56.0 CLAY sandy, med stiff, gray, calc
	56.0		56.0 - 58.0 CLAY sandy, med stiff, gray, calc
	58.0		58.0 - 60.0 CLAY sandy, med stiff, gray, calc
	60.0		60.0 - 62.0 CLAY sandy, med stiff, gray, calc
	62.0		62.0 - 64.0 CLAY sandy, med stiff, gray, calc
	64.0		64.0 - 66.0 CLAY sandy, med stiff, gray, calc
	66.0		66.0 - 68.0 CLAY sandy, med stiff, gray, calc
	68.0		68.0 - 70.0 CLAY sandy, med stiff, gray, calc
	70.0		70.0 - 72.0 CLAY sandy, med stiff, gray, calc
	72.0		72.0 - 74.0 CLAY sandy, med stiff, gray, calc
	74.0		74.0 - 76.0 CLAY sandy, med stiff, gray, calc
	76.0		76.0 - 78.0 CLAY sandy, med stiff, gray, calc
	78.0		78.0 - 80.0 CLAY sandy, med stiff, gray, calc
	80.0		80.0 - 82.0 CLAY sandy, med stiff, gray, calc
	82.0		82.0 - 84.0 CLAY sandy, med stiff, gray, calc
	84.0		84.0 - 86.0 CLAY sandy, med stiff, gray, calc
	86.0		86.0 - 88.0 CLAY sandy, med stiff, gray, calc
	88.0		88.0 - 90.0 CLAY sandy, med stiff, gray, calc
	90.0		90.0 - 92.0 CLAY sandy, med stiff, gray, calc
	92.0		92.0 - 94.0 CLAY sandy, med stiff, gray, calc
	94.0		94.0 - 96.0 CLAY sandy, med stiff, gray, calc
	96.0		96.0 - 98.0 CLAY sandy, med stiff, gray, calc
	98.0		98.0 - 100.0 CLAY sandy, med stiff, gray, calc

ELEVATION	DEPTH	LEGEND	CLASSIFICATION OF MATERIALS (Description)	COLE RECOVERED	BOX OR SAMPLE NO.	REMARKS (Drilling time, water level, depth of weathering, etc., if significant)
35.5	30.2		SAND tan, sat'd, gravelly, med to coarse gr, med dense, calc			
19.2	27.0		SHALE dk. gray, med hard (rock classification unvec, non-jointed, sl. calc 43.2 - 50.0 signific- antly higher to fis- tall.			
87.0 - 87.1			SILTSTONE hard, cemented, massive			
87.1 - 90.2			LIMESTONE lt. gray, soft (rock classification), massive			
87.1 - 88.9			SHALE	05.0		
90.2 - 97.1			SHALE dk. gray, med hard, non-jointed	05.5		
97.1 - 97.5			SILTSTONE hard, cemented, massive	L18		
97.1 - 97.5				L11		
TD @ 97.5						

Hole No. 8A6D-66

DRILLING LOG		Division Southwest TN	INSTALLATION Port North	SHEET of 1 sheets
PROJECT Aubrey D.S.		Hole size and type of bit 8" dia. core, 6" d. bb'l.		
LOCATION (Community or Station)		DATE FOR TELEVISION-CORRECTED HOLE Falling 1900		
DRILLING AGENCY Coles of Engineers		MANUFACTURER IDENTIFICATION OF DRILL Falling 1500		
HOLE NO. (See instructions on drawing title and file number) 8A6D-66		TOTAL NO. OF OVER- BURDEN SAMPLES TAKEN 6		
NAME OF DRILLER Newhouse		TOTAL NUMBER CORE BOXES 6		
DIRECTION OF HOLE <input checked="" type="checkbox"/> VERTICAL <input type="checkbox"/> INCLINED deg. from vert		ELEVATION GROUND WATER		
THICKNESS OF OVERBURDEN =		DATE HOLE STARTED 2 April 73		
DEPTH DRILLED INTO ROCK =		DATE HOLE COMPLETED 3 April 73		
TOTAL DEPTH OF HOLE 35.7		TOTAL CORE RECOVERY FOR BORING		
		NATURE OF MUD		
		CORRECTION FACTOR		

ELEVATION	DEPTH	LEGEND	CLASSIFICATION OF MATERIALS (Description)	COLE RECOVERED	BOX OR SAMPLE NO.	REMARKS (Drilling time, water level, depth of weathering, etc., if significant)
0.0'	19.0'		CLAY - 0.0 to 3.0 - sli. sandy medium to stiff, moist, brown. 3.0 to 16.0 - sandy to 16.0, very sandy from 16.0 to 19.0, stiff, moist, tan.			1. Elevation of ground water was not determined. 2. Jars: A. 24.0 B. 26.0 C. 28.0 D. 30.0 E. 32.0 F. 34.0 NOTE: All jar samples taken from Denison bb'l shoe.
19.0'	21.0'		SAND, sli. clayey, medium to coarse-grained, medium dense, moist, tan.			3. Denison Cans: 1. 22.0 to 24.0 2. 24.0 to 26.0 3. 26.0 to 28.0 4. 28.0 to 30.0 5. 30.0 to 32.0 6. 32.0 to 34.0
21.0'	22.0'		CLAY, sandy, medium stiff moist, tan.			4. Pocket penetrometer tests as follows: cm no. test 2. 2.75 3. 2.0 4. 1.5 5. 1.5
	22.0'		-- Start 6" d. b'l. at 22.0			5. No jar samples taken from 0.0 to 22.0
22.0'	24.0'		SAND, clayey, medium dense, moist, tan.	L. 1		6. 0.0 to 22.0 - 4' core 22.0 to 35.7 - 6' core
24.0'	30.0'		CLAY, sandy, stiff, moist tan.	L. 2 L. 3		
30.0'	32.0'		BORDERLINE - sandy clay or clayey sand, moist, tan.	L. 4 L. 5		
32.0'	35.7'		SAND, medium to coarse- grained, gravelly with gravel increase at 33.2' REFUGAL w/ d.b. @ 35.7'	L. 6 No Rec.		7. Bentonite drill mud used from 22.0

ENG FORM 1836 PREVIOUS EDITIONS ARE OBSOLETE PROJECT Aubrey, D.S. HOLE NO. 8A6D-66

Note No. 867-6

DRILLING LOG		DIVISION		INSTALLATION		SHEET	
southwest		Fort Worth		of 1 sheets			
1. PROJECT		2. LOCATION		3. DRILLING AGENCY		4. HOLE NO. (As shown on drawing title and hole number)	
Aubrey D.S.		11. DATE (For elevation information only)		5. NAME OF DRILLER		6. HOLE NO. (As shown on drawing title and hole number)	
Camps of Engineers		12. DATE HOLE STARTED		Newhouse		7. HOLE NO. (As shown on drawing title and hole number)	
8A6D-66		13. DATE HOLE COMPLETED		2 April 73		8. TOTAL DEPTH OF HOLE	
9. DIRECTION OF HOLE		14. ELEVATION TOP OF HOLE		15. TOTAL CORE RECOVERY FOR BORING		9. TOTAL DEPTH OF HOLE	
10. THICKNESS OF OVERBURDEN		16. ELEVATION GROUND WATER		17. NATURE OF INSPECTOR		18.7	
11. DEPTH DRILLED INTO ROCK		17. ELEVATION TOP OF HOLE		Christie			
12. TOTAL DEPTH OF HOLE		18. TOTAL CORE RECOVERY FOR BORING		19. NATURE OF INSPECTOR			
13.7		19. TOTAL CORE RECOVERY FOR BORING		Christie			
ELEVATION	DEPTH	LEGEND	CLASSIFICATION OF MATERIALS (Description)	LOG RECORD	TEST	REMARKS (Including test, water flow, depth of penetration, etc., if significant)	
			0.0' to 19.0'			1. Elevation of ground water was not determined.	
			CLAY - -			2. Jars:	
			0.0 to 3.0 - sil. sandy medium to stiff, moist, brown.			A. 24.0	
			3.0 to 16.0 - sandy to 16.0, very sandy from 16.0 to 19.0, stiff, moist, tan.			B. 26.0	
			19.0' to 21.0'			C. 28.0	
			SAND, sil. clayey, medium to coarse-grained, medium dense, moist, tan.			D. 30.0	
			21.0' to 22.0'			E. 32.0	
			CLAY, sandy, medium stiff moist, tan.			F. 34.0	
			-- Start 6" d. b'l. at 22.0'				
			22.0' to 24.0'	L. 1.0	1	3. Denison Cans:	
			SAND, clayey, medium dense, moist, tan.	L. 0.4	2	1. 22.0 to 24.0	
			24.0' to 30.0'	L. 0.0	3	2. 24.0 to 26.0	
			CLAY, sandy, stiff, moist tan.	L. 0.0	b	3. 26.0 to 28.0	
			30.0' to 32.0'	L. 0.0	5	4. 28.0 to 30.0	
			BORDERLINE - sandy clay or clayey sand, moist, tan.	L. 0.3	6	5. 30.0 to 32.0	
			32.0' to 35.7'	No Rec.	X	6. 0.0 to 22.0 - auger 22.0 to 35.7 - 6" d.	
			SAND, medium to coarse-grained, gravelly with gravel increase at 33.2'			7. Bentonite drill mud used from 22.0	
			REVEAL w/ d.b. to 35.7'				

ENG FORM 1836 MAR 73 PREVIOUS EDITIONS ARE OBSOLETE

PROJECT: Aubrey D.S. HOLE NO: 8A6D-66

RECORD DRAWING-WORK AS BUILT

SYM	LOG NO	ACTION	DATE	DESCRIPTION OF REVISION
U.S. ARMY ENGINEER DISTRICT, FORT WORTH CORPS OF ENGINEERS FORT WORTH, TEXAS				
DESIGNED BY	RAY ROBERTS LAKE ELM FORK, TRINITY RIVER, TEXAS EMBANKMENT, SPILLWAY AND OUTLET WORKS LOGS OF BORINGS 8A6D-65 AND 8A6D-66			
DRAWN BY				
REVIEWED BY				
SUBMITTED BY				
ENGINEER	INVITATION NO	DACW63-82B-0025	DATE	MAR, 1982
	CONTRACT NO	DACW63-52 C 0013	SEQUENCE NO	
	DRAWING NUMBER		SHEET NO	26
			OF	

TO ACCOMPANY FOUNDATION REPORT

Note No. 8162-67

DRILLING LOG		Division	INSTALLATION	SHEET
PROJECT Audrey D. S.		Coastal	Port Tank, New York	1 of 2 SHEETS
1. LOCATION (Continent or Island)			10. SIZE AND TYPE OF BIT 11. BITCH FOR ELEVATION (Type of Bit)	
2. DRILLING AGENCY Corps of Engineers			12. HANDS/FEET'S ELEVATION OF DRILL Fadlan 1500	
3. HOLE NO. (As shown on drawing sheet and file number)		8162-67	13. TOTAL NO. OF OVERBURDEN SAMPLES TAKEN	12
4. NAME OF DRILLER Mullins			14. TOTAL NUMBER CORE BOIES	9
5. DIRECTION OF HOLE <input checked="" type="checkbox"/> VERTICAL <input type="checkbox"/> INCLINED			15. ELEVATION GROUND WATER	60
6. THICKNESS OF OVERBURDEN		35.3	16. DATE HOLE STARTED	8 Aug 73
7. DEPTH DRILLED INTO ROCK		0	17. DATE HOLE COMPLETED	19 Aug 73
8. TOTAL DEPTH OF HOLE		35.3	18. ELEVATION TOP OF HOLE	559.6'
			19. TOTAL CORE RECOVERY FOR SPINS	3
			20. SIGNATURE OF DRILLER	<i>Joseph A. Blum</i>

ELEVATION	DEPTH	LEGEND	CLASSIFICATION OF MATERIALS (Description)	CORE RECOVERY	BOX OR SAMPLE NO.	REMARKS (Diving time, water flow, depth of penetration, etc., if significant)
0.0 to 33.3			CLAY - 0.0 to 3.0 medium plasticity, dark brown, medium stiff, moist 3.0 to 9.4 low to medium plasticity, brown, very moist, stiff, slightly sandy 9.4 to 16.5 medium plasticity, dark brown, stiff, moist 16.5 to 26.5 low plasticity, dark brown, stiff to very stiff, moist, slightly sandy 26.5 to 30.5 medium plasticity, dark brown, stiff, moist 30.5 to 33.3 medium plasticity, gray and tan, very stiff, moist 33.3 to 35.3 GRAVEL -		Jar A Jar B Jar C Jar D Can 1 Can 2 Can 3 Can 4 Can 5 Can 6 Can 7 Can 8	Drilling 0.0 to 15.0 10" sugar 15.0 to 33.3 6" D Bbl 33.3 to 35.3 77/8" rock bit Denison samples 1. 15.8 to 17.8 2. 19.8 to 21.8 3. 21.8 to 23.8 4. 23.8 to 25.8 5. 25.8 to 27.8 6. 27.8 to 29.8 7. 29.8 to 31.8 8. 31.8 to 33.3 Denison sample 1. 18.1 to 19.0 Note: sample came from denison can. Jar samples A. 0.0 to 3.0 B. 3.0 to 9.4 C. 8.0 to 9.4 D. 9.4 to 15.8 E. 17.8 F. 19.8 G. 21.8 H. 23.8 I. 25.8 J. 27.8 K. 29.8 L. 31.8 Note: samples E through L from shoe of Denison Bbl. Location Hole offset 20.7' S35°W from staked location (X= 2,141,445; Y= 615,594). New elevation is 559.6 as determined by hand level. T. D. @ 35.3
						Hand penetrometer test depth tons/sq. ft. 17.8 1.30 19.8 1.50 21.8 2.25 23.8 2.25 25.8 2.25 27.8 1.75 29.8 1.75 31.8 3.30 Note All samples are calcareous. Water table Hole was not bailed. 4" slotted, plastic pipe set to 36.0'. Daily measurements reported on supplemental sheet.

DRILLING LOG		Division	INSTALLATION	SHEET
PROJECT Audrey D. S.		Southwestern		
1. LOCATION (Continent or Island)			10. SIZE AND TYPE OF BIT	
2. DRILLING AGENCY Corps of Engineers			12. HANDS/FEET'S ELEVATION OF DRILL	
3. HOLE NO. (As shown on drawing sheet and file number)		8162-69	13. TOTAL NO. OF OVERBURDEN SAMPLES TAKEN	
4. NAME OF DRILLER Mullins			14. TOTAL NUMBER CORE BOIES	
5. DIRECTION OF HOLE <input checked="" type="checkbox"/> VERTICAL <input type="checkbox"/> INCLINED			15. ELEVATION GROUND WATER	
6. THICKNESS OF OVERBURDEN		45.5'	16. DATE HOLE STARTED	
7. DEPTH DRILLED INTO ROCK		0	17. DATE HOLE COMPLETED	
8. TOTAL DEPTH OF HOLE		45.5'	18. ELEVATION TOP OF HOLE	
			19. TOTAL CORE RECOVERY FOR SPINS	
			20. SIGNATURE OF DRILLER	

ELEVATION	DEPTH	LEGEND	CLASSIFICATION OF MATERIALS (Description)
0.0 to 29.2			CLAY - 0.0 to 6.0 medium pl dark brown, medium at stiff, moist, calcareous 6.0 to 14.6 medium pl brown, hard, moist (very stiff at 12.5) 14.6 to 18.0 medium tlicity, light brown, stiff, moist 18.0 to 22.0 high pl brown, very stiff, ve 22.0 to 28.2 medium tlicity, light brown a very n stiff to stiff moist, slightly sandy 28.2 to 29.2 low pla gray and tan, very at moist 29.2 to 32.6 SAND - tan, loose to medium saturated, non calcareous 32.6 to 36.0 Clay - 32.6 to 34.5 medium tlicity, moist, stiff, and gray 34.0 to 36.0 low pla tan and gray, soft to stiff, saturated, sandy 36.0 to 38.5 SAND - tan, medium dense, slightly clayey 38.5 to 45.5 GRAVEL - tan, loose, saturated, sandy, becomes coarse 40.5 T. D. @ 45.5

Hole No. 1150-69

DRILLING LOG	Division Southwestern	INSTALLATION Fort Worth District	SHEET 1 OF 2 SHEETS
PROJECT Aubrey D. S.		W. SIZE AND TYPE OF BIT 6" D Bit	
LOCATION (County, State or Federal) Xr 2, 141, 610 Yr 615, 020		DATE FOR ELEVATION DETERMINATION NSI	
DRILLING AGENCY Corps of Engineers		II. MANUFACTURER'S DESIGNATION OF DRILL Falling 1500	
HOLE NO. (As shown on drawing sheet and its number) 0A6D-69		III. TOTAL NO. OF OVER-ROUNDER SAMPLE TAKEN 20	IV. UNDRUN 16
NAME OF DRILLER Mullins		VI. TOTAL NUMBER CORE BOXES	
DIRECTION OF HOLE <input checked="" type="checkbox"/> VERTICAL <input type="checkbox"/> INCLINED		DATE MOLE STARTED 9 Aug 73 COMPLETED 10 Aug 73	
THICKNESS OF OVERBURDEN 47.5'		ELEVATION TOP OF MOLE 560.81	
DEPTH DRILLED INTO ROCK 0		TOTAL CORE RECOVERY FOR BORING	
TOTAL DEPTH OF HOLE 47.5'		SIGNATURE OF INSPECTOR James G. ...	

ELEVATION	DEPTH	LEGEND	CLASSIFICATION OF MATERIAL (Description)	CORE RECOVERY	BOX OR SAMPLE NO.	REMARKS (Drilling time, water flow, depth of penetration, etc., if significant)
0.0 to 29.2			CLAY --		Jar A	Drilling
0.0 to 6.0			sedium plasticity, dark brown, sedium stiff to stiff, moist, calcareous		Jar B	0.0 to 5.0 8" sugar 5.0 to 41.0 6" D Bit 41.0 to 45.5 7 7/8" rock bit no casing
6.0 to 14.6			sedium plasticity, brown, hard, moist (becomes very stiff at 12.5)		Can 2	Denison samples
14.6 to 18.0			sedium plasticity, light brown, very stiff, moist		Can 3	1. 5.0 to 7.0 2. 7.0 to 9.0 3. 9.0 to 11.0 4. 11.0 to 13.0 5. 13.0 to 15.0 6. 15.0 to 17.0 7. 17.0 to 19.0 8. 19.0 to 21.0 9. 21.0 to 23.0 10. 23.0 to 25.0 11. 25.0 to 27.0 12. 27.0 to 29.0 13. 31.0 to 33.0 14. 33.0 to 35.0 15. 35.0 to 37.0 16. 37.0 to 39.0
18.0 to 22.0			high plasticity, brown, very stiff, very moist		Can 4	Notes: sand sample from 29.0 to 31.0 and gravel sample from 39.0 to 41.0 were disturbed.
22.0 to 26.2			sedium plasticity, light brown and gray, very stiff to stiff, moist, slightly sandy		Can 5	Sand samples
26.2 to 29.2			low plasticity, gray and tan, very stiff, moist		Can 6	A. 0.0 to 3.0 B. 3.0 to 5.0 C. 7.0 D. 9.0 E. 11.0 F. 13.0 G. 15.0 H. 17.0 I. 19.0 J. 21.0 K. 23.0 L. 25.0 M. 27.0 N. 29.0 O. 31.0 P. 33.0 Q. 35.0 R. 37.0 S. 39.0 T. 41.0
29.2 to 32.6			SAND --		Can 7	
			tan, loose to medium dense, saturated, non calcareous		Can 8	
32.6 to 36.0			CLAY --		Can 9	
			tan, loose to medium dense, saturated, non calcareous		Can 10	
36.0 to 38.5			SAND --		Can 11	
			tan, medium dense, saturated, slightly clayey		Can 12	
38.5 to 45.5			GRAVEL --		Can 13	
			tan, loose, saturated, sandy, becomes coarse at 40.5'		Can 14	
			T. D. @ 45.5'		Can 15	
					Can 16	
					Can 17	
					Can 18	
					Can 19	
					Can 20	

Hole No. 1150-69

DRILLING LOG	Division Southwestern	INSTALLATION Fort Worth District	SHEET 2 OF 2 SHEETS
PROJECT Aubrey D. S.		W. SIZE AND TYPE OF BIT 6" D Bit	
LOCATION (County, State or Federal) Xr 2, 140, 155 Yr 614, 685		DATE FOR ELEVATION DETERMINATION NSI	
DRILLING AGENCY Corps of Engineers		II. MANUFACTURER'S DESIGNATION OF DRILL Falling 1500	
HOLE NO. (As shown on drawing sheet and its number) 0A6D-69		III. TOTAL NO. OF OVER-ROUNDER SAMPLE TAKEN 20	IV. UNDRUN 16
NAME OF DRILLER Mullins		VI. TOTAL NUMBER CORE BOXES	
DIRECTION OF HOLE <input checked="" type="checkbox"/> VERTICAL <input type="checkbox"/> INCLINED		DATE MOLE STARTED 15 Aug 73 COMPLETED 15 Aug 73	
THICKNESS OF OVERBURDEN 43.0		ELEVATION TOP OF MOLE 557.5	
DEPTH DRILLED INTO ROCK 1.0		TOTAL CORE RECOVERY FOR BORING	
TOTAL DEPTH OF HOLE 44.0		SIGNATURE OF INSPECTOR James G. ...	

ELEVATION	DEPTH	LEGEND	CLASSIFICATION OF MATERIAL (Description)	CORE RECOVERY	BOX OR SAMPLE NO.	REMARKS (Drilling time, water flow, depth of penetration, etc., if significant)
0.0 to 32.0			CLAY --		Jar A	
0.0 to 4.5			medium plasticity, brownish-gray, stiff, slightly moist		Jar B	0.0 to 15.0 15.0 to 37.0 37.0 to 44.0 rockbit no casing
4.5 to 11.0			low to medium plasticity, brown, stiff to very stiff, moist, with some calcareous particles 5.2 to 11.0		Jar C	
11.0 to 20.0			high plasticity, light brown, moist to very moist, stiff		Jar D	A. 0.0 to 4.5 B. 4.5 to 11.0 C. 5.2 to 11.0 D. 10.2 to 11.0 E. 11.0 to 17.0 F. 17.0 to 19.0 G. 19.0 to 21.0 H. 21.0 to 23.0 I. 23.0 to 25.0 J. 25.0 to 27.0 K. 27.0 to 29.0 L. 29.0 to 31.0 M. 31.0 to 33.0 N. 33.0 to 35.0 O. 35.0 to 37.0 P. 37.0 to 39.0
20.0 to 22.0			high plasticity, light brown, medium stiff, very moist to saturated		Can 1	Notes: samp P taken from Denison bar
22.0 to 28.0			medium plasticity, brown, stiff to very stiff, moist, with some calcareous particles and a few small shells		Can 2	
28.0 to 30.0			medium plasticity, tan, stiff, very moist, slightly sandy		Can 3	
30.0 to 32.0			low plasticity, tan, saturated, stiff, sandy		Can 4	Denison.
32.0 to 43.0			SAND --		Can 5	1. 15.0 to 17.0 2. 17.0 to 21.0 3. 21.0 to 23.0 4. 23.0 to 25.0 5. 25.0 to 27.0 6. 27.0 to 29.0 7. 29.0 to 31.0 8. 31.0 to 33.0 9. 33.0 to 35.0
			tan, saturated, stiff, sandy		Can 6	
32.0 to 34.0			tan, medium dense, clayey, saturated		Can 7	
34.0 to 36.5			tan, loose, saturated, gravelly		Can 8	
36.5 to 43.0			with coarse gravel		Can 9	Notes: no sample 21.0 due to no sample 21.0 due to pre-
43.0 to 44.0			SHALE --		Can 10	Hand Remot depth 17.0 19.0 23.0 25.0 27.0 29.0 31.0
			dark gray, medium hard (rock classification), unweathered, non-jointed, moist		Can 11	**Water Hole bailed initially X water vary After com bailing, 9.8'. Addi table info ported on sheet. 4' plastic p 35.0'

DRILLING LOG		INSTALLATION			
PROJECT: Southwestern		Hole No. 8167-00			
LOCATION: Abbey D. S.		Sheet 1 of 2 sheets			
DATE: Y-2-148-155		MANUFACTURER'S DECLARATION OF QUALITY			
DRILLING PROJECT: Y-614,685		Fallline 1500			
CORPS OF ENGINEERS		TOTAL NO. OF OVERBURDEN SAMPLES TAKEN: 16			
HOLE NO. (As shown on drawing sheet): 816D-69		UNDISTURBED: 9			
NAME OF DRILLER: W. J. ...		TOTAL NUMBER CORE BOXES: 16			
DIRECTION OF HOLE: <input checked="" type="checkbox"/> VERTICAL <input type="checkbox"/> INCLINED		ELEVATION GROUND WATER: 80			
THICKNESS OF OVERBURDEN: 45.0		DATE HOLE STARTED: 15 AUG 73			
DEPTH DRILLED INTO ROCK: 1.0		DATE HOLE COMPLETED: 16 AUG 73			
TOTAL DEPTH OF HOLE: 44.0		ELEVATION TOP OF HOLE: 557.5'			
		TOTAL CORE RECOVERY FOR BORING: 557.5'			
		SIGNATURE OF INSPECTOR: Joseph A. ...			
ELEVATION	DEPTH	LEGEND	CLASSIFICATION OF MATERIAL (Overburden)	NO. ON SAMPLE NO.	REMARKS (Drilling time, water level, depth of overburden, etc., if significant)
0.0	0.0		CLAY --	Jar A	*Drilling
0.0	4.5		medium plasticity, brownish-gray, stiff, slightly moist	Jar B	0.0 to 15.0 10" auger
4.5	11.0		low to medium plasticity, brown, stiff to very stiff, moist, with some calcareous particles 5.2 to 11.0	Jar C	15.0 to 37.0 6" D Ebl
11.0	20.0		high plasticity, light brown, moist to very moist, stiff	Jar D	37.0 to 44.0 7 7/8" rockbit
20.0	22.0		high plasticity, light brown, medium stiff, very moist to saturated	Jar E	no casing
22.0	28.0		medium plasticity, brown, stiff to very stiff, moist, with some calcareous particles and a few small chells	Can 1	Jar samples
28.0	30.0		medium plasticity, tan, stiff, very moist, slightly sandy	Can 2	A. 0.0 to 4.5
30.0	32.0		low plasticity, tan, saturated, stiff, sandy	Can 3	B. 4.5 to 5.2
32.0	45.0		SAND --	Can 4	C. 5.2 to 10.2
32.0	34.0		tan, medium dense, clayey, saturated	Can 5	D. 10.2 to 11.0
34.0	36.5		tan, loose, saturated, gravelly	Can 6	E. 11.0 to 15.0
36.5	45.0		with coarse gravel	Can 7	F. 17.0 to 19.0
				Can 8	G. 19.0
				Can 9	H. 21.0
					I. 23.0
					J. 25.0
					K. 27.0
					L. 29.0
					M. 31.0
					N. 33.0
					O. 35.0
					P. 37.0
					Note: samples F through P taken from shoe of Denison barrel.
					Denison samples
					1. 15.0 to 17.0
					2. 17.0 to 19.0
					3. 21.0 to 23.0
					4. 23.0 to 25.0
					5. 25.0 to 27.0
					6. 27.0 to 29.0
					7. 29.0 to 31.0
					8. 31.0 to 33.0
					9. 33.0 to 35.0
					Note: no sample 19.0 to 21.0 due to catchers
					no sample 35.0 to 37.0 due to presence of gravel
					Note
					All overburden material are calcareous.
					Hand penetrometer test
					depth : tons/sq. ft.
					17.0 : 3.20
					19.0 : 2.75
					23.0 : 2.65
					25.0 : 2.65
					27.0 : 1.75
					29.0 : 1.50
					31.0 : 1.20
					**Water table
					Hole bailed to approximately 30.0' but making water very rapidly. After completion of bailing, water level at 9.8'. Additional water table information reported on supplemental sheet. 4" slotted plastic pipe set to 35.0'.
45.0	44.0		SHALE --		
			dark gray, medium hard (rock classification), un-weathered, non-jointed, moist		

RECORD DRAWING-WORK AS BUILT

SYM	NO.	ACTION	DATE	DESCRIPTION OF REVISION
U.S. ARMY ENGINEER DISTRICT, FORT WORTH CORPS OF ENGINEERS FORT WORTH, TEXAS				
DESIGNED BY:	RAY ROBERTS LAKE ELM FORK, TRINITY RIVER, TEXAS EMBANKMENT, SPILLWAY AND OUTLET WORKS LOGS OF BORINGS 8A6D-67, 8A6D-68, AND 8A6D-69			
DRAWN BY:				
REVIEWED BY:				
SUBMITTED BY:	INITIATION NO. DACW 63-82-C-0025 DATE: MAR 1982			
ENGINEER:	CONTRACT NO. DACW 63-82-C-0083			SEQUENCE NO. 27
	DRAWING NUMBER			SHEET NO. OF

DRILLING LOG		Installation		Sheet 1 of 2	
PROJECT: South Western		NAME OF WELL: South Western		SHEET: 1 of 2	
SUBJECT: Drilling		DATE OF LOG: 14 Aug 73		SHEET: 1 of 2	
LOCATION: 2140 700 Y 615 945		DATE OF LOG: 14 Aug 73		SHEET: 1 of 2	
DRILLING AGENCY: Corps of Engineers		DATE OF LOG: 14 Aug 73		SHEET: 1 of 2	
NAME OF DRILLER: Mullins		DATE OF LOG: 14 Aug 73		SHEET: 1 of 2	
DIRECTION OF HOLE: VERTICAL		DATE OF LOG: 14 Aug 73		SHEET: 1 of 2	
THICKNESS OF OVERBURDEN: 45.5'		DATE OF LOG: 14 Aug 73		SHEET: 1 of 2	
DEPTH DRILLED INTO ROCK: 0.5'		DATE OF LOG: 14 Aug 73		SHEET: 1 of 2	
TOTAL DEPTH OF HOLE: 40.0'		DATE OF LOG: 14 Aug 73		SHEET: 1 of 2	
ELEVATION	DEPTH	LEGEND	CLASSIFICATION OF MATERIALS (See notes)	SOIL OR ROCK NO.	REMARKS (Depth, time, water level, etc.)
	0.0		0.0 to 29.0 CLAY --	Jar A	Drilling
	0.0		0.0 to 5.0 medium plasticity, dark brown, medium stiff, slightly moist		0.0 to 40.0 8" auger no casing
	5.0		5.0 to 10.8 medium plasticity, brown, stiff, moist, with some calcareous particles	Jar B	Jar samples
	10.8		10.8 to 27.0 high plasticity, brown, stiff to very stiff moist	Jar C	A. 0.0 to 5.0 B. 5.0 to 10.8 C. 10.8 to 12.0 D. 12.0 to 16.8 E. 16.8 to 21.8 F. 21.8 to 27.0 G. 27.0 to 28.0 H. 28.0 to 29.0 I. 29.0 to 31.0 J. 31.0 to 33.0 K. 33.0 to 34.0 L. 34.0 to 35.0 M. 35.0 to 38.0 N. 38.0 to 39.2 O. 39.2 to 40.0
	27.0		27.0 to 28.0 medium plasticity, tan, medium stiff to stiff, very moist, slightly sandy	Jar F	Note All overburden material are calcareous
	28.0		28.0 to 29.0 low plasticity, tan, medium stiff, saturated, sandy	Jar G	*Water table
	29.0		29.0 to 33.0 SAND --	Jar H	Drilling mud not used and hole not balled. 4" slotted plastic pipe set to 33.0'. At completion of drilling, water level standing at 24.1'. Other water table information reported on supplemental sheet.
	33.0		33.0 to 34.0 CLAY --	Jar I	
	34.0		34.0 to 35.0 GRAVEL --	Jar J	
	35.0		35.0 to 39.2 CLAY --	Jar K	
	39.2		39.2 to 40.0 SHALE --	Jar L	
	40.0		dark gray medium hard (rock classification), unweathered, non-jointed, non- to slightly calcareous	Jar M	T. D. @ 40.0

DRILLING LOG		Installation		Sheet 1 of 2	
PROJECT: South Western		NAME OF WELL: South Western		SHEET: 1 of 2	
SUBJECT: Drilling		DATE OF LOG: 14 Aug 73		SHEET: 1 of 2	
LOCATION: 2140 700 Y 615 945		DATE OF LOG: 14 Aug 73		SHEET: 1 of 2	
DRILLING AGENCY: Corps of Engineers		DATE OF LOG: 14 Aug 73		SHEET: 1 of 2	
NAME OF DRILLER: Mullins		DATE OF LOG: 14 Aug 73		SHEET: 1 of 2	
DIRECTION OF HOLE: VERTICAL		DATE OF LOG: 14 Aug 73		SHEET: 1 of 2	
THICKNESS OF OVERBURDEN: 45.5'		DATE OF LOG: 14 Aug 73		SHEET: 1 of 2	
DEPTH DRILLED INTO ROCK: 0.5'		DATE OF LOG: 14 Aug 73		SHEET: 1 of 2	
TOTAL DEPTH OF HOLE: 46.0'		DATE OF LOG: 14 Aug 73		SHEET: 1 of 2	
ELEVATION	DEPTH	LEGEND	CLASSIFICATION OF MATERIALS (See notes)	SOIL OR ROCK NO.	REMARKS (Depth, time, water level, etc.)
	0.0		0.0 to 30.5 CLAY --		
	0.0		0.0 to 6.5 medium plasticity, brown, medium stiff (becomes stiff at 4.0), slightly moist		
	6.5		6.5 to 11.5 low plasticity, light brown, very stiff, slightly sandy		
	11.5		11.5 to 16.5 medium plasticity, light brown, stiff, moist		
	16.5		16.5 to 29.6 medium to high plasticity, brown, stiff, moist		
	29.6		29.6 to 30.5 low plasticity, tan, stiff, saturated, sandy, very slightly gravelly		
	30.5		30.5 to 31.7 SAND --		
	31.7		31.7 to 37.0 CLAY --		
	37.0		37.0 to 45.5 GRAVEL --		
	45.5		45.5 to 46.0 SAND --		

DRILLING LOG		Division	INSTALLATION	Sheet 1 of 2 SHEETS	
PROJECT Abrey D. S.		Southwestern	Port North District		
I. LOCATION (Continuation of Form)					
Xt 2-140,700 Yt 615,945					
II. DRILLING AGENCY Corps of Engineers					
III. HOLE NO. 722 (shown on casing data) and site number		DA-71			
IV. NAME OF DRILLER Hullins					
V. DIRECTION OF HOLE <input checked="" type="checkbox"/> VERTICAL <input type="checkbox"/> INCLINED DES. FROM FEET					
VI. THICKNESS OF OVERBURDEN 45.5'					
VII. DEPTH DRILLED INTO ROCK 0.5'					
VIII. TOTAL DEPTH OF HOLE 46.0'					
IX. DATE HOLE STARTED 13 Aug 73 COMPLETED 14 Aug 73					
X. ELEVATION TOP OF HOLE 560.0'					
XI. TOTAL CORE RECOVERY FOR SOILS 60%					
REMARKS <i>Joseph H. Shanks</i>					
ELEVATION	DEPTH	LEGEND	CLASSIFICATION OF MATERIALS (Description)	SOIL SAMPLE NO.	REMARKS (Drilling time, water loss, depth of penetration, etc., if significant)
0.0 to 30.5			CLAY -- 0.0 to 6.5 medium plasticity, brown, medium stiff (becomes stiff at 4.0), slightly moist. 6.5 to 11.5 low plasticity, light brown, very stiff, slightly sandy. 11.5 to 16.5 medium plasticity, light brown, stiff, moist. 16.5 to 29.6 medium to high plasticity, brown, stiff, moist.	Jar A Jar B Jar C Jar D Jar E Jar F Jar G Jar H Jar I Jar J Jar K Jar L	Drilling 0.0 to 43.0 8" auger 43.0 to 46.0 7 7/8" rockbit *Water samples A. 0.0 to 4.0 B. 4.0 to 6.5 C. 6.5 to 11.5 D. 11.5 to 16.5 E. 16.5 to 20.5 F. 20.5 to 25.5 G. 25.5 to 29.6 H. 29.6 to 30.5 I. 30.5 to 31.7 J. 31.7 to 32.5 K. 32.5 to 37.0 L. 37.0 to 42.0 M. 42.0 to 45.5 *Notes All materials are calcareous. *Water table Because of squeezing, hole was bailed only to 16.0' slotted, plastic set to 39.2'. See measurements reported on supplemental sheet.
29.6 to 30.5			low plasticity, tan, stiff, saturated, sandy, very slightly gravelly	Jar M	
30.5 to 31.7			SAND -- tan, loose, saturated, coarse, gravelly	Jar N	
31.7 to 37.0			CLAY -- 31.7 to 32.5 high plasticity, gray and tan mottled, medium stiff, very moist, calcareous 32.5 to 37.0 high plasticity, grayish-brown, soft to medium stiff, very moist to saturated. Becomes slightly sandy at 35.0	Jar O	
37.0 to 45.5			GRAVEL -- tan, loose, saturated, clayey, with some shells and small cobbles. Becomes very clayey at 42.0'	Jar P	T. D. @ 46.0

DRILLING LOG		Division	INSTALLATION	Sheet 1 of 2 SHEETS	
PROJECT Abrey D. S.		Southwestern	Port North District		
I. LOCATION (Continuation of Form)					
Xt 2-140,700 Yt 615,945					
II. DRILLING AGENCY Corps of Engineers					
III. HOLE NO. 722 (shown on casing data) and site number		BA6C-72			
IV. NAME OF DRILLER Kerby					
V. DIRECTION OF HOLE <input checked="" type="checkbox"/> VERTICAL <input type="checkbox"/> INCLINED DES. FROM FEET					
VI. THICKNESS OF OVERBURDEN 21.0					
VII. DEPTH DRILLED INTO ROCK 7.0					
VIII. TOTAL DEPTH OF HOLE 28.0					
IX. DATE HOLE STARTED 17 Aug 73 COMPLETED 21 Aug 73					
X. ELEVATION TOP OF HOLE 570.4					
XI. TOTAL CORE RECOVERY FOR SOILS 60%					
REMARKS <i>Joseph H. Shanks</i>					
ELEVATION	DEPTH	LEGEND	CLASSIFICATION OF MATERIALS (Description)	SOIL SAMPLE NO.	REMARKS (Drilling time, water loss, depth of penetration, etc., if significant)
0.0 to 4.0			CLAY -- medium plasticity, brown, very stiff, slightly moist, slightly sandy.	Jar A	*Location Hole offset 16.0' S40° E from staked location of X-2-138,510 and Y-614,460 *Water table
4.0 to 20.0			SAND -- 4.0 to 11.0 tan, medium dense, moist, fine, clayey; becomes silty at 10.0 11.0 to 12.5 tan, medium dense, moist, silty, with small ironstone nodules 12.5 to 15.0 tan and gray, loose, saturated, with ironstone 15.0 to 17.0 gray, loose, saturated, silty 17.0 to 20.0 tan, loose, saturated, silty	Jar B Jar C Jar D Jar E Jar F Jar G	4" slotted plastic pipe installed to 18.5' depth. hole bailed to 23.0'. Readings report on supplemental sheet. *Drilling 0.0 to 24.0 8" auger 24.0 to 28.0 6" core *Water samples A. 0.0 to 4.0 B. 4.0 to 10.0 C. 10.0 to 11.0 D. 11.0 to 12.5 E. 12.5 to 15.0 F. 15.0 to 17.0 G. 17.0 to 20.0 H. 20.0 to 21.0 *Cation sample I. 26.7 to 27.6 *Notes Overburden is non-calcareous. Max elevation is 571.0' 8" casing to 24.0'
20.0 to 21.0			GRAVEL -- tan, loose, saturated, sandy, with cobbles up to 4" diameter	Jar H Jar I Jar J Jar K Jar L	
21.0 to 21.2			SILTSTONE -- light gray, hard (rock classification), massive	Box 1.2	
21.2 to 28.0			SHALE -- light gray, non-weathered, moderately hard (rock classification), laminated, non-jointed T. D. @ 28.0		

ENG FORM 1836 PREVIOUS EDITIONS ARE OBSOLETE.
MAR 71

PROJECT
Abrey D. S.

HOLE NO.
BA6C-72

Note No. 8A6C-72		SHEET 1 of 1 SHEETS	
PROJECT: Southwestern Fort Worth District			
INSTALLATION: Fort Worth District			
PROJECT: Aubrey D. S.			
LOCATION: X = 2,138,837 Y = 614,570			
MANUFACTURER'S DESIGNATION OF DRILL: Falling 1500			
TOTAL NO. OF OVERBURDEN SAMPLES TAKEN: 0			
TOTAL NUMBER CORE BOXES: 1			
ELEVATION GROUND WATER: 00			
DATE MOLE: 17 Aug 73 21 Aug 73			
ELEVATION TOP OF MOLE: 570.4			
TOTAL CORE RECOVERY FOR BORING: 60%			
SIGNATURE OF INSPECTOR: <i>Joseph P. Olmsted</i>			
CLASSIFICATION OF MATERIAL (Description)	CORE RECOVERY	BOX OR SAMPLE NO.	REMARKS (Depth from, water level, depth of overburden, etc., if significant)
0.0 to 4.0 CLAY - medium plasticity, brown, very stiff, slightly moist, slightly sandy.	Jar A		location Hole offset 16.0' S40° W from staked location of X = 2,138,510 and Y = 614,460
4.0 to 20.0 SAND - 4.0 to 11.0 tan, medium dense, moist, fine, clayey; becomes silty at 10.0	Jar B		Water table 4" slotted plastic pipe installed to 18.5 after hole bailed to 23.0. Readings reported on supplemental sheet.
11.0 to 12.5 tan, medium dense, moist, silty, with small ironstone nodules	Jar C		Drilling 0.0 to 24.0 8" auger 24.0 to 28.0 6" core
12.5 to 15.0 tan and gray, loose, saturated, with ironstone	Jar D		
15.0 to 17.0 gray, loose, saturated, silty	Jar E		Jar samples A. 0.0 to 4.0 B. 4.0 to 10.0 C. 10.0 to 11.0 D. 11.0 to 12.5 E. 12.5 to 15.0 F. 15.0 to 17.0 G. 17.0 to 20.0 H. 20.0 to 21.0
17.0 to 20.0 tan, loose, saturated, silty	Jar F		
20.0 to 21.0 GRAVEL - tan, loose, saturated, sandy, with cobbles up to 4" diameter	Jar G		Carton sample 1. 26.7 to 27.6
21.0 to 21.2 SILTSTONE - light gray, hard (rock classification), massive	Jar H		Notes Overburden is non-calcareous - box elevation is 571.0' 8" casing to 24.0'
21.2 to 28.0 SHALE - light gray, non-weathered, moderately hard (rock classification), laminated, non-jointed	Box 1		
ELEVATION TOP OF MOLE: 570.4			
TOTAL CORE RECOVERY FOR BORING: 60%			
SIGNATURE OF INSPECTOR: <i>Joseph P. Olmsted</i>			

Note No. 8A6C-73		SHEET 1 of 1 SHEETS				
PROJECT: Southwestern Fort Worth District						
INSTALLATION: Fort Worth District						
PROJECT: Aubrey D. S.						
LOCATION: X = 2,138,837 Y = 614,570						
MANUFACTURER'S DESIGNATION OF DRILL: Falling 1500						
TOTAL NO. OF OVERBURDEN SAMPLES TAKEN: 0						
TOTAL NUMBER CORE BOXES: 1						
ELEVATION GROUND WATER: 00						
DATE MOLE: 17 Aug 73 21 Aug 73						
ELEVATION TOP OF MOLE: 560.4'						
TOTAL CORE RECOVERY FOR BORING: 100%						
SIGNATURE OF INSPECTOR: <i>Joseph P. Olmsted</i>						
ELEVATION	DEPTH	LEGEND	CLASSIFICATION OF MATERIAL (Description)	CORE RECOVERY	BOX OR SAMPLE NO.	REMARKS (Depth from, water level, depth of overburden, etc., if significant)
0.0 to 10.5			CLAY - 0.0 to 4.0 medium to high plasticity, dark brown, stiff, dry to slightly moist, non-calcareous.		Jar A	Drilling 0.0 to 14.0 8" auger 14.0 to 19.0 6" core no casing
4.0 to 6.0			medium plasticity, light brown, very stiff, moist, slightly sandy, calcareous		Jar B	
6.0 to 7.5			low plasticity, tan, stiff, moist, sandy, calcareous		Jar C	Carton sample 1. 18.1 to 19.0
7.5 to 10.5			low plasticity, tan and gray, very stiff, moist, sand, non-calcareous, becomes slightly gravelly		Jar D	
10.5 to 19.0			SHALE - moderately weathered, dark gray to tan, moist, soft (rock classification) non-jointed, with clayey sand, tan, from 13.0 to 14.0		Jar E	Water table 4" slotted plastic pipe set to 19.0 after hole bailed to 17.2'. Water table information reported on supplemental sheet.
19.0 to 19.0			2. D. O 19.0		Jar F	
			<i>Carton sample shows a mottled gray tan clay w/ small pockets of siltstone. No shale structure noted.</i>		Box 1	
			<i>Well 911714</i>			

RECORD DRAWING-WORK AS BUILT

SYM	NO	ACTION	DATE	DESCRIPTION OF REVISION
U.S. ARMY ENGINEER DISTRICT, FORT WORTH CORPS OF ENGINEERS FORT WORTH, TEXAS				
DESIGNED BY	RAY ROBERTS LAKE			
DRAWN BY	ELM FORK, TRINITY RIVER, TEXAS			
DESIGNED BY	EMBANKMENT, SPILLWAY AND			
DESIGNED BY	OUTLET WORKS			
DESIGNED BY	LOGS OF BORINGS			
DESIGNED BY	8A-70, 8A-71, 8A6C-72, AND 8A6C-73			
SUBMITTED BY	INVITATION NO. DACW63-02-C-0025 DATE MAR, 1982			
DATE	CONTRACT NO. DACW63-82-C-0083			
DRAWING NUMBER	SHEET NO.		SEQUENCE	
	28		28	

TO ACCOMPANY FOUNDATION REPORT

CONTRACT NO. DACW63-82-C-0083

Hole No. **D160-75**

DRILLING LOG DIVISION Southwestern		INSTALLATION Fort Worth District SHEET 1 OF 1 SHEETS				
1. PROJECT Aubrey D. S.		10. SIZE AND TYPE OF BIT 8" auger 6" core				
2. LOCATION (County, State or Station)		11. DATE AND TIME ELEVATION MEASUREMENTS MADE				
3. DRILLING AGENCY Comp. of Engineers		12. MANUFACTURER'S DESIGNATION OF DRILL Falling 1500				
4. HOLE NO. (As shown on drawing sheet and site marked) B160-75		13. TOTAL NO. OF OVERBURDEN SAMPLES TAKEN 0 (DISTURBED) 0 (UNDISTURBED)				
5. NAME OF DRILLER Newhouse		14. TOTAL NUMBER CORE BOXES 1				
6. DIRECTION OF HOLE <input checked="" type="checkbox"/> VERTICAL <input type="checkbox"/> INCLINED SEE FROM VERT.		15. ELEVATION GROUND WATER				
7. THICKNESS OF OVERBURDEN 3.5		16. DATE HOLE STARTED 21 Aug 75 COMPLETED 22 Aug 75				
8. DEPTH DRILLED INTO ROCK 5.6		17. ELEVATION TOP OF HOLE				
9. TOTAL DEPTH OF HOLE 9.1		18. TOTAL CORE RECOVERY FOR SPRING 75%				
		19. SIGNATURE OF INSPECTOR Joseph A. Shultz				
ELEVATION	DEPTH	LEGEND	CLASSIFICATION OF MATERIALS (Description)	A CORE RECOVERY %	BOX OR SAMPLE NO.	REMARKS (Drilling time, water level, depth of overburden, etc., if significant)
			0.0 to 3.5 CLAY --			Drilling 0.0 to 3.5 8" auger 3.5 to 9.1 6" core (short barrel) 0.0 to 3.5 8" casing Carton sample
			0.0 to 2.5 medium plasticity, dark brown, stiff to very stiff, slightly moist	L.O.F	Box 1	
			2.5 to 3.5 low plasticity, brown, stiff, moist, slightly sandy; gravelly from 3.3 to 3.5	L.O.F		5.4 to 6.0 Note
			3.5 to 7.9 LIMESTONE --			Water measurements not taken. Overburden non-calcareous.
			hard (rock classification), well cemented, light gray, massive			
			7.9 to 9.1 SHALS --			
			gray and tan, moderately hard, non-jointed, non-calcareous			
			T. D. @ 9.1			

Hole No. **D160-75**

DRILLING LOG DIVISION SWD		INSTALLATION Fort Worth District SHEET 1 OF 1 SHEETS				
1. PROJECT Aubrey Dam		10. SIZE AND TYPE OF BIT 8" auger 6" core				
2. LOCATION (County, State or Station) TUNNEY OUTLET TRAMS		11. DATE AND TIME ELEVATION MEASUREMENTS MADE				
3. DRILLING AGENCY USCE		12. MANUFACTURER'S DESIGNATION OF DRILL Falling 1500				
4. HOLE NO. (As shown on drawing sheet and site marked) B160-75		13. TOTAL NO. OF OVERBURDEN SAMPLES TAKEN 0 (DISTURBED) 0 (UNDISTURBED)				
5. NAME OF DRILLER Newhouse		14. TOTAL NUMBER CORE BOXES 1				
6. DIRECTION OF HOLE <input checked="" type="checkbox"/> VERTICAL <input type="checkbox"/> INCLINED SEE FROM VERT.		15. ELEVATION GROUND WATER				
7. THICKNESS OF OVERBURDEN 12.0'		16. DATE HOLE STARTED 22 Aug 75 COMPLETED 22 Aug 75				
8. DEPTH DRILLED INTO ROCK 80.8'		17. ELEVATION TOP OF HOLE				
9. TOTAL DEPTH OF HOLE 92.8'		18. TOTAL CORE RECOVERY FOR SPRING				
		19. SIGNATURE OF INSPECTOR Joseph A. Shultz				
ELEVATION	DEPTH	LEGEND	CLASSIFICATION OF MATERIALS (Description)	A CORE RECOVERY %	BOX OR SAMPLE NO.	REMARKS (Drilling time, water level, depth of overburden, etc., if significant)
			0.0' - to 39.5'			Drilling 0.0 to 5.5 8" auger Note Water measurements not taken. Overburden non-calcareous. Auger refusal at 5.5'
			NO SAMPLES TAKEN			

ENG FORM 18-36 MAR 51 PREVIOUS EDITIONS ARE OBSOLETE. (TRANSPARENT) PROJECT **AD125**

Hole No. **D160-75**

DRILLING LOG DIVISION Southwestern		INSTALLATION Fort Worth District SHEET 1 OF 1 SHEETS				
1. PROJECT Aubrey D. S.		10. SIZE AND TYPE OF BIT 8" auger 6" core				
2. LOCATION (County, State or Station)		11. DATE AND TIME ELEVATION MEASUREMENTS MADE				
3. DRILLING AGENCY Comp. of Engineers		12. MANUFACTURER'S DESIGNATION OF DRILL Falling 1500				
4. HOLE NO. (As shown on drawing sheet and site marked) B160-75		13. TOTAL NO. OF OVERBURDEN SAMPLES TAKEN 0 (DISTURBED) 0 (UNDISTURBED)				
5. NAME OF DRILLER Newhouse		14. TOTAL NUMBER CORE BOXES 1				
6. DIRECTION OF HOLE <input checked="" type="checkbox"/> VERTICAL <input type="checkbox"/> INCLINED SEE FROM VERT.		15. ELEVATION GROUND WATER				
7. THICKNESS OF OVERBURDEN 5.5		16. DATE HOLE STARTED 22 Aug 75 COMPLETED 22 Aug 75				
8. DEPTH DRILLED INTO ROCK 0		17. ELEVATION TOP OF HOLE				
9. TOTAL DEPTH OF HOLE 5.5		18. TOTAL CORE RECOVERY FOR SPRING				
		19. SIGNATURE OF INSPECTOR Joseph A. Shultz				
ELEVATION	DEPTH	LEGEND	CLASSIFICATION OF MATERIALS (Description)	A CORE RECOVERY %	BOX OR SAMPLE NO.	REMARKS (Drilling time, water level, depth of overburden, etc., if significant)
			0.0 to 5.5 CLAY --			Drilling 0.0 to 5.5 8" auger Note Water measurements not taken. Overburden non-calcareous. Auger refusal at 5.5'
			0.0 to 4.0 medium plasticity, dark brown, stiff to very stiff, slightly moist			
			4.0 to 5.5 becomes light brown, moist			
			5.5 LIMESTONE --			
			hard (rock classification), well cemented, light gray, massive			
			T. D. @ 5.5			

DRILLING LOG		VISION	INSTALLATION	WELL NO.	SHEET	
PROJECT		Southwestern	Part North District	8165-01	OF 3 SHEETS	
1. PROJECT		Aubrey Lyle	8 1/2" x 11" 5" CORE			
2. LOCATION (Coordinates or Station)						
3. DRILLING AGENCY						
4. HOLE NO. (As shown on drilling permit and file number)		8165-01				
5. NAME OF DRILLER						
6. DIRECTION OF HOLE		VERTICAL				
7. THICKNESS OF OVERBURDEN		4.0'				
8. DEPTH DRILLED INTO ROCK		82.0'				
9. TOTAL DEPTH OF HOLE		86.0'				
ELEVATION	DEPTH	LEGEND	CLASSIFICATION OF MATERIALS (Description)	LOG RECORD NO.	LOG OR SAMPLE NO.	REMARKS (Drilling time, water loss, depth of weathering, etc., if significant)
	0.0'		0.0' to 4.0'		Jar A	Drilling
	4.0'		4.0' to 33.5'		Jar sample	0.0' to 9.0' 8" auger 9.0' to 26.0' 6" core 9.0' to 17.0' 8" casing
	16.3'		16.3' to 24.5'		Carbon samples	A. 0.0' to 4.0'
	24.5'		24.5' to 27.3'		Note	Depth of weathering at 55.0'. Hole was electrilogged. Not
	27.3'		27.3' to 29.0'		*Water level	Four inch slotted plastic pipe was set to 49.
	33.5'		33.5' to 43.8'			
	43.8'		43.8' to 45.3'			
	45.3'		45.3' to 48.8'			
	48.8'		48.8' to 51.7'			
	51.7'		51.7' to 52.6'			
	52.6'		52.6' to 56.4'			
	56.4'		56.4' to 57.3'			
	57.3'		57.3' to 61.6'			
	61.6'		61.6' to 62.6'			
	62.6'		62.6' to 65.4'			
	65.4'		65.4' to 72.7'			
	72.7'		72.7' to 73.6'			
	73.6'		73.6' to 77.8'			
	77.8'		77.8' to 79.9'			
	79.9'		79.9' to 80.9'			
	80.9'		80.9' to 81.8'			
	81.8'		81.8' to 82.6'			
	82.6'		82.6' to 85.1'			
	85.1'		85.1' to 86.0'			

DRILLING LOG		VISION	INSTALLATION	WELL NO.	SHEET	
PROJECT		SSD	Part North District	8165-01	OF 3 SHEETS	
1. PROJECT		Aubrey Lyle	8 1/2" x 11" 5" CORE			
2. LOCATION (Coordinates or Station)						
3. DRILLING AGENCY						
4. HOLE NO. (As shown on drilling permit and file number)		8165-02				
5. NAME OF DRILLER						
6. DIRECTION OF HOLE		VERTICAL				
7. THICKNESS OF OVERBURDEN						
8. DEPTH DRILLED INTO ROCK						
9. TOTAL DEPTH OF HOLE						
ELEVATION	DEPTH	LEGEND	CLASSIFICATION OF MATERIALS (Description)	LOG RECORD NO.	LOG OR SAMPLE NO.	REMARKS (Drilling time, water loss, depth of weathering, etc., if significant)
	0.0'		0.0' to 4.0'			occasional pockets of tan sand; with numerous short, irregular, tight, iron-stained yellow-brown joints, some of which open upon handling.
	4.0'		4.0' to 33.5'			32.5' to 34.8' black, iron-stained, high angle, tight joint
	33.5'		33.5' to 44.4'			44.4' to 46.8' badly jointed and very sandy; completely broken up with handling
	44.4'		44.4' to 48.0'			48.0' to 48.3' ironstone, red, soft
	48.0'		48.0' to 55.0'			55.0' to 65.4'
	55.0'		55.0' to 58.3'			SCALE --
	58.3'		58.3' to 65.4'			48.3' to 55.0' tan and light gray, slightly weathered, massive, calcareous
	65.4'		65.4' to 72.7'			72.7' to 78.6' well cemented with occasional lenses of shale, light gray
	72.7'		72.7' to 78.6'			78.6' to 79.2' transition with unit below
	78.6'		78.6' to 79.2'			79.2' to
	79.2'		79.2' to 80.7'			SHALE --
	80.7'		80.7' to 81.7'			dark gray, non-calcareous, thin-bedded, non-fractured, non-jointed, with numerous sandy lenses and lenses of fine, poorly cemented, thin-bedded to cross-bedded sandstone; contains scattered shale which tend to be concentrated along bedding planes
	81.7'		81.7' to 82.0'			sandstone at 80.7' to 81.0'
	82.0'		82.0' to 82.3'			81.7' to 82.0'; 82.3' to 85.7' to 86.0'
	82.3'		82.3' to 85.2'			siltstone, brownish-gray, well cemented at 79.6'
	85.2'		85.2' to 86.0'			85.2'

INSTALLATION	FWD	SHEET 2 OF 3 SHEETS
10 SIZE AND TYPE OF BIT	6" auger	
11 DATE FOR ELEVATION INFORMATION (If any)		
12 MANUFACTURER'S DESIGNATION OF DRILL		
13 TOTAL NO. OF OVERBURDEN SAMPLES TAKEN	Disturbed	Undisturbed
14 TOTAL NUMBER CORE BOXES		
15 ELEVATION GROUND WATER		
16 DATE HOLE STARTED	Completed	
17 ELEVATION TOP OF HOLE		
18 TOTAL CORE RECOVERY FOR BORING		
19 SIGNATURE OF INSPECTOR		

DESCRIPTION OF MATERIALS (Including lithology)	DEPTH (Feet)	BOX OR SAMPLE NO.	REMARKS (Including lithology, color, etc., if significant)
1 pockets of tan, numerous short, tight, iron-stained joints, none open upon handling	41.0	7	
34.8' black, iron, high angle, tight	45.0	8	
46.8' badly jointed sandy; completely with handling	49.0	9	
48.3' ironstone, .4'	53.0	10	
55.0' tan and y, slightly weathered, calcareous	57.0	11	
65.4' light gray weathered, thin, calcareous; fossiliferous in	61.0	12	
72.7' gradational unit, light gray, with numerous gray shale; reddish cemented	68.3	13	
78.6' well cemented, occasional lenses of gray	74.3	14	
79.2' transitional below	78.6	15	
80.7' to 81.0'	83.3	16	
82.0' to 82.6'	85.0	17	
86.0' brownish-gray, bedded at 79.6'			

DRILLING DIVISION	So. Western	INSTALLATION	Fort Worth District	SHEET 1 OF 2 SHEETS
PROJECT	Aubrey Lake	10 SIZE AND TYPE OF BIT	6" auger	
LOCATION (Company or Station)	Com's business	11 DATE FOR ELEVATION INFORMATION (If any)		
DRILLING AGENCY	Mullins	12 MANUFACTURER'S DESIGNATION OF DRILL	Pulling 1500	
13 TOTAL NO. OF OVERBURDEN SAMPLES TAKEN	Disturbed	14 TOTAL NUMBER CORE BOXES	12	
15 ELEVATION GROUND WATER		16 DATE HOLE STARTED	Completed	
17 ELEVATION TOP OF HOLE		18 TOTAL CORE RECOVERY FOR BORING	100%	
19 SIGNATURE OF INSPECTOR		20 SIGNATURE OF INSPECTOR		

ELEVATION	DEPTH	LEGEND	CLASSIFICATION OF MATERIALS (Description)	BOX OR SAMPLE NO.	REMARKS (Including lithology, color, etc., if significant)
0.0'	3.5'		SAND - -	Jar A	Drilling 0.0' to 7.0' 8" auger
3.5'	25.6'		tan, loose, moist, fine to medium, silty, non-calcareous	B	7.0' to 67.0' 6" core
3.5'	25.6'		SAND (primary) - -	Jar samples	0.0' to 6.0' 8" casing
3.5'	6.0'		brown, non-cemented, non-calcareous, firm to medium, slightly clayey, very moist, with numerous ironstone concretions (to 6"), easy to auger	Box 1	1. 7.0' to 7.9'
6.0'	8.6'		reddish-brown, poorly cemented, with concretions, very difficult to auger	2	2. 12.3' to 13.2'
8.6'	14.2'		reddish-brown, non-cemented, massive, very moist, non-calcareous, with scattered small ironstone concretions, carbonaceous inclusions, and decayed roots	3	3. 16.0' to 16.8'
14.2'	25.6'		becomes light gray with reddish-brown and yellowish-brown clayey, with some carbonaceous matter and occasional thin veins of selenite	4	4. 18.0' to 18.9'
18.0'	19.8'		CLAY, predominantly gray, sandy, with pockets of yellowish-brown clayey sand	5	5. 27.7' to 28.6'
19.8'	25.6'		borderline clay, gray, massive with lenses of clayey sand and sandy clay	6	6. 32.1' to 33.0'
25.6'	45.0'		SHALE - -	7	7. 34.7' to 35.6'
25.6'	26.7'		dark purple, sandy, massive, with ironstone nodules	8	8. 41.4' to 42.3'
26.7'	28.6'		light gray and gray, slightly weathered, approximately 4.0 on hand	9	9. 48.1' to 49.0'
				10	10. 54.0' to 54.9'
				11	11. 58.3' to 59.2'
				12	12. 65.6' to 66.5'

ELEVATION	DEPTH	LEGEND	CLASSIFICATION
0.0'	3.5'		penetrating
3.5'	25.6'		28.6' calcareous
3.5'	25.6'		33.0' calcareous
3.5'	25.6'		34.0' calcareous
3.5'	25.6'		42.8' calcareous
3.5'	25.6'		45.0' calcareous
3.5'	25.6'		45.0' calcareous
3.5'	25.6'		45.0' calcareous
3.5'	25.6'		51.3' calcareous
3.5'	25.6'		57.6' calcareous
3.5'	25.6'		57.6' calcareous
3.5'	25.6'		60.9' calcareous
3.5'	25.6'		61.5' calcareous
3.5'	25.6'		62.1' calcareous

Hole No. 8A6C-85

DIVISION So. Western	INSTALLATION Fort Worth District	SHEET 1 OF 2 SHEETS
10 SIZE AND TYPE OF BIT OR AUGER FOR CORE		
11 DISTANCE FOR ELEVATION INDICATED ON HOLE		
12 MANUFACTURER'S DESIGNATION OF DRILL		
13 TOTAL NO. OF OVERBURDEN SAMPLES TAKEN		
14 TOTAL NUMBER CORE BOXES		
15 ELEVATION GROUND WATER		
16 DATE HOLE STARTED		
17 ELEVATION TOP OF HOLE		
18 TOTAL CORE RECOVERY FOR BORING		
19 SIGNATURE OF INSPECTOR		

TR	LEGEND	CLASSIFICATION OF MATERIALS (Description)	SCORE RECOVERY (%)	BOX NO.	REMARKS (Depth from, water level, etc.)
		0.0' to 3.5'		Jar A	Drilling
		SAND -- tan, loose, moist, fine to medium, silty, non-calcareous		B	0.0' to 7.0' 8" auger 7.0' to 67.0' 6" core 0.0' to 6.0' 8" casing
		3.5' to 25.6'		Jar B	Jar samples
		SAND (primary) -- 3.5' to 6.0' brown, non-cemented, non-calcareous, fine to medium, slightly clayey, very moist, with numerous ironstone concretions (to 6"), easy to auger		7.0	A. 0.0' to 3.5' B. 3.5' to 6.0'
		6.0' to 8.6' reddish-brown, poorly cemented, with concretions, very difficult to auger		10.0	Carton samples
		8.6' to 14.2' reddish-brown, non-cemented, massive, very moist, non-calcareous, with scattered small ironstone concretions, carbonaceous inclusions, and decayed roots		11.6	1. 7.0' to 7.9' 2. 12.3' to 13.2' 3. 16.0' to 16.8' 4. 18.0' to 18.9' 5. 27.7' to 28.6' 6. 32.1' to 33.0' 7. 34.7' to 35.6' 8. 41.4' to 42.3' 9. 48.1' to 49.0' 10. 54.0' to 54.9' 11. 58.3' to 59.2' 12. 65.6' to 66.5'
		14.2' to 25.6' becomes light gray with reddish-brown and yellowish-brown clayey, with some carbonaceous matter and occasional thin veins of selenite		14.2	Note Depth of weathering at 33.7'
		18.0' to 19.8' CLAY, predominantly gray, sandy, with pockets of yellowish-brown clayey sand		17.7	Water level Hole was not bailed but left open for water level check.
		19.8' to 25.6' borderlime clay, gray, massive with lenses of clayey sand and sandy clay		23.1	
		25.6' to 45.0'		26.0	
		SHALE -- 25.6' to 26.7' dark purple, sandy, massive, with ironstone nodules		28.6	
		26.7' to 28.6' light gray and gray, slightly weathered, approximately 4.0 on hand		34.3	

ELEVATION	DEPTH	LEGEND	CLASSIFICATION OF MATERIALS (Description)	SCORE RECOVERY (%)	BOX NO.	REMARKS (Depth from, water level, etc.)
			penetrator, thin-bedded, non-calcareous, non-fractured, and non-jointed	41.7	7	
			28.6' to 33.7' becomes calcareous, 74.5 on hand penetrator	10	10	
			33.7' to 45.0' non-weathered, gray, very calcareous, silty, cemented, breccia along bedding planes, but bedding is not clearly apparent	00	8	
			34.0' to 34.2' rust-stained	17	50.3	
			42.8' to 45.0' with scattered fossils	53.0	9	
			45.0' to 57.6'	11	65.3	
			SHALE --	60.0	10	
			45.0' to 51.3' transitional with above unit, very argillaceous, with numerous lenses and partings of shale, gray, moderately well cemented, with numerous fossils from 50.8' to 51.2'	07	65.3	
			51.3' to 57.6' becomes light gray, well cemented, with numerous lenses of gray, argillaceous limestone	01	11	
			57.6' to 60.5'	67.0	11	
			SHALE -- dark gray, thin-bedded, non-fractured, non-jointed, calcareous on bedding planes to 59.0', non-calcareous from 59.0' to 70', scattered pockets of thin, thin bedded sand			
			60.5' to 60.9' SAND, thin-bedded, very fine			
			60.9' to 61.0' SILTSTONE			
			61.6' fossils on bedding plane			
			62.1' to 62.3' fossiliferous			

ENG FORM 1836 MAR 71 PREVIOUS EDITIONS ARE OBSOLETE
 ITRAVEL "EXT"
 AUTHORITY: L30
 HOLE NO. 8A6C-85

RECORD DRAWING - PUNK AS PULL

DESIGNED BY	RAY ROBERTS LAKE
DRAWN BY	ELM FORK, TRINITY RIVER, TEXAS
REVIEWED BY	EMBANKMENT, SPILLWAY AND OUTLET WORKS
APPROVED BY	LOGS OF BORINGS 8A6C-84 AND 8A6C-85
CONTRACT NO.	INVITATION NO. DAC#63-B2-B 0025 DATE MAR, 1962
DATE	CONTRACT NO. DAC#63-92 C 0010
DESCRIPTION OF REVISION	DATE

DRILLING LOG		INSTALLATION	
PROJECT: Southwestern		Port Worth District	
LOCATION: Aubrey Lake		SHEET 1 of 2	
Left Abutment		NO. AND TYPE OF BIT: 3 1/8" fishtail	
CORPS OF ENGINEERS		DATE: 15 Dec 74	
CORPS OF ENGINEERS		COMPLETED: 6 Jan 75	
HOLE NO. (See Uniform on Drawing) and Site Number: SP-06		TOTAL NO. OF OIL-BURDEN SAMPLES TAKEN: 0	
NAME OF DRILLER: Mullins		TOTAL NUMBER CORE BOXES: 0	
DIRECTION OF HOLE: <input checked="" type="checkbox"/> VERTICAL <input type="checkbox"/> INCLINED		ELEVATION AT GROUND WATER: 00	
THICKNESS OF OVERBURDEN: 0.0'		ELEVATION TOP OF HOLE: 0	
DEPTH DRILLED INTO ROCK: 140.0'		TOTAL CORE RECOVERY FOR BORING: 0	
TOTAL DEPTH OF HOLE: 140.0'		SIGNATURE OF INSPECTOR: Joseph A. Cherkov	

ELEVATION	DEPTH	LEGEND	CLASSIFICATION OF MATERIALS (Description)	CORE SECTION NO.	BOX OF SAMPLE NO.	REMARKS (Drilling time, water loss, depth of penetration, etc., if significant)
0.0'	0.0'		0.0' to 68.5'			Drilling 0.0' to 140.0' 3 1/8" fishtail Jar sample A. 45.0' (from split spoon; may be fall-in) *Offset Due to inaccessibility, hole was offset approximately 50' ESW from elevation 690.26' to elevation 674.8' (as measured by hand level). Packer lost in hole at 95.0', and hole was re-drilled 4.5' S at same elevation. Note Attempted unsuccessfully to obtain sand samples with shaly tube, split spoon, and BX core barrel. Hole was pressure tested and electric logged. Logging is by drilling action and cuttings.
			SAND - red, fine-grained			
			8.0' becomes firmer, possibly clayey			
			14.5' ironstone concretion			
			20.0' to 21.5' fairly hard, poorly cemented			

ELEVATION	DEPTH	LEGEND	CLASSIFICATION OF MATERIALS (Description)	CORE SECTION NO.	BOX OF SAMPLE NO.	REMARKS
68.5'	68.5'		68.5' to 101.3'			
			SHALE - gray, non-calcareous			
			73.8' to 74.1' harder			
			77.2' very hard			
			79.5' to 81.5' very hard			
			91.5' to 101.0' sandy, cuts very easily			
			101.0' to 101.3' very hard			
			101.3' to 115.0'			
			SHALE - gray, calcareous, cuts easily to 105.0'			
			108.8' very hard			
			115.0' to 132.8'			
			LIMESTONE			
			121.0' to 121.2' soft			
			121.0' to 132.8' becomes very hard			
			132.8' to 140.0'			
			SHALE - dark gray, non-calcareous			
			T. D. in shale @ 140.0'			

Well No. calyx hole

DRILLING LOG PROJECT Subrey Lake	DIVISION Southwestern	INSTALLATION Fort Worth District	SHEET 1 OF 2 SHEETS
1. PROJECT	2. LOCATION (Coordinates or Station)	3. MANUFACTURER'S DESIGNATION OF DRILL	4. HOLE NO. (As shown on drawing title and log number)
5. DRILLING AGENCY Corps of Engineers	6. DATE MOLE 3 Mar 75	7. TOTAL NO. OF OVERBURDEN SAMPLES TAKEN 0	8. TOTAL NUMBER CORE BOXES 0
9. NAME OF DRILLER Preyer	10. ELEVATION GROUND WATER 0	11. ELEVATION TOP OF HOLE STARTED 3 Mar 75 COMPLETED 3 Mar 75	12. TOTAL CORE RECOVERY FOR BORING 0
13. THICKNESS OF OVERBURDEN 45.0'	14. DEPTH DRILLED INTO ROCK 1.5'	15. TOTAL DEPTH OF HOLE 46.5'	16. SIGNATURE OF INSPECTOR <i>James A. Smith</i>

ELEVATION	DEPTH	LEGEND	CLASSIFICATION OF MATERIALS (Descriptive)	SCORE RECOVERY	BOX OR SAMPLE NO.	REMARKS (Drawing title, water level, depth of penetration, etc., if appropriate)
0.0' to 45.0'			CLAY - low to medium plasticity, dark brownish-gray, very stiff, moist, silty			Drilling 0.0' to 45.0' 42" auger casing Water level Boring was making water from between 20.0' and 21.0' to 45.0'. Hole tended to cave from 21.0' to 22.0'. Cylinder samples 1. 19.6' to 20.2' 2. 21.6' to 22.2'
45.0' to 46.5'			SHALE			19.6' to 35.0' becomes saturated, soft, very easy to auger 35.0' to 45.0' becomes very sandy with gravel and small bobbles in lower 1.5'

Well No. 8A6DC-90

DRILLING LOG PROJECT Ambrey Dam	DIVISION Southwestern	INSTALLATION Fort Worth District	SHEET 1 OF 1 SHEETS
1. PROJECT	2. LOCATION (Coordinates or Station) Tunnel Outlet Works	3. MANUFACTURER'S DESIGNATION OF DRILL Falling 1500	4. HOLE NO. (As shown on drawing title and log number) 8A6DC-90
5. DRILLING AGENCY Corps of Engineers	6. DATE MOLE 29 Jan 1976	7. TOTAL NO. OF OVERBURDEN SAMPLES TAKEN 1	8. TOTAL NUMBER CORE BOXES 5
9. NAME OF DRILLER Warehouse	10. ELEVATION GROUND WATER 0	11. ELEVATION TOP OF HOLE STARTED 29 Jan 1976 COMPLETED 30 Jan 1976	12. TOTAL CORE RECOVERY FOR BORING 100
13. THICKNESS OF OVERBURDEN 1.5'	14. DEPTH DRILLED INTO ROCK 28.5'	15. TOTAL DEPTH OF HOLE 30.0'	16. SIGNATURE OF INSPECTOR <i>James J. Popaw</i>

ELEVATION	DEPTH	LEGEND	CLASSIFICATION OF MATERIALS (Descriptive)	SCORE RECOVERY	BOX OR SAMPLE NO.	REMARKS (Drawing title, water level, depth of penetration, etc., if appropriate)
0.0' to 1.5'			SAND - fine to medium grained, brown, dry, clayey and limy.		A	1. Hole was bailed upon completion and perforated plastic pipe was installed for water level observation.
1.5' to 9.2'			LIMESTONE - fine to medium grained, tan to rust brown, highly weathered, medium hard.		No Sample	
9.2' to 30.0'			SHALE		Box 1	2. Drilling 8" auger to 2.5'; 7 1/8" tri-cone rock bit to 7.0'; 6" core to total depth
9.2' to 13.5'			tan to gray, silty, soft, weathered.		Box 2	3. Jars: A. 0.0' to 1.5' B. 1.5' to 2.5'
13.5' to 30.0'			dark gray, silty, horizontal bedding definition, soft, fossiliferous, non-calcareous except for fossils and fossil fragments. Light gray siltstone noted from 25.2' to 26.0'.		Box 3	4. Cartons: 1. 13.5' to 14.5' 2. 20.6' to 21.6' 3. 27.8' to 28.8'
30.0'					Box 4	5. Core Boxes: 1. 7.0' to 11.6' 2. 11.6' to 17.2' 3. 17.2' to 22.6' 4. 22.6' to 27.4' 5. 27.4' to 30.0'
30.0'			T. D. 30.0'		Box 5	

ENG FORM 1836 MAR 71 PREVIOUS EDITIONS ARE OBSOLETE
PROJECT Ambrey Dam HOLE NO. 8A6DC-90

RECORD DRAWING-WORK AS BUILT

DESIGNED BY:	RAY ROBERTS LAKE		
DRAWN BY:	ELM FORK, TRINITY RIVER, TEXAS		
REVIEWED BY:	EMBANKMENT, SPILLWAY AND OUTLET WORKS		
SUBMITTED BY:	LOGS OF BORINGS		
ENGINEER:	3SF-86, CALYX HOLE AND 8A6DC-90		
INVITATION NO. DACW63-82-C-0025	DATE	MAR, 1982	
CONTRACT NO. DACW63-72-C-0083	SHEET NO.	31	

CONTRACT NO. DACW63-82-C-0083

Hole No. 8167C-02

Hole No. 816C-01

DRILLING LOG	Southwestern	INSTALLATION	Port North
PROJECT	Aubrey Dam	NO. SIZE AND TYPE OF BIT	8" Auger; 6" Core
LOCATION (County or Township)	Normal Outlet Works	DATE FOR ELEVATION DETERMINATION	
DRILLING AGENCY	Corps of Engineers	MANUFACTURER'S DESIGNATION OF DRILL	Falling 1500
HOLE NO. (As shown on drawing and 175 number)	8167C-02	TOTAL NO. OF CORE BURDEN SAMPLES TAKEN	7
NAME OF DRILLER	Neponawg	TOTAL NUMBER CORE BOXES	2
DIRECTION OF HOLE	Vertical	DATE HOLE STARTED	19 Jan 1976
THICKNESS OF OVERBURDEN	15.2'	DATE HOLE COMPLETED	20 Jan 1976
DEPTH DRILLED INTO ROCK	10.3'	TOTAL CORE RECOVERY FOR BOXES	100%
TOTAL DEPTH OF HOLE	25.5'	SIGNATURE OF INSPECTOR	<i>James D. Logan</i>

DRILLING LOG	Southwestern	INSTALLATION	Port North
PROJECT	Aubrey Lake	NO. SIZE AND TYPE OF BIT	8" Auger; 6" Core
LOCATION (County or Township)	Soilway Site #2	DATE FOR ELEVATION DETERMINATION	
DRILLING AGENCY	Corps of Engineers	MANUFACTURER'S DESIGNATION OF DRILL	Falling 1500
HOLE NO. (As shown on drawing and 175 number)	816C-01	TOTAL NO. OF CORE BURDEN SAMPLES TAKEN	2
NAME OF DRILLER	Schooner	TOTAL NUMBER CORE BOXES	2
DIRECTION OF HOLE	Vertical	DATE HOLE STARTED	21 Nov 1975
THICKNESS OF OVERBURDEN	7.0'	DATE HOLE COMPLETED	21 Nov 1975
DEPTH DRILLED INTO ROCK	15.0'	TOTAL CORE RECOVERY FOR BOXES	100%
TOTAL DEPTH OF HOLE	20.0'	SIGNATURE OF INSPECTOR	<i>James D. Logan</i>

ELEVATION	DEPTH	LEGEND	CLASSIFICATION OF MATERIALS (Description)	NO. CORE RECOVERY	BOX OR SAMPLE NO.	REMARKS (Drilling time, water flow, depth of penetration, etc., if significant)
0.0'	15.2'		CLAY AND SAND - clay dominates overburden with sand noted only at 6.0'. Clay from 0.0' to 2.0' light reddish brown, stiff, silty, sandy, medium to low plasticity, slightly moist; becoming dry, finely sandy, light rust brown at 4.0'. Sand at 6.0' fine grained, brown, clayey with scattered fine gravel. Clay was noted below and to 15.2'; reddish brown, some gray, medium to low plasticity, medium to stiff, moist, non-calcareous.			1. Hole was bailed upon completion and perforated plastic pipe installed for water level observation.
15.2'	17.2'		SHALE - tan soft, silty, calcareous.			2. Drilling: 8" auger to 2.0'; Denison barrel to 17.0'; 6" core to 25.5'.
17.2'	25.5'		LIMESTONE - gray, soft to medium hard to hard, fine to medium grained, argillaceous, fossiliferous.			3. Jars: A. At 0.0' to 2.0' B. At 4.0' C. At 6.0' D. At 8.0' E. At 11.0' F. At 13.0' G. At 15.0' H. At 17.0'
						4. Denison Cans: 1. 2.0' to 4.0' 2. 4.0' to 6.0' 3. 6.0' to 8.0' 4. 9.0' to 11.0' 5. 11.0' to 13.0' 6. 13.0' to 15.0' 7. 15.0' to 17.0'
						5. Cartons: 1. 18.7' to 19.7' 2. 23.3' to 24.2'
						6. Core Boxes: 1. 17.0' to 21.5' 2. 21.5' to 25.5'

ELEVATION	DEPTH	LEGEND	CLASSIFICATION OF MATERIALS (Description)	NO. CORE RECOVERY	BOX OR SAMPLE NO.	REMARKS (Drilling time, water flow, depth of penetration, etc., if significant)
0.0'	2.0'		CLAY - as described in interval below.			1. Hole was bailed to near total depth upon completion. 4" plastic pipe, slotted, was installed in boring for future water level observations.
2.0'	7.0'		CLAY			2. Drilling: 8" auger to 7.0'; 6" core to total depth of 20.0'.
7.0'	13.9'		2.0' to 5.0' - medium plasticity, brown, hard, silty to finely sandy, slightly moist, non-calcareous.			3. Jars: A. 2.0' to 5.0' B. 5.0' to 7.0'
13.9'	20.0'		5.0' to 7.0' - as above interval, slightly lighter in color, some very fine gravel widely scattered throughout.			4. Cartons: 1. 7.5' to 8.5' 2. 11.5' to 12.5' 3. 16.7' to 17.6' 4. 19.0' to 20.0'
			7.0' to 13.9' - CLAY-SHALE - soft, rust brown and gray, silty, highly weathered, non-calcareous, occasional very fine gravel scattered throughout recovery.			5. Core Boxes: 1. 7.0' to 13.4' 2. 13.4' to 20.0'
			13.9' to 20.0' - SHALE - tan with some gray marbling, soft, occasional soft white lily inclusions. Shale is non-calcareous and weathered to total depth. Sand lenses noted from 13.5' to 13.9'; fine grained, rust brown. Iron concretionary zone noted from 14.9' to 15.1'.			

Hole No. 8A6C-301
 SHEET 1 of 1 SHEETS
DRILLING LOG *Southwestern* **INSTALLATION** *Fort Worth*
PROJECT *Aubrey Lake*
LOCATION *Spillway Site #2*
DATE *Falling 1950*
DRILLING AGENCY *Corps of Engineers*
LOG NUMBER *8A6C-301*
TYPE OF DRILLER *Schoonover*
SECTION OF HOLE *Vertical*
THICKNESS OF OVERBURDEN *7.0'*
DEPTH DRILLED INTO ROCK *13.0'*
TOTAL DEPTH OF HOLE *20.0'*

DEPTH	LEGEND	CLASSIFICATION OF MATERIALS (Description)	LOG RECORD	BOX OR SAMPLE NO.	REMARKS
0.0' to 2.0'		CLAY - as described in interval below.		Sample	1. Hole was bailed to near total depth upon completion. 4" plastic pipe, slotted, was installed in boring for future water level observations. 2. Drilling: 8" auger to 7.0'; 6" core to total depth of 20.0'. 3. JARS: A. 2.0' to 5.0' B. 5.0' to 7.0' 4. CARBONS: 1. 7.5' to 8.5' 2. 11.5' to 12.5' 3. 16.7' to 17.6' 4. 19.0' to 20.0' 5. Core Boxes: 1. 7.0' to 13.4' 2. 13.4' to 20.0'
2.0' to 7.0'		CLAY 2.0' to 5.0' - medium plasticity, brown, hard, silty to finely sandy, slightly moist, non-calcareous.		A	
5.0' to 7.0'		5.0' to 7.0' - as above interval, slightly lighter in color, some very fine gravel widely scattered throughout.	L 0.1'	Box 1	
7.0' to 13.9'		CLAY-SHALE - soft, rust brown and gray, silty, highly weathered, non-calcareous, occasional very fine gravel scattered throughout recovery.	L 0.1'		
13.9' to 20.0'		SHALE - tan with some gray marbling, soft, occasional soft white clay inclusions. Shale is non-calcareous and weathered to total depth. Sand lense noted from 13.5' to 13.9'; fine grained, rust brown. Iron concretionary zone noted from 14.9' to 15.1'.	G 0.6'		
7.0' to 20.0'					

ENG FORM 1836 PREVIOUS EDITIONS ARE OBSOLETE.
 PROJECT *Aubrey Lake* HOLE NO. *8A6C-301*

Hole No. 8A6C-302
 SHEET 1 of 1 SHEETS
DRILLING LOG *Southwestern* **INSTALLATION** *Fort Worth*
PROJECT *Aubrey Lake*
LOCATION *Spillway Site #2*
DATE *Falling 1950*
DRILLING AGENCY *Corps of Engineers*
LOG NUMBER *8A6C-302*
TYPE OF DRILLER *Schoonover*
SECTION OF HOLE *Vertical*
THICKNESS OF OVERBURDEN *6.5'*
DEPTH DRILLED INTO ROCK *19.4'*
TOTAL DEPTH OF HOLE *25.9'*

DEPTH	LEGEND	CLASSIFICATION OF MATERIALS (Description)	LOG RECORD	BOX OR SAMPLE NO.	REMARKS
0.0' to 2.0'		CLAY - as described in interval below.		Sample	1. Installed slotted plastic pipe after bailing to near T. 2. Drilling: 6" auger to 8.0'; 6" core to total depth of 25.9'. 3. JARS: A. 2.0' to 4.0' B. 4.0' to 6.5' C. 6.5' to 8.0' D. 13.0' to 14.0' 4. CARBONS: 1. 8.0' to 9.0' 2. 14.0' to 15.0' 3. 20.1' to 21.1' 4. 24.7' to 25.5' 5. Core Box 2: 1. 8.0' to 15.0' 2. 15.3' to 15.0' 3. 19.8' to 25.5' 6. Actual bottom of 0.9' from 13.1' to 14.0' - 20 po. r.v. gravel 17.7' to 19.5' 2". Corrosive sample D.
2.0' to 6.5'		CLAY 2.0' to 4.0' - medium plasticity, brown, hard, silty to finely sandy, slightly moist, non-calcareous.		A	
4.0' to 6.5'		4.0' to 6.5' - as above interval; light brown.		B	
6.5' to 13.0'		CLAY-SHALE - soft, rust brown and gray, silty, highly weathered, non-calcareous, occasional fine gravel scattered throughout recovery; appears to be reworked shale. Core becoming calcareous at 12.0'.	L 0.0'	Box 1	
13.0' to 14.0'		SHALE - purpl. grad'd up to 2", clay to shaly matrix, angular to sub-angular, calcareous, easy to penetrate with core bit. (Labels in Jar D).	L 0.3'	Box 2	
14.0' to 25.9'		SHALES - tan with some gray marbling, soft, occasional soft white clay inclusions. Occasional mill pockets of rust brown silt. Shale is non-calcareous and weathered to total depth.	L 0.0'	Box 3	
7.0' to 25.9'					

ENG FORM 1836 PREVIOUS EDITIONS ARE OBSOLETE.
 PROJECT *Aubrey Lake* HOLE NO. *8A6C-302*

RECORD DRAWING - WORK AS FULL

U S ARMY ENGINEER DISTRICT, FORT WORTH
 CORPS OF ENGINEERS
 404 404th, TEXAS
 DESIGNED BY: **RAY ROBERTS LAKE**
 DRAWN BY: **ELM FORK, TRINITY RIVER, TEXAS**
 CHECKED BY: **EMBANKMENT, SPILLWAY AND**
OUTLET WORKS
LOGS OF BORINGS
8A6C-91, 8A6DC-92, 8A6C-301, AND 8A6C-302
 INVITATION NO. *DISC#53-82 B. 0010* DATE *MAR, 1982*
 CONTRACT NO. *DISC#63-54*
 DRAWING NUMBER: _____ SHEET NO. **37**

DRILLING LOG		DIVISION		INSTALLATION	
PROJECT: Southwestern		Southwestern		Southwestern	
LOCATION: Auburn Lake Spillway Site #2		Auburn Lake Spillway Site #2		Auburn Lake Spillway Site #2	
DRILLING AGENCY: Corps of Engineers		Corps of Engineers		Corps of Engineers	
HOLE NO. AND DATE: 816C-303		816C-303		816C-303	
NAME OF DRILLER: Schoonover		Schoonover		Schoonover	
DIRECTION OF HOLE: <input checked="" type="checkbox"/> VERTICAL <input type="checkbox"/> INCLINED		<input checked="" type="checkbox"/> VERTICAL <input type="checkbox"/> INCLINED		<input checked="" type="checkbox"/> VERTICAL <input type="checkbox"/> INCLINED	
THICKNESS OF OVERBURDEN: 11.0'		2.0'		2.0'	
DEPTH DRILLED INTO ROCK: 40.0'		49.0'		49.0'	
TOTAL DEPTH OF HOLE: 51.0'		51.0'		51.0'	
ELEVATION	DEPTH	LEGEND	CLASSIFICATION OF MATERIALS (Description)	REMARKS	REMARKS
10.0'	0.0'	1	CLAY 0.0' to 7.0' - medium plasticity, brown, hard, silty to finely sandy, slightly moist, non-calcareous. 7.0' to 11.0' - as above interval; more moist.	No Sample A	1. Hole was bailed to near total depth upon completion. Unable to determine where hole is making water, but sacking water slowly. Installed slotted plastic pipe for water level observations. Water Levels: 26 Nov. '75 - 17.0' 1 Dec. '75 - 16.5'
10.0'	11.0'	1	CLAY-SHALE - rust brown, marbled gray, soft, non-calcareous; appears to be reworked shale; scattered ferrous nodules; very gravelly and calcareous from 18.3' to 19.3' with very fine grained light rust brown sand from 19.3' to 19.6'.	B	
20.0'	22.0'	2	SHALE 22.0' to 40.7' - light tan to grayish tan, soft, non-calcareous, bedding angle approximately 5° from horizontal, occasional ferrous nodule with distinct iron concretionary zone from 26.3' to 26.8'; very fine grained light rust brown sandstone from 35.8' to 36.0' and from 37.4' to 37.7'; approaching base of extensive weathering from 38.0' to 40.7' as evidenced by intermittent short intervals of light bluish-gray shale.	L 1.0 Box 1 G 0.8 L 0.8 Box 2 L 0.0 Box 3	2. Drilling 8" auger to 11.0', 6" core to total depth of 51.0'. Set 3.0' of 8" casing due to fluid loss near surface. 3. Jars: A. 2.0' to 7.0' B. 7.0' to 11.0' 4. Cartons: 1. 11.3' to 12.2' 2. 16.0' to 17.0' 3. 22.1' to 23.1' 4. 28.5' to 29.5' 5. 35.1' to 35.8' 6. 39.7' to 40.7' 7. 45.3' to 46.2' 8. 49.7' to 50.7' 5. Core Boxes: 1. 11.0' to 17.5' 2. 17.5' to 23.5' 3. 23.5' to 28.3' 4. 28.3' to 33.9' 5. 33.9' to 39.0' 6. 39.0' to 44.3' 7. 44.3' to 50.7'
30.0'	40.7'	4	40.7' to 50.7' - shale is light bluish-gray, soft, slightly silty, very fossiliferous (numerous fossils along parting at 44.3' and in Carton No. 8 at 49.7'); bedding is near horizontal; shale is calcareous from 40.7' to recovery depth of 50.7'.	L 0.0 Box 4 G 0.8 Box 5 L 0.0 Box 6 L 0.7 Box 7 G 0.4	
50.0'	51.0'	5			

DRILLING LOG		DIVISION		INSTALLATION	
PROJECT: Auburn Lake Spillway Site #2		Southwestern		Southwestern	
DRILLING AGENCY: Corps of Engineers		Corps of Engineers		Corps of Engineers	
HOLE NO. AND DATE: 816C-304		816C-304		816C-304	
NAME OF DRILLER: Schoonover		Schoonover		Schoonover	
DIRECTION OF HOLE: <input checked="" type="checkbox"/> VERTICAL <input type="checkbox"/> INCLINED		<input checked="" type="checkbox"/> VERTICAL <input type="checkbox"/> INCLINED		<input checked="" type="checkbox"/> VERTICAL <input type="checkbox"/> INCLINED	
THICKNESS OF OVERBURDEN: 2.0'		2.0'		2.0'	
DEPTH DRILLED INTO ROCK: 49.0'		49.0'		49.0'	
TOTAL DEPTH OF HOLE: 51.0'		51.0'		51.0'	
ELEVATION	DEPTH	LEGEND	CLASSIFICATION OF MATERIALS (Description)	REMARKS	REMARKS
10.0'	0.0'	1	CLAY - medium plasticity, brown, hard, silty to finely sandy, slightly moist, non-calcareous.		
10.0'	2.0'	1	CLAY-SHALE 2.0' to 7.0' - rust brown soft, non-calcareous; appears to be reworked shale; more moist from 4.0' to 7.0'. 7.0' to 13.7' - as described above with some gray marbling and scattered ferrous nodules.	L 0.6' G 0.2'	
20.0'	13.7'	2	SANDSTONE - very fine grained, light rust brown, soft, well consolidated, non-calcareous.		
20.0'	14.0'	3	SHALE - light tan to grayish tan, soft, silty, non-calcareous.	L 0.0'	
20.0'	17.0'	3	SHALE - as described above.		
20.0'	17.5'	4	SANDSTONE - as described in interval 13.7' to 14.0'.	L 0.0'	
20.0'	17.6'	4	SHALE - as described above.		
20.0'	19.8'	5	SANDSTONE - as described above.	L 0.1'	
20.0'	20.2'	5	SHALE - as described above.		
20.0'	20.6'	6	SANDSTONE - as described above with approximately 5° from horizontal bedding angle.	C 0.5'	
20.0'	22.8'	6	SHALE - as described above, approaching base of extensive weathering from 26.7' to 32.7' as evidenced by intermittent thin beds of bluish gray shale.	L 0.9'	
20.0'	26.7'	7	Distinct iron concretionary zone was noted from 26.7' to 29.2'. Shale becoming calcareous below 24.7'.	C 0.5'	
20.0'	32.7'	8	SHALE - unweathered, soft, bluish gray, varies from waxy to silty to very finely sandy, fossiliferous, calcareous.	L 0.0'	
50.0'	51.0'	9			

Male No. BAC-305

Southwestern	INSTALLATION	Port Worth	SHEET 1 OF 1 SHEETS
10. SITE AND TYPE OF BIT	10. SITE AND TYPE OF BIT	8" Auger; 6" Core	
11. DATE FOR ELEVATION INFORMATION	11. DATE FOR ELEVATION INFORMATION	8 Aug 1975	
12. MANUFACTURER'S DESIGNATION OF DRILL	12. MANUFACTURER'S DESIGNATION OF DRILL	Palling 1500	
13. TOTAL NO. OF OVERBURDEN SAMPLES TAKEN	13. TOTAL NO. OF OVERBURDEN SAMPLES TAKEN	0	
14. TOTAL NUMBER CORE BOXES	14. TOTAL NUMBER CORE BOXES	8	
15. ELEVATION GROUND WATER	15. ELEVATION GROUND WATER	80	
16. DATE MOLE	16. DATE MOLE	1 Dec. 1975	
17. ELEVATION TOP OF MOLE	17. ELEVATION TOP OF MOLE	100	
18. TOTAL CORE RECOVERY FOR BORING	18. TOTAL CORE RECOVERY FOR BORING	100	
19. SIGNATURE OF INSPECTOR	19. SIGNATURE OF INSPECTOR	<i>James T. Logan</i>	

CLASSIFICATION OF MATERIALS (Description)	ELEVATION	DEPTH	LEGEND
CLAY - medium plasticity, brown, hard, silty to finely sandy, slightly moist, non-calcareous.	0.0' to 2.0'	0.0'	1
CLAY-SHALE	2.0' to 7.0'	2.0'	2
CLAY-SHALE - rust brown, soft, non-calcareous; appears to be reworked shale; more moist from 4.0' to 7.0'.	2.0' to 7.0'	2.0'	2
CLAY-SHALE - as described above with some gray marbling and scattered ferrous nodules.	7.0' to 13.7'	7.0'	2
SANDSTONE - very fine grained, light rust brown, soft, well consolidated, non-calcareous.	13.7' to 14.0'	13.7'	3
CLAY-SHALE - as described above.	14.0' to 17.6'	14.0'	2
SANDSTONE - as described in interval 13.7' to 14.0'.	14.0' to 17.6'	14.0'	3
CLAY-SHALE - as described above.	17.6' to 19.8'	17.6'	2
SANDSTONE - as described above.	19.8' to 20.2'	19.8'	3
CLAY-SHALE - as described above.	20.2' to 20.6'	20.2'	2
SANDSTONE - as described above with approximately 9° from horizontal bedding angle.	20.6' to 22.8'	20.6'	3
CLAY-SHALE - as described above, approaching base of extensive weathering from 25.7' to 32.7' as evidenced by intermittent thin beds of bluish gray distinct iron concretionary zones was noted from 7' to 29.2'. Shale coating calcareous below 7'.	22.8' to 31.0'	22.8'	2
CLAY-SHALE - unweathered, soft, with gray, varies from silty to very fine sandy, fossiliferous, calcareous.	31.0' to 51.0'	31.0'	2

REMARKS:
 1. Hole was bailed to near total depth upon completion. Water level 24 hours after completion at 16.0'. Hole was backfilled.
 2. Drilling: 8" auger to 7.0'; 6" core to total depth of 51.0'.
 3. Jars:
 A. 2.0' to 4.0'
 B. 4.0' to 7.0'
 4. Cartons:
 1. 7.5' to 8.5'
 2. 12.5' to 15.5'
 3. 17.8' to 24.4'
 4. 23.4' to 28.7'
 5. 27.6' to 32.0'
 6. 31.0' to 32.0'
 7. 39.5' to 45.5'
 8. 45.5' to 46.5'
 9. 50.0' to 51.0'
 5. Core Boxes:
 1. 7.0' to 12.5'
 2. 12.5' to 18.9'
 3. 18.9' to 24.7'
 4. 24.7' to 30.3'
 5. 30.3' to 36.0'
 6. 36.0' to 41.7'
 7. 41.7' to 47.3'
 8. 47.3' to 51.0'

Male No. BAC-305

Southwestern	INSTALLATION	Port Worth	SHEET 1 OF 1 SHEETS
10. SITE AND TYPE OF BIT	10. SITE AND TYPE OF BIT	8" Auger; 6" Core	
11. DATE FOR ELEVATION INFORMATION	11. DATE FOR ELEVATION INFORMATION	8 Aug 1975	
12. MANUFACTURER'S DESIGNATION OF DRILL	12. MANUFACTURER'S DESIGNATION OF DRILL	Palling 1500	
13. TOTAL NO. OF OVERBURDEN SAMPLES TAKEN	13. TOTAL NO. OF OVERBURDEN SAMPLES TAKEN	2	
14. TOTAL NUMBER CORE BOXES	14. TOTAL NUMBER CORE BOXES	4	
15. ELEVATION GROUND WATER	15. ELEVATION GROUND WATER	80	
16. DATE MOLE	16. DATE MOLE	3 Dec. 1975	
17. ELEVATION TOP OF MOLE	17. ELEVATION TOP OF MOLE	100	
18. TOTAL CORE RECOVERY FOR BORING	18. TOTAL CORE RECOVERY FOR BORING	100	
19. SIGNATURE OF INSPECTOR	19. SIGNATURE OF INSPECTOR	<i>James T. Logan</i>	

CLASSIFICATION OF MATERIALS (Description)	ELEVATION	DEPTH	LEGEND
CLAY	0.0' to 6.0'	0.0'	1
CLAY - medium plasticity, hard, silty to finely sandy, brown, slightly moist, non-calcareous.	0.0' to 2.0'	0.0'	1
CLAY - as above interval; slightly calcareous.	2.0' to 4.0'	2.0'	1
CLAY - yellowish brown, medium plasticity, stiff, silty, finely sandy, some scattered fine gravel, moist, non-calcareous.	4.0' to 6.0'	4.0'	1
CLAY-SHALE - rust brown, soft, some gray mixed, scattered gravel and ferrous nodules, non-calcareous.	6.0' to 12.0'	6.0'	2
SHALE AND SANDSTONE - shale is dominant; light tan to grayish tan, silty, non-calcareous. Shale is interrupted with occasional thin beds of sandstones, notably from 14.5' to 17.3'; sandstone is light rust brown, very fine grained, soft and non-calcareous. Maximum thickness without shale interruption was 1.0' (Carton No. 3 from 14.5' to 15.5'). Shale was dominant from 17.3' to 20.7'. Last sandstone in this boring was logged from 20.7' to 21.0'.	12.0' to 21.0'	12.0'	2
SHALE - soft, light tan to grayish tan, silty, some very widely scattered calcite; iron concretionary zone, very calcareous noted from 27.4' to 29.9'. Shale is silty calcareous from this point to total depth and is weathered throughout.	21.0' to 30.0'	21.0'	2

REMARKS:
 1. Hole was bailed to near total depth upon completion and slotted plastic pipe installed for water level observation. Water level after 24 hours at 10.9'.
 2. Drilling: 8" auger to 7.0'; 6" core to total depth of 30.0'.
 3. Jars:
 A. 2.0' to 4.0'
 B. 4.0' to 6.0'
 C. 6.0' to 7.0'
 4. Cartons:
 1. 7.5' to 8.5'
 2. 12.9' to 13.9'
 3. 14.5' to 15.5'
 4. 21.0' to 22.0'
 5. 29.0' to 30.0'
 5. Core Boxes:
 1. 7.0' to 12.6'
 2. 12.6' to 19.2'
 3. 19.2' to 24.8'
 4. 24.8' to 30.0'

Male No. BAC-305

Southwestern	INSTALLATION	Port Worth	SHEET 1 OF 1 SHEETS
10. SITE AND TYPE OF BIT	10. SITE AND TYPE OF BIT	8" Auger; 6" Core	
11. DATE FOR ELEVATION INFORMATION	11. DATE FOR ELEVATION INFORMATION	8 Aug 1975	
12. MANUFACTURER'S DESIGNATION OF DRILL	12. MANUFACTURER'S DESIGNATION OF DRILL	Palling 1500	
13. TOTAL NO. OF OVERBURDEN SAMPLES TAKEN	13. TOTAL NO. OF OVERBURDEN SAMPLES TAKEN	0	
14. TOTAL NUMBER CORE BOXES	14. TOTAL NUMBER CORE BOXES	4	
15. ELEVATION GROUND WATER	15. ELEVATION GROUND WATER	80	
16. DATE MOLE	16. DATE MOLE	3 Dec. 1975	
17. ELEVATION TOP OF MOLE	17. ELEVATION TOP OF MOLE	100	
18. TOTAL CORE RECOVERY FOR BORING	18. TOTAL CORE RECOVERY FOR BORING	100	
19. SIGNATURE OF INSPECTOR	19. SIGNATURE OF INSPECTOR	<i>James T. Logan</i>	

CLASSIFICATION OF MATERIALS (Description)	ELEVATION	DEPTH	LEGEND
CLAY	0.0' to 6.0'	0.0'	1
CLAY - medium plasticity, hard, silty to finely sandy, brown, slightly moist, non-calcareous.	0.0' to 2.0'	0.0'	1
CLAY - as above interval; slightly calcareous.	2.0' to 4.0'	2.0'	1
CLAY - yellowish brown, medium plasticity, stiff, silty, finely sandy, some scattered fine gravel, moist, non-calcareous.	4.0' to 6.0'	4.0'	1
CLAY-SHALE - rust brown, soft, some gray mixed, scattered gravel and ferrous nodules, non-calcareous.	6.0' to 12.0'	6.0'	2
SHALE AND SANDSTONE - shale is dominant; light tan to grayish tan, silty, non-calcareous. Shale is interrupted with occasional thin beds of sandstones, notably from 14.5' to 17.3'; sandstone is light rust brown, very fine grained, soft and non-calcareous. Maximum thickness without shale interruption was 1.0' (Carton No. 3 from 14.5' to 15.5'). Shale was dominant from 17.3' to 20.7'. Last sandstone in this boring was logged from 20.7' to 21.0'.	12.0' to 21.0'	12.0'	2
SHALE - soft, light tan to grayish tan, silty, some very widely scattered calcite; iron concretionary zone, very calcareous noted from 27.4' to 29.9'. Shale is silty calcareous from this point to total depth and is weathered throughout.	21.0' to 30.0'	21.0'	2

REMARKS:
 1. Hole was bailed to near total depth upon completion and slotted plastic pipe installed for water level observation. Water level after 24 hours at 10.9'.
 2. Drilling: 8" auger to 7.0'; 6" core to total depth of 30.0'.
 3. Jars:
 A. 2.0' to 4.0'
 B. 4.0' to 6.0'
 C. 6.0' to 7.0'
 4. Cartons:
 1. 7.5' to 8.5'
 2. 12.9' to 13.9'
 3. 14.5' to 15.5'
 4. 21.0' to 22.0'
 5. 29.0' to 30.0'
 5. Core Boxes:
 1. 7.0' to 12.6'
 2. 12.6' to 19.2'
 3. 19.2' to 24.8'
 4. 24.8' to 30.0'

Male No. 8A6C-305

INSTALLATION Port Worth SHEET 1 OF 1 SHEETS

10 SIZE AND TYPE OF BIT 8" AUGER 6" CORE

11 LOCATION (COUNTY AND CITY OR TOWNSHIP AND STATE) Spillway Site "K"

12 MANUFACTURER'S DESIGNATION OF DRILL PAULING 1500

13 TOTAL NO. OF OVERBURDEN SAMPLES TAKEN 2 0

14 TOTAL NUMBER CORE BOXES 5

15 ELEVATION GROUND WATER

16 DATE HOLE STARTED 3 Dec. 1975 COMPLETED 4 Dec. 1975

17 ELEVATION TOP OF HOLE

18 TOTAL CORE RECOVERY FOR BORING 100

19 DEPTH DRILLED INTO ROCK 25.2'

20 SIGNATURE OF INSPECTOR *James H. Logan*

21 TOTAL DEPTH OF HOLE 30.0'

CLASSIFICATION OF MATERIALS (Description)

1. Hole was bailed to near total depth upon completion and slotted plastic pipe installed for water level observation. Water level after 24 hours at 10.9'.

2. Drilling: 8" auger to 7.0'; 6" core to total depth of 30.0'.

3. Jars:
A. 2.0' to 4.0'
B. 4.0' to 6.0'
C. 6.0' to 7.0'

4. Cartons:
1. 7.5' to 8.5'
2. 12.9' to 13.9'
3. 14.5' to 15.5'
4. 21.0' to 22.0'
5. 29.0' to 30.0'

5. Core Boxes:
1. 7.0' to 12.6'
2. 12.6' to 19.2'
3. 19.2' to 24.8'
4. 24.8' to 30.0'

SHALE - rust brown, soft, some gray mixed, scattered gravel and ferruginous nodules, non-calcareous.

SHALE AND SANDSTONE - shale is dominant; light tan to grayish tan, silty, non-calcareous. Shale is interrupted with occasional thin beds of sandstone, notably from 14.5' to 17.3'; sandstone is light rust brown, very fine grained, soft and non-calcareous. Maximum thickness without shale interruption was 4.0' (Carton No. 3 from 14.5' to 15.5'). Shale was dominant from 17.3' to 20.7'. Last sandstone in this boring was logged from 20.7' to 21.0'.

SHALE - soft, light tan to grayish tan, silty, some very widely scattered selenite; iron concretions, very calcareous noted from 23.4' to 23.9'. Shale is slightly calcareous from this point to total depth and is weathered throughout.

T. D. 30.0'

ENGINEER ARE OBSOLETE. PROJECT Aubrey Lake HOLE NO. 8A6C-305

Male No. 8A6C-306

DRILLING LOCATION Southwestern INSTALLATION Port Worth SHEET 1 OF 1 SHEETS

1 PROJECT Aubrey Lake

2 LOCATION (COUNTY AND CITY OR TOWNSHIP AND STATE) Spillway Site "K"

3 DRILLING AGENCY Corps of Engineers

4 HOLE NO. (AS SHOWN ON DRAWING AND SITE NUMBER) 8A6C-306

5 NAME OF DRILLER Schoonover

6 DIRECTION OF HOLE VERTICAL INCLINED SEE FROM VERT

7 THICKNESS OF OVERBURDEN 5.0'

8 DEPTH DRILLED INTO ROCK 25.2'

9 TOTAL DEPTH OF HOLE 30.2'

10 SIZE AND TYPE OF BIT 8" AUGER 6" CORE

11 LOCATION (COUNTY AND CITY OR TOWNSHIP AND STATE) Spillway Site "K"

12 MANUFACTURER'S DESIGNATION OF DRILL PAULING 1500

13 TOTAL NO. OF OVERBURDEN SAMPLES TAKEN 1 0

14 TOTAL NUMBER CORE BOXES 4

15 ELEVATION GROUND WATER

16 DATE HOLE STARTED 14 Dec. 1975 COMPLETED 15 Dec. 1975

17 ELEVATION TOP OF HOLE

18 TOTAL CORE RECOVERY FOR BORING 100

19 DEPTH DRILLED INTO ROCK 25.2'

20 SIGNATURE OF INSPECTOR *James H. Logan*

21 TOTAL DEPTH OF HOLE 30.2'

ELEVATION DEPTH LEGEND CLASSIFICATION OF MATERIALS (Description) CORE RECOVERY BOX OR SAMPLE NO. REMARKS (Detail time, name, level of observation, etc., if significant)

0.0' to 5.0' CLAY
0.0' to 2.0' - medium plasticity, light brown, hard, silty, sandy, slightly moist, non-calcareous.
2.0' to 5.0' - medium plasticity, light brown, very stiff, silty, slightly moist, non-calcareous.

5.0' to 7.0' CLAY-SHALE - rust brown and gray, soft, silty, appears to be unworked shale, non-calcareous.

7.0' to 19.5' SHALE AND SANDSTONE - shale is dominant; light tan to grayish tan, silty, non-calcareous. Shale is interrupted with occasional beds of sandstone, notably from 12.4' to 19.5' with maximum thickness of 1.5' from 14.2' to 15.7' (see carton No. 2). Sandstone is light rust brown, very fine grained, well consolidated, soft, and non-calcareous. Shale as described above is dominant below this point with last sandstone in this interval logged from 19.3' to 19.5'.

19.5' to 30.2' SHALE - light tan to gray, (predominantly gray below 25.0'), silty, scattered small crystals of selenite, slightly calcareous; iron concretions, very calcareous noted from 21.9' to 22.4'. Some very fine-grained gray sand interbedded with shale below 29.0'. Shale is weathered to total depth.

T. D. 30.2'

ENGINEER ARE OBSOLETE. PROJECT Aubrey Lake HOLE NO. 8A6C-306

RECORD DRAWING-WORK AS BUILT

SYN	DC	NO	ACTION	DATE	DESCRIPTION OF REVISION
U.S. ARMY ENGINEER DISTRICT, FORT WORTH CORPS OF ENGINEERS FORT WORTH, TEXAS					
DESIGNED BY:	RAY ROBERTS LAKE ELM FORK, TRINITY RIVER, TEXAS EMBANKMENT, SPILLWAY AND OUTLET WORKS LOGS OF BORINGS 8A6C-303, 8A6C-304, 8A6C-305, AND 8A6C-306				
REVISION BY:					
REVIEWED BY:					
SUBMITTED BY:	INVITATION NO. DACW63-82-B-0025		DATE: MAR. 1982		SEQUENCE NO.
ENGINEER	CONTRACT NO. DACW63-82-C-0093		DRAWING NUMBER		33

TO ACCOMPANY FOUNDATION REPORT

CONTRACT NO. DACW63-82-C-0093

DRILLING LOG	Division Southwestern	INSTALLATION	Port 7
PROJECT	Aubrey Lake	NO. RECORD TYPE OF BIT	6" Auger
LOCATION (Continent, State, County)	Guillevy Site #2	DATE FOR ELEVATION	1975
DRILLING AGENCY	Corps of Engineers	DATE FOR ELEVATION	1975
HOLE NO. (As shown on drawing sheet and file number)	816C-308	DATE FOR ELEVATION	1975
NAME OF DRILLER	Seabroover	DATE FOR ELEVATION	1975
DIRECTION OF HOLE	Vertical	DATE FOR ELEVATION	1975
THICKNESS OF OVERBURDEN	3.5'	DATE FOR ELEVATION	1975
DEPTH DRILLED INTO ROCK	17.1'	DATE FOR ELEVATION	1975
TOTAL DEPTH OF HOLE	20.6'	DATE FOR ELEVATION	1975

ELEVATION	DEPTH	LEGEND	CLASSIFICATION OF MATERIALS (Description)	REMARKS (Drilling time, water loss, etc., if significant)
0.0'	4.5'	No Sample	CLAY - medium plasticity, brown, hard, silty, sandy, slightly moist, non-calcareous.	1. Hole bailed to near total depth upon completion and slotted plastic pipe installed for water level observation.
4.5'	10.0'	B	CLAY-SHALE - rust brown, some gray mottled, soft, appears to be reworked shale, scattered small ferrous nodules, non-calcareous.	2. Drilling: 6" auger to 7.0'; 6" core to total depth of 25.0'.
10.0'	24.7'	L 0.2'	SEALS, SILTSTONE AND SANDSTONE - shale is light tan, some gray marbling, soft, variously grades into thin beds of siltstone and very fine grained sandstones; light rust brown and non-calcareous. Maximum thickness of sandstone is 0.8' from 18.3' to 19.1'. Last sandstone logged this interval from 22.0' to 22.3', brown, fine grained and calcareous. Shale as previously described becoming gray, slightly calcareous below 22.3'. Iron concretionary zone, very calcareous, noted from 24.5' to 24.7'.	3. Jars: A. 2.0' to 4.5' B. 4.5' to 7.0'
20.0'		L 1.0'		4. Cartons: 1. 7.7' to 8.7' 2. 12.7' to 13.5' 3. 19.2' to 20.0' 4. 23.0' to 24.0'
		L 1.2'		5. Core Boxes: 1. 7.0' to 12.7' 2. 12.7' to 18.3' 3. 18.3' to 24.7'
		L 0.3'		

DRILLING LOG	Division Southwestern	INSTALLATION	Port 7
PROJECT	Aubrey Lake	NO. RECORD TYPE OF BIT	6" Auger
LOCATION (Continent, State, County)	Guillevy Site #2	DATE FOR ELEVATION	1975
DRILLING AGENCY	Corps of Engineers	DATE FOR ELEVATION	1975
HOLE NO. (As shown on drawing sheet and file number)	816C-308	DATE FOR ELEVATION	1975
NAME OF DRILLER	Seabroover	DATE FOR ELEVATION	1975
DIRECTION OF HOLE	Vertical	DATE FOR ELEVATION	1975
THICKNESS OF OVERBURDEN	3.5'	DATE FOR ELEVATION	1975
DEPTH DRILLED INTO ROCK	17.1'	DATE FOR ELEVATION	1975
TOTAL DEPTH OF HOLE	20.6'	DATE FOR ELEVATION	1975

ELEVATION	DEPTH	LEGEND	CLASSIFICATION OF MATERIALS (Description)	REMARKS (Drilling time, water loss, etc., if significant)
0.0'	3.5'	No Sample	CLAY - medium plasticity, brown, hard, silty to finely sandy, slightly moist, non-calcareous.	1. Hole bailed to near total depth upon completion and slotted plastic pipe installed for water level observation.
3.5'	4.5'	B	CLAY-SHALE - rust brown to reddish brown, some gray, soft, gravelly (composed mostly of small ferrous nodules), some calcareous granules.	2. Drilling: 6" auger to 7.0'; 6" core to total depth of 25.0'.
10.0'	20.6'	L 0.4'	SEALS, SILTSTONE AND SANDSTONE - predominantly shale, light tan to grayish tan, soft, non-calcareous with interruptions of light rust brown, fine grained sandstone noted at the following intervals: 10.5' to 11.0'; 11.5' to 12.3'; 12.8' to 14.9'; 16.9' to 17.2'. Shale becoming slightly calcareous from 17.2' to total depth. Iron concretionary zone, very calcareous from 20.0' to 20.4'.	3. Jars: A. 2.0' to 4.5' B. 4.5' to 7.0'
20.0'		L 0.5'		4. Cartons: 1. 8.4' to 12.7' 2. 14.4' to 19.0'
		L 0.9'		5. Core Boxes: 1. 7.0' to 12.7' 2. 12.8' to 18.3' 3. 20.0' to 20.4'

Hole No. 816C-309

DIVISION Southwestern		INSTALLATION Port North		SHEET 1 of 1 SHEETS	
PROJECT Aubrey Lake					
LOCATION (Continuation of Station) Spillway Site "F"					
DRILLING AGENCY Corps of Engineers					
HOLE NO. (As shown on drawing sheet and this manual) 816C-309					
DRILLER Schoonover					
DATE HOLE STARTED 9 Dec, 1975					
DATE HOLE COMPLETED 9 Dec, 1975					
ELEVATION TOP OF HOLE 17.1'					
TOTAL CORE RECOVERY FOR BORING 100					
SIGNATURE OF INSPECTOR <i>James H. Logan</i>					

DEPTH	LEGEND	CLASSIFICATION OF MATERIALS (Description)	NO. OF CORE RECOVERY	BOX OR SAMPLE NO.	REMARKS (Drilling time, water flow, depth of overburden, etc., if significant)
0.0'		0.0' to 3.5'	No Sample		1. Hole bailed to near total depth upon completion and slotted plastic pipe installed for water level observation.
3.5'		3.5' to 4.5'	A		
4.5'		CLAY-SHALE - rust brown to reddish brown, some gray, soft, gravelly (composed mostly of small ferrous nodules), some calcareous greenish.			
4.5'		4.5' to 20.6'	L 0.4'	Bx 1	2. Drilling: 8" auger to 7.0'; 6" core to total depth of 20.6'. 3. Jars: A. 2.0' to 3.5' B. 3.5' to 4.5' C. 4.5' to 7.0'
10.0'		SHALE AND SANDSTONE - predominantly shale, light tan to grayish tan, soft, non-calcareous with interruptions of light rust brown, fine grained sandstone noted at the following intervals: 10.5' to 11.0'; 11.5' to 12.3'; 12.8' to 14.9'; 16.9' to 17.2'. Shale becoming slightly calcareous from 17.2' to total depth. Iron concretionary zone, very calcareous from 20.0' to 20.4'.	L 0.5'	Bx 2	4. Cartons: 1. 8.4' to 9.4' 2. 14.4' to 15.4' 3. 19.0' to 20.0'
20.0'			0 0.9'	Bx 3	5. Core Boxes: 1. 7.0' to 12.8' 2. 12.8' to 20.0' 3. 20.0' to 20.6'
20.6'		T. D. 20.6'			

36 PREVIOUS EDITIONS ARE OBSOLETE. (TRANSLUCENT) PROJECT Aubrey Lake HOLE NO. 816C-309

Hole No. 816C-309

DIVISION Southwestern		INSTALLATION Port North		SHEET 1 of 1 SHEETS	
PROJECT Aubrey Lake					
LOCATION (Continuation of Station) Spillway Site "F"					
DRILLING AGENCY Corps of Engineers					
HOLE NO. (As shown on drawing sheet and this manual) 816C-309					
DRILLER Schoonover					
DATE HOLE STARTED 10 Dec, 1975					
DATE HOLE COMPLETED 10 Dec, 1975					
ELEVATION TOP OF HOLE 10.0'					
TOTAL CORE RECOVERY FOR BORING 100					
SIGNATURE OF INSPECTOR <i>James H. Logan</i>					

ELEVATION	DEPTH	LEGEND	CLASSIFICATION OF MATERIALS (Description)	NO. OF CORE RECOVERY	BOX OR SAMPLE NO.	REMARKS (Drilling time, water flow, depth of overburden, etc., if significant)
0.0'			0.0' to 4.5'	No Sample		1. Hole was bailed to near total depth upon completion and slotted plastic pipe installed for water level observation.
4.5'			4.5' to 9.9'	A		
10.0'			CLAY-SHALE - appears to be reworked shale, rust brown, marbled gray, soft, abundant calcareous nodules throughout, moist. Clay-shale is gravelly (mostly ferrous nodules) throughout this interval. Calcareous from 9.3' to 9.9'.	Actual Loss 1.4'		2. Drilling: 8" auger to 7.0'; 6" core to total depth of 15.0'. 3. Jars: A. 2.0' to 4.5' B. 4.5' to 7.0'
10.0'			9.9' to 11.3'	L 0.6'	Bx 1	4. Cartons: 1. 7.5' to 8.5' 2. 14.0' to 15.0'
11.3'			Core lost due to grinding. 11.3' to - 15.0'	G 0.6'		5. Core Bx: 1. 7.0' to 15.0'
15.0'			SHALE AND SANDSTONE - shale is tan, to grayish tan, soft, silty, finely sandy and is interrupted by tan very fine grained sandstone at the following intervals: 11.8' to 12.0'; 12.5' to 13.3'. Ironstone noted from 13.3' to 13.4'. Shale and sandstone is non-calcareous.			
15.0'			T. D. 15.0'			

ENG FORM 18 36 PREVIOUS EDITIONS ARE OBSOLETE. (TRANSLUCENT) PROJECT Aubrey Lake HOLE NO. 816C-309

PROJECT	Aubrey Lake
LOCATION	Spillway Site "F"
DRILLING	Falling 1500
HOLE NO.	816C-309
NAME OF DRILLER	Schoonover
DIRECTION	VERTICAL
THICKNESS OF OVERBURDEN	4.5'
DEPTH DRILLED INTO ROCK	10.5'
TOTAL DEPTH OF HOLE	15.0'
ELEVATION	10.0'

ENG FORM 18 36

Division		Installation		Hole No.	
Southwestern		Fort Worth		816C-309	
PROJECT		Aubrey Lake		SHEET 1 OF 1 SHEETS	
1. NAME AND TYPE OF BIT		8" Auger 6" Core		11. DATE FOR ELEVATION IDENTIFICATION	
2. LOCATION OF HOLE (Name of Building or Outlet Works)		Falling 1500		12. MANUFACTURER'S DESIGNATION OF DRILL	
3. DRILLING AGENCY		USCE		13. TOTAL NO. OF OVERBURDEN SAMPLES TAKEN	
4. HOLE NO. (As shown on drawing and on bit)		8A-310		14. TOTAL NUMBER CORE BORES	
5. NAME OF DRILLER		Mullins		15. ELEVATION GROUND WATER	
6. DIRECTION OF HOLE		VERTICAL		16. DATE HOLE STARTED	
7. THICKNESS OF OVERBURDEN		10.3		17. ELEVATION TOP OF HOLE	
8. DEPTH DRILLED INTO ROCK		0.7		18. TOTAL CORE RECOVERY FOR BORING	
9. TOTAL DEPTH OF HOLE		11.0		19. SIGNATURE OF INSPECTOR	
CLASSIFICATION OF MATERIALS (Description)		CORRECTION		REMARKS	
0.0' to 4.5'		No Sample		1. Hole was bailed to near total depth upon completion and slotted plastic pipe installed for water level observation.	
CLAY - medium plasticity, brown, hard, silty to finely sandy, slightly moist, becoming more moist from 2.0' to 4.5', slightly calcareous.		A		2. Drillings: 8" auger to 7.0'; 6" core to total depth of 15.0'.	
4.5' to 9.9'		B		3. Jars: A. 2.0' to 4.5' B. 4.5' to 7.0'	
CLAY-SHALE - appears to be reworked shale, rust brown, marbled gray, soft abundant calcareous nodules throughout, moist. Clay-shale is gravelly (mostly ferrous nodules) throughout this interval. Calcareous from 9.3' to 9.9'.		Actual Loss 1.4'		4. Cartons: 1. 7.5' to 8.5' 2. 14.0' to 15.0'	
9.9' to 11.3'		C 0.6'		5. Core Box: 1. 7.0' to 15.0'	
Core lost due to grinding.		D 0.6'			
11.3' to 15.0'		E			
SHALE AND SANDSTONE - shale is tan, to grayish tan, soft, silty, finely sandy and is interrupted by tan very fine grained sandstone at the following intervals: 11.8' to 12.0', 12.5' to 13.3'. Ironstone noted from 13.3' to 13.4'. Shale and sandstone is non-calcareous.		F			
T.D. 15.0'					

Division		Installation		Hole No.	
Southwestern		Fort Worth		8A-310	
PROJECT		Aubrey Dam		SHEET 1 OF 1 SHEETS	
1. NAME AND TYPE OF BIT		8" Auger		11. DATE FOR ELEVATION IDENTIFICATION	
2. LOCATION OF HOLE (Name of Building or Outlet Works)		Falling 1500		12. MANUFACTURER'S DESIGNATION OF DRILL	
3. DRILLING AGENCY		USCE		13. TOTAL NO. OF OVERBURDEN SAMPLES TAKEN	
4. HOLE NO. (As shown on drawing and on bit)		8A-310		14. TOTAL NUMBER CORE BORES	
5. NAME OF DRILLER		Mullins		15. ELEVATION GROUND WATER	
6. DIRECTION OF HOLE		VERTICAL		16. DATE HOLE STARTED	
7. THICKNESS OF OVERBURDEN		10.3		17. ELEVATION TOP OF HOLE	
8. DEPTH DRILLED INTO ROCK		0.7		18. TOTAL CORE RECOVERY FOR BORING	
9. TOTAL DEPTH OF HOLE		11.0		19. SIGNATURE OF INSPECTOR	
CLASSIFICATION OF MATERIALS (Description)		CORRECTION		REMARKS	
0.0' to 1.0'		A		1. Hole was dry after completion. 16 hour check, hole was dry.	
CLAY, low plasticity, hard dry, silty, dark gray.		B		2. Jars: A. 0.0 to 1.0 B. 1.0 to 4.0 C. 4.0 to 6.0 D. 6.0 to 9.0 E. 9.0 to 10.3 F. 10.3 to 11.0	
1.0' to 4.0'		C		3. Hole offset 10' East.	
CLAY, medium plasticity, hard, dry, gray.		D			
4.0' to 6.0'		E			
CLAY, medium plasticity, silty, stiff, gravelly, some caliche, tan and white.		F			
6.0' to 10.3'					
CLAY, low plasticity, medium stiff, sandy, moist to 2', wet from 2' to 10.3', tan.					
10.3' to 11.0'					
SHALE, weathered to 10.5', unweathered from 10.3' to 11', stiff, dark gray.					
T.D. - 11.0'					

RECORD DRAWING-WORK AS BUILT

SYM	NO	ACTION	DATE	DESCRIPTION OF REVISION
U.S. ARMY ENGINEER DISTRICT, FORT WORTH CORPS OF ENGINEERS FORT WORTH, TEXAS				
RAY ROBERTS LAKE ELM FORK, TRINITY RIVER, TEXAS BANKMENT, SPILLWAY AND OUTLET WORKS LOGS OF BORINGS 8A6C-307, 8A6C-308, 8A6C-309 AND 8A-310				
DESIGNED BY:		INVESTIGATION NO. DACW63-BZ-B-0025 DATE MAR, 1982		
DRAWN BY:		CONTRACT NO. DACW63-82-C-0083		
REVIEWED BY:		DRAWING NUMBER		
SUBMITTED BY:		SHEET NO. 34		
ENGINEER:		SEQUENCE NO.		

TO ACCOMPANY FOUNDATION REPORT

CONTRACT NO. DACW63-82-C-0083

Map No. **8A-311**

DRILLING LOG		DIVISION Southwestern		INSTALLATION Fort Worth		SHEET of 4 SHEETS	
1. PROJECT Aubrey Dam				16. SIZE AND TYPE OF BIT BUGER			
2. LOCATION (Name of Dam or Structure) Outlet Works				17. DATE FOR ELEVATION TOOK (T.M. or M.D.) Falling 1500			
3. DRILLING AGENCY USCE				18. MANUFACTURER'S DESIGNATION OF DRILL Falling 1500			
4. HOLE NO. (As shown on drawing title and file number) 8A-311				19. TOTAL NO. OF OVERBURDEN SAMPLES TAKEN		20. UNSTURBED	
5. NAME OF DRILLER Mullina				21. TOTAL NUMBER CORE BOXES		22. ELEVATION GROUND WATER	
6. DIRECTION OF HOLE <input type="checkbox"/> VERTICAL <input type="checkbox"/> INCLINED _____ DEG. FROM VERT.				23. DATE HOLE 5 <input type="checkbox"/> STARTED <input type="checkbox"/> COMPLETED		24. ELEVATION TOP OF HOLE 573.6 (offset elev)	
7. THICKNESS OF OVERBURDEN 13.8				25. TOTAL CORE RECOVERY FOR BORING			
8. DEPTH DRILLED INTO ROCK 2.2				26. HOLE NO. (As shown on drawing title and file number)			
9. TOTAL DEPTH OF HOLE 15.0				27. SIGNATURE OF INSPECTOR <i>[Signature]</i>			

ELEVATION	DEPTH	LEGEND	CLASSIFICATION OF MATERIALS (Description)	% CORE RECOVERY	BOX OR SAMPLE NO.	REMARKS (Disturb from water level, depth of weathering, etc., if significant)
0.0'	1.0'		SILT , medium stiff, dry, low plasticity, dark brown.		A	1. Hole was dry after completion. 16 hour check, level was 15.4' 2. Jars: A. 0.0 to 1.0 B. 1.0 to 6.7 C. 6.7 to 12.0 D. 12.0 to 13.8 E. 13.8 to 16.0 3. Hole offset 30 ft. on a bearing of N 90° E.
1.0'	6.7'		CLAY , low plasticity, medium stiff, silty, sandy, slightly moist, red and tan.		B	
6.7'	12.0'		CLAY , low plasticity, medium stiff, sandy, moist, tan and gray.		C	
12.0'	13.8'		SAND , gravelly, medium dense, clayey, tan and brown.		D	
13.8'	16.0'		SHALE , reworked in upper 0.3', unweathered dark gray.		E	
T.D. - 16.0' -						

Map No. **8A-311**

DRILLING LOG		DIVISION Southwestern		INSTALLATION Fort Worth		SHEET of 4 SHEETS	
1. PROJECT Aubrey Dam				16. SIZE AND TYPE OF BIT BUGER			
2. LOCATION (Name of Dam or Structure) Outlet Works				17. DATE FOR ELEVATION TOOK (T.M. or M.D.) Falling 1500			
3. DRILLING AGENCY USCE				18. MANUFACTURER'S DESIGNATION OF DRILL Falling 1500			
4. HOLE NO. (As shown on drawing title and file number) 8A-312				19. TOTAL NO. OF OVERBURDEN SAMPLES TAKEN		20. UNSTURBED	
5. NAME OF DRILLER Mullina				21. TOTAL NUMBER CORE BOXES		22. ELEVATION GROUND WATER	
6. DIRECTION OF HOLE <input checked="" type="checkbox"/> VERTICAL <input type="checkbox"/> INCLINED _____ DEG. FROM VERT.				23. DATE HOLE 19 Sep 80 <input type="checkbox"/> STARTED <input type="checkbox"/> COMPLETED		24. ELEVATION TOP OF HOLE 56	
7. THICKNESS OF OVERBURDEN 15.0				25. TOTAL CORE RECOVERY FOR BORING			
8. DEPTH DRILLED INTO ROCK 0.5				26. HOLE NO. (As shown on drawing title and file number)			
9. TOTAL DEPTH OF HOLE 15.5				27. SIGNATURE OF INSPECTOR <i>[Signature]</i>			

ELEVATION	DEPTH	LEGEND	CLASSIFICATION OF MATERIALS (Description)	% CORE RECOVERY	BOX OR SAMPLE NO.	REMARKS (Disturb from water level, depth of weathering, etc., if significant)
0.0'	3.0'		SAND , fine grained, medium dense, dry, brown.		A	1. Aug rated 24 hours 2. Jars: A. 0. B. 2. C. 5. D. 7. E. 12. F. 15 3. Ho. on : N80° Ina: Ele: tail
3.0'	12.0'		GRAVEL , coarse to fine grained, medium dense, moist from 2' to 3', damp from 5' to 7', becomes saturated at 7'.		B	
12.0'	15.0'		CLAY , medium plasticity, very stiff, moist, gravelly, brown.		C	
15.0'	15.5'		SHALE , unweathered, soft, dark gray.		D	
T.D. - 15.5' -						

10471410-011

Hole No. BA-312

INSTALLATION Fort Worth		SHEET 1 of 1 SHEETS	
1. PROJECT Aubrey Dam			
2. LOCATION (Township or Station) Outlet			
3. DRILLING AGENCY USCE-C			
10. SIZE AND TYPE OF BIT 6" aug. 6" den. 6" case		11. DATE AND TIME OF ELEVATION MEASUREMENT 19 Sep 80	
12. MANUFACTURER'S DESIGNATION OF DRILL Falling 1500			
13. TOTAL NO. OF OVERBURDEN SAMPLES TAKEN 6		14. ELEVATION GROUND WATER 567.9	
15. TOTAL NUMBER CORE BORES 10			
16. DATE HOLE STARTED 19 Sep 80			
17. ELEVATION TOP OF HOLE 567.9			
18. TOTAL CORE RECOVERY FOR BORING 99			
19. SIGNATURE OF INSPECTOR <i>[Signature]</i>			
20. TOTAL DEPTH OF HOLE 83.2			
REMARKS 1. Augered into saturated gravel at 7'. 24 hour check - level was same.			
2. Jars: A. 0.0 to 2.0 B. 2.0 to 3.0 C. 3.0 to 7.0 D. 7.0 to 12.0 E. 1. ? to 15.0 F. 15.0 to 15.5			
3. Hole offset 80. ft. on a bearing of N80°E due to inaccessible terrain. Elevation was obtained with level.			

CLASSIFICATION OF MATERIALS (Description)	1. CORE RECOVERY	2. BOX OR SAMPLE NO.	REMARKS (Including diam., hole den., depth of overburden, etc., if significant)
0.0' to 2.0' SAND, fine grained, medium dense, dry, brown.		A	
2.0' to 12.0' GRAVEL, coarse to fine grained, medium dense, moist from 2' to 5', damp from 5' to 7', becomes saturated at 7'.		B	
12.0' to 15.0' CLAY, medium plasticity, very stiff, moist, gravelly, brown.		C	
15.0' to 15.5' SLALE, unweathered, soft, dark gray.		D	
T.D. - 15.5'			

ENGINE FORM 1836 PREVIOUS EDITIONS ARE OBSOLETE. PROJECT **Aubrey Lake** HOLE NO. **BA-312**

Hole No. GDC-313

INSTALLATION FWD		SHEET 1 of 3 SHEETS	
1. PROJECT Aubrey Dam			
2. LOCATION (Township or Station) Outlet			
3. DRILLING AGENCY USCE-C			
10. SIZE AND TYPE OF BIT 6" aug. 6" den. 6" case		11. DATE AND TIME OF ELEVATION MEASUREMENT 29 Aug	
12. MANUFACTURER'S DESIGNATION OF DRILL Falling 1500			
13. TOTAL NO. OF OVERBURDEN SAMPLES TAKEN 14		14. ELEVATION GROUND WATER 567.9	
15. TOTAL NUMBER CORE BORES 10			
16. DATE HOLE STARTED 29 Aug			
17. ELEVATION TOP OF HOLE 567.9			
18. TOTAL CORE RECOVERY FOR BORING 99			
19. SIGNATURE OF INSPECTOR <i>[Signature]</i>			
20. TOTAL DEPTH OF HOLE 83.2			
REMARKS 1. Balled hole to near T.D., 24 hr. check, water @ 25.5'.			
2. Jars: A. 0.0 to 4.0 B. 4.0 to 5.0 C. 5.0 to 5.5 D. 7.0 E. 9.0 F. 11.0 G. 11.0 to 13.0 H. 15.0 I. 17.0 J. 18.0 K. 20.0 L. 20.0 to 21.5 M. 21.5 to 26.5 N. 26.5 to 29.5 O. 29.5 to 32.0			
3. Denison cast: 1. 5.5 to 7.0 2. 7.0 to 9.0 3. 9.0 to 11.0 4. 13.0 to 15.0 5. 15.0 to 17.0 6. 18.0 to 20.0			
4. Cartons: 1-35.3 to 36.3 2-41.9 to 42.9 3-45.6 to 46.5 4-50.5 to 51.3 5-57.3 to 58.3 6-65.8 to 66.8 7-69.9 to 70.6 8-75.3 to 76.3 9-81.9 to 82.9			
5. Drillings: 0.0' to 5.0', 8" auger, Set 5.0' casing 5.0' to 21.5', 6" denison casing as drill progressed 21.5' to 32.0', 8" auger			

CLASSIFICATION OF MATERIALS (Description)	1. CORE RECOVERY	2. BOX OR SAMPLE NO.	REMARKS (Including diam., hole den., depth of overburden, etc., if significant)
0.0' to 16.0' CLAY		A	
0.0' to 4.0', low plasticity, hard, dry, brown, silty.		B	
4.0' to 6.5', med. plast., v. stiff, dry, strong brown, sl. sandy.		C	
6.5' to 16.0', med./low plast., stiff, dry, yellowish brown, silty, lime nodules and sand below 15.0'.		D	
16.0' to 21.5' SAND, fine grained, clayey & silty seams within, sl. gravelly, dry, strong brown, & yellow brown w/ light gray.		E	
21.5' to 29.5' GRAVEL, coarse to fine & round, damp to moist? (drill fluid still in hole), strong brn. clayey, sandy.		F	
29.5' to 82.9' CLAYSHALE, unweath., dk, gray, soft to mod. soft (R. classif) massive, silty w/ interbeds of thin silty & sandy seams @ 10-12 degrees. Several med. hard SANDSTONE seams as indicated below: 45.6-45.9 49.6-50.9 50.4-52.1 57.0-57.3 61.2-61.4 64.1-64.4 64.9-65.0 66.7-66.8		G	
Highly fossilif. zone from 69.9 to 70.4 (ctn. #7).		H	
Structural features as follows: 43.4 open fract 47.1 " " 51.5 " " 64.2 " "		I	

ENGINE FORM 1836 PREVIOUS EDITIONS ARE OBSOLETE. PROJECT **Aubrey Lake** HOLE NO. **GDC-313**

INSTALLATION FWD		SHEET 1 of 3 SHEETS	
1. PROJECT AUB			
2. LOCATION (Township or Station)			
3. DRILLING AGENCY			
10. SIZE AND TYPE OF BIT		11. DATE AND TIME OF ELEVATION MEASUREMENT	
12. MANUFACTURER'S DESIGNATION OF DRILL			
13. TOTAL NO. OF OVERBURDEN SAMPLES TAKEN		14. ELEVATION GROUND WATER	
15. TOTAL NUMBER CORE BORES			
16. DATE HOLE STARTED			
17. ELEVATION TOP OF HOLE			
18. TOTAL CORE RECOVERY FOR BORING			
19. SIGNATURE OF INSPECTOR			
20. TOTAL DEPTH OF HOLE			
REMARKS			

RECORD DRAWING-WORK AS BUILT

Male No. 6DC-313

LOG DIVISION SWD	INSTALLATION FWD	SHEET 1 OF 3 SHEETS
PROJECT ry Dam	NO. SIZE AND TYPE OF BIT 6" Aug. 60 den. 6" core	DATE FOR ELEVATION IDENTIFICATION 10 Sep 50
NAME OF DRILLER USCE-C	11 MANUFACTURER'S DESIGNATION OF DRILL Falling 1500	12 TOTAL NO. OF OVERBURDEN SAMPLES TAKEN 14
LOG NO. GDC-313	13 TOTAL NUMBER CORE BOXES 10	14 ELEVATION GROUND WATER 0000
DATE 10 Sep 50	15 DATE HOLE STARTED 29 Aug	16 DATE HOLE COMPLETED 10 Sep 50
DRILLER A Mullins	17 ELEVATION TOP OF HOLE	18 TOTAL CORE RECOVERY FOR BORING 99
INCLINED	19 SIGNATURE OF INSPECTOR	

LEGEND	CLASSIFICATION OF MATERIALS (Description)	DEPTH CORRECTION	SOLO ON SAMPLE NO.	REMARKS (Drilling time, water loss, depth of measuring, etc., if significant)
0.0' to 16.0'	CLAY		A	1. Bailed hole to near T.D., 24 hr. check, water @ 23.5'
0.0' to 4.0'	low plasticity, hard, dry, brown, silty.		B	
4.0' to 6.3'	med. plast., v. stiff, dry, strong brown, sl. sandy.		C	
6.3' to 16.0'	med./low plast., stiff, dry, yellowish brown, silty, lime nodules and sand below 15.0'		D	
16.0' to 21.3'	SAND, fine grained, clayey & silty seams within, sl. gravelly, dry, strong brown, & yellow brown w/ light gray.		E	
21.3' to 29.5'	GRAVEL, coarse to fine & rounded, clasp to soil? (drill fluid still in hole), strong brn. clayey, sandy		F	
29.5' to 62.9'	CLAYSHALE, unweath. dk. gray, soft to mod. soft (Rz. classif) massive, silty w/ interbeds of thin silty & sandy seams @ 10-12 degrees.		G	
	Several med. hard SANDSTONE seams as indicated below:		H	
	45.6-45.9			
	49.6 50.9			
	50.4 52.1			
	57.0 57.3			
	61.2 61.4			
	64.1 64.4			
	64.9 65.0			
	66.7 66.8			
	Highly fossilif. zone from 69.9 to 70.4 (ctn. #7)			
	Structural features as follows:			
	43.4 open fract			
	47.1 " "			
	51.3 " "			
	64.2 " "			
	5. Drilling:			
	0.0' to 5.0', 8" auger, Set 5.0' casing			
	5.0' to 21.5', 6" denison 8" casing as drill progressed			
	21.5' to 32.0', 8" auger			

Male No. GDC-313

DRILLING LOG DIVISION	INSTALLATION	SHEET 1 OF 3 SHEETS
PROJECT AUBREY DAM	NO. SIZE AND TYPE OF BIT 6" Aug. 60 den. 6" core	DATE FOR ELEVATION IDENTIFICATION 10 Sep 50
LOCATION (Coordinates or Station) OUTLET	11 MANUFACTURER'S DESIGNATION OF DRILL Falling 1500	12 TOTAL NO. OF OVERBURDEN SAMPLES TAKEN 14
DRILLING AGENCY USCE-C	13 TOTAL NUMBER CORE BOXES 10	14 ELEVATION GROUND WATER 0000
HOLE NO. (As shown on Drawing Sheet) and its number GDC-313	15 DATE HOLE STARTED 29 Aug	16 DATE HOLE COMPLETED 10 Sep 50
NAME OF DRILLER	17 ELEVATION TOP OF HOLE	18 TOTAL CORE RECOVERY FOR BORING 99
DIRECTION OF HOLE VERTICAL	19 SIGNATURE OF INSPECTOR	

ELEVATION	DEPTH	LEGEND	CLASSIFICATION OF MATERIALS (Description)	SOLO ON SAMPLE NO.	REMARKS (Drilling time, water loss, depth of measuring, etc., if significant)
50				L-02 2	Drilling cont. Set 31.5' casing, clearout to 33.5' 33.5' to 83.1' 6" core
				G-03 33	
				L-01 14	
				G-03	
				L-01 5	
				L-01 21	
				G-02 4	
				L-02 17	
				L-02 7	
				G-01 8	
				G-01 10	
				G-01 10	
				G-01 9	
				G-01 10	
				G-01 9	

- T.D. 83.1 -
HOLE TAPPED 72.9

RECORD DRAWING-WORK AS BUILT

SYMBOL NO.	ACTION	DATE	DESCRIPTION OF REVISION
U.S. ARMY ENGINEER DISTRICT, FORT WORTH CORPS OF ENGINEERS FORT WORTH, TEXAS			
DESIGNED BY	RAY ROBERTS LAKE ELM FORK, TRINITY RIVER, TEXAS EMBANKMENT, SPILLWAY AND OUTLET WORKS LOGS OF BORINGS 8A-311, 8A-312, 6DC-313		
DRAWN BY			
REVIEWED BY			
SUBMITTED BY			
ENGINEER	INVITATION NO. DACW63-82B-0085	DATE MAR. 1982	SEQUENCE NO. 25
	CONTRACT NO. DACW63-82-C-0093		SHEET NO. 25
	DRAWING NUMBER		

TO ACCOMPANY FOUNDATION REPORT

Mile No 50r 31r


DRILLING LOG		PROJECT		SHEET	
Aubrey Dam		Outlet Works		1 of 3	
60C-314		Mullins		10	
18.5		70.5		89.0	
10		20		30	
40		50		60	
70		80		90	

ELEVATION	DEPTH	LEGEND	CLASSIFICATION OF MATERIALS	SCORE	FOR ON	NO	CD
81.0							5
G1			44.3' to 44.5' - SANDSTONE				6
G1			44.7' to 44.9' - SANDSTONE				7
80.5							8
L			54.3' to 54.9' - SANDSTONE				9
G1							10
G1			60.6' to 60.8' - SANDSTONE				11
G1			62.1' to 62.4' - SANDSTONE				12
G1			62.7' to 62.9' - SANDSTONE				13
L			65.0' to 65.5' - SANDSTONE				14
L			65.0' to 70.0' - SANDSTONE				15
L			72.3' to 75.5' - very fossiliferous, numerous claystone lenses				
T.D. - 89.0'							

ENG FORM 1836 PREVIOUS EDITIONS ARE OBSOLETE

PROJECT - Aubrey Dam

WELL NO - 60C 314

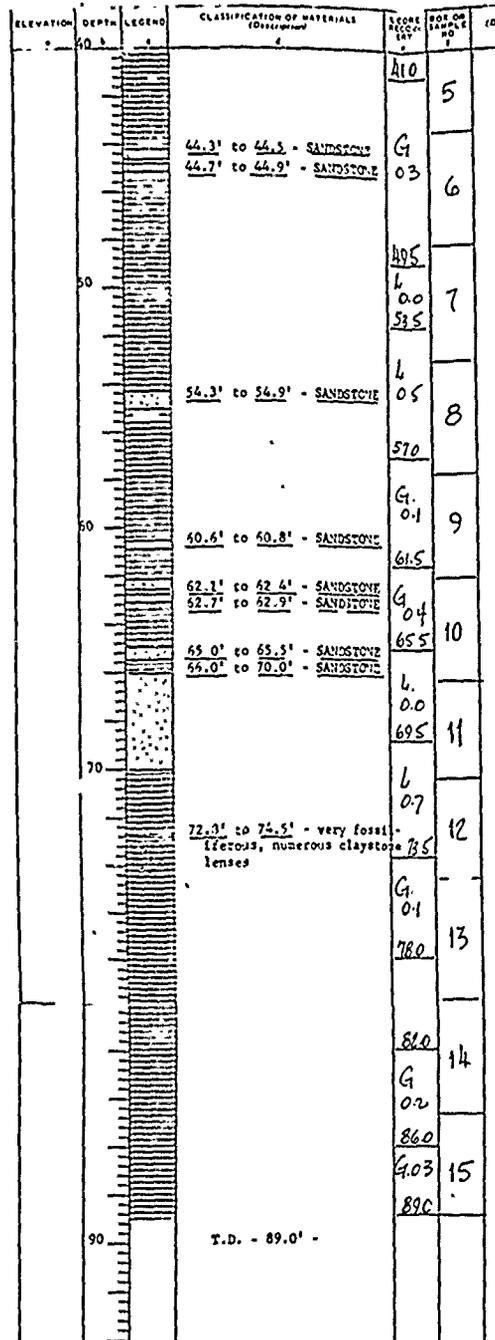


ELEVATION	DEPTH	LEGEND	CLASSIFICATION OF MATERIALS (Description)	SCORE RECOVERY	BOX OR SAMPLE NO	REMARKS (Drilling time, water loss, depth of weathering, etc., if significant)
90.1					A10	
					5	
			44.3' to 44.5' - SANDSTONE	G	03	
			44.7' to 44.9' - SANDSTONE			
					6	
					495	
					7	
					L 00	
					535	
			54.3' to 54.9' - SANDSTONE	L	05	
					8	
					570	
					9	
			60.6' to 60.8' - SANDSTONE	G	01	
					10	
					615	
			62.1' to 62.4' - SANDSTONE	G	04	
			62.7' to 62.9' - SANDSTONE			
					11	
			65.0' to 65.5' - SANDSTONE	L	00	
			65.0' to 70.0' - SANDSTONE			
					12	
			72.3' to 72.5' - very fossiliferous, numerous claystone lenses	L	07	
					13	
					780	
					14	
					810	
					G 02	
					860	
					G 03	
					890	
			T.D. - 89.0' -			

DRILLING LOG		Southwestern		INSTRUMENTATION		Fort Worth		Hole No. 60C-315		SHEET 1 of 3 SHEETS	
PROJECT Aubrey Dam		LOCATION (Community or Bureau) Outlet Works		14 SIZE AND TYPE OF BIT NUMBER, d, bb, l, core, etc.		15 DATE FOR RECEIVING INSTRUMENTS					
3 DRILLING AGENCY USCE		16 MANUFACTURER DESIGNATION OF GRILL Falling 1500		17 TOTAL NO. OF OVERBURDEN SAMPLES TAKEN		18 TOTAL NO. OF CORE BORES		19 ELEVATION GROUND WATER			
4 HOLE NO. This shows on drawing title and file number 60C-315		5 NAME OF DRILLER Mullins		6 DIRECTION OF HOLE <input checked="" type="checkbox"/> VERTICAL <input type="checkbox"/> INCLINED DEE FROM VEAT		7 THICKNESS OF OVERBURDEN 18.5		8 DEPTH DRILLED INTO ROCK 76.3		9 TOTAL DEPTH OF HOLE 94.8	
				10 DATE MOLE 13 Sept 80		11 SIGNATURE OF DRILLER J.P. [Signature]		12 DATE MOLE 18 Sept 80		13 SIGNATURE OF SUPERVISOR [Signature]	
				14 ELEVATION TOP OF HOLE		15 TOTAL CORE RECOVERY FOR BORING 98.4					
ELEVATION	DEPTH	LEGEND	CLASSIFICATION OF MATERIALS (Description)	SCORE RECOVERY	BOX OR SAMPLE NO	REMARKS (Drilling time, water loss, depth of weathering, etc., if significant)					
			0.0' to 2.5'		A	1. After completion, hole was bailed to T.D. 24 hr check, water level was 31.5'					
			CLAY, low plasticity, hard, dry, brown.		B	2. Jars:					
					1	A. 0.0 to 2.5					
					2	* B. 4.5					
					3	* C. 6.5					
					4	D. 6.5 to 11.5					
					5	E. 11.5 to 12.5					
					6	F. 12.5 to 17.5					
					7	G. 17.5 to 18.5					
					8	H. 18.5 to 20.5					
					9	* taken from Denison shoe.					
					10	3. Denison cans:					
					11	1. 2.5 to 4.5					
					12	2. 4.5 to 6.5					
					13	4. Castons:					
					14	1. 22.5 to 23.6					
					15	2. 25.7 to 27.7					
					16	3. 30.0 to 31.0					
					17	4. 35.4 to 36.4					
					18	5. 38.9 to 39.9					
					19	6. 44.5 to 45.5					
					20	7. 51.2 to 52.2					
					21	8. 56.0 to 57.0					
					22	9. 59.8 to 60.6					
					23	10. 65.4 to 66.4					
					24	11. 70.6 to 71.6					
					25	12. 77.0 to 77.8					
					26	13. 80.8 to 81.8					
					27	14. 85.8 to 86.8					
					28	15. 90.0 to 90.9					
					29	16. 93.8 to 94.8					
			2.5' to 6.5'		C	5. Drilling methods:					
			CLAY, medium plasticity, very stiff, slightly moist, brown.		2	0.0 to 2.5 - auger					
					3	2.5 to 6.5 - denison bb'1					
					4	6.5 to 20.5 - auger					
					5	20.5 to 94.8 - core bb'1					
					6	6. Base of weathering at 30'					
			6.5' to 18.5'		D						
			CLAY, medium plasticity, hard, moist, gravelly except from 17.5' to 18.5', calcareous nodules.		E						
					F						
			18.5' to 30.0'		G						
			SHALE, moderately soft, weathered as shown below:		H						
			18.5' to 20.5' - unweathered.		I						
			20.5' to 25.4' - highly weathered, soft, tan.		J						
			25.4' to 30.0' - slightly weathered, gray and tan.		K						
					L						
			30.0' to 94.8'		M						
			SPALC, moderately soft, unweathered, unjointed, unfractured, massive, gray.		N						
					O						
			Interbeds of hard SANDSTONE at the following depths:		P						
			21.0' to 21.6'		1						
			38.9' to 40.3'		2						
			42.7' to 43.0'		3						
			45.7' to 45.0'		4						
			49.3' to 50.0'		5						
			57.3' to 58.3'		6						
					7						
			58.4' - very fossiliferous.		8						

DRIILLING LOG	Southwestern	INSTALLATION Fort Worth	SHEET of 3 sheets
PROJECT Aubrey Dam		10 SIZE AND TYPE OF BIT 6" auger, d bb'1	11 DATE FOR ELEVATION 13 Sept 80
LOCATION (Continued on Section) Outlet Works		12 MANUFACTURER'S DESIGNATION OF BIT Falling 1500	13 TOTAL NO. OF OVER- BURDEN SAMPLES TAKEN 8
DRAWING AGENCY USCE		14 TOTAL NUMBER CORE SOLES 16	15 ELEVATION GROUND WATER *
PROJECT NO. 6DC-315		16 DATE HOLE 13 Sept 80	17 ELEVATION TOP OF HOLE 98.4
DRILLER Mullins		18 TOTAL CORE RECOVERY FOR BORING 98.4	19 DATE LOG 18 Sept 80
DIAMETER OF HOLE 6" INCLINED		20 ELEVATION TOP OF HOLE	21 TOTAL CORE RECOVERY FOR BORING 98.4
THICKNESS OF OVERBURDEN 18.5		22 DATE LOG 18 Sept 80	23 TOTAL CORE RECOVERY FOR BORING 98.4
DEPTH DRILLED INTO ROCK 76.3		24 DATE LOG 18 Sept 80	25 TOTAL CORE RECOVERY FOR BORING 98.4
DEPTH OF HOLE 94.8		26 DATE LOG 18 Sept 80	27 TOTAL CORE RECOVERY FOR BORING 98.4

DEPTH	LEGEND	CLASSIFICATION OF MATERIALS (Description)	SCORE RECORDED	BOX OR SAMPLE NO.	REMARKS (Drilling time, water loss, depth of weathering, etc., if significant)
0.0' to 2.5'	A	CLAY, low plasticity, hard, dry, brown.			** 1. After completion, hole was bailed to T.D. 24 hr check, water level was 31.5'
2.5' to 6.5'	1	CLAY, medium plasticity, very stiff, slightly moist, brown.			2. Jars: A. 0.0 to 2.5 B. 4.5 C. 6.5 D. 6.5 to 11.5 E. 11.5 to 12.5 F. 12.5 to 17.5 G. 17.5 to 18.5 H. 18.5 to 20.5 * taken from denison shoe.
6.5' to 18.5'	D	CLAY, medium plasticity, hard, moist, gravelly except from 17.5' to 18.5', calcareous nodules.			3. Denison cans: 1. 2.5 to 4.5 2. 4.5 to 6.5
18.5' to 30.0'	F	SHALE, moderately soft, weathered as shown below.			4. Cartons: 1. 22.5 to 23.6 2. 25.7 to 27.7 3. 30.0 to 31.0 4. 35.4 to 36.4 5. 38.9 to 39.9 6. 44.5 to 45.5 7. 51.2 to 52.2 8. 56.0 to 57.0 9. 59.8 to 60.6 11. 65.4 to 66.4 11. 70.6 to 71.6 12. 77.0 to 77.8 13. 80.8 to 81.8 14. 85.8 to 86.8 15. 90.0 to 90.9 16. 93.8 to 94.8
30.0' to 94.8'	G	SHALE, moderately soft, unweathered, unjointed, unfractured, massive, gray.			5. Drilling methods: 0.0 to 2.5 - auger 2.5 to 6.5 - denison bb'1 6.5 to 20.5 - auger 20.5 to 94.8 - core bb'1
	H	Interbeds of hard SANDSTONE at the following depths:			6. Base of weathering at 30'
		21.0' to 21.6'	L. 0.0		
		38.9' to 40.2'	L. 0.0		
		42.7' to 43.0'	G. 325		
		45.7' to 45.9'	G. 0.8		
		49.3' to 50.0'	L. 0.0		
		57.3' to 58.3'	L. 0.0		
		58.4' - very fossiliferous.	L. 0.0		

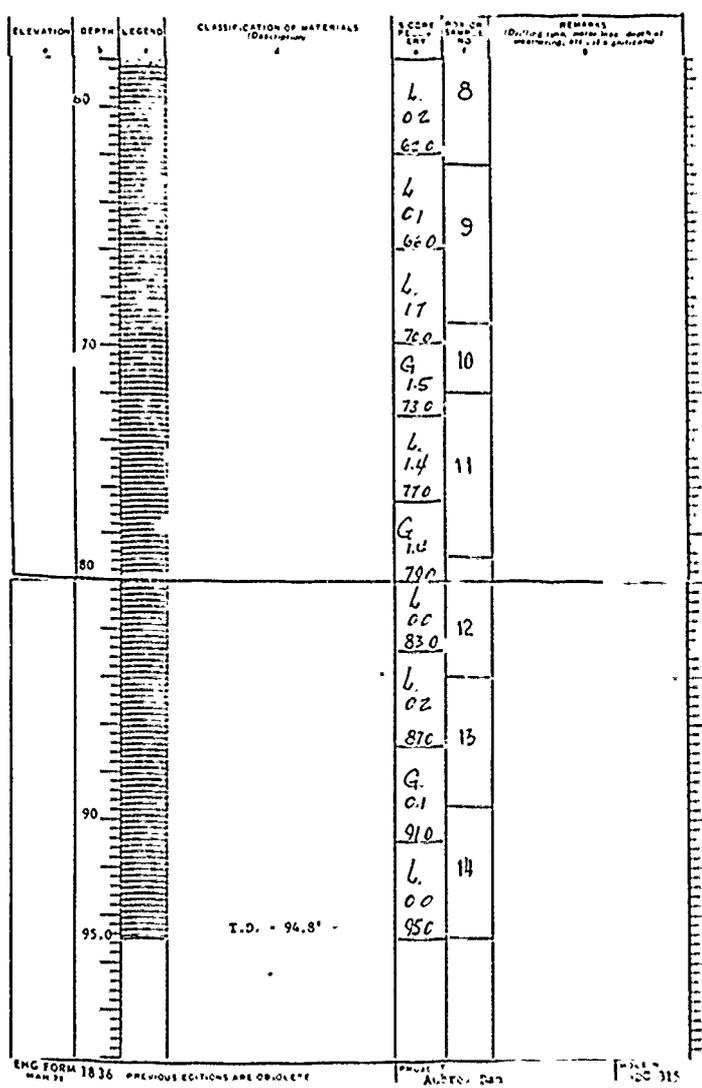

ENG FORM 1836 PREVIOUS EDITIONS ARE OBSOLETE

RECORD DRAWING-WORK AS FILED

DESIGNED BY	RAY ROBERTS LAKE
DRAWN BY	ELM FORK, TRINITY RIVER, TEXAS
REVIEWED BY	EMBANKMENT, SPILLWAY AND
	OUTLET WORKS
	LOGS OF BORINGS
	6 DC-314 AND 6DC-315
SUBMITTED BY	INVITATION NO SAGA 83-82 B-0025 DATE MAR. 11 1982
APPROVED BY	CONTRACT NO DACW 63-82 C 1.005
	DRAW NO 4, 4, 4, 4
	SHEET NO 36

TO ACCOMPANY FOUNDATION REPORT

Hole No. BA-315

DRILLING LOG		Southwestern		Installation		Fort Worth		SHEET	
PROJECT		Aubrey Dam		NO. AND TYPE OF BIT		11		OF SHEETS	
LOCATION		Outlet Works		DATE FOR ELEVATION INDENTIFICATION		12			
DRILLING AGENCY		USCE		MANUFACTURER'S DESIGNATION OF DRILL		Pallins 1500			
HOLE NO. TAG AND HOLE NUMBER		BA-315		TOTAL NO. OF OVERBURDEN SAMPLES TAKEN		7		UNDISTURBED	
NAME OF DRILLER		Mullins		TOTAL NUMBER CORE BORES		-			
DIRECTION OF HOLE		VERTICAL		ELEVATION GROUND WATER		99.6			
THICKNESS OF OVERBURDEN		27.7'		DATE HOLE STARTED		19 Sep 80		COMPLETED	
DEPTH DRILLED INTO ROCK		74.8'		ELEVATION TOP OF HOLE		19 Sep 80			
TOTAL DEPTH OF HOLE		104.5'		TOTAL CORE RECOVERY FOR BORING		-			
				SIGNATURE OF DIRECTOR		[Signature]			

ELEVATION	DEPTH	LEGEND	CLASSIFICATION OF MATERIALS (Describe)	SCORE RECORDED	BOX OR TAG NO.	REMARKS (Drying time, water loss, depth of penetration, etc., if significant)
0.0'	11.0'		CLAY, medium to high plasticity, stiff, moist black and white.		A	1. After completion, water level in hole was 12.4'. 16 hour check - level was 12.4'
11.0'	23.0'		CLAY, high plasticity, medium stiff, moist to 16', very moist from 16' to 23', scattered gravel, tan and gray.		B	
23.0'	29.0'		CLAY, medium plasticity, soft, wet, sandy, gray-green.		C	
29.0'	35.0'		CLAY, medium plasticity, soft, wet, sandy, gray green.		D	
			T.D. = 35.0'		E	
					F	
					G	

ENG FORM 1836 PREVIOUS EDITIONS ARE OBSOLETE. MAR 71 PROJECT Aubrey Dam HOLE NO. BA 316

DRILLING LOG		SWD		Installation		Fort Worth		SHEET	
PROJECT		AUBREY DAM - OULET WORKS		NO. AND TYPE OF BIT		11		OF SHEETS	
LOCATION		STA 2 +10		DATE FOR ELEVATION INDENTIFICATION		12			
DRILLING AGENCY		USCE		MANUFACTURER'S DESIGNATION OF DRILL		Pallins 1500			
HOLE NO. TAG AND HOLE NUMBER		BA-315		TOTAL NO. OF OVERBURDEN SAMPLES TAKEN		7		UNDISTURBED	
NAME OF DRILLER		MULLINS		TOTAL NUMBER CORE BORES		-			
DIRECTION OF HOLE		VERTICAL		ELEVATION GROUND WATER		99.6			
THICKNESS OF OVERBURDEN		27.7'		DATE HOLE STARTED		19 Sep 80		COMPLETED	
DEPTH DRILLED INTO ROCK		74.8'		ELEVATION TOP OF HOLE		19 Sep 80			
TOTAL DEPTH OF HOLE		104.5'		TOTAL CORE RECOVERY FOR BORING		-			
				SIGNATURE OF DIRECTOR		[Signature]			

ELEVATION	DEPTH	LEGEND	CLASSIFICATION OF MATERIALS (Describe)	SCORE RECORDED	BOX OR TAG NO.	REMARKS (Drying time, water loss, depth of penetration, etc., if significant)
0.0'	13.5'		CLAY		A	1. After completion, water level in hole was 12.4'. 16 hour check - level was 12.4'
0.0'	13.5'		CLAY, MED/HIGH PLASTICITY, STIFF, MOIST; D.C. BRN, SANDY, LIME 1.3'-5.6' 25' ABOVE, COLOR GRADES TO 90'		B	
13.5'	16.1'		5.6'-13.5' LOW PLASTICITY, HARD; D.C., REDDISH YELLOW; SANDY & SILTY, VERY SANDY AFTER 10 G		C	
16.1'	20.2'		GRAVEL COARSE TO FINE, DRY; STRONG BEN VERY SANDY, CLAYEY		D	
20.2'	27.7'		SAND, FINE-GRAINED; DRY REDDISH YELLOW; SLT. GRAVELLY		E	
27.7'	43.1'		GRAVEL COARSE TO FINE; DAMP; VERY SANDY, STRONG BEN TO BEN BY 24.2'		F	
43.1'	43.1'		SHALE:		G	
43.1'	43.1'		27.7'-28.3' WEATHERED; GRAY; MASSIVE; SAND IS OLIVE, VERY FRAGILE E W/CLAY CEMENTED		H	
43.1'	43.1'		28.3'-43.1' UNWEATHERED; D.C. GRAY, MOD. SOFT; MASSIVE; SILTY; NUMEROUS THIN (<0.1" THICK) SAND-STONE SEAMS SCATTERED EXCEPT WHERE NOTED:		I	
43.1'	43.1'		@ 30.0'		J	
43.1'	43.1'		@ 30.3'-30.5'		K	
43.1'	43.1'		@ 31.5'		L	
43.1'	43.1'		33.3'-34.2' VERY SILTY		M	


ENG FORM 1836 PREVIOUS EDITIONS ARE OBSOLETE. MAR 71 PROJECT AUBREY

DRILLING LOG		SWD	INSTALLATION	FWD	SHEET 1 OF 3 SHEETS
PROJECT: AUBREY DAM - OUTLET WORKS		NO. AND TYPE OF BIT: AUGER 6" CORE		DATE OF RECORDING: 13 FEB 81	
1. LOCATION (Compass or Triangulation): STA 25+10		11. MANUFACTURER'S DESIGNATION OF BIT: FWHING 1500		12. TOTAL NO. OF OVERBURDEN SAMPLES TAKEN: 8	
2. DRILLING AGENCY: USCE-C		13. TOTAL NO. OF OVERBURDEN SAMPLES TAKEN: 8		14. TOTAL NUMBER CORE BORES: 16	
3. HOLE NO. (As shown on drawing sheet and log number): BANC-358		15. ELEVATION GROUND WATER @ SEE REMARKS		16. DATE HOLE STARTED: 9 FEB 81	
4. NAME OF DRILLER: HULLINS		17. ELEVATION TOP OF HOLE		18. DATE HOLE COMPLETED: 13 FEB 81	
5. DIRECTION OF HOLE: <input type="checkbox"/> VERTICAL <input type="checkbox"/> INCLINED		19. ELEVATION TOP OF HOLE		20. TOTAL CORE RECOVERY FOR BORING: 99.3	
6. THICKNESS OF OVERBURDEN: 27.7'		21. ELEVATION TOP OF HOLE		22. SIGNATURE OF INSPECTOR: M. VEY	
7. DEPTH DRILLED INTO ROCK: 74.8'		23. ELEVATION TOP OF HOLE		REMARKS (Check time, water level, depth of overburden, etc., if significant)	
8. TOTAL DEPTH OF HOLE: 104.5'		24. SIGNATURE OF INSPECTOR: M. VEY			
ELEVATION	DEPTH	LEGEND	CLASSIFICATION OF MATERIALS (Description)	LOG OR SAMPLE NO.	REMARKS (Check time, water level, depth of overburden, etc., if significant)
0.0'	0.0'		0.0' to 13.5' CLAY	A	1. WATER LEVEL: 84 HRS AFTER BAILING WATER LEVEL WAS @ 27.1'
13.5'	16.1'		13.5' to 16.1' GRAVEL COARSE TO FINE, DRY; STRONG BRN, VERY SANDY, CLAYEY	B	2. JAR SAMPLES: A: 0.0' - 1.3' B: 1.3' - 5.6' C: 5.6' - 10.6' D: 10.6' - 13.5' E: 13.5' - 16.1' F: 16.1' - 20.2' G: 20.2' - 24.2' H: 24.2' - 27.7' I: 27.7' - 28.3' J: 28.3' - 29.0'
16.1'	20.2'		16.1' to 20.2' SAND FINE-GRAINED; DRY; REDDISH YELLOW; SLI GRAVELLY	C	3. DRILLING: AUGER 0.0' - 29.0' SET 30.0' OF CASING. CLEANED HOLE OUT TO 30.0' 6" CORE 30.0' - 105.0'
20.2'	27.7'		20.2' to 27.7' GRAVEL COARSE TO FINE; DAMP; VERY SANDY; STRONG BRN TO BEN BY 24.2'	D	4. E-LOGGING: BORING DRILLED 15' SOUTH OF BANC-358 & WAS E-LOGGED.
27.7'	43.1'		27.7' to 43.1' SHALE:	E	5. BASE OF WEATHERING: @ 28.3'
43.1'	43.1'		27.7' - 28.3' WEATHERED; GRAY, MASSIVE; SAND IS OLIVE, VERY FRAGILE & WEAKLY CEMENTED	F	
43.1'	43.1'		28.3' - 43.1' UNWEATHERED; DK GRAY; MOD SOFT; MASSIVE; SILTY; NUMEROUS THIN (< 0.1" THICK) SANDSTONE SEAMS SCATTERED EXCEPT WHERE NOTED: @ 29.0' @ 30.3' - 32.2' @ 31.5'	G	
43.1'	33.3'		33.3' - 34.2' VERY SILTY	H	

DRILLING LOG		SWD	INSTALLATION	FWD	SHEET 2 OF 3 SHEETS
PROJECT: AUBREY DAM - OUTLET WORKS		NO. AND TYPE OF BIT: AUGER 6" CORE		DATE OF RECORDING: 13 FEB 81	
1. LOCATION (Compass or Triangulation): STA 25+10		11. MANUFACTURER'S DESIGNATION OF BIT: FWHING 1500		12. TOTAL NO. OF OVERBURDEN SAMPLES TAKEN: 8	
2. DRILLING AGENCY: USCE-C		13. TOTAL NO. OF OVERBURDEN SAMPLES TAKEN: 8		14. TOTAL NUMBER CORE BORES: 16	
3. HOLE NO. (As shown on drawing sheet and log number): BANC-358		15. ELEVATION GROUND WATER @ SEE REMARKS		16. DATE HOLE STARTED: 9 FEB 81	
4. NAME OF DRILLER: HULLINS		17. ELEVATION TOP OF HOLE		18. DATE HOLE COMPLETED: 13 FEB 81	
5. DIRECTION OF HOLE: <input type="checkbox"/> VERTICAL <input type="checkbox"/> INCLINED		19. ELEVATION TOP OF HOLE		20. TOTAL CORE RECOVERY FOR BORING: 99.3	
6. THICKNESS OF OVERBURDEN: 27.7'		21. ELEVATION TOP OF HOLE		22. SIGNATURE OF INSPECTOR: M. VEY	
7. DEPTH DRILLED INTO ROCK: 74.8'		23. ELEVATION TOP OF HOLE		REMARKS (Check time, water level, depth of overburden, etc., if significant)	
8. TOTAL DEPTH OF HOLE: 104.5'		24. SIGNATURE OF INSPECTOR: M. VEY			
ELEVATION	DEPTH	LEGEND	CLASSIFICATION OF MATERIALS (Description)	LOG OR SAMPLE NO.	REMARKS (Check time, water level, depth of overburden, etc., if significant)
31.2'	31.2'		@ 31.2' HARD DK GRAY BRN CO ₃	Box 3	
37.2'	37.2'		@ 37.2' - 38.5' VERY SILTY	Box 4	
40.4'	40.4'		@ 40.4' HARD DK GRAY BRN CO ₃	Box 5	
43.1'	43.1'		43.1' to 66.9' SHALE & SANDSTONE: 43.1' - 66.3' INTERLAYERED, UNWEATHERED; DK GRAY TO LT GRAY, MOD. SOFT TO MOD. HARD; MOD. CEMENTED SANDSTONE ZONES AS FOLLOWS: 43.1' - 43.4' 45.7' - 46.0' 46.9' - 48.0' SHALEY 48.5' - 50.1' SHALEY 50.8' - 51.0' 52.3' - 54.5' SHALEY	Box 6	
58.5'	58.5'		58.5' - 59.0'	Box 7	
62.1'	62.1'		@ 62.1' HARD BRN CO ₃	Box 8	
61.9'	61.9'		61.9' - 61.9' SANDSTONE IS HARD & WELL CEMENTED	Box 9	
66.3'	66.3'		66.3' - 66.9' SHALE as above; SANDSTONE IS GREEN GRAY WITH NUMEROUS OYSTER SHELLS (< 1/2" in size)	Box 10	
66.9'	66.9'		66.9' to 99.9' SHALE: 66.9' - 91.0' UNWEATHERED; DK GRAY TO LT GRAY, MOD. SOFT TO MOD. HARD; ARENACEOUS, NUMEROUS THIN & SCAT. SAND & SILT SEAMS; NUMEROUS HARD BRN CONCENTRATIONS & LENSES @ 68.0' FOSSILIFEROUS & VERY SILTY FOR 40.5'	Box 11	

Hole No. BA6C-358


DRILLING LOG	SWD	INSTALLATION	FWD	SHEET 2 OF 3 SHEETS
PROJECT	AUBREY DAM - OUTLET WORKS			
LOCATION (County or Station)	STA 25+10			
DRILLING AGENCY	USOE-C			
HOLE NO. (As shown on drawing title, if no number)	BA6C-358			
NAME OF DRILLER	HULLINS			
DIRECTION OF HOLE	VERTICAL			
THICKNESS OF OVERBURDEN	27.7'			
DEPTH DRILLED INTO ROCK	76.8'			
TOTAL DEPTH OF HOLE	104.5'			

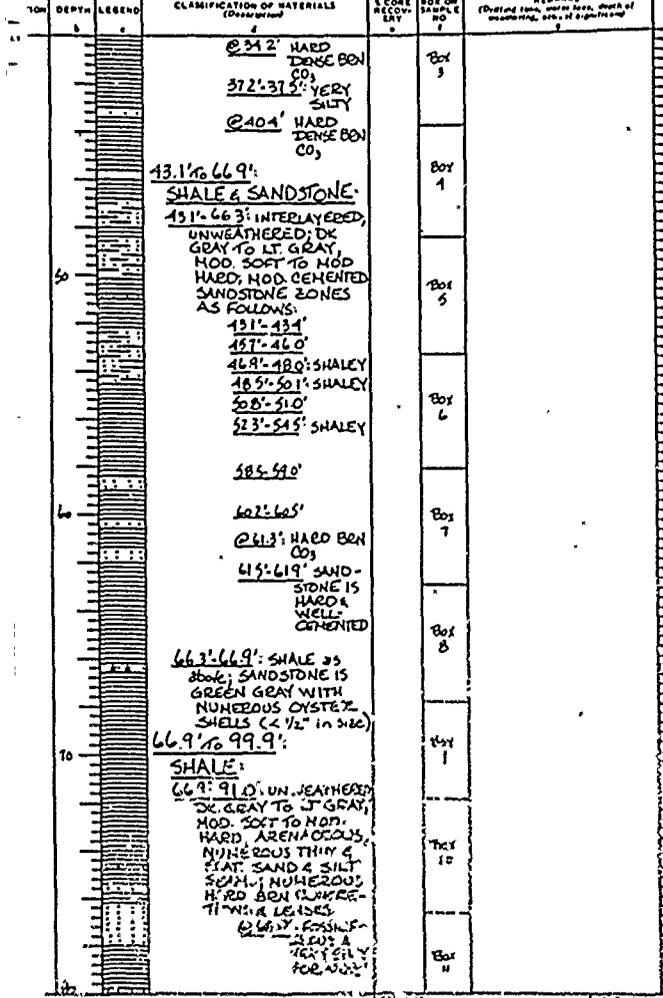

1836 PREVIOUS EDITIONS ARE OBSOLETE. AUBREY DAM HOLE NO. BA6C-358

Hole No. BA6C-358

DRILLING LOG	SWD	INSTALLATION	FWD	SHEET 3 OF 3 SHEETS
PROJECT	AUBREY DAM - OUTLET WORKS			
LOCATION (County or Station)	STA 25+10			
DRILLING AGENCY	USOE-C			
HOLE NO. (As shown on drawing title, if no number)	BA6C-358			
NAME OF DRILLER	BEEWEB			
DIRECTION OF HOLE	VERTICAL			
THICKNESS OF OVERBURDEN	27.7'			
DEPTH DRILLED INTO ROCK	76.8'			
TOTAL DEPTH OF HOLE	104.5'			

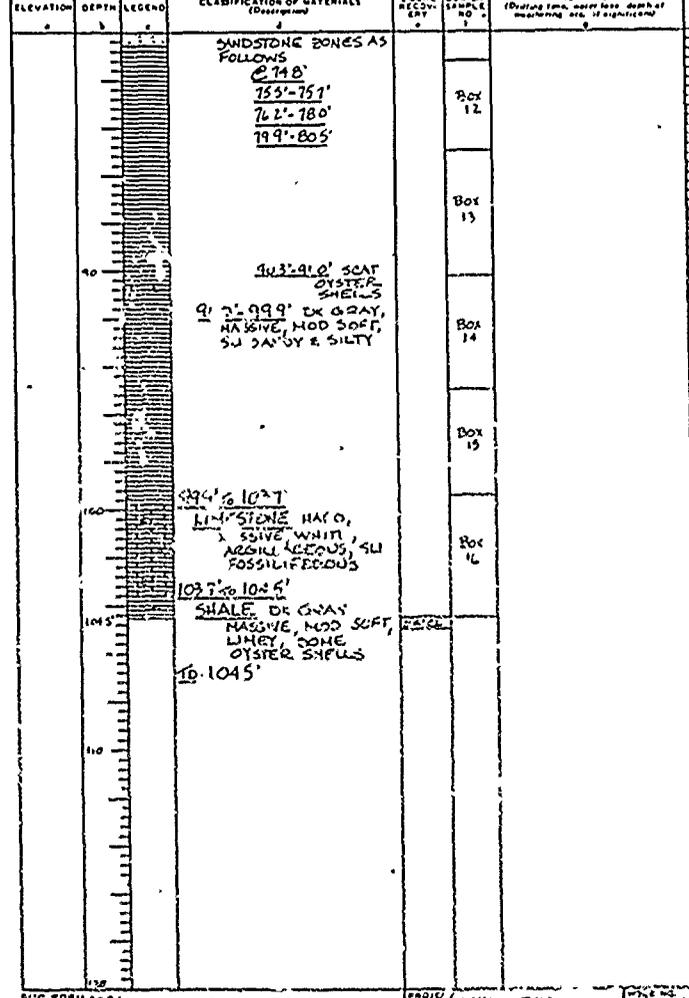

1836 PREVIOUS EDITIONS ARE OBSOLETE. AUBREY DAM HOLE NO. BA6C-358

RECORD DRAWING WORK AS BUILT

U.S. ARMY ENGINEER DISTRICT, FORT WORTH	
NAME OF ENGINEER	
DATE	
RAY ROBERTS LAKE	
SLW FORK, TRINITY RIVER, TEXAS	
EMBANKMENT, SPILLWAY AND	
OUTLET WORKS	
LOGS OF BORINGS	
BA-310 AND BA6C-358	
DATE	27

TO ACCOMPANY FOUNDATION REPORT

H-1 No. **BAGC-359**

DRILLING LOG		INSTALLATION	
PROJECT AUBREY DAM - OUTLET WORKS		INSTALLATION FWD	
LOCATION (Compass or Station) STA 27+20		NO. AND TYPE OF BIT AUGER; 6" CORE	
DRILLING AGENCY USCE-C		FALLING 1500	
HOLE NO. (As shown on drawing sheet and site number) BAGC-359		TOTAL NO. OF OVERBURDEN SAMPLES TAKEN INSTALLED 5 UNINSTALLED 0	
NAME OF DRILLER MULLINS		TOTAL NUMBER CORE BOXES 3	
DIRECTION OF HOLE <input checked="" type="checkbox"/> VERTICAL <input type="checkbox"/> INCLINED DEG FROM VERT		ELEVATION GROUND WATER * SEE REMARKS	
THICKNESS OF OVERBURDEN 17.0'		DATE HOLE STARTED 18 FEB 61 COMPLETED 19 FEB 61	
DEPTH DRILLED INTO ROCK 5.5'		ELEVATION TOP OF HOLE	
TOTAL DEPTH OF HOLE 22.5'		TOTAL CORE RECOVERY FOR BORING 100%	
		SIGNATURE OF INSPECTOR MCVEY	

ELEVATION	DEPTH	LEGEND	CLASSIFICATION OF MATERIALS (Description)	3 CORE RECON. NO.	BOX OR SAMPLE NO.	REMARKS (Detail top, water level, depth of weathering, etc., if significant)
00'	00'		00' to 17.0' CLAY: 00'-3.0' MED/HIGH PLASTICITY; HARD; DRY; BRN; SANDY & SILTY 3.0'-4.9' as above; VERY STIFF; DAMP; BRN 4.9'-8.0' MED/HIGH PLASTICITY; HARD; DRY; YELLOW BRN & BRN; LIMY; SILTY & SANDY 8.0'-14.1' MED/LOW PLASTICITY; V. STIFF; DRY; RED YELLOW; SILTY & SANDY 14.1'-17.0' as above; STIFF; DAMP		A	1. WATER LEVEL: 24 HRS AFTER BAILING WATER LEVEL WAS @ 27.4'
17.0'	18.7'		17.0' to 18.7' LIMESTONE HARD; MASSIVE, WEATHER-STAINED, WHITE & YELLOW-BRN; FOSSILIFEROUS; 0.1" THICK LIMONITE SEAM @ BASE		Box 1	2. JAR SAMPLES A: 00'-3.0' B: 3.0'-4.9' C: 4.9'-8.0' D: 8.0'-14.1' E: 14.1'-17.0'
18.7'	31.5'		18.7' to 31.5' SHALE: 18.7'-28.9' WEATHERED; YELLOW BRN & GRAY; SOFT TO MOD. SOFT MASSIVE, SCAT. THIN SILT & SAND SEAMS, SLT TO NON-CALC 28.9'-27.2' VERY SANDY ZONE 27.2'-21.6' MOD. HARD LIMONITE SEAM 21.6'-27.7' HARD LIMONITE SEAM 27.7'-28.9' THIN VERY SHELLY & SANDY 28.9'-31.5' UNWEATHERED DK GRAY; FOSSILIFEROUS; 3" AMMONITE @ 31.0'		Box 2 Box 3	3. DRILLING: AUGERED 0.0'-17.5'. AUGER REFUSAL @ 17.5'. 6" CORE 17.5'-32.5' LEFT 1' OF CORE IN BORING (31.5'-32.5') ON LAST RUN. BAILED BORING. 4. BASE OF WEATHERING @ 28.7'

ENG FORM 1836 PREVIOUS EDITIONS ARE OBSOLETE MAR 71 PROJECT **AUBREY DAM** HOLE NO. **BAGC-359**


Hole No. **2**

DRILLING LOG		INSTALLATION	
PROJECT AUBREY DAM - OUTLET WORKS		INSTALLATION FWD	
LOCATION (Compass or Station) STA 28+20		NO. AND TYPE OF BIT AUGER; 6" CORE	
DRILLING AGENCY USCE-C		FALLING 15	
HOLE NO. (As shown on drawing sheet and site number) BAGC-360		TOTAL NO. OF OVERBURDEN SAMPLES TAKEN INSTALLED 1 UNINSTALLED 0	
NAME OF DRILLER MULLINS		TOTAL NUMBER CORE BOXES 3	
DIRECTION OF HOLE <input checked="" type="checkbox"/> VERTICAL <input type="checkbox"/> INCLINED DEG FROM VERT		ELEVATION GROUND WATER * SEE R	
THICKNESS OF OVERBURDEN 15.3'		DATE HOLE STARTED 19 FEB 61	
DEPTH DRILLED INTO ROCK 14.7'		ELEVATION TOP OF HOLE	
TOTAL DEPTH OF HOLE 30.0'		TOTAL CORE RECOVERY FOR BORING	
		SIGNATURE OF INSPECTOR MCVEY	


ELEVATION	DEPTH	LEGEND	CLASSIFICATION OF MATERIALS (Description)	3 CORE RECON. NO.	BOX OR SAMPLE NO.	REMARKS (Detail top, water level, depth of weathering, etc., if significant)
00'	00'		00' to 15.3' CLAY: 00'-2.4' MED/HIGH PLASTICITY; STIFF; DAMP; DK BRN; SANDY & SILTY 2.4'-7.4' HIGH/MED PLASTICITY; STIFF; DAMP TO MOIST; RED YELLOW; SILTY & SANDY; LIME NODULES 7.4'-12.7' as above; MED/LOW PLASTICITY; MED STIFF; SANDIER 12.7'-15.3' MED/HIGH PLASTICITY; HARD; DRY; YELLOW BRN; SANDY & SILTY; LIMY		A	1. WATER LEVEL: 16 HRS 21 WATER @ 23.1'
15.3'	17.3'		15.3' to 17.3' LIMESTONE WHITE & YELLOW BRN STAINS; HARD; MASSIVE; FOSSILIFEROUS		Box 1	2. JAR SA A: 0.0'-2' B: 2.4'-7' C: 7.4'-11' D: 12.7'-
17.3'	29.7'		17.3' to 29.7' SHALE WEATHERED TO YELLOW BRN & LT. GRAY TO 29.2'; THEN UNWEATHERED DK GRAY; MASSIVE, MOD. SOFT; SILTY & SANDY; NUMEROUS SCAT. THIN SAND SEAMS; FEW LIMONITE CONCRETIONS 26.3'-26.7' MOD. CEMENTED SANDSTONE 27.8'-28.1' MOD. CEMENTED SANDSTONE		Box 2 Box 3	3. DRILLING AUGERED 6" CORE BAILED @ 29.2'
29.7'	29.7'		10' to 29.7'		Box 3	4. E-LOGG C. OG HC 27' NORTH BAGC-360

ENG FORM 1836 PREVIOUS EDITIONS ARE OBSOLETE MAR 71 PROJECT **AUBREY DAM**

LOG NO. SWD	INSTALLATION FWD	SHEET 1 OF 3 SHEETS
PROJECT AUBREY DAM - OUTLET WORKS		
10 SIZE AND TYPE OF BIT: 8" AUGER, 6" CORE		
11 LOCATION (Elevation, Position, etc.) STA 32+00		
12 MANUFACTURER'S DESIGNATION OF DRILL FAILING 1500		
13 TOTAL NO. OF OVERBURDEN SAMPLES TAKEN 1 0		
14 TOTAL NUMBER CORE BOXES 5		
15 ELEVATION GROUND WATER # SEE REMARKS		
16 DATE MOLE STARTED 14 FEB 81 COMPLETED 19 FEB 81		
17 ELEVATION TOP OF HOLE		
18 TOTAL CORE RECOVERY FOR BORING 98%		
19 SIGNATURE OF INSPECTOR McVEY		

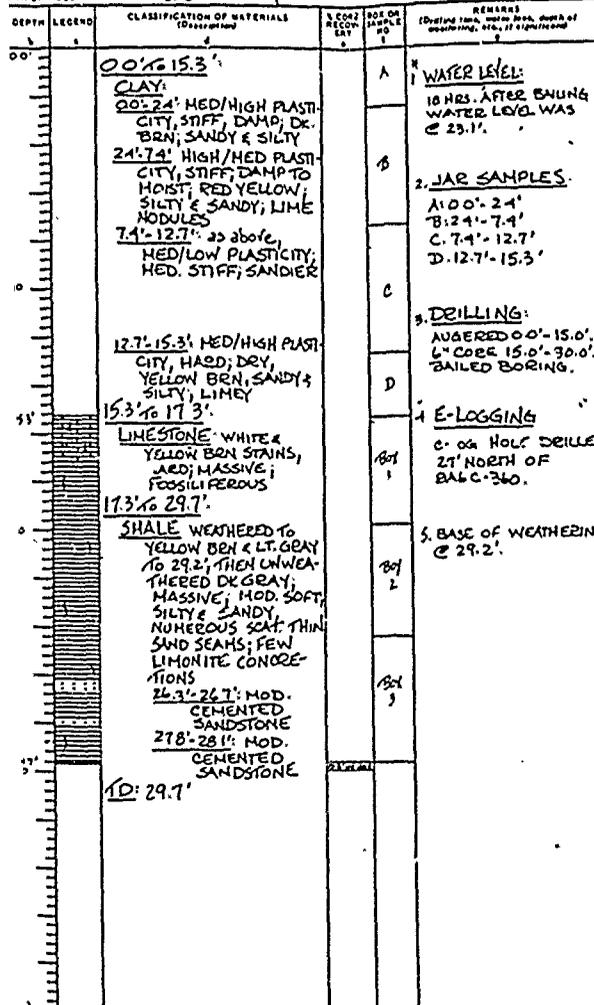

LOG NO. SWD	INSTALLATION FWD	SHEET 1 OF 1 SHEETS
PROJECT AUBREY DAM - OUTLET WORKS		
10 SIZE AND TYPE OF BIT: 8" AUGER, 6" CORE		
11 LOCATION (Elevation, Position, etc.) STA 32+00		
12 MANUFACTURER'S DESIGNATION OF DRILL FAILING 1500		
13 TOTAL NO. OF OVERBURDEN SAMPLES TAKEN 3 0		
14 TOTAL NUMBER CORE BOXES 3		
15 ELEVATION GROUND WATER # SEE REMARKS		
16 DATE MOLE STARTED 29 JAN 81 COMPLETED 30 JAN 81		
17 ELEVATION TOP OF HOLE		
18 TOTAL CORE RECOVERY FOR BORING 99%		
19 SIGNATURE OF INSPECTOR		

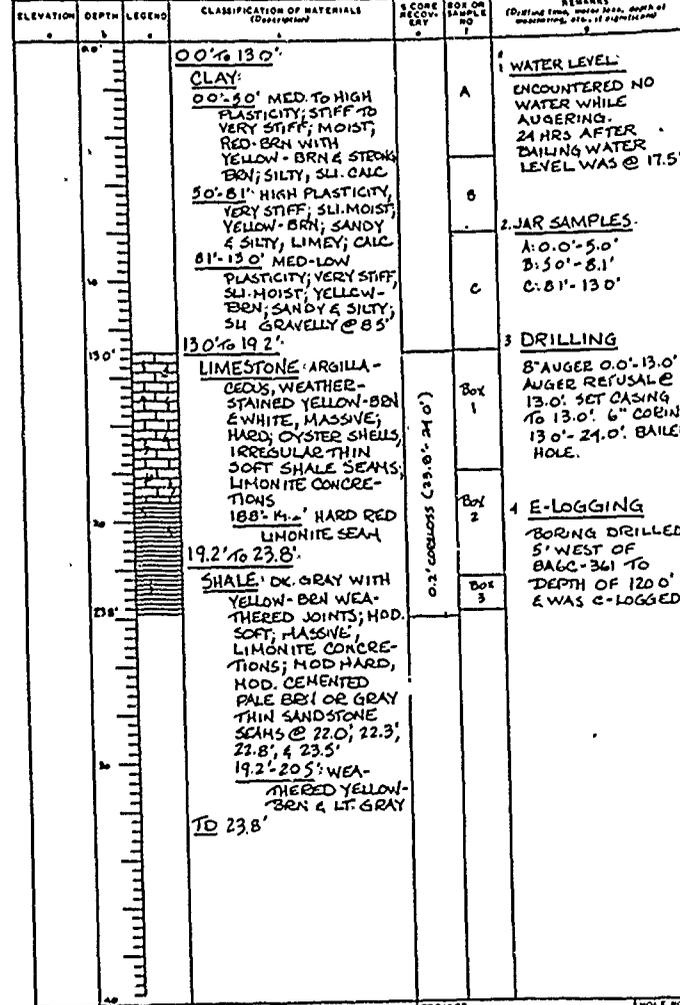

Male No. 8A6C-361

SYMBOL	SWD	INSTALLATION	FWD	SHEET 1 OF 2 SHEETS
PROJECT	OUTLET WORKS	NO. SIZE AND TYPE OF BIT	8" AUGER 6" CORE	11. DATE FOR ELEVATION QUANTIFICATION
LOCATION		12. MANUFACTURER'S DESIGNATION OF DRILL	FALLING 1500	12. TOTAL NO. OF OVERBURDEN SAMPLES TAKEN
DRILLING AGENCY	USOEC	13. TOTAL NO. OF OVERBURDEN SAMPLES TAKEN	3	13. TOTAL NUMBER CORE BOXES
HOLE NO. (As shown on drawing title and field notes)	8A6C-361	14. ELEVATION GROUND WATER	SEE REMARKS	14. DATE MOLE
NAME OF CHILLER	MULLINS	15. DATE MOLE	24 JAN 81	15. ELEVATION TOP OF MOLE
DIRECTION OF MOLE	CERTICAL	16. DATE MOLE	2 FEB 81	16. TOTAL CORE RECOVERY FOR BORING
THICKNESS OF OVERBURDEN	6.7'	17. SIGNATURE OF INSPECTOR		17. SIGNATURE OF INSPECTOR
DEPTH DRILLED INTO ROCK	21.9'			
TOTAL DEPTH OF HOLE	28.6'			

CLASSIFICATION OF MATERIALS (Disturbance)	SCORE RECOVERY	BOX OR SAMPLE NO.	REMARKS (Drilling time, water used, depth of overburden, etc., if significant)
0.0' to 13.0' CLAY 0.0'-5.0' MED. TO HIGH PLASTICITY; STIFF TO VERY STIFF; MOIST; RED-BRN WITH YELLOW-BRN & STRONG BEN; SILTY; SLI. CALC 5.0'-8.1' HIGH PLASTICITY, VERY STIFF; SLI. MOIST; YELLOW-BRN; SANDY & SILTY; LIMY; CALC 8.1'-13.0' MED. LOW PLASTICITY; VERY STIFF; SLI. MOIST; YELLOW-BRN; SANDY & SILTY; SH. GRAVELLY @ 8.5'		A	1. WATER LEVEL ENCOUNTERED NO WATER WHILE AUGERING. 24 HRS. AFTER BAILING WATER LEVEL WAS @ 17.5'
		B	2. JAR SAMPLES A 0.0'-5.0' B 5.0'-8.1' C 8.1'-13.0'
13.0' to 19.2' LIMESTONE ARGILLA - OCEOUS, WEATHER-STAINED YELLOW-BRN & WHITE, MASSIVE; HARD; OYSTER SHELLS, IRREGULAR THIN SOFT SHALE SEAMS, LIMONITE CONCRETIONS 188'-19.2' HARD RED LIMONITE SEAM		Box 1	3. DRILLING 8" AUGER 0.0'-13.0' AUGER REFUSAL @ 13.0'. SET CASING TO 13.0'. 6" CORING 13.0'-24.0'. BAILED HOLE
19.2' to 23.8' SHALE DK. GRAY WITH YELLOW-BRN WEATHERED JOINTS; MOD. SOFT; MASSIVE; LIMONITE CONCRETIONS; MOD. HARD; MOD. CEMENTED PALE BRN OR GRAY THIN SANDSTONE SEAMS @ 22.0'; 22.3'; 22.8'; & 23.5' 19.2'-20.5' WEATHERED YELLOW-BRN & LT. GRAY		Box 2	4. E-LOGGING BORING DRILLED 5' WEST OF 8A6C-361 TO DEPTH OF 120.0' & WAS C-LOGGED
		Box 3	

1. EDITIONS ARE OBSOLETE PROJECT AUBREY DAM HOLE NO. 8A6C-361

Male No. 8A6C-362

SYMBOL	SWD	INSTALLATION	FWD	SHEET 1 OF 2 SHEETS
PROJECT	AUBREY DAM-OUTLET WORKS	NO. SIZE AND TYPE OF BIT	8" AUGER 6" CORE	11. DATE FOR ELEVATION QUANTIFICATION
LOCATION	STA. 33+95	12. MANUFACTURER'S DESIGNATION OF DRILL	FALLING 1500	12. TOTAL NO. OF OVERBURDEN SAMPLES TAKEN
DRILLING AGENCY	USOEC	13. TOTAL NO. OF OVERBURDEN SAMPLES TAKEN	3	13. TOTAL NUMBER CORE BOXES
HOLE NO. (As shown on drawing title and field notes)	8A6C-362	14. ELEVATION GROUND WATER	SEE REMARKS	14. DATE MOLE
NAME OF CHILLER	MULLINS	15. DATE MOLE	30 JAN 81	15. ELEVATION TOP OF MOLE
DIRECTION OF MOLE	CERTICAL	16. DATE MOLE	2 FEB 81	16. TOTAL CORE RECOVERY FOR BORING
THICKNESS OF OVERBURDEN	6.7'	17. SIGNATURE OF INSPECTOR		17. SIGNATURE OF INSPECTOR
DEPTH DRILLED INTO ROCK	21.9'			
TOTAL DEPTH OF HOLE	28.6'			

ELEVATION	DEPTH	LEGEND	CLASSIFICATION OF MATERIALS (Disturbance)	SCORE RECOVERY	BOX OR SAMPLE NO.	REMARKS (Drilling time, water used, depth of overburden, etc., if significant)
0.0'	0.0'		0.0' to 6.7' CLAY 0.0'-1.3' MED PLASTICITY; STIFF; DRY, DK. BEN, SANDY & SILTY 1.3'-2.2' HIGH PLASTICITY; STIFF, SLI. MOIST, STRONG BEN 2.2'-6.7' MED. LOW PLASTICITY, VERY STIFF, DRY, RED-DISH, YELLOW; SANDY & SILTY; LIMY		A	1. WATER LEVEL BAILED BORING 2 FEB 81 3 FEB 81 WL = 21.0' 4 FEB 81 WL = 20.2' 6 FEB 81 WL = 19.1' 9 FEB 81 WL = 18.9'
6.7'	6.7'		6.7' to 12.6' LIMESTONE ARGILLA - OCEOUS, WEATHER-STAINED YELLOW-BRN & WHITE; MASSIVE; HARD; OYSTER SHELLS 12.3'-12.6' HARD RED LIMONITE SEAM		Box 1	2. JAR SAMPLES A 0.0'-1.3' B 1.3'-2.2' C 2.2'-6.7'
12.6'	12.6'		12.6' to 24.1' SHALE WEATHERED YELLOW-BRN & GRAY TO UNWEATHERED DK. GRAY @ 24.3'. SOFT TO MOD. SOFT; MASSIVE; LIMONITE CONCRETIONS; SOFT THIN SANDY SEAMS; MOD. HARD; MOD. CEMENTED PALE BRN SANDSTONE SEAMS @ 15.6'-16.0' & @ 16.9'		Box 2	3. DRILLING 8" AUGER 6" CORE
24.1'	24.1'		24.1' to 28.3' SANDSTONE & SHALE INTERBEDDED DK. GRAY SOFT TO MOD. SOFT UNWEATHERED SHALE & PALE BRN MOD. HARD MOD. CEMENTED SANDSTONE 24.1'-24.2' HARD, WELL-CEMENTED SANDSTONE 28.1'-28.3' HARD, WELL-CEMENTED SANDSTONE		Box 3	4. E-LOGGING BORING DRILLED 5' WEST OF 8A6C-362 TO DEPTH OF 110.0' & WAS C-LOGGED
28.3'	28.3'				Box 4	
					Box 5	

ENG FORM 1836 MAR 71 PREVIOUS EDITIONS ARE OBSOLETE PROJECT AUBREY DAM HOLE NO. 8A6C-362

RECORD DRAWING-WORK AS BUILT

SYMBOL	LOG NO.	ACTION	DATE	DESCRIPTION OF REVISION
U.S. ARMY ENGINEER DISTRICT, FORT WORTH CORPS OF ENGINEERS FORT WORTH, TEXAS				
DESIGNED BY	RAY ROBERTS LAKE ELM FORK, TRINITY RIVER, TEXAS EMBANKMENT, SPILLWAY AND OUTLET WORKS LOGS OF BORINGS 8A6C-359, 8A6C-360, 8A6C-361 AND 8A6C-362			
REVIEWED BY				
SUBMITTED BY	INVITATION NO. DACW63-82-B-0025 DATE MAR 1982			
ENGINEER	CONTRACT NO. DACW63-82-C-0093		SHEET NO.	SEQUENCE NO.
			30	30

TO ACCOMPANY FOUNDATION REPORT

CONTRACT NO. DACW63-82-C-0093

Hole No. BA-363

DRILLING LOG PROJECT: AUBREY DAM - OUTLET WORKS LOCATION (Company or Station): STA. 12+50 DRILLING AGENCY: USCE-C HOLE NO. (As shown on drawing sheet and No. marked on hole): BA-363 NAME OF DRILLER: MULLINS DIRECTION OF HOLE: <input checked="" type="checkbox"/> VERTICAL <input type="checkbox"/> INCLINED <input type="checkbox"/> SEE FROM VERT. THICKNESS OF OVERBURDEN: 24.6' DEPTH DRILLED INTO ROCK: 1.4' TOTAL DEPTH OF HOLE: 26.0'	INSTALLATION FWD SHEET 1 OF 1 SHEETS SIZE AND TYPE OF BIT: AUGER DESIGN FOR ELEVATION (HEIGHT FROM MSL): MANUFACTURER'S DESIGNATION OF DRILL: FAILING 1500 TOTAL NO. OF OVERBURDEN SAMPLES TAKEN: 0 (DISTURBED) 0 (UNDISTURBED) TOTAL NUMBER CORE BOSES: N/A ELEVATION GROUND WATER: SEE REMARKS DATE HOLE STARTED: 1 JAN 81 COMPLETED: 1 JAN 81 ELEVATION TOP OF HOLE: TOTAL CORE RECOVERY FOR BORING: N/A SIGNATURE OF INSPECTOR: MEVEY
--	--

ELEVATION	DEPTH	LEGEND	CLASSIFICATION OF MATERIALS (Description)	% CORE RECOVERY	BOX OR SAMPLE NO.	REMARKS (Drilling time, total hole, depth of overburden, etc., if significant)
00.0'	00.0'		00' to 24.6' CLAY 00'-4.3' LOW PLASTICITY @ SURFACE, GRADING TO HIGH PLASTICITY BY 1.0'; SOFT TO MED. STIFF, MOIST; DK BEN; SILTY 4.3'-16.0' HIGH-MED. PLASTICITY; STIFF BECOMING SOFT BY 1.0'; MOIST; YELLOW BEN & LT GRAY; SANDY & SILTY; SOME FINE GRAVELS			1. WATER LEVEL: BORING MAKING WATER @ 13.0'. WATER LEVEL IMMEDIATELY AFTER DRILLING WAS @ 7.0'. 24 HRS AFTER DRILLING WATER LEVEL WAS @ 4.8'. 6 FEB 81: WL 4.6' 9 FEB 81: WL 4.6'
			16.0'-23.0' GRAY & STRONG BEN; AS ABOVE; THIN YELLOW SAND SEAM AFTER 20.0'			2. NO SAMPLES TAKEN.
			23.0'-24.6' DK. GRAY, AS ABOVE, STIFF			3. DRILLING NOTE BORING OFFSET 17' NE.
			24.6' to 26.0' SHALE DK. GRAY; DRY; MOD SOFT; BLOCKY CLEAVAGE.			
			ID: 26.0'			

ENG FORM 1836 MAR 71 PREVIOUS EDITIONS ARE OBSOLETE. PROJECT: AUBREY DAM. HOLE NO. BA-363

Hole No. BA-364

DRILLING LOG PROJECT: AUBREY DAM - OUTLET WORKS LOCATION (Company or Station): STA. 12+50 DRILLING AGENCY: USCE-C HOLE NO. (As shown on drawing sheet and No. marked on hole): BA6C-364 NAME OF DRILLER: MULLINS DIRECTION OF HOLE: <input checked="" type="checkbox"/> VERTICAL <input type="checkbox"/> INCLINED <input type="checkbox"/> SEE FROM VERT. THICKNESS OF OVERBURDEN: 12.0' DEPTH DRILLED INTO ROCK: 23.0' TOTAL DEPTH OF HOLE: 35.0'	INSTALLATION FWD SHEET 1 OF 1 SHEETS SIZE AND TYPE OF BIT: AUGER DESIGN FOR ELEVATION (HEIGHT FROM MSL): MANUFACTURER'S DESIGNATION OF DRILL: FAILING 1500 TOTAL NO. OF OVERBURDEN SAMPLES TAKEN: 1 (DISTURBED) 1 (UNDISTURBED) TOTAL NUMBER CORE BOSES: 4 ELEVATION GROUND WATER: SEE REMARKS DATE HOLE STARTED: 23 FEB 81 COMPLETED: 23 FEB 81 ELEVATION TOP OF HOLE: TOTAL CORE RECOVERY FOR BORING: SIGNATURE OF INSPECTOR: MEVEY
---	---

ELEVATION	DEPTH	LEGEND	CLASSIFICATION OF MATERIALS (Description)	% CORE RECOVERY	BOX OR SAMPLE NO.	REMARKS (Drilling time, total hole, depth of overburden, etc., if significant)
00.0'	00.0'		00' to 8.0' CLAY 0.0'-2.1' LOW PLASTICITY, STIFF, MOIST, BLACK, SILTY & SANDY 2.1'-5.1' HIGH PLASTICITY, STIFF, MOIST; DK. BEN, SILTY 5.1'-8.0' HIGH PLASTICITY, HARD, SL DAMP, YELLOW BEN & LT GRAY, LIMY; SANDY & SILTY 8.0' to 12.0' GRAVEL : WELL-GRADED, MED. DENSE; SUB-ROUNDED; SANDY; CLAYEY; BRN			1. WATER LEVEL: 24 HRS. AFTER WATER LEVEL 8.5'
			12.0' to 16.0' SHALE & SANDSTONE SLI. WEATHERED; YELLOW BEN & LT. TO DK. GRAY; SOFT TO MOD SOFT MASSIVE; SOME SAND & GRAVEL TO 14.0' (REWORKED OR DUE TO AUGER)			2. JAR SAMPLING A: 0.0' - 2.0' B: 2.1' - 5.1' C: 5.1' - 8.0' D: 8.0' - 12.0' E: 12.0' - 16.0'
			16.0' to 35.0' SHALE : UNWEATHERED; DK GRAY; MOD SOFT; MASSIVE; SILTY & SANDY; SLI. FOSSILIFEROUS WITH PLANT REMAINS & CARBON; ABUNDANT MOD. HARD MOD CEMENTED SANDSTONE SEAMS 16.9'-17.4' SANDSTONE 18.1'-18.8' SANDSTONE 20.8'-21.0' SANDSTONE 21.1'-21.4' SANDSTONE 21.7'-21.9' SANDSTONE 22.2'-22.5' SANDSTONE 23.8'-24.0' SANDSTONE 24.3'-24.8' SANDSTONE 24.9'-25.5' SANDSTONE 26.6'-32.4' SANDSTONE 32.6'-34.7' SHALEY SANDSTONE 34.7' HARD BRN CONCRETION			3. DRILLING AUGERED & SET CASIN CLEANED & CORED 16.0' BAILED TO 1. BASE OF WEAR @ 16.0'
			ID: 35.0'			

ENG FORM 1836 MAR 71 PREVIOUS EDITIONS ARE OBSOLETE. PROJECT: AUBREY DAM

Hole No. BA6C-365

SWD	INSTALLATION	FWD
1. OUTLET WORKS	10. SIZE AND TYPE OF BIT AUGER, L-CORE	11. DATE FOR ELEVATION INFORMATION - HWS
USCC-C	12. MANUFACTURER DESIGNATION OF DRILL	FALLING 1500
8A6C-365	13. TOTAL NO. OF OVER BURDEN SAMPLES TAKEN	0
MULLINS	14. TOTAL NUMBER CORE BOXES	3
	15. ELEVATION GROUND WATER # SEE REMARKS	
	16. DATE HOLE STARTED	6 FEB 81
	17. ELEVATION TOP OF HOLE	
	18. TOTAL CORE RECOVERY FOR BORING	98.9
	19. SIGNATURE OF INSPECTOR	MCVEY

ELEVATION	DEPTH	LEGEND	CLASSIFICATION OF MATERIALS (Description)	SCORE RECOVERY %	BOX OR SAMPLE NO.	REMARKS (Drilling time, water loss, depth of overburden, etc., if significant)
00' to 12.2'			CLAY: 00'-24' LOW PLASTICITY, MED. STIFF, MOIST, YELLOW-BRN. VERY SANDY, GRAVELLY 24'-35' MED/HIGH PLASTICITY, MED. STIFF, MOIST, BROWNISH-GRAY, SANDY, SILT, GRAVELLY 35'-83' MED/HIGH PLASTICITY, HARD; DRY; BRN GRAY; SANDY & SILTY 83'-12.2' MED/HIGH PLASTICITY, HARD; DRY, YELLOW-BRN & LT. GRAY; SANDY & SILTY 12.2' to 16.0' GRAVEL: 12.2'-13.1' COARSE TO FINE; ROUND; DRY; STRONG BRN; SANDY & CLAYEY 13.1'-16.0' as above; MOIST; YELLOW-BRN & LT. GRAY 16.0' to 34.7'		A, B, C, D, E, F, G	1. WATER LEVEL: 72 HRS. AFTER BAILING WATER LEVEL WAS @ 14.0'. 2. JAR SAMPLES: A: 00'-24' B: 24'-35' C: 35'-83' D: 83'-12.2' E: 12.2'-13.1' F: 13.1'-16.0' G: 16.0'-20.0' 3. DRILLING: NOTE: BORING OFFSET 50' WEST AUGER 00'-16.0' SET 19' OF CASING. CLEANED OUT TO 20.0'. L-CORE 20.0'-35.0'
TO: 34.7'			SHALE & SANDSTONE: INTERLAYERED; UNWEATHERED; DK. GRAY TO LT. GRAY; MOD. SOFT TO MOD. HARD; MOD. CEMENTED; MASSIVE 23.5'-24.6' SANDSTONE SEAM		Box 1, Box 2, Box 3	

THIS EDITIONS ARE OBSOLETE. PROJECT: AUBREY DAM. HOLE NO.: BA6C-365

Hole No. BA6C-366

SWD	INSTALLATION	FWD
1. PROJECT	10. SIZE AND TYPE OF BIT AUGER, L-CORE	11. DATE FOR ELEVATION INFORMATION - HWS
AUBREY DAM - OUTLET WORKS	12. MANUFACTURER DESIGNATION OF DRILL	FALLING 1500
USCC-C	13. TOTAL NO. OF OVER BURDEN SAMPLES TAKEN	0
8A6C-366	14. TOTAL NUMBER CORE BOXES	2
	15. ELEVATION GROUND WATER # SEE REMARKS	
	16. DATE HOLE STARTED	4 FEB 81
	17. ELEVATION TOP OF HOLE	
	18. TOTAL CORE RECOVERY FOR BORING	96.9
	19. SIGNATURE OF INSPECTOR	MCVEY

ELEVATION	DEPTH	LEGEND	CLASSIFICATION OF MATERIALS (Description)	SCORE RECOVERY %	BOX OR SAMPLE NO.	REMARKS (Drilling time, water loss, depth of overburden, etc., if significant)
00' to 17.0'			CLAY: 00'-31' HIGH PLASTICITY, STIFF, MOIST, RED & REDDISH-BRN, SANDY & SILTY 31'-12.3' MED-HIGH PLASTICITY, HARD; DRY, YELLOW-BRN & LT. GRAY, SANDY & SILTY 12.3'-17.0' LOW-MED PLASTICITY, MED STIFF TO SOFT, MOIST, PALE BRN & YELLOW-BRN, VERY SANDY, SAND SEAMS 17.0' to 25.0' GRAVEL: 17.0'-19.8' FINE TO COARSE, ROUND, VERY MOIST TO WET, STRONG BRN; SANDY & CLAYEY 19.8'-25.0' as above; YELLOW-BRN & LT. GRAY, VERY MOIST 25.0' to 34.6'		A, B, C, D, E, F	1. WATER LEVEL: 18 HRS. AFTER BAILING WATER LEVEL WAS @ 17.8'. 72 HRS. AFTER BAILING WATER LEVEL WAS @ 17.5'. 2. JAR SAMPLES: A: 00'-31' B: 31'-81' C: 81'-12.3' D: 12.3'-17.0' E: 17.0'-19.8' F: 19.8'-25.0' 3. DRILLING: NOTE GRAVEL ON SURFACE @ BORING LOCATION 8" AUGER 00'-25.0' AUGER REFUSAL @ 25.0' SET CASING TO 25.0' 6" COBBING 25.0'-35.0'
TO: 34.6'			SHALE ARENACEOUS, SOFT TO MOD. SOFT, UNWEATHERED, MASSIVE; BENTONITE-LOOKING @ 25.4' SOFT SANDSTONE SEAMS; SOFT DOLOMITE SEAMS; MANY THIN SCAT. SAND SEAMS, MOD. SOFT TO MOD. HARD, MOD. CEMENTED, & LT. GRAY 25.0'-25.4' VERY HARD BRN DOLOMITE SEAM 26.1'-26.3' SANDSTONE 27.8' HARD DOLOMITE 28.5'-29.2' SHALEY SANDSTONE 31.3'-31.6' SANDSTONE 31.9'-32.0' SANDSTONE 32.0'-32.1' DOLOMITE 32.8'-34.6' SHALEY SANDSTONE		Box 1, Box 2	


ENG FORM 1236 PREVIOUS EDITIONS ARE OBSOLETE. PROJECT: AUBREY DAM. HOLE NO.: BA6C-366


RECORD DRAWING-WORK AS BUILT

REV	NO.	ACTION	DATE	DESCRIPTION OF REVISION
U.S. ARMY ENGINEER DISTRICT, FORT WORTH CORPS OF ENGINEERS FORT WORTH, TEXAS				
8A RAY ROBERTS LAKE ELM FORK, TRINITY RIVER, TEXAS EMBANKMENT, SPILLWAY AND OUTLET WORKS LOGS OF BORINGS 8A-363, 8A6C-364, 8A6C-365 AND 8A6C-366				
DESIGNED BY:		INVESTIGATION NO. DACW63-82-0-0025 DATE: MAR, 1982		
DRAWN BY:		CONTRACT NO. DACW63-82-C-0089		
REVIEWED BY:		DRAWING NUMBER		
SUBMITTED BY:		SHEET NO. 30		
ENGINEER:		CONTRACT NO. DACW63-82-C-0089		

CONTRACT NO. DACW63-82-C-0089

G
F
E
D
C
B
A

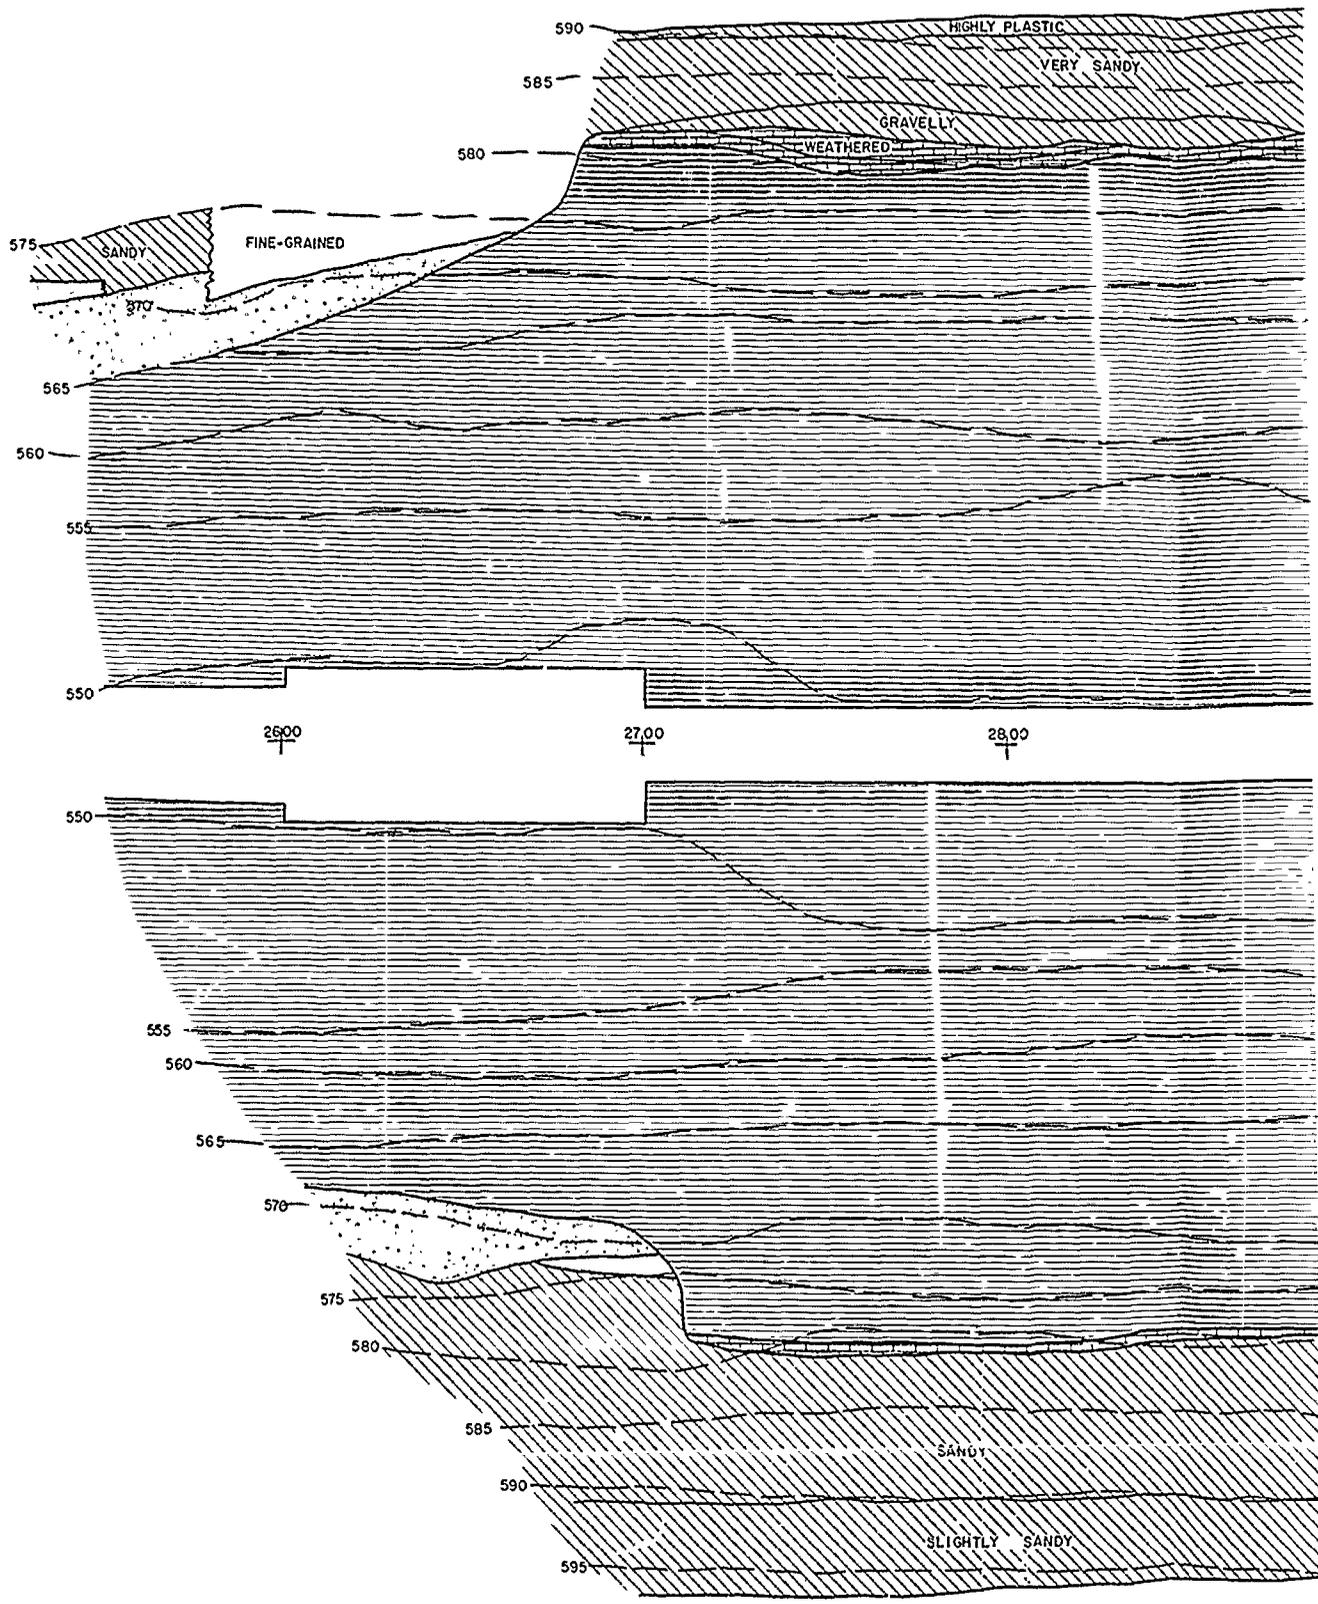


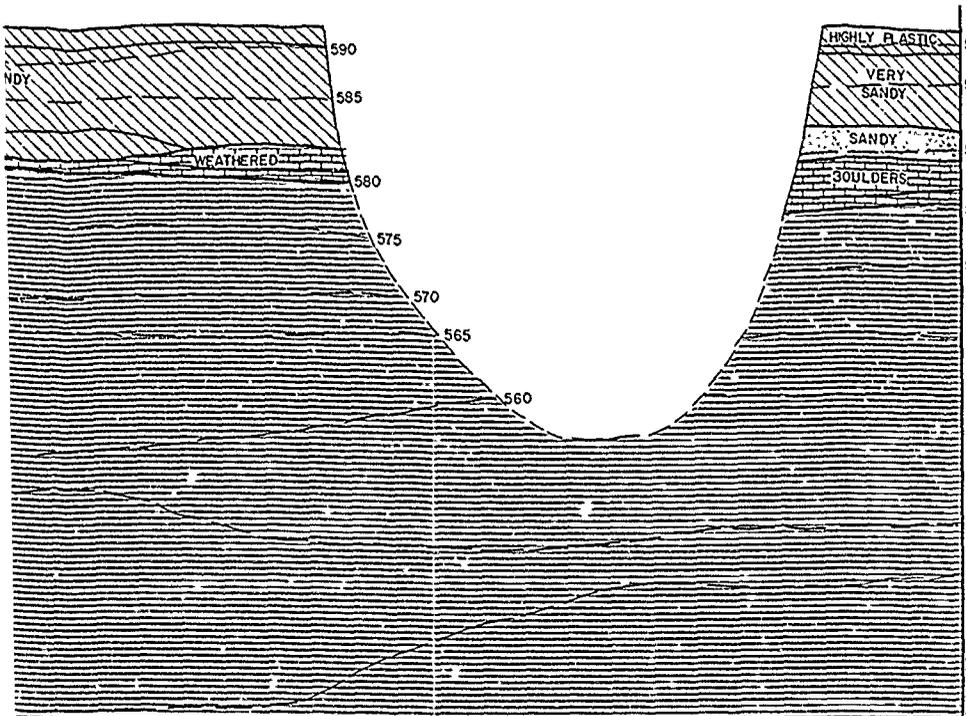

29+00

30+00

MATCH LINE STA 31+00

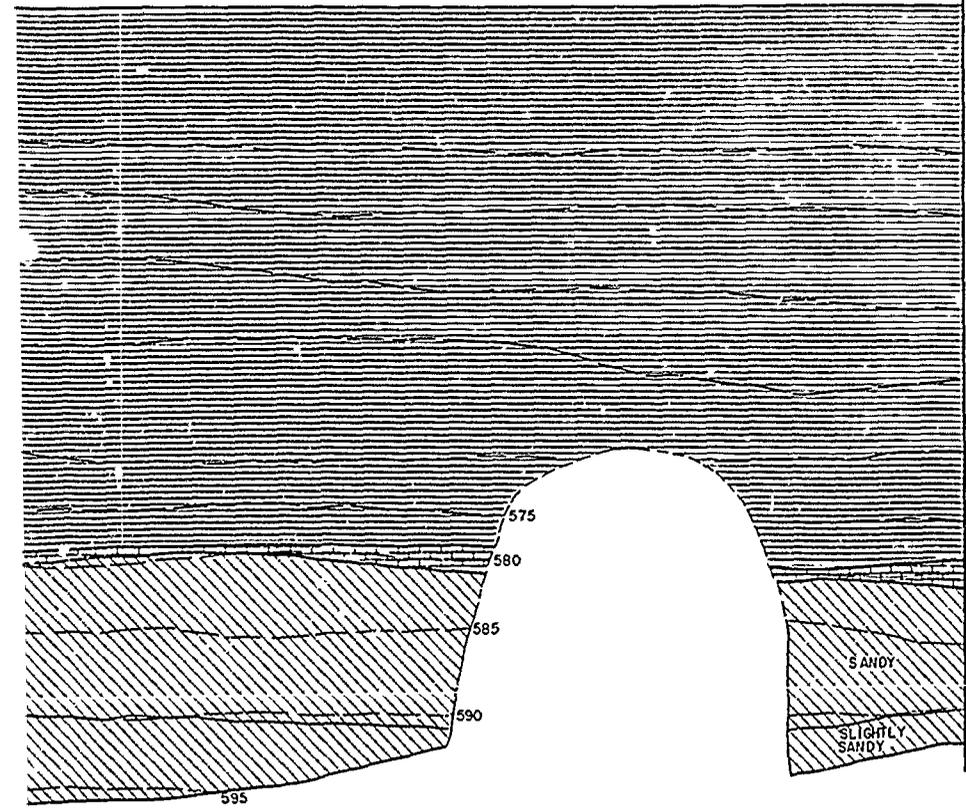


29+00


LEGEND

-  SAND
-  GRAVEL
-  CLAY
-  SANDSTONE
-  LIMESTONE
-  SHALE

DESIGNED BY: H. BARNETT		RAY ROBERTS LAKE ELM FORK, TRINITY RIVER, TEXAS	
DRAWN BY: C. KIRBY		FOUNDATION REPORT	
REVIEWED BY: R. BEHM		OUTLET WORKS STA. 25+50 TO 31+00	
SUBMITTED BY: ROBERT C. BEHM ENGINEER		SOL. NO.	DATE:
		CONTR. NO.	SEQUENCE NO.
		DRAWING NUMBER	SHEET NO. 40






G
F
E
D
C
B
A

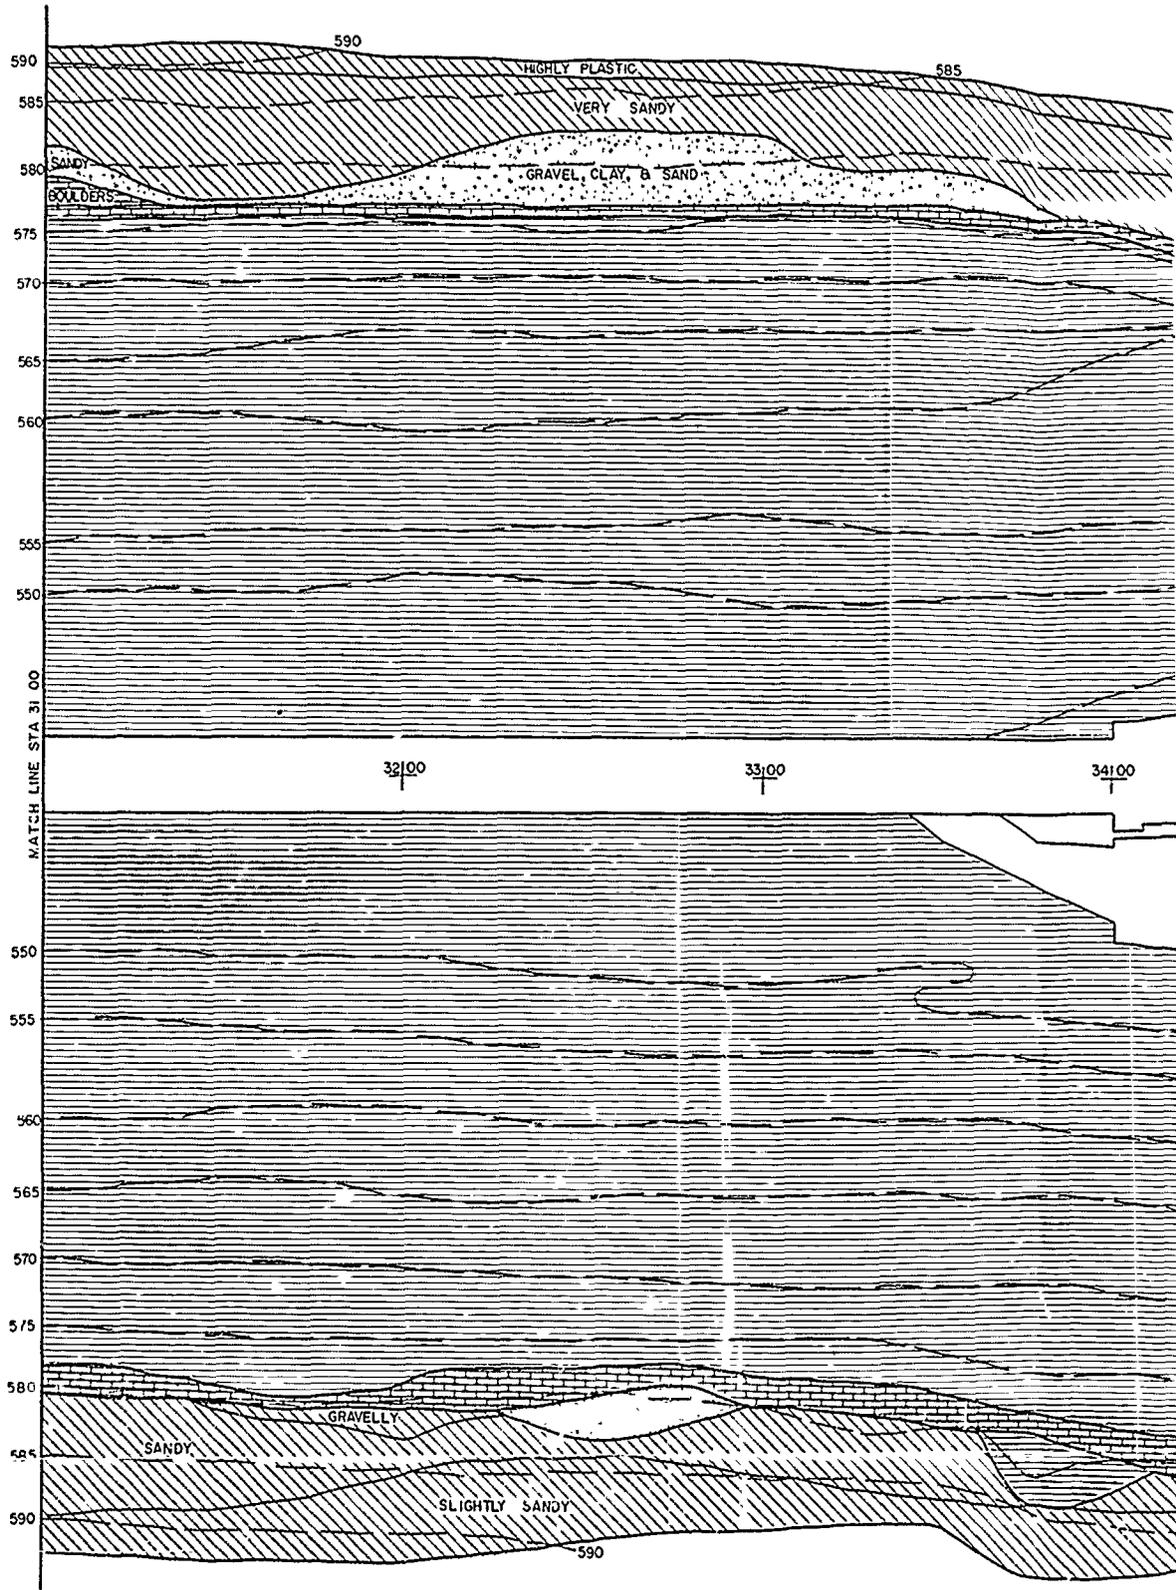




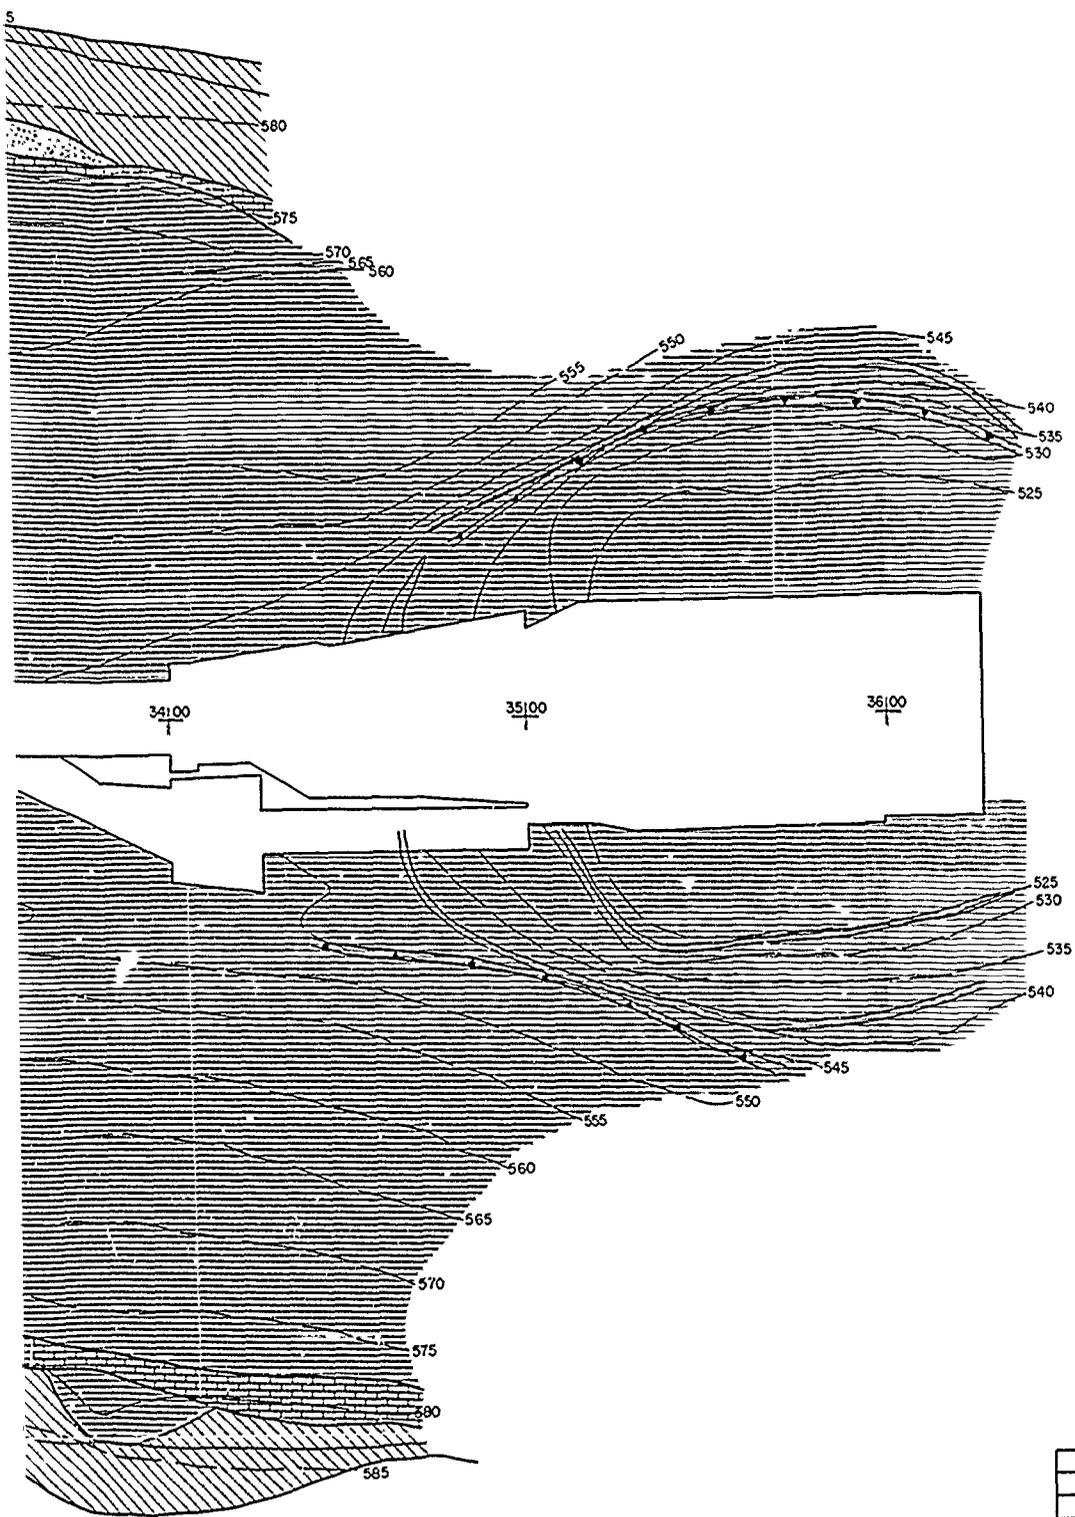


DESIGNED BY: H. BARNETT		RAY ROBERTS LAKE ELM FORK, TRINITY RIVER, TEXAS	
DRAWN BY: C. KIRBY		FOUNDATION REPORT OUTLET WORKS STA. 31+00 TO 36+28	
REVIEWED BY: R. BEHM			
SUBMITTED BY: ROBERT C. BEHM		SOL. NO.	DATED:
ENGINEER:		CONTR. NO.	SEQUENCE NO.
		DRAWING NUMBER	SHEET NO. OF
			41

G
F
E
D
C
B

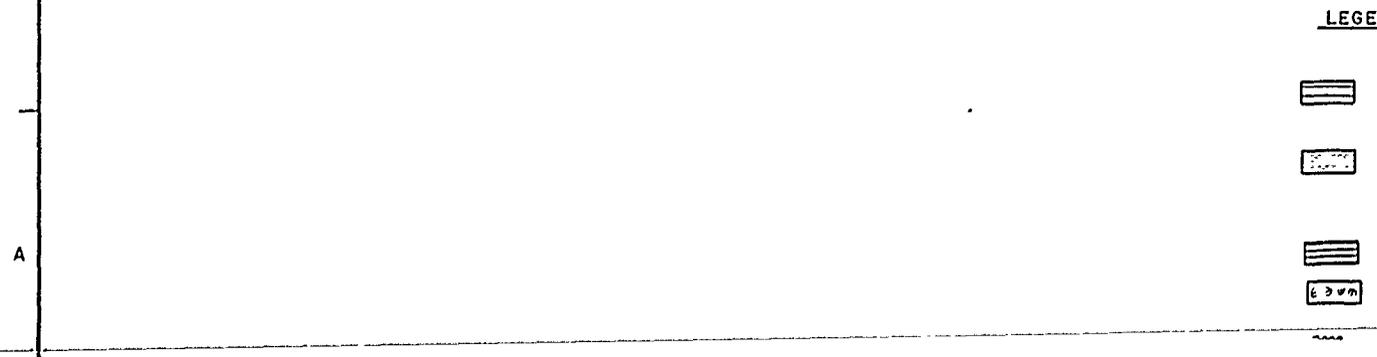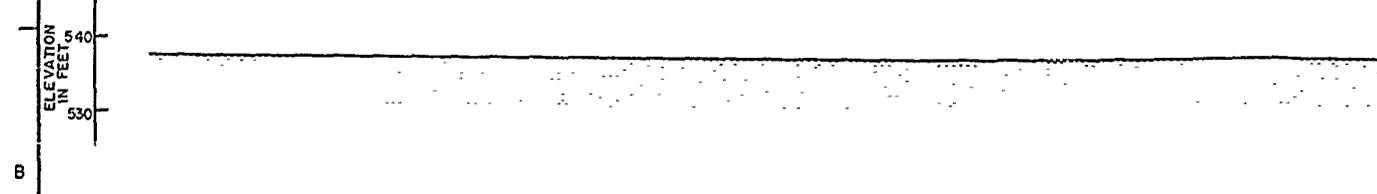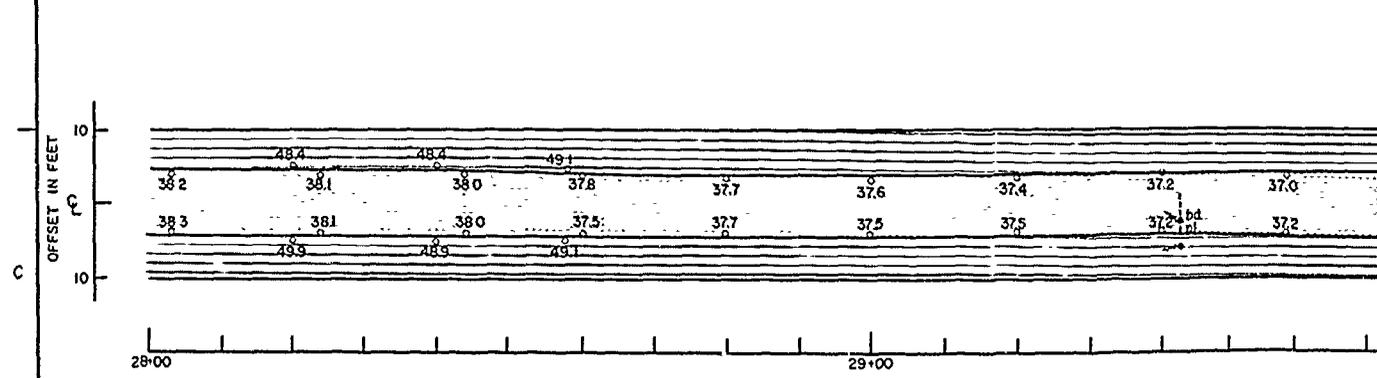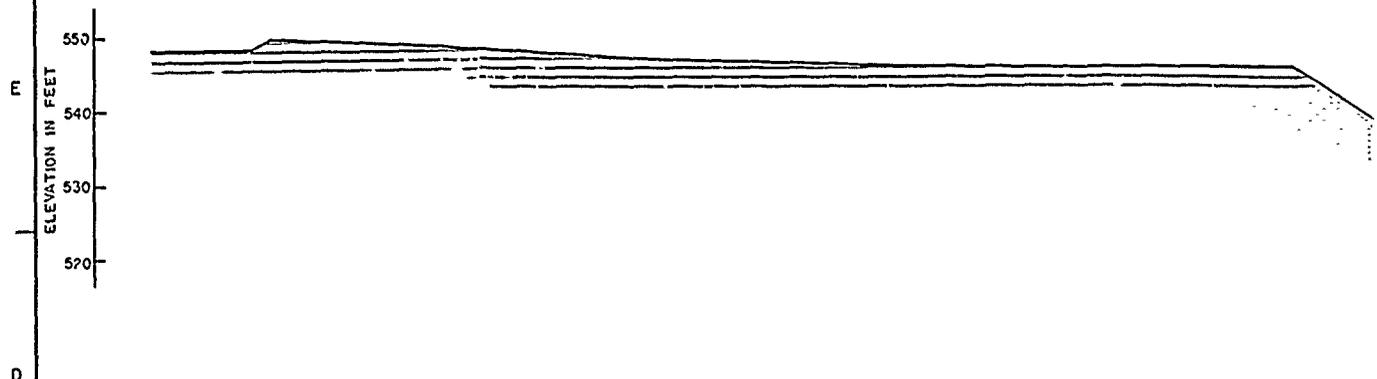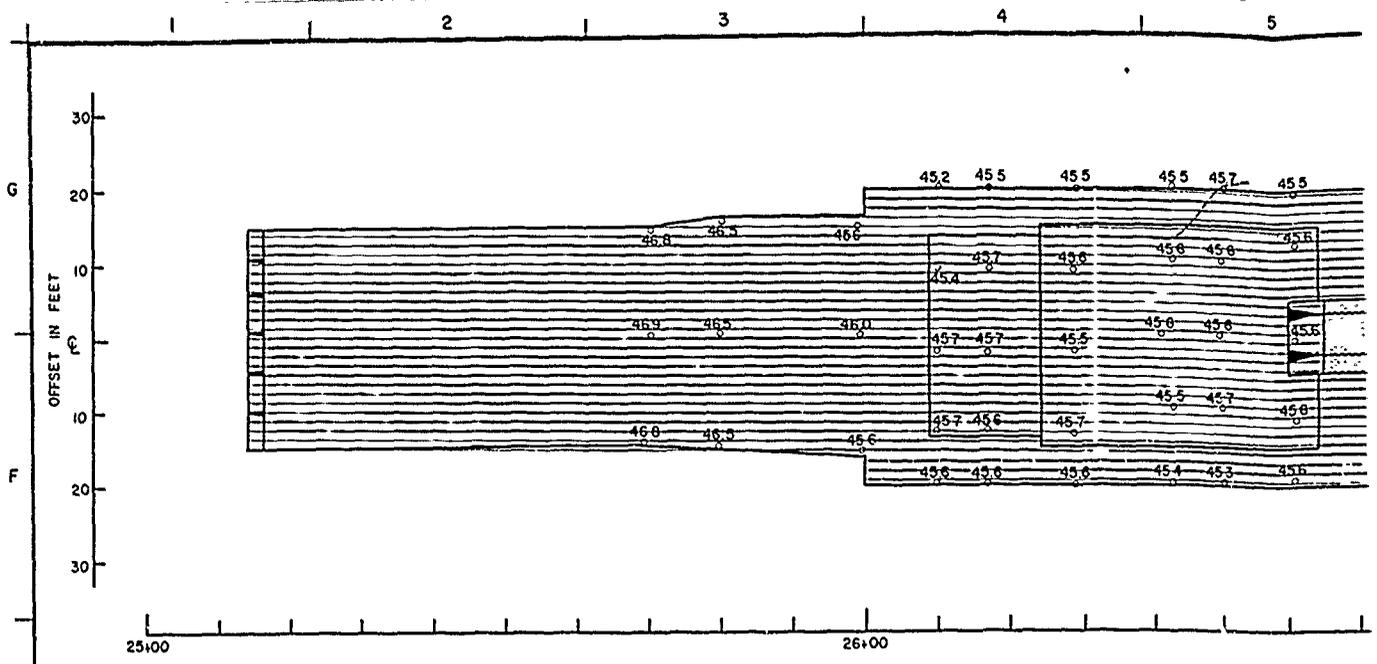


- LEGEN**
- 
 - 
 - 
 - 


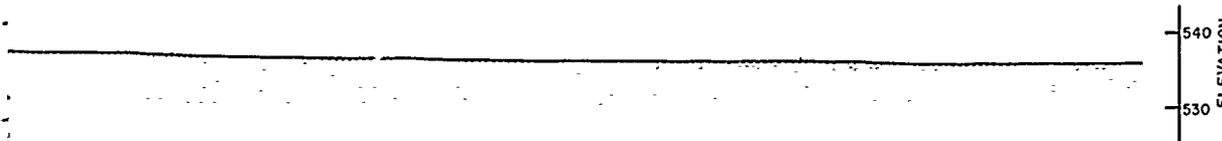
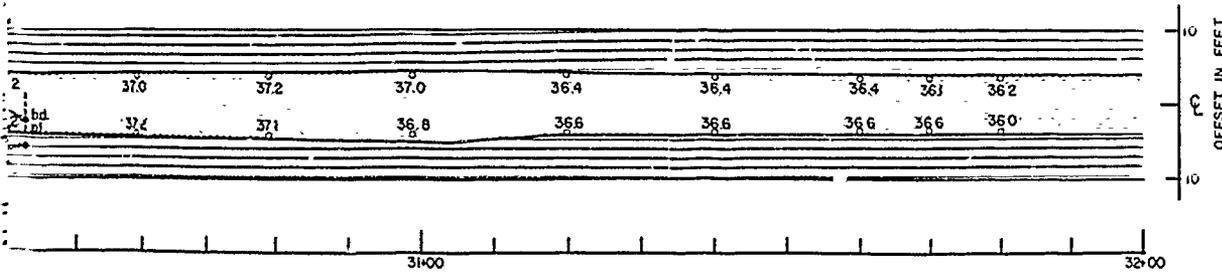
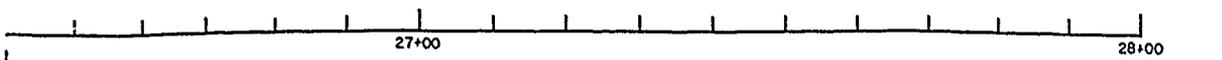
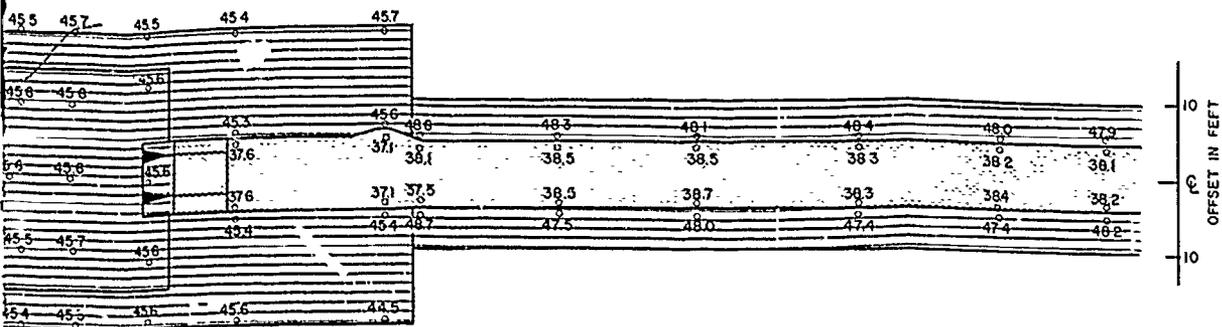


LEGEND

-  CLAY-SHALE, SOFT TO MODERATELY HARD, GREENISH TO DARK GRAY w/SAND AND SANDSTONE LENSES.
-  ALTERNATING CLAY SHALE AND SANDSTONE SEAMS, SOFT TO MODERATELY HARD, DARK GRAY, SANDSTONE, FINE TO MEDIUM GRAINED, COMPRISES UP TO 50% OF MATERIAL.
-  CLAY-SHALE, SOFT TO MODERATELY HARD, MOIST, DARK GRAY, SLIGHTLY FOSSILIFEROUS.
-  HIGHLY FOSSILIFEROUS
-  WATER SEEP


REVISION NO.		DATE	DESCRIPTION OF REVISION
U.S. ARMY ENGINEER DISTRICT, FORT WORTH			CORPS OF ENGINEERS FORT WORTH, TEX. 8
DESIGNED BY:	RAY ROBERT'S LAKE ELM FORK, TRINITY RIVER, TEXAS		
DRAWN BY:	FOUNDATION REPORT OUTLET WORKS PLAN AND PROFILE		
REVIEWED BY:	STA. 25+00 TO 31+00		
APPROVED BY:	R. BEHM		
SUBMITTED BY:		SCL. NO.	DATED:
ROBERT C BEHM		CONTR. NO.	SHEET NO.
DRAWING NUMBER		SEQUENCE NO.	
		42	

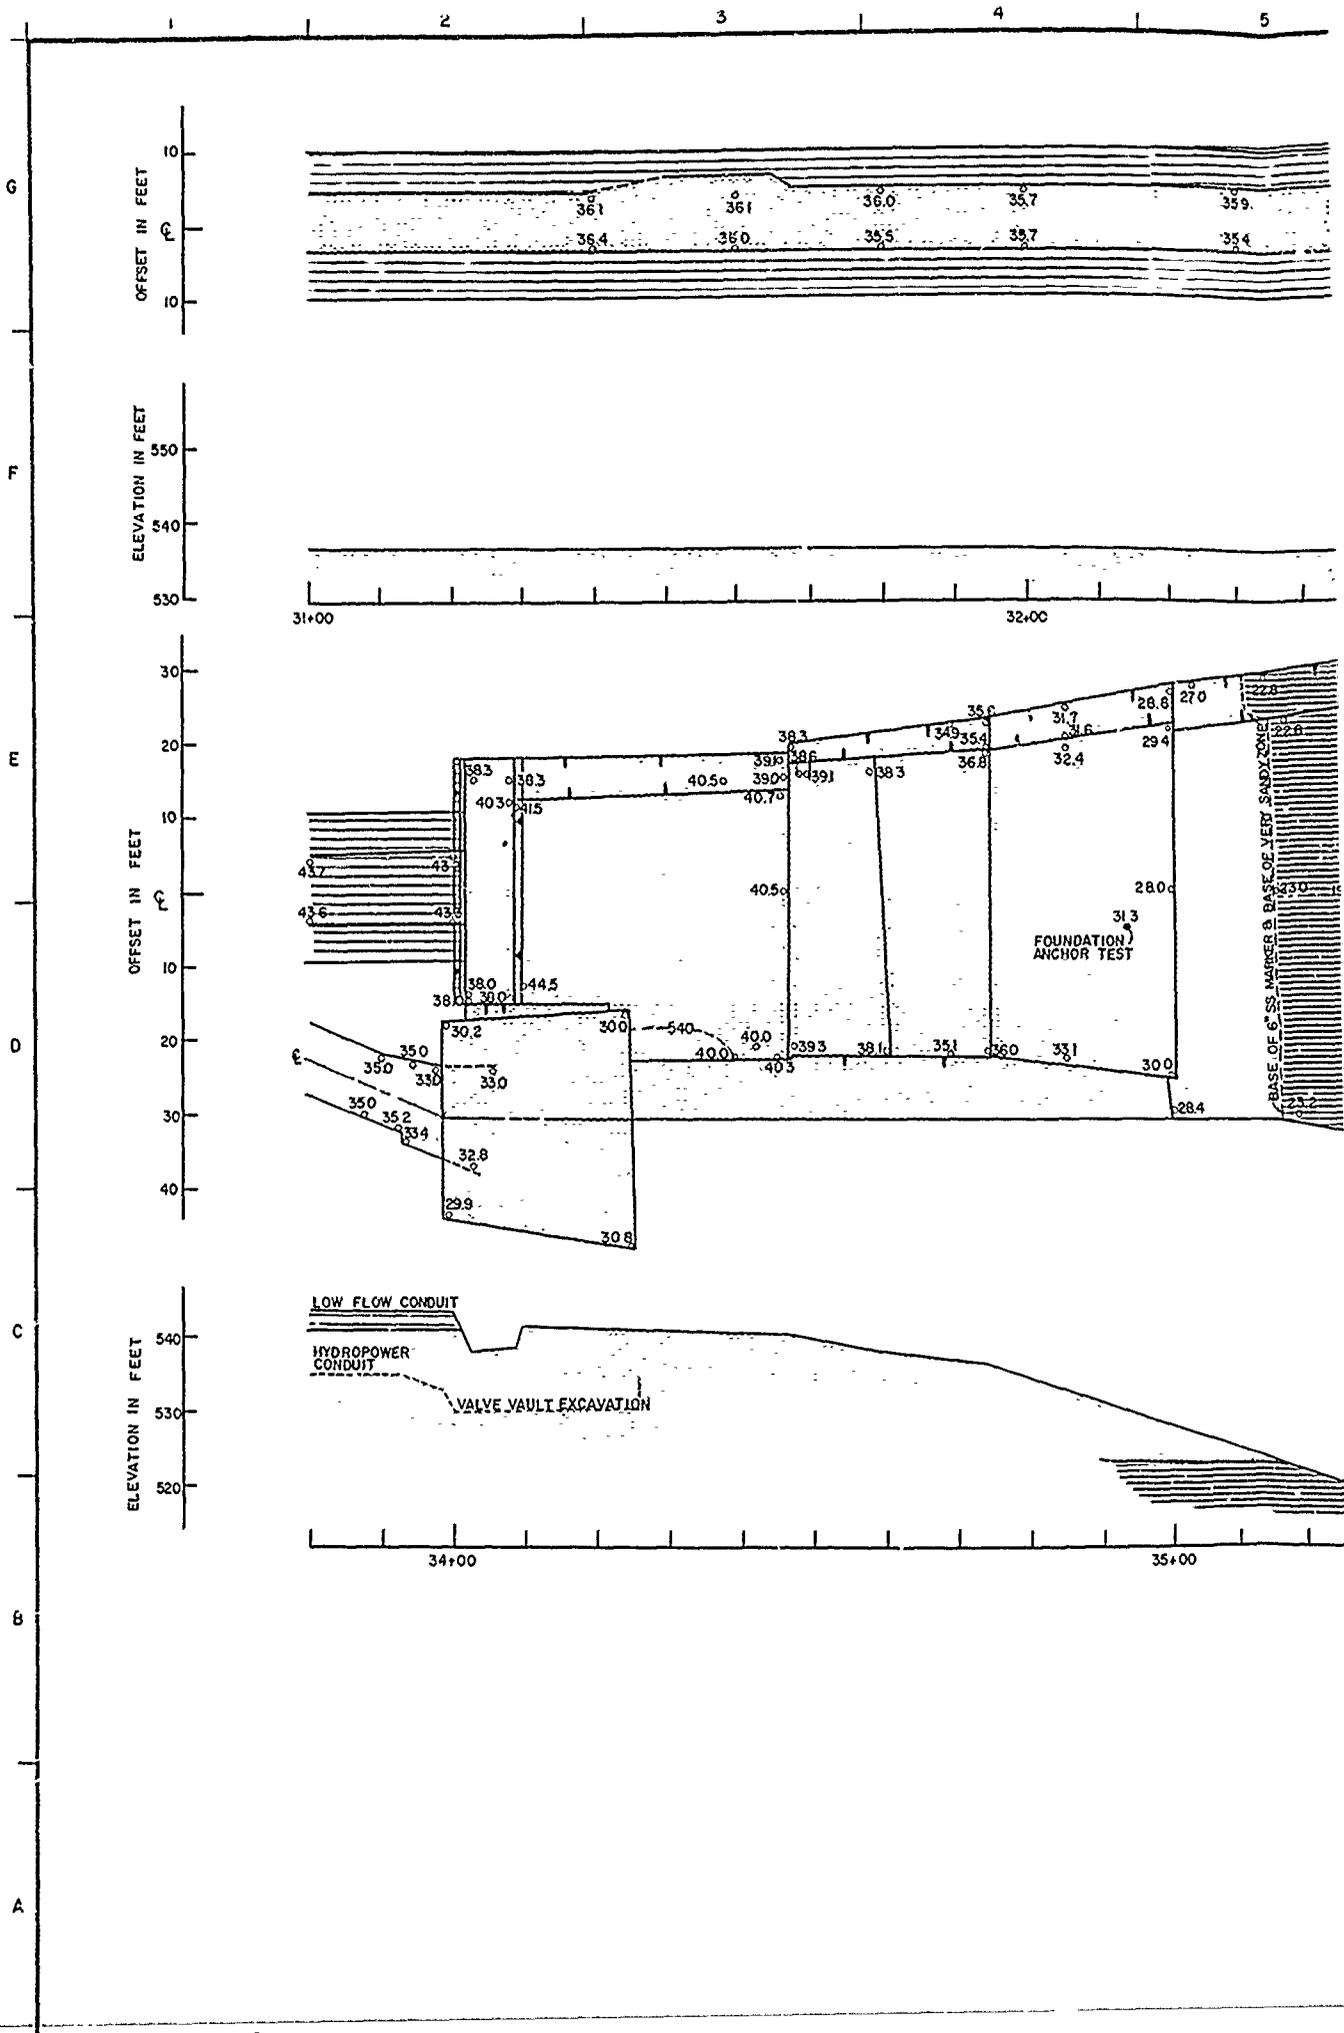

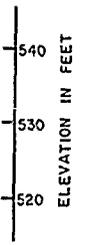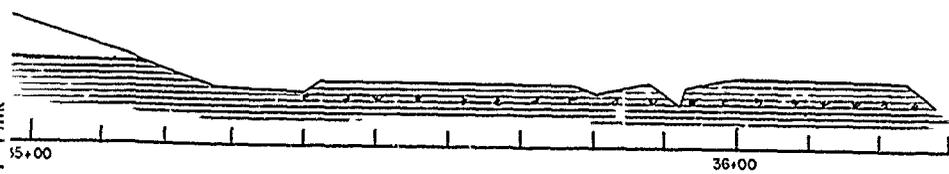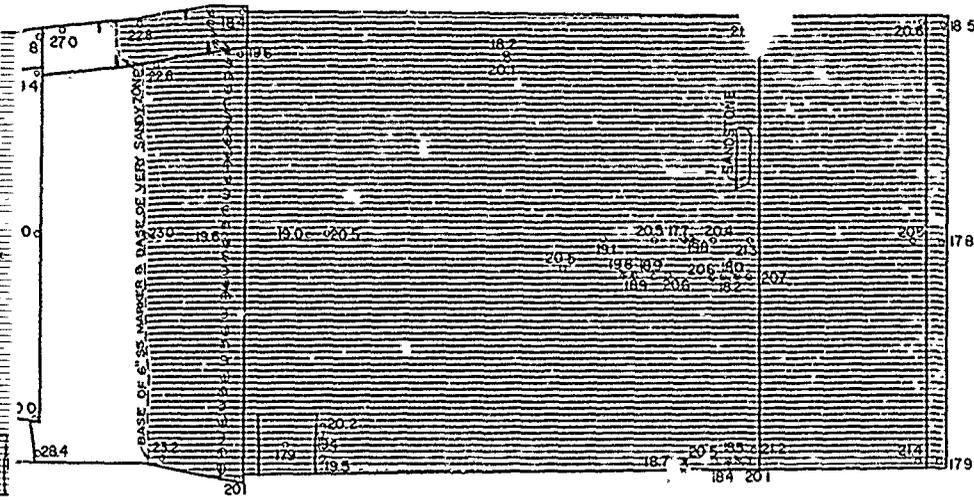
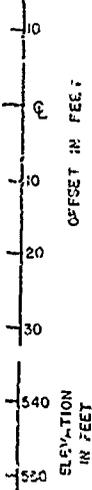
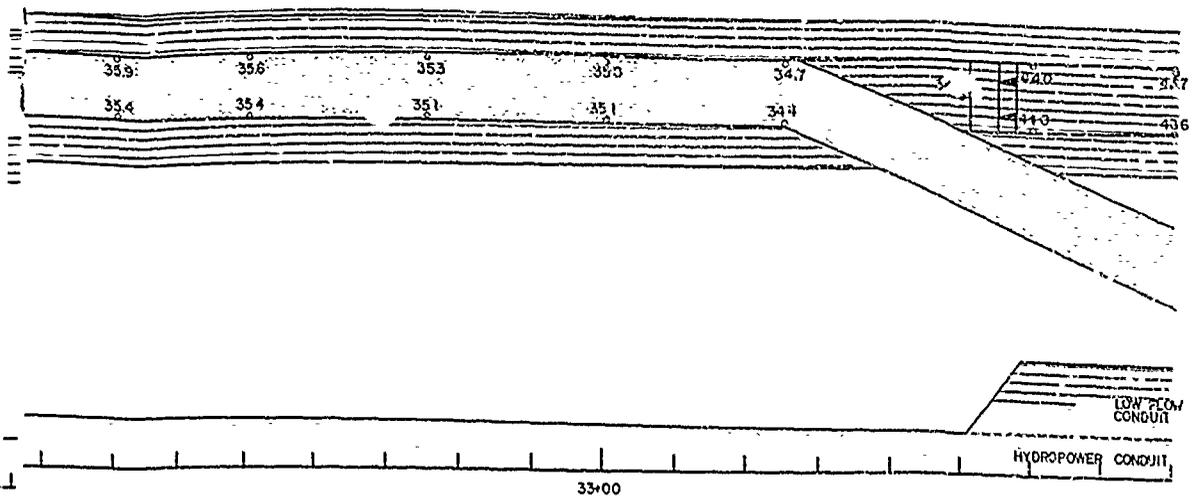


NOTE:
FOR LEGEND, SEE PLATE NO. 42.


DESIGNED BY: H. BARNETT	RAY ROBERTS LAKE E.L.M. FORK, TRINITY RIVER, TEXAS	
DRAWN BY: C. KIRBY	FOUNDATION REPORT	
REVIEWED BY: R. BEHM	OUTLET WORKS	
ENGINEER:	STA. 31+00 TO 36+25	
APPROVED BY: ROBERT C. BEHM	CONTR. NO.	DATED:
ENGINEER:	DRAWING NUMBER	SHEET NO. 43

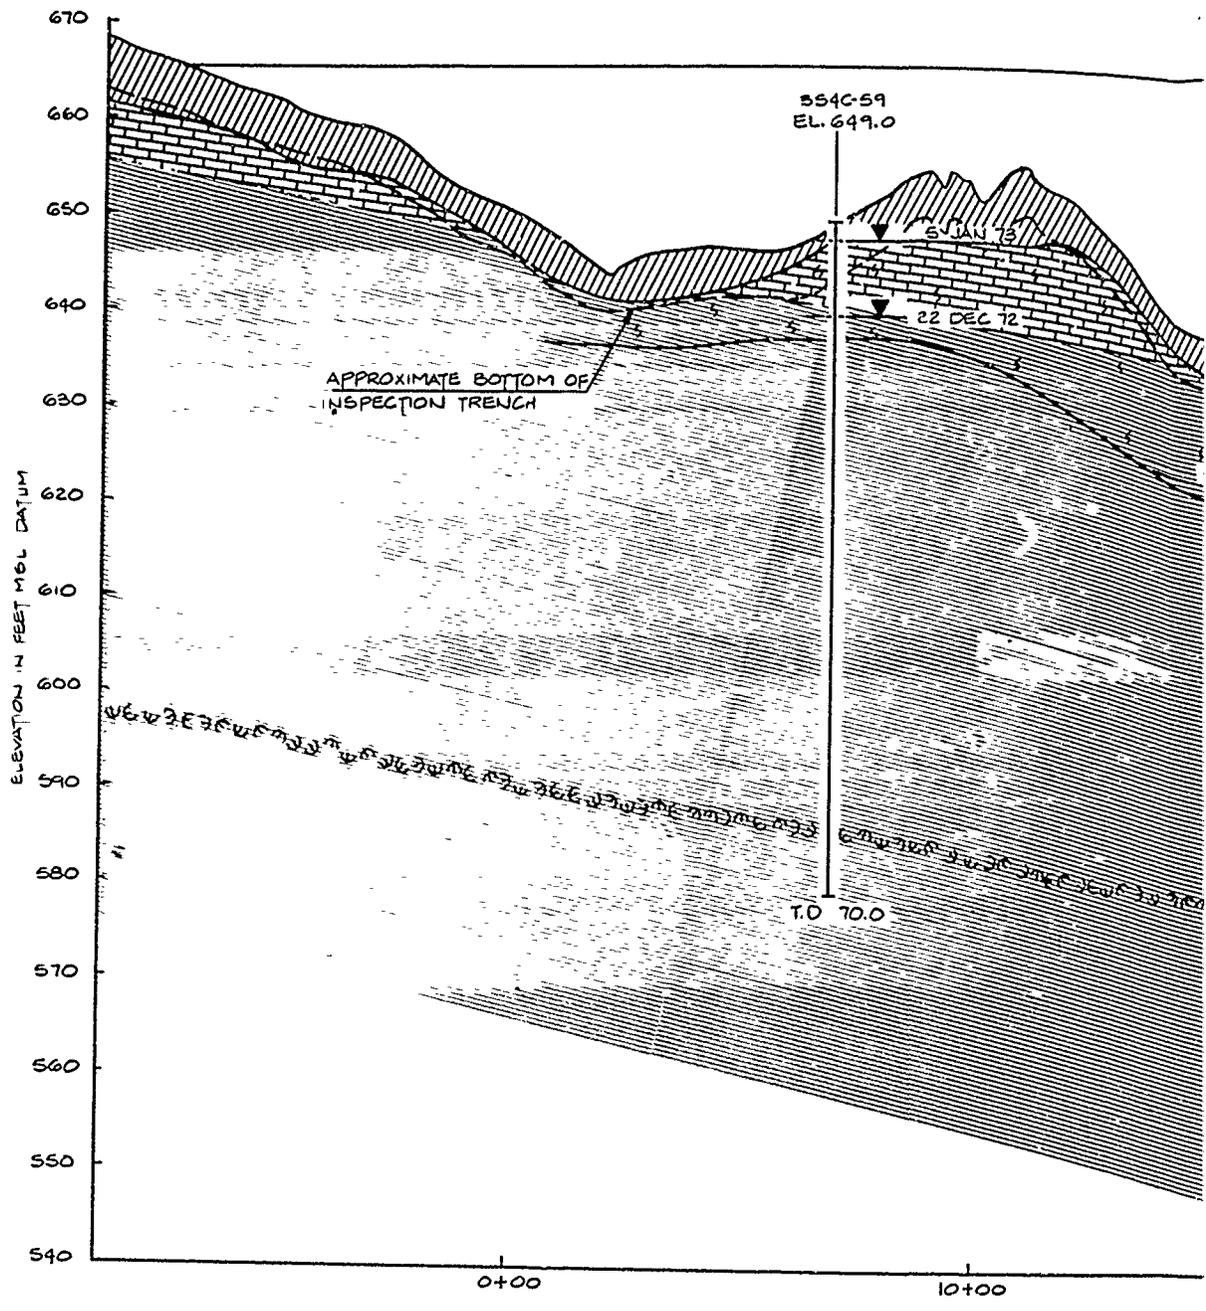


LEGEND

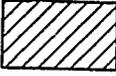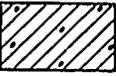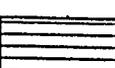- | | | | | | |
|---|--|---|---|---|-------------------------------|
|  | CLAY, VARIABLY SILTY AND SANDY |  | SHALE & SANDY SHALE |  | SANDSTONE, VARIAB |
|  | CLAY, GRAVELLY |  | SHALE CALCAREOUS |  | LIMESTONE, MODERAT
TO HARD |
|  | SAND, VARIABLY CLAYEY SANDY & GRAVELLY |  | SHALE, SANDY W/NUMEROUS LENSES OF MODERATELY TO WELL CEMENTED SANDSTONE | | |
|  | GRAVEL, VARIABLY SANDY & CLAYEY |  | SHALE, NON-SANDY | | |

TOP OF DAM EL. 665.0

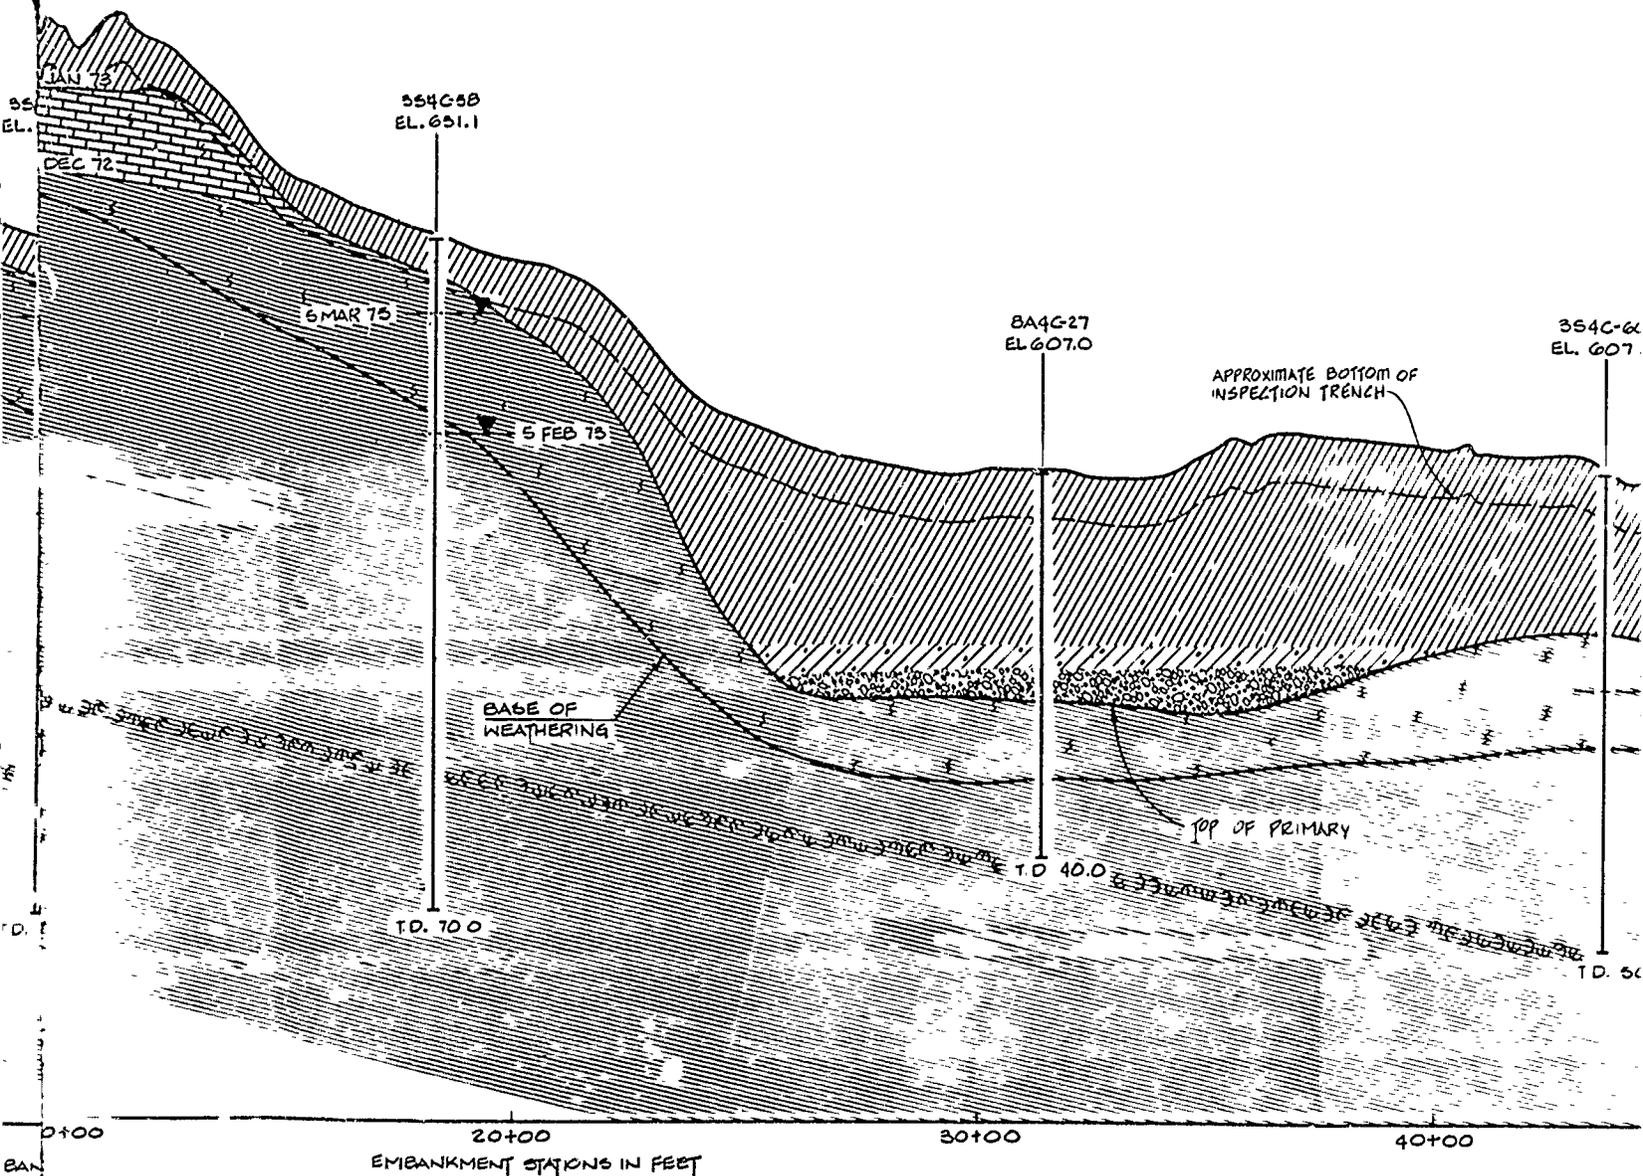


-  SANDSTONE, VARIABLY CEMENTED
-  LIMESTONE, MODERATELY HARD TO HARD

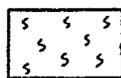

▼ WATER LEVEL ON DATE INDICATED

WEATHERED ZONE

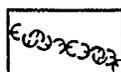


FOSSILIFEROUS ZONE

100 OHM RESISTIVITY LOG

- 8A 8-INCH AUGER BORING
- 6D 6-INCH DENISON BORING
- 6C 6-INCH CORE BORING
- 4C 4-INCH CORE BORING
- 3S 3-INCH SHGLBY TUBE
- 2C 2-INCH CORE BORING
- F FISHTAIL WASH BORING
- C CORE BORING
- T.D. TOTAL DEPTH

GENERAL NOTES

1. OVERBURDEN AND PRIMARY STRATA DESCRIPTIONS ARE GENERALIZED SEE SEQUENCES 205 THROUGH 236 FOR DETAILED LOGS OF BORINGS.
2. ABSENCE OF GROUND WATER LEVELS OPPOSITE BORING LOGS DOES NOT NECESSARILY MEAN THAT GROUND WATER WILL NOT BE ENCOUNTERED AT THE LOCATION OR WITHIN THE VERTICAL REACHES OF THE BORINGS. WATER LEVELS WILL FLUCTUATE DEPENDING ON SEASON AND RAINFALL.
3. FOR DETAIL OF CUTOFF AND INSPECTION TRENCH SEE SEQ. 171 AND 172.

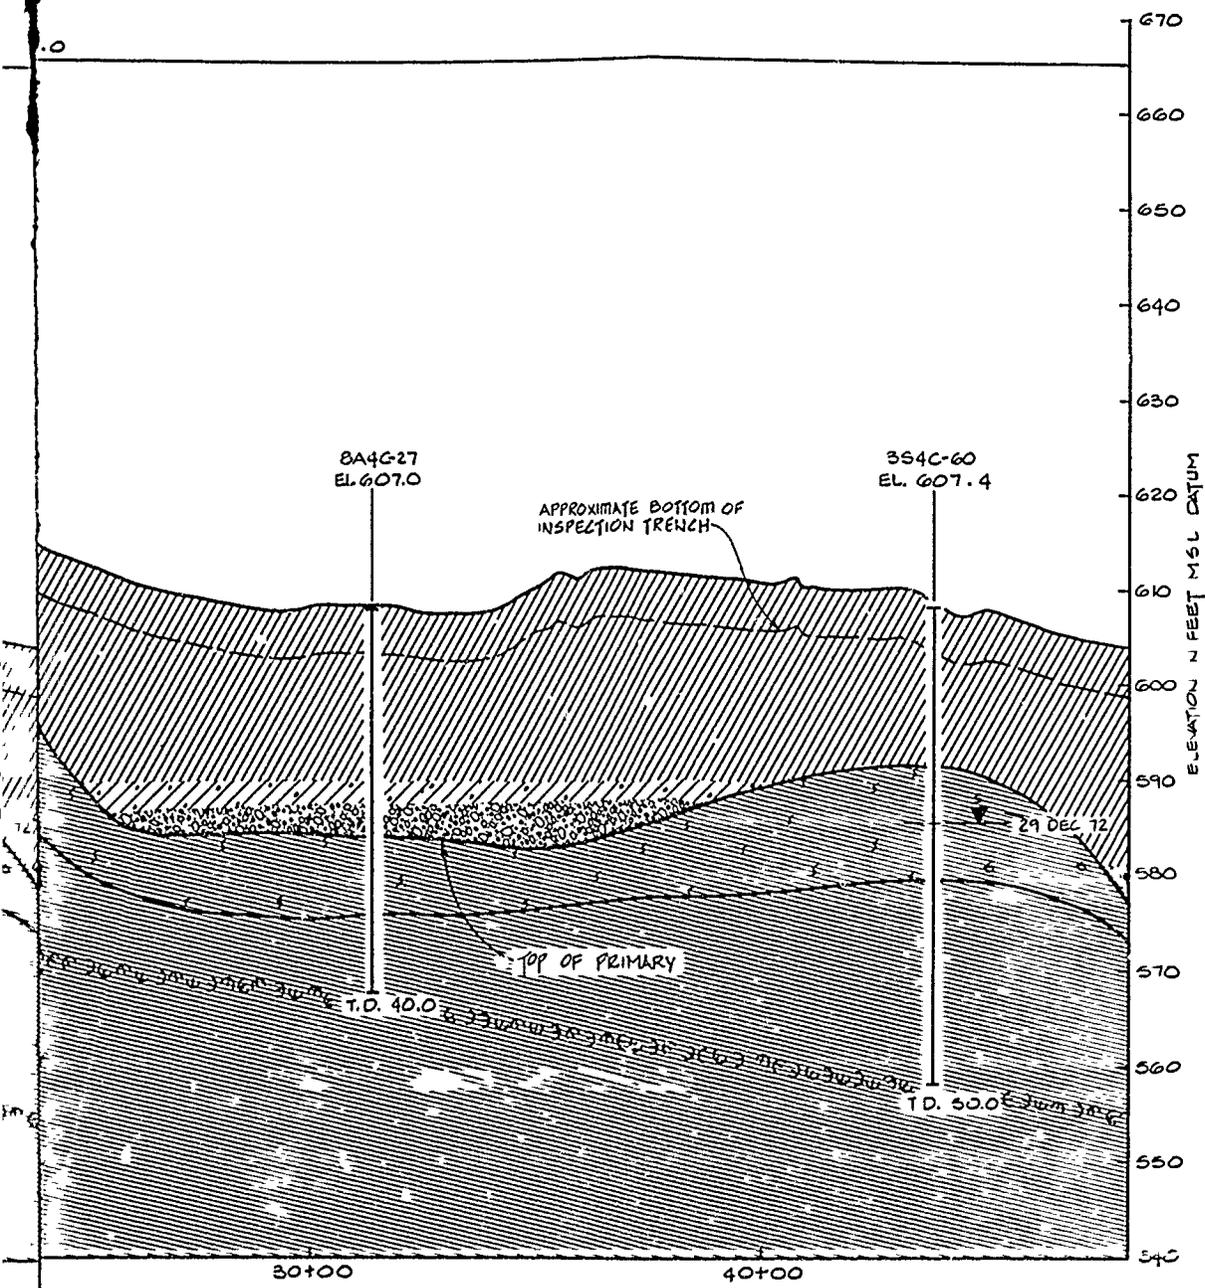

GENERAL NOTES

1. OVERBURDEN AND PRIMARY STRATA DESCRIPTIONS ARE GENERALIZED SEE SEQUENCES 225 THROUGH 236 FOR DETAILED LOGS OF BORINGS.
2. ABSENCE OF GROUND WATER LEVELS OPPOSITE BORING LOGS DOES NOT NECESSARILY MEAN THAT GROUND WATER WILL NOT BE ENCOUNTERED AT THE LOCATION OR WITHIN THE VERTICAL REACHES OF THE BORINGS. WATER LEVELS WILL FLUCTUATE DEPENDING ON SEASON AND RAINFALL.
3. FOR DETAIL OF CUTOFF AND INSPECTION TRENCH SEE SEQ. 171 AND 172.

- LEVEL ON INDICATED
- 8A 8-INCH AUGER BORING
 - 6D 6-INCH DENISON BORING
 - 6C 6-INCH CORE BORING
 - 4C 4-INCH CORE BORING
 - 3S 3-INCH SHELBY TUBE
 - 2C 2-INCH CORE BORING
 - F FISHTAIL WASH BORING
 - C CORE BORING
 - T.D. TOTAL DEPTH

RED ZONE


UNSATURATED ZONE

PERMEABILITY LOG

RECORD DRAWING-WORK AS BUILT

REVISION NO.	ACTION	DATE	DESCRIPTION OF REVISION
U.S. ARMY ENGINEER DISTRICT, FORT WORTH CORPS OF ENGINEERS FORT WORTH, TEXAS			
RAY ROBERTS LAKE ELM FORK TRINITY RIVER, TEXAS EMBANKMENT GEOLOGIC PROFILE EMBANKMENT CENTERLINE (STA. 0+00 TO STA. 48+00)			
DESIGNED BY:	E. HAGEN		
DRAWN BY:	M. RUTHERFORD		
REVIEWED BY:	E. HAGEN		
SUBMITTED BY:	M. GREEN		
ENGINEER	INVITATION NO. DACW 63-82-B-0025	DATE: MAR 1982	PROJECT NO.
	CONTRACT NO. DACW 63-82-C-0083		
	DRAWING NUMBER	SHEET NO. OF	44

TO ACCOMPANY FOUNDATION REPORT

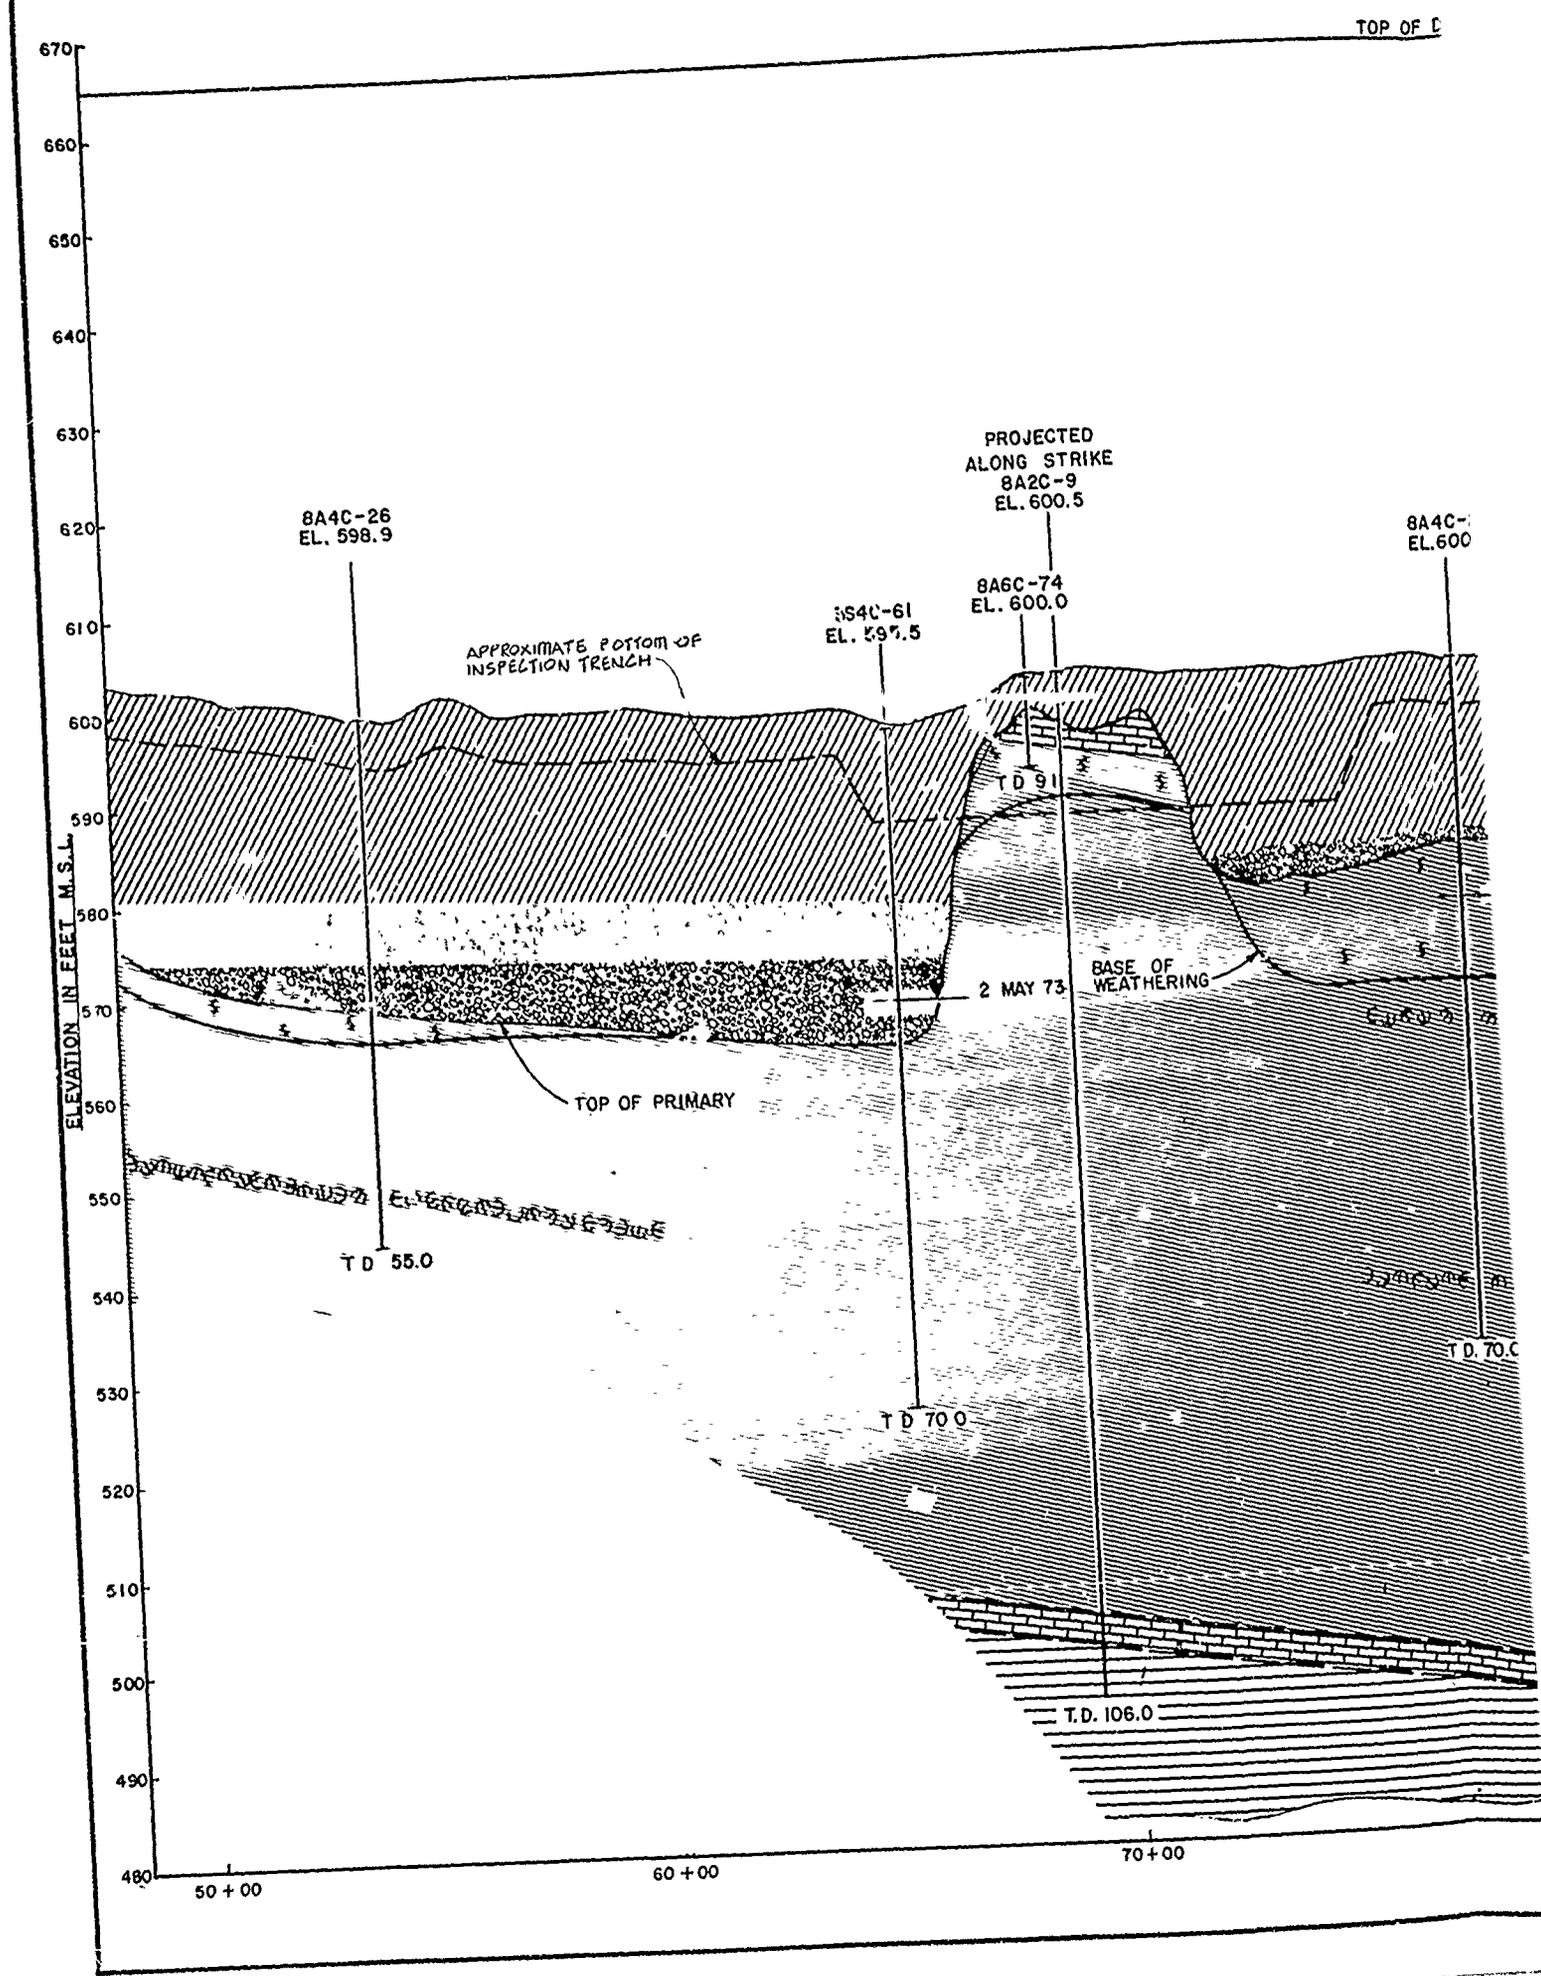

TOP OF DAM EL. 665.0

ELEVATION IN FEET M.S.L.
670
660
650
8A4C-25
EL. 600.4

6DC-18
EL. 595.1

C-1
EL. 597.2

6A4C-20
EL. 597.0

6DC-17
EL. 578.2

PROJ
8A6C-72
EL. 571.1

8A6C-73
EL. 560.4

7 AUG 72

9 SEPT 71

5 MAR 75

4 MAR 75

22 AUG 73

START OF CUTOFF TRENCH
STATION 86+00

APPROXIMATE BOTTOM OF
CUTOFF TRENCH

APPROXIMATE OUTLET
WORKS EXCAVATION

OUTLET
WORKS

END OF CUTOFF TRENCH
STATION 102+50

TOP OF PRIMARY
STRATA

T.D. 700

T.D. 300

T.D. 470

T.D. 280

T.D. 190

T.D. 500


T.D. 970


80+00

90+00

100+00

EXISTING GROUND SURFACE

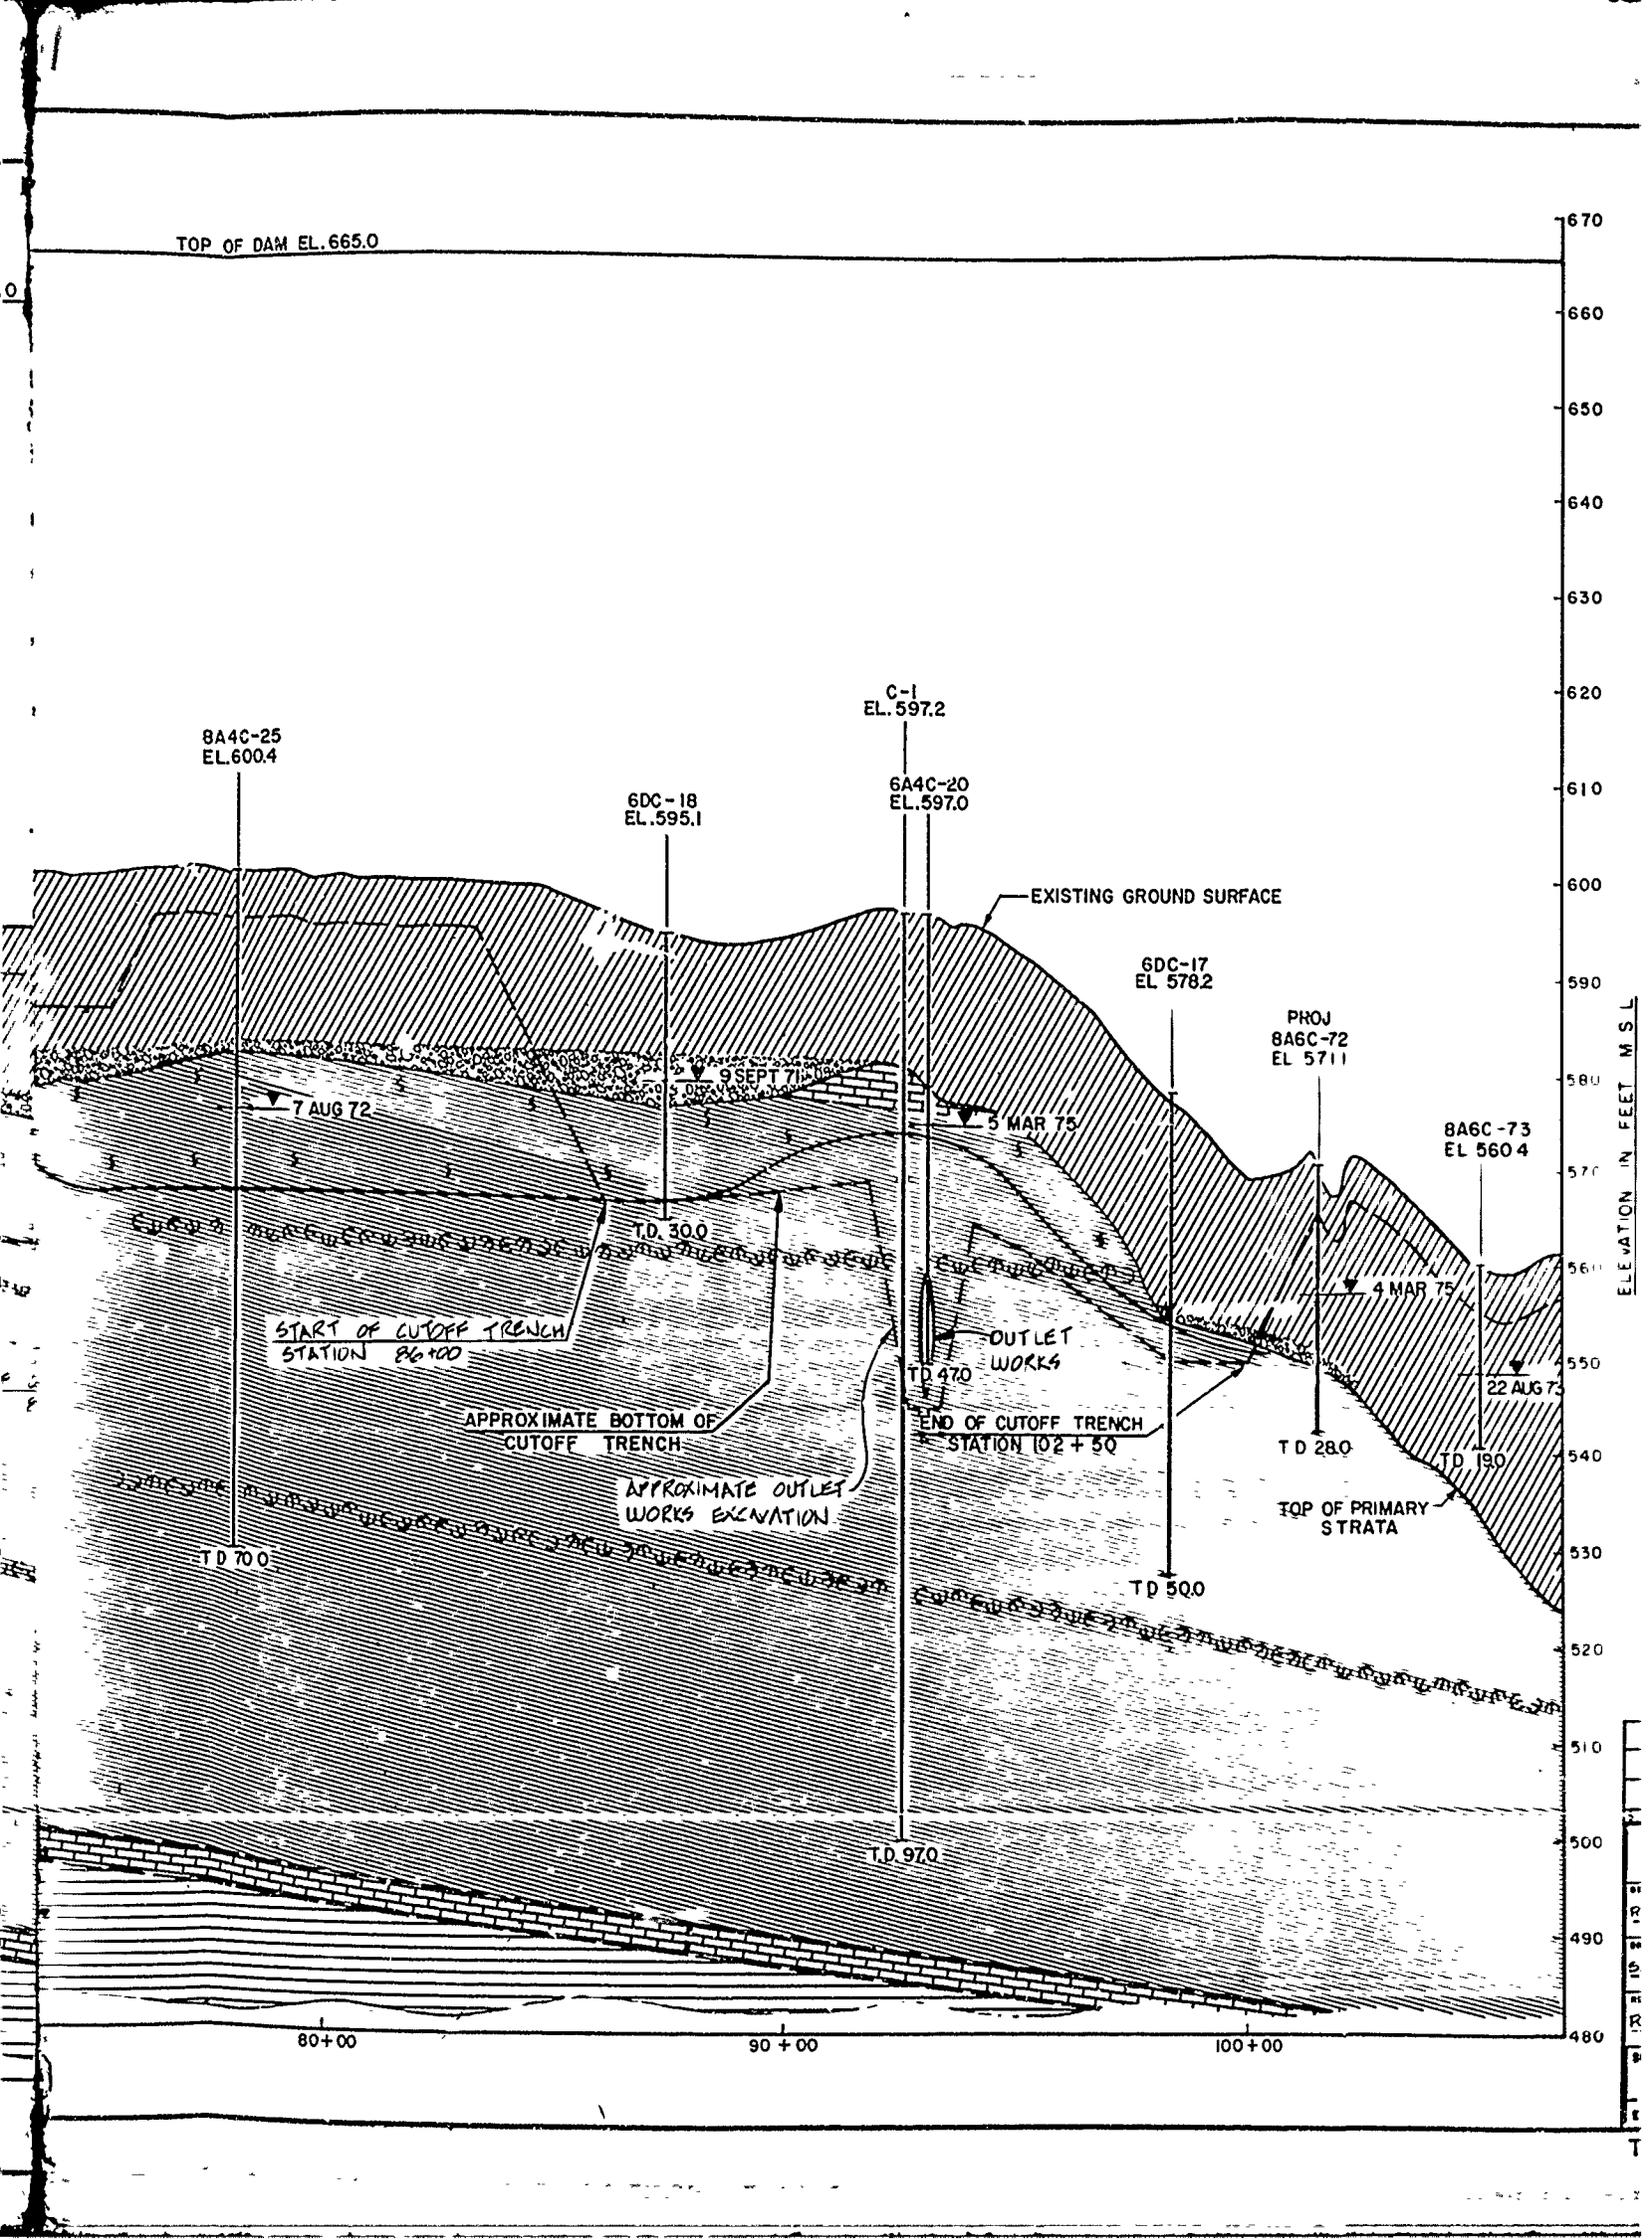

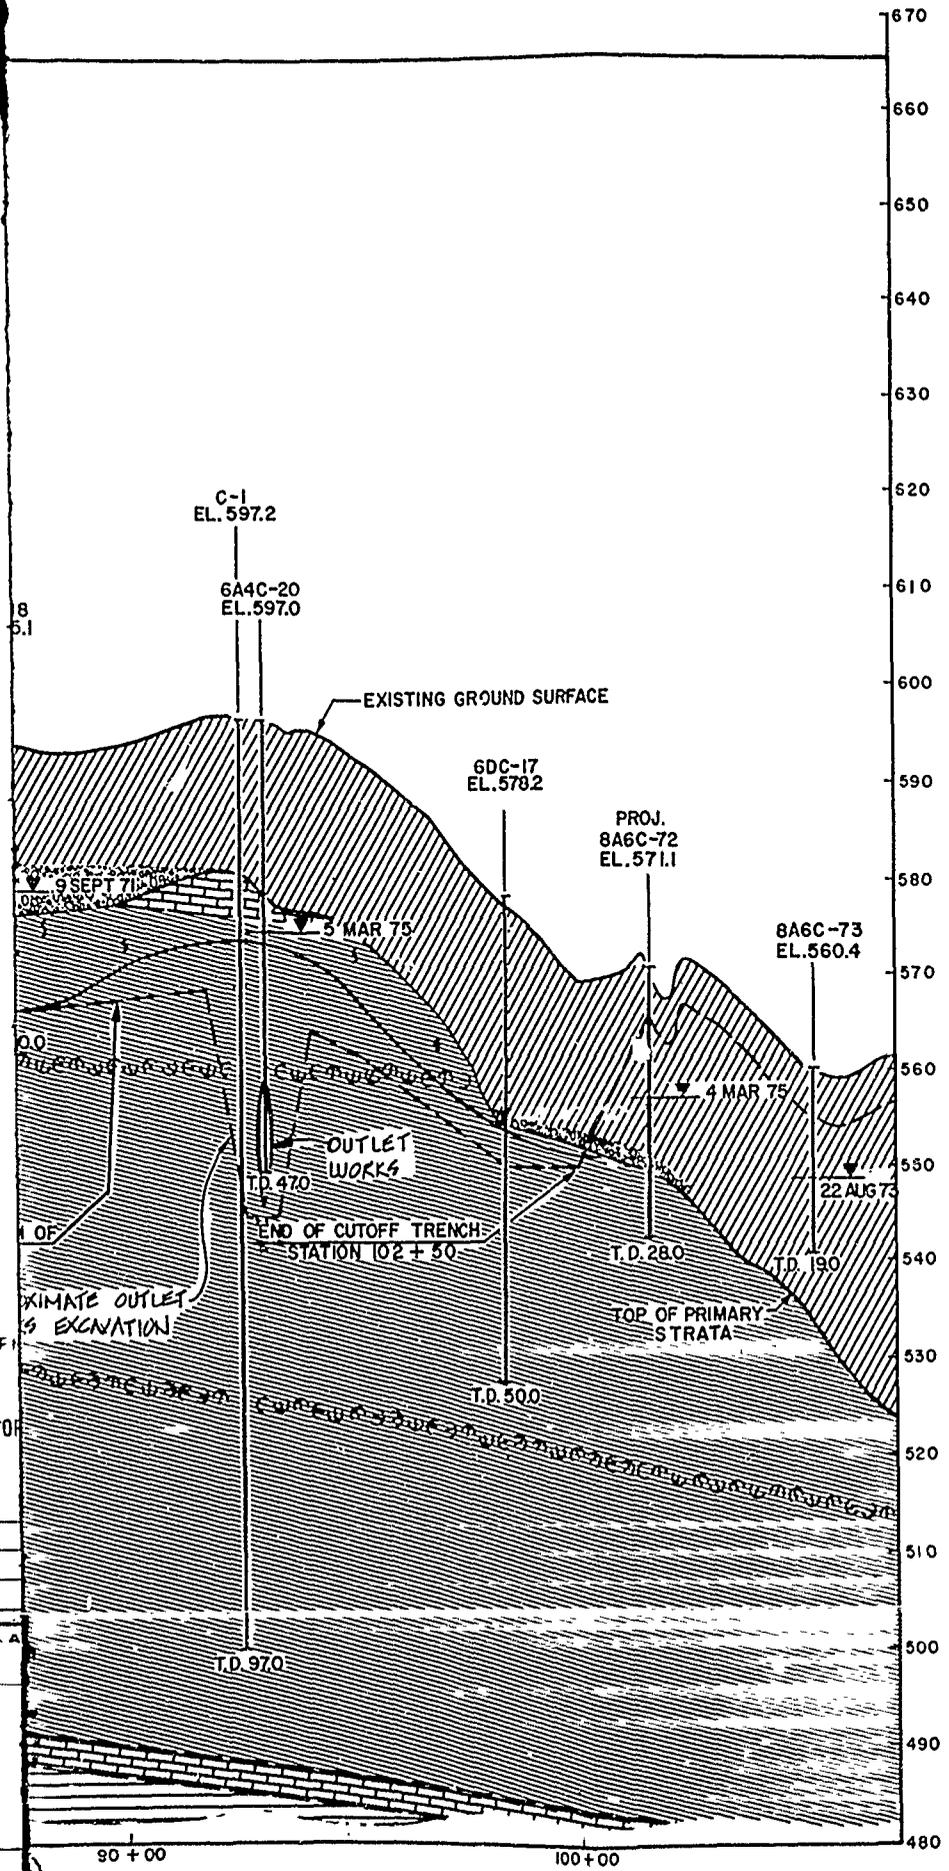


FOR LEGEND AND GENERAL NOTES, SEE SEQ 199

RECORD DRAWING-WORK AS BUILT


SYM	NO	ACTION	DATE	DESCRIPTION OF REVISION
U.S. ARMY ENGINEER DISTRICT, FORT WORTH CORPS OF ENGINEERS FORT WORTH, TEXAS				
DESIGNED BY	RAY ROBERTS LAKE ELM FORK, TRINITY RIVER, TEXAS EMBANKMENT GEOLOGIC PROFILE EMBANKMENT CENTERLINE (STATION 48+00 TO 107+00)			
DRAWN BY				
REVIEWED BY				
ENGINEER				
SUBMITTED BY	INVITATION NO. DACW 63-82-B-0025	DATE: MAR, 1982	SEQUENCE NO.	
	CONTRACT NO. DACW 63-82-C-0083			
	DRAWING NUMBER		SHEET NO. OF	
			45	


TO ACCOMPANY FOUNDATION REPORT

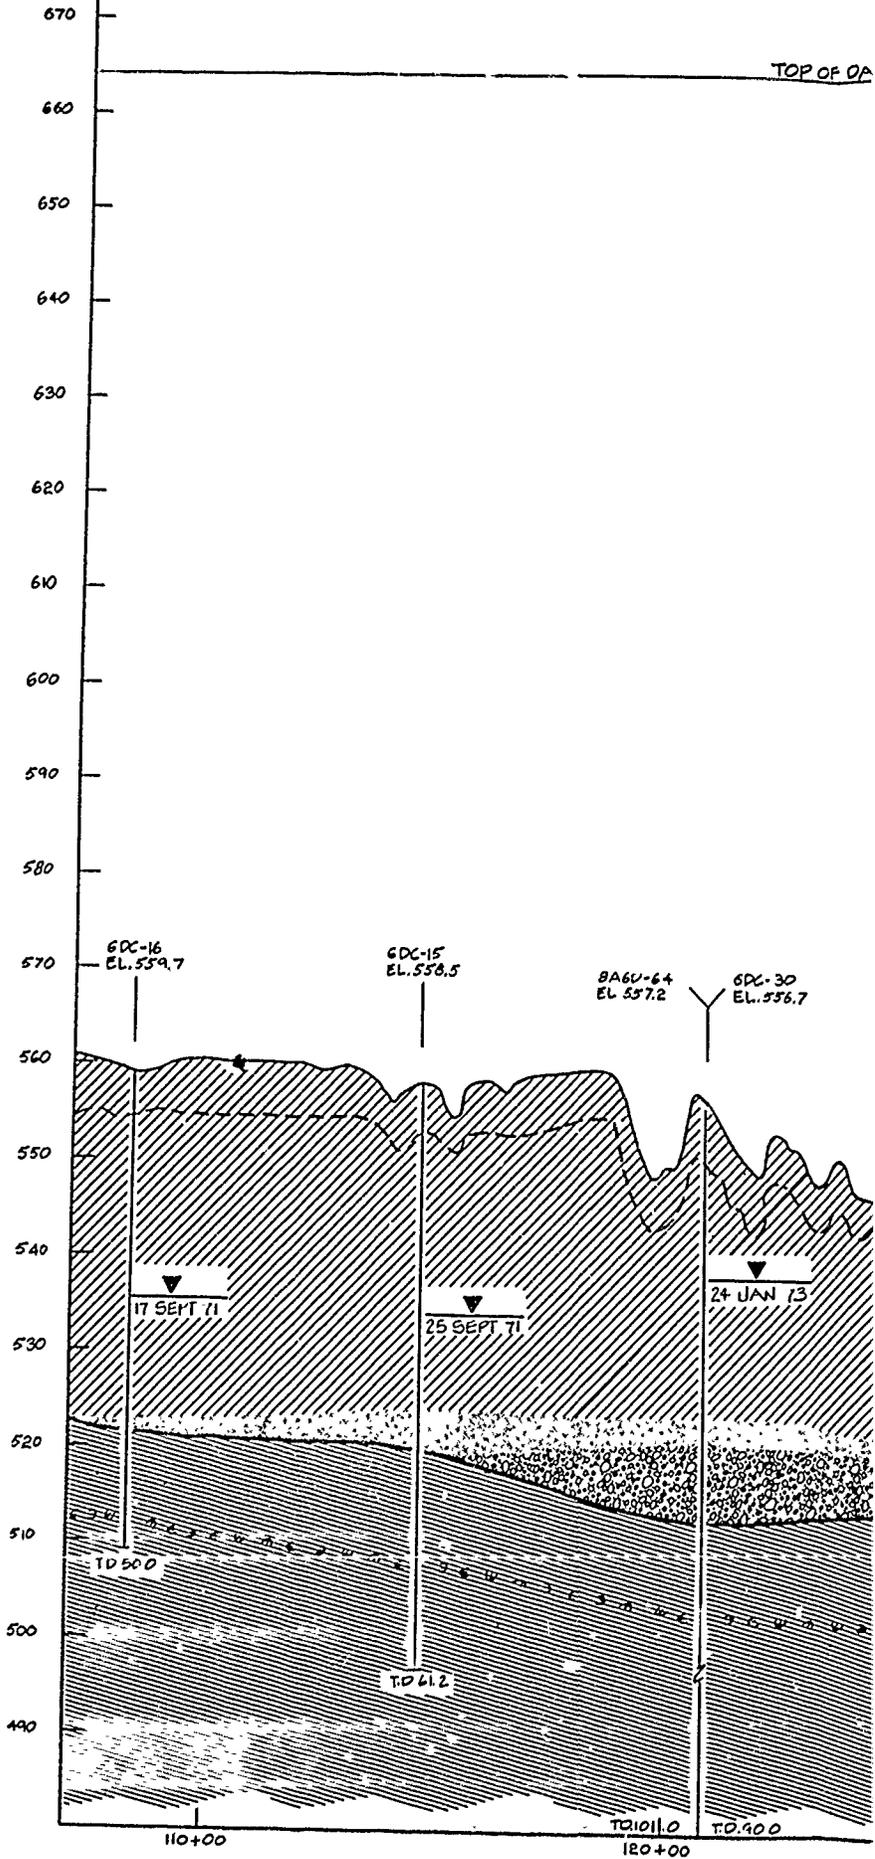

SCALE 1:100

EMBANK

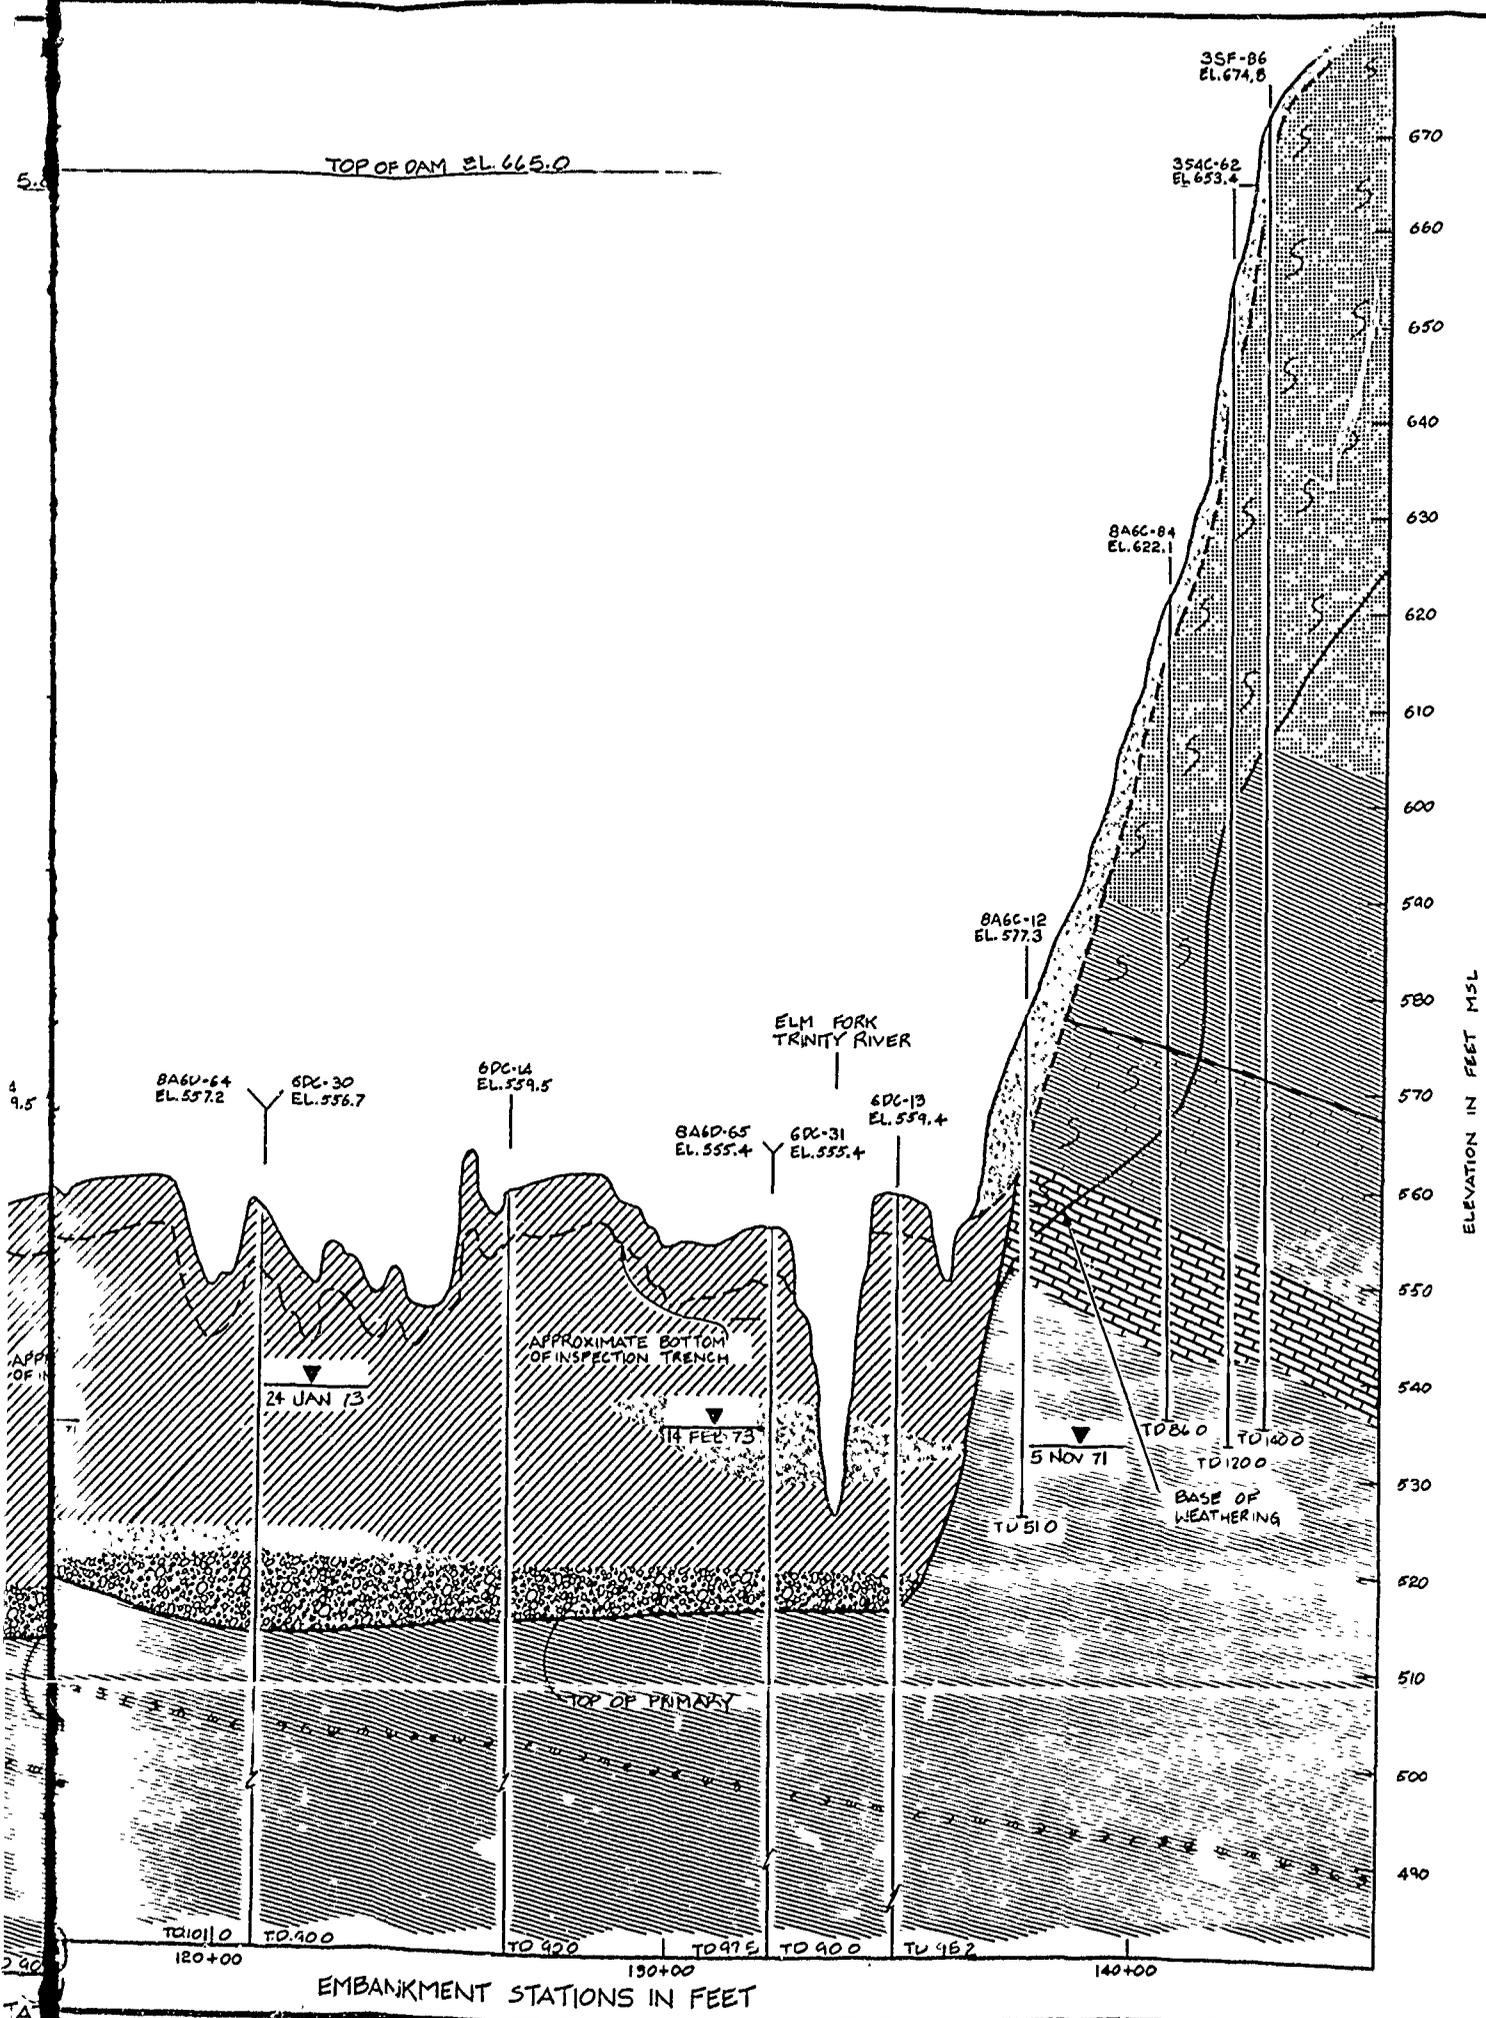

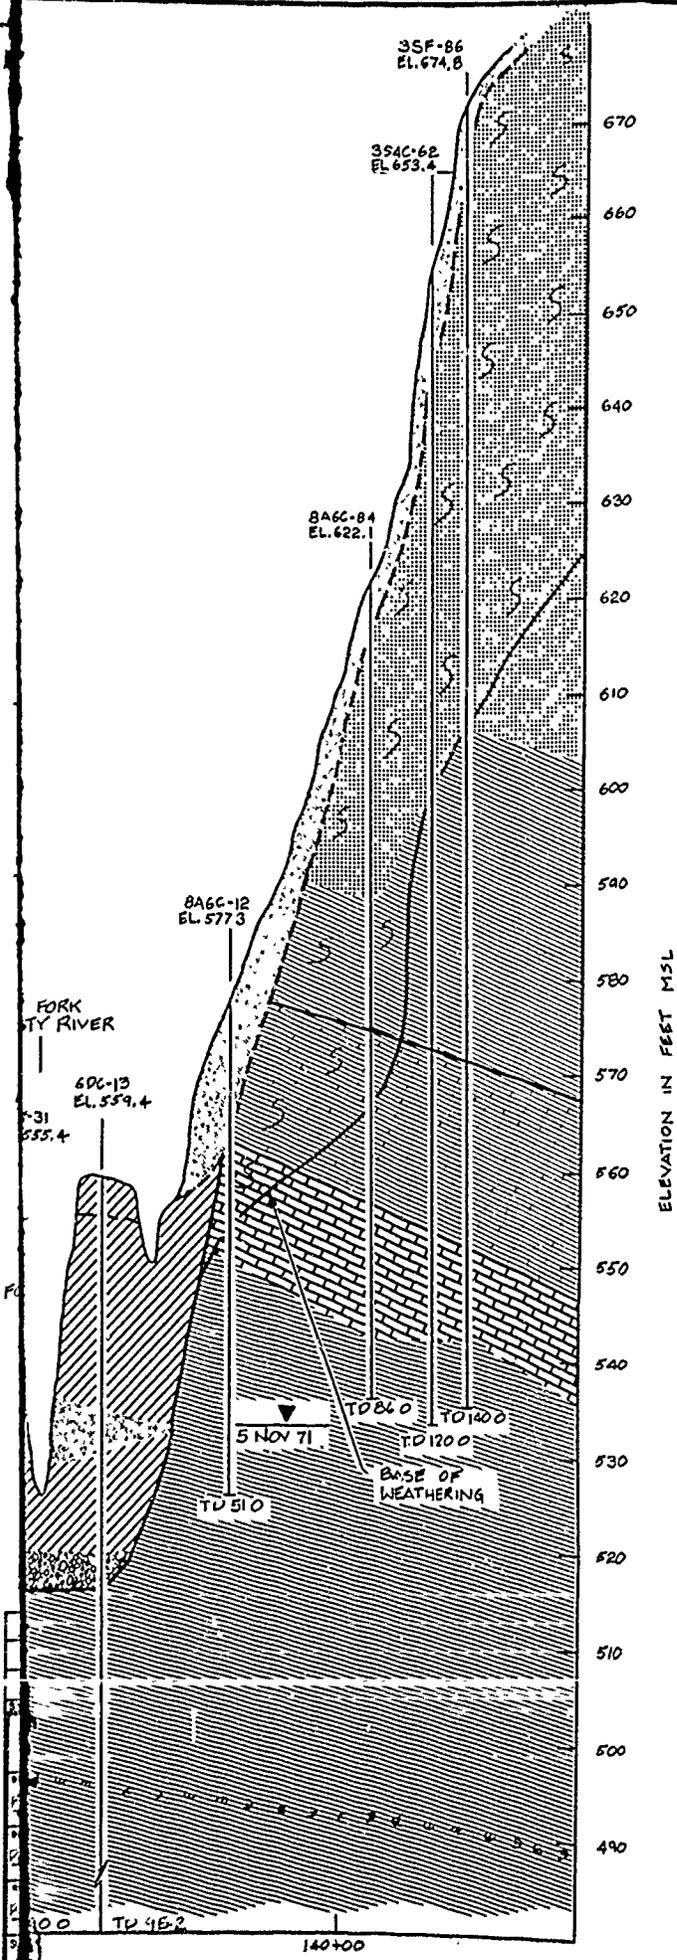



FOR LEGEND AND GENERAL NOTES SEE SEQ 19.1.

RECORD DRAWING-WORK AS BUILT

REV	LOG NO.	ACTION	DATE	DESCRIPTION OF REVISION
U.S. ARMY ENGINEER DISTRICT, FORT WORTH CORPS OF ENGINEERS FORT WORTH, TEXAS				
DESIGNED BY:	RAY ROBERTS LAKE ELM FORK, TRINITY RIVER, TEXAS EMBANKMENT GEOLOGIC PROFILE EMBANKMENT CENTERLINE (STATION 107+00 TO 142+25)			
DRAWN BY:				
CHECKED BY:				
REVIEWED BY:				
SUBMITTED BY:	INVITATION NO. DACW43-82B-0025	DATE: MAR., 1983	SHEET NO. 4	
ENGINEER:	CONTRACT NO. DACW43-82C-0083	DRAWING NUMBER	SHEET NO. OF	

TO ACCOMPANY FOUNDATION REPORT

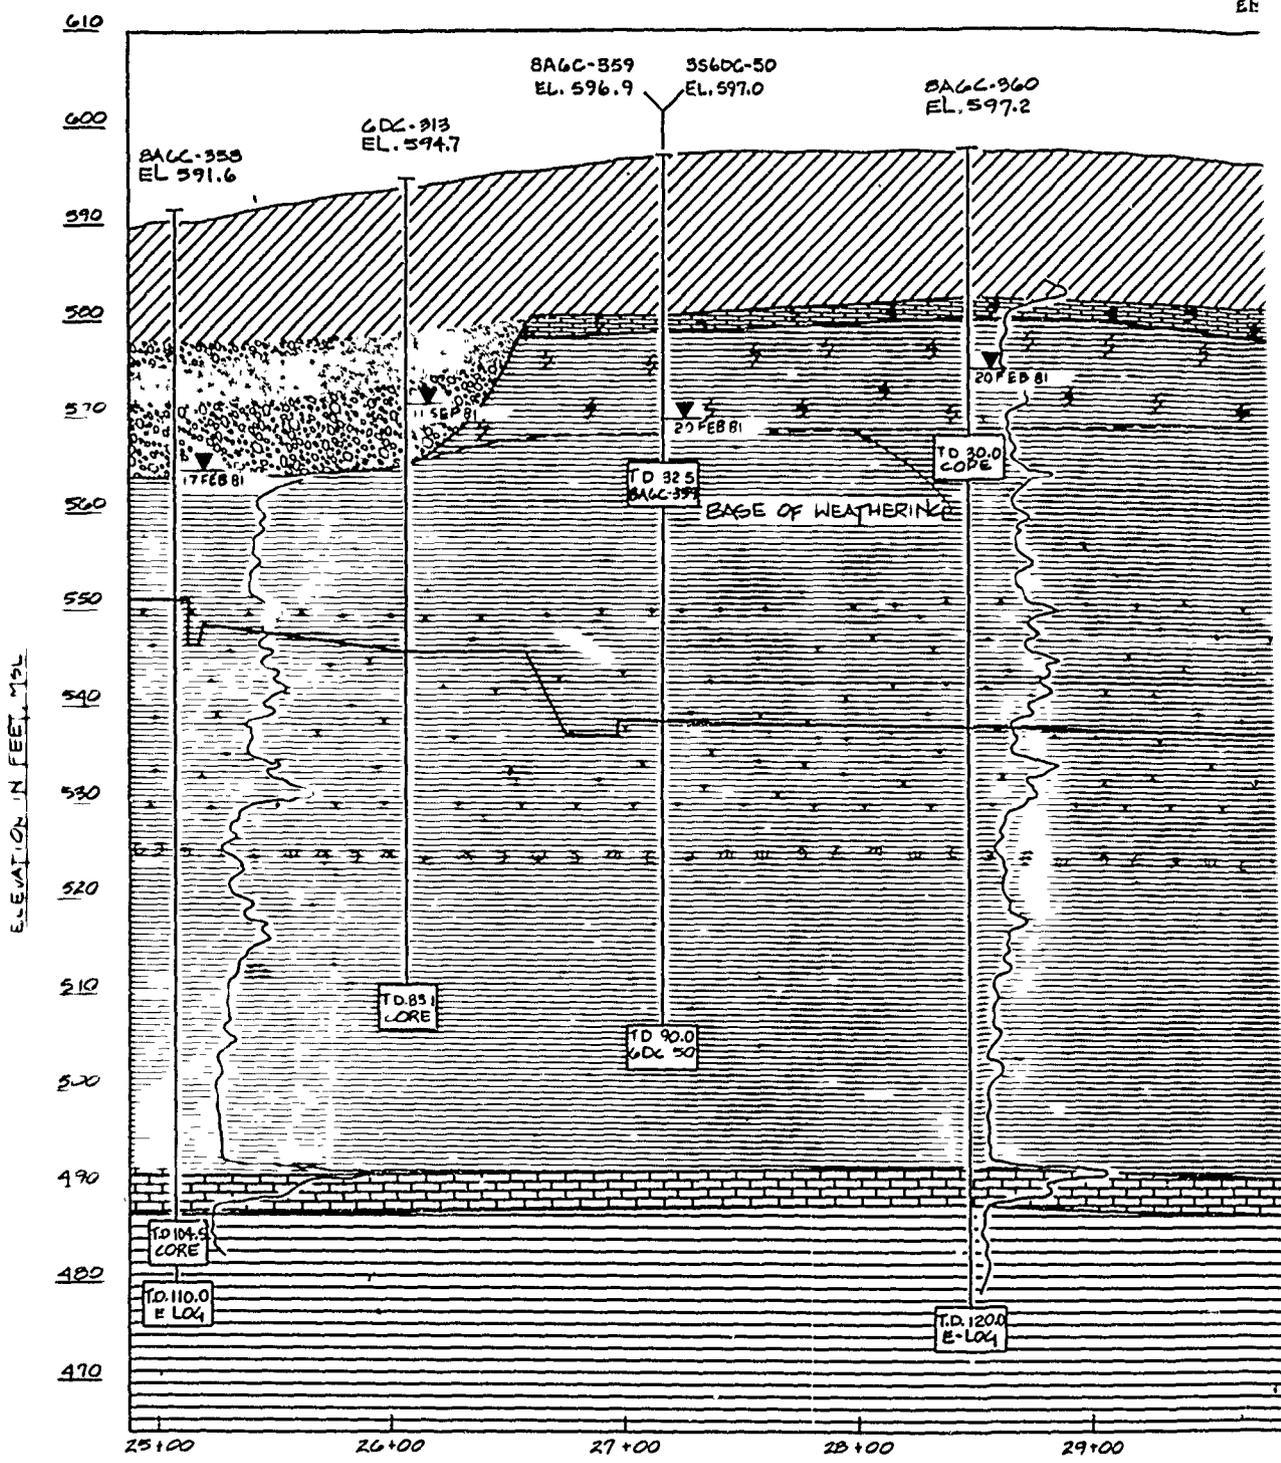

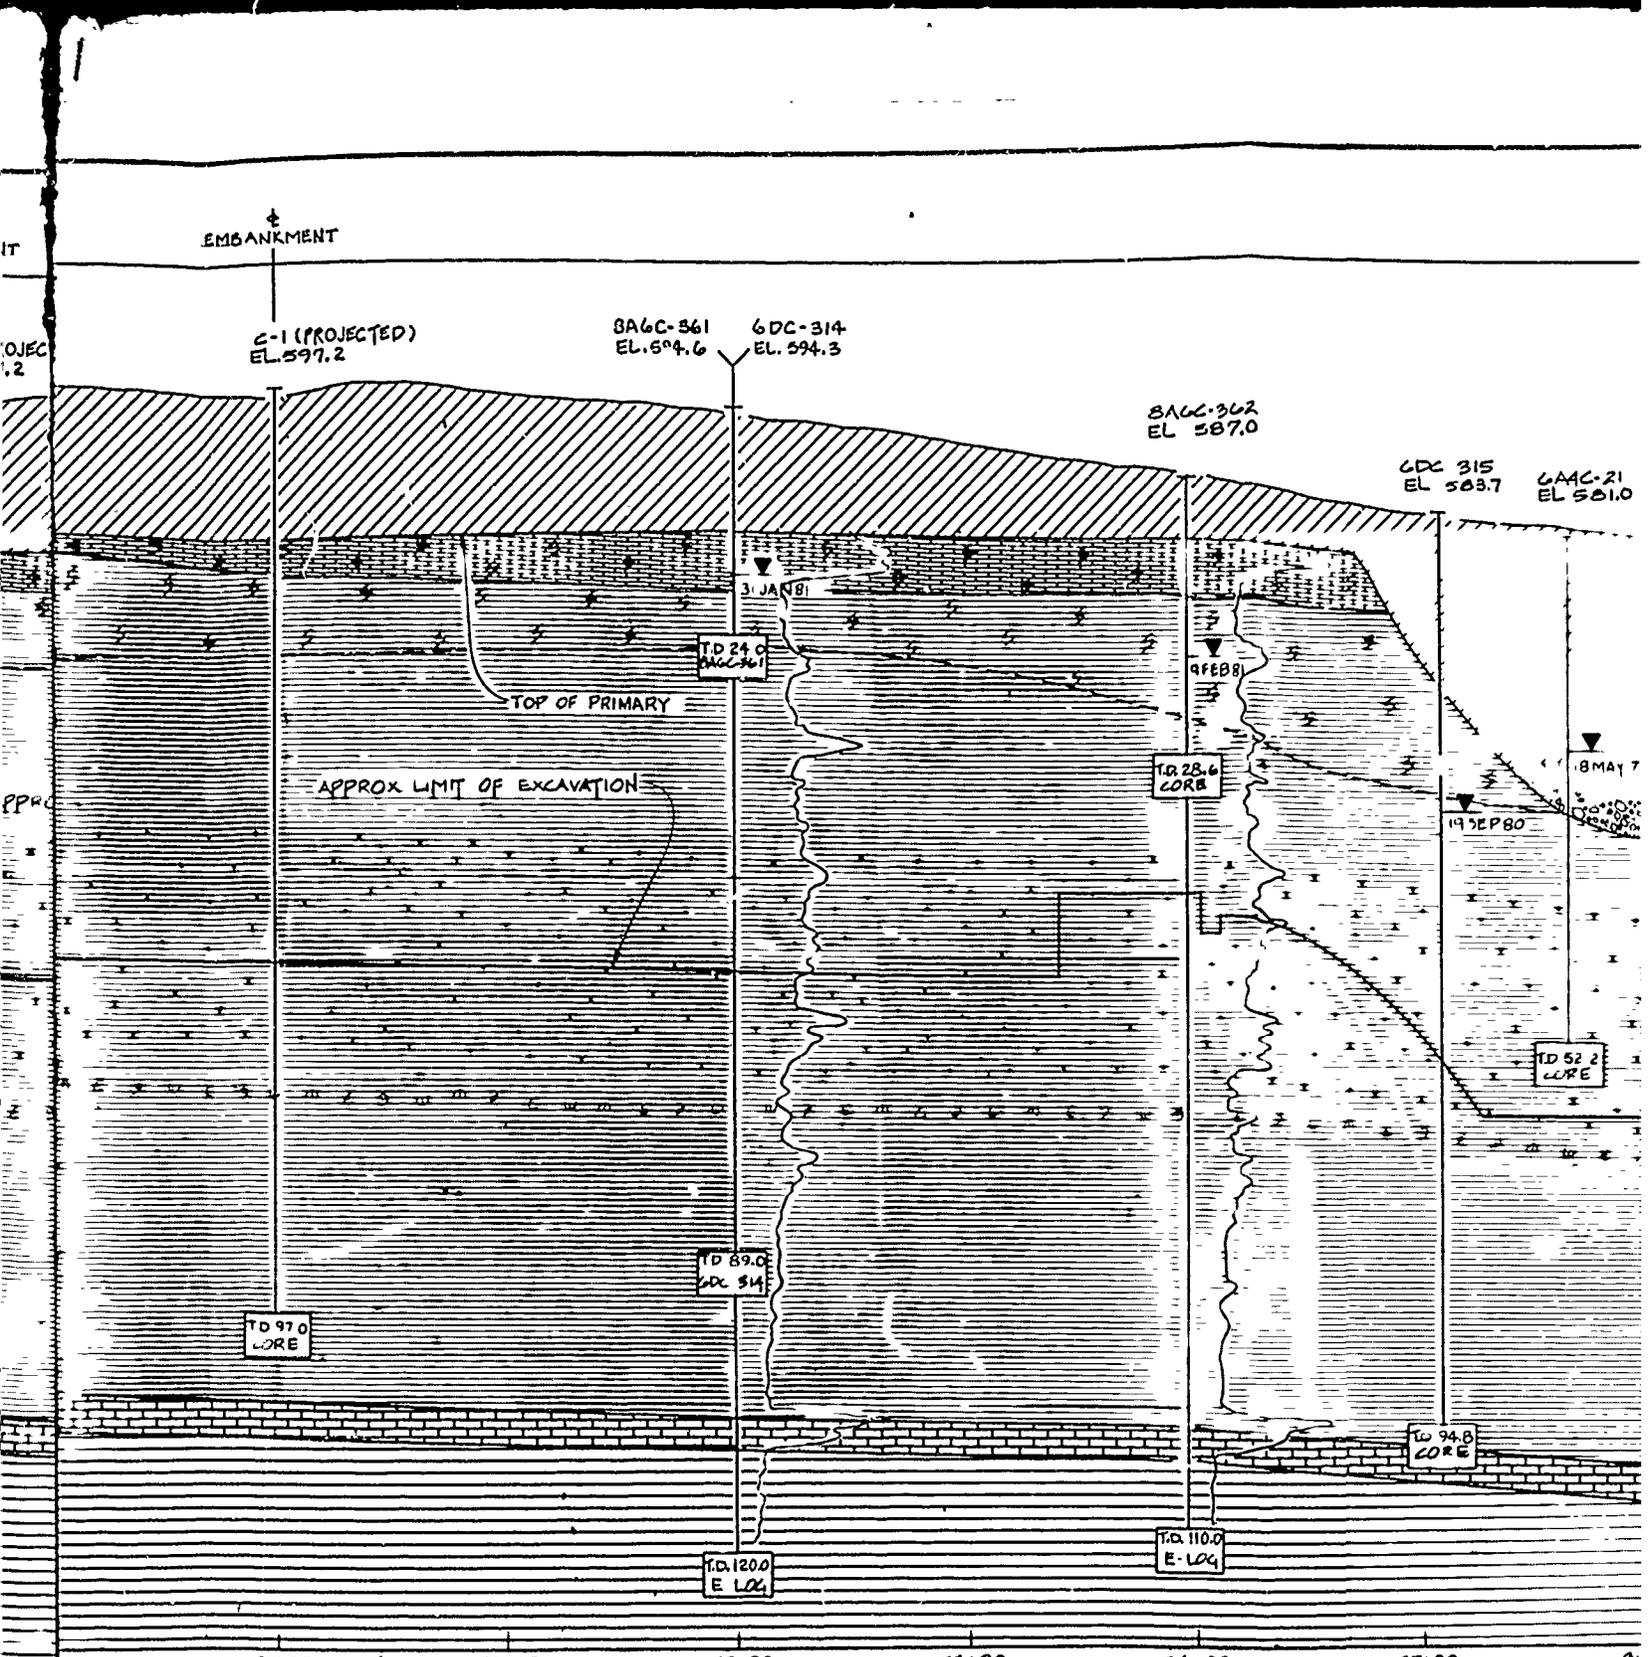


DISTANCES IN STATIONS ALONG OUTLET WORKS

00 30+00 31+00 32+00 33+00 34+00 35+00 36

FOR LEGEND AND GENERAL NOTES SEE SEQ 199.

RECORD DRAWING-WORK AS BUILT

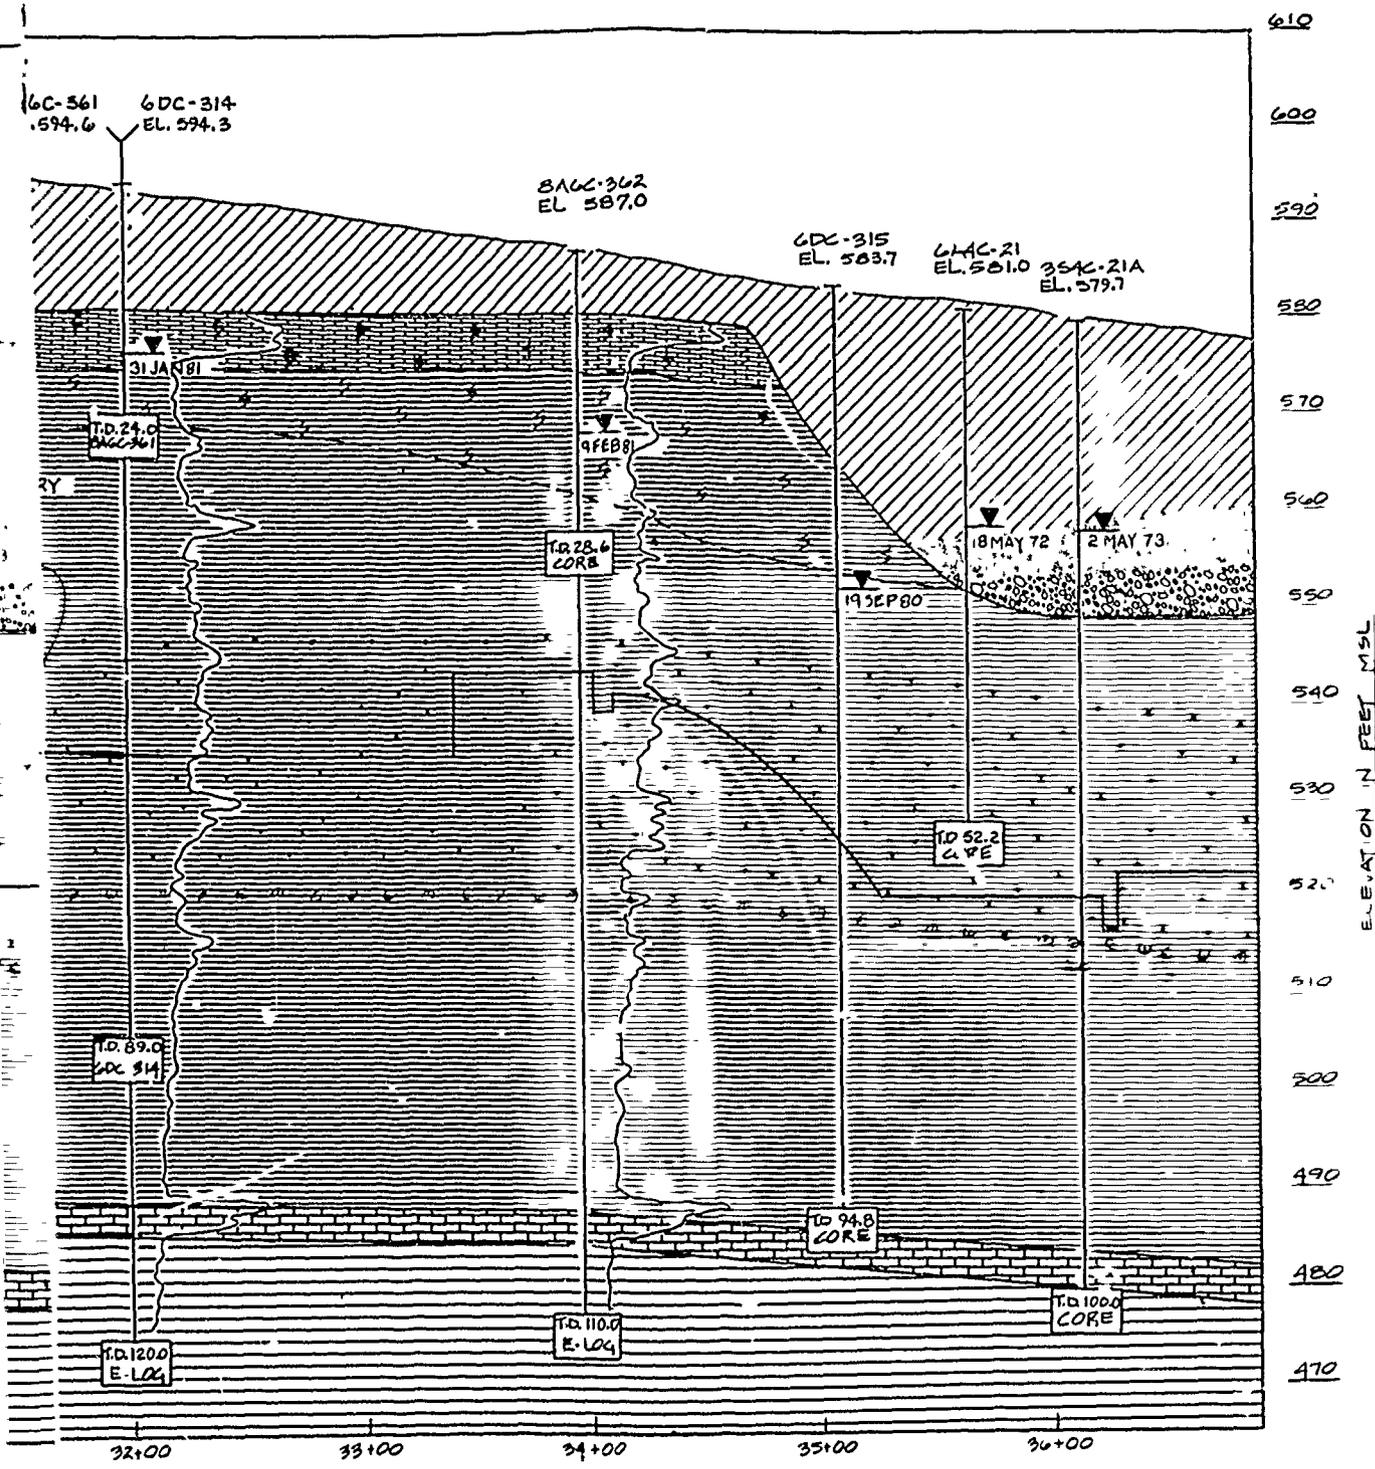



LET WORKS

FOR LEGEND AND GENERAL NOTES SEE SEC 199.


RECORD DRAWING-WORK AS BUILT

REV. NO.	ACTION	DATE	DESCRIPTION OF REVISION
U.S. ARMY ENGINEER DISTRICT, FORT WORTH CORPS OF ENGINEERS FORT WORTH, TEXAS			
DESIGNED BY: R. HAGEN		RAY ROBERTS LAKE ELM FORK, TRINITY RIVER, TEXAS OUTLET WORKS GEOLOGIC PROFILE STATION 25+11 TO STATION 36+27	
DRAWN BY: M. BLAIN			
REVIEWED BY: R. HAGEN			
SUBMITTED BY: M. GREEN ENGINEER		INVITATION NO. DACH 63-82-C-0025 DATE: MAR 78 CONTRACT NO. DACH 63-82-C-0083 DRAWING NUMBER: _____ SHEET NO. OF: 47	

TO ACCOMPANY FOUNDATION REPORT

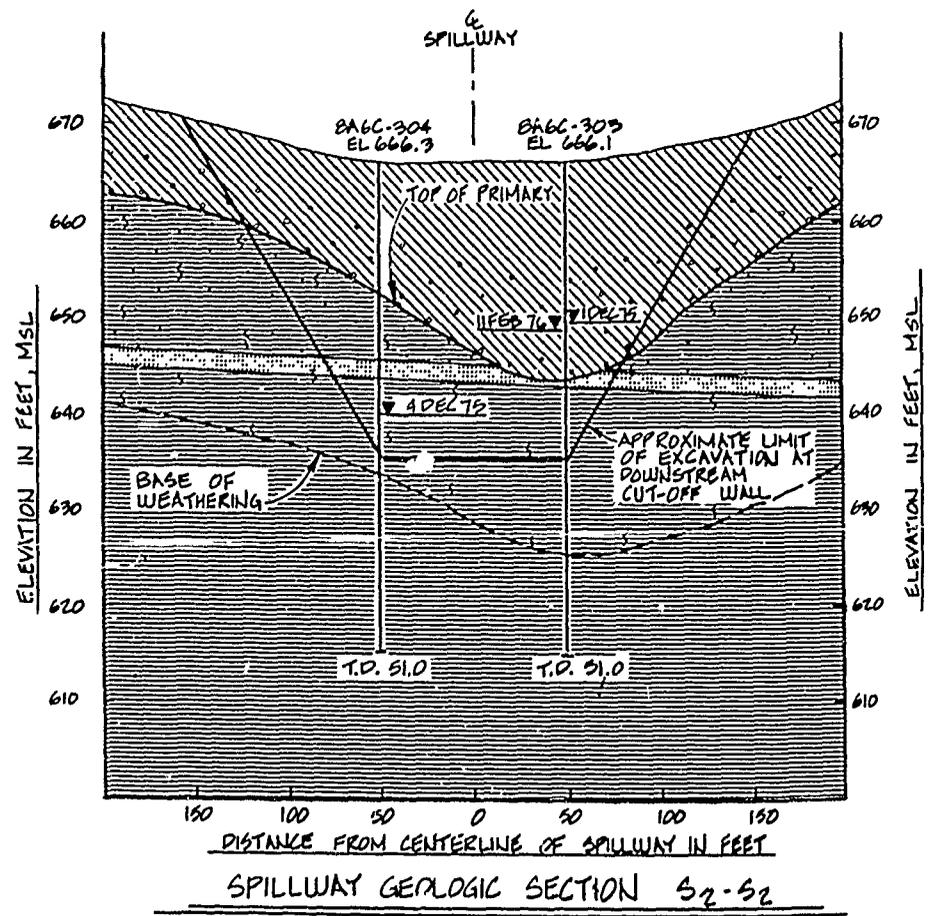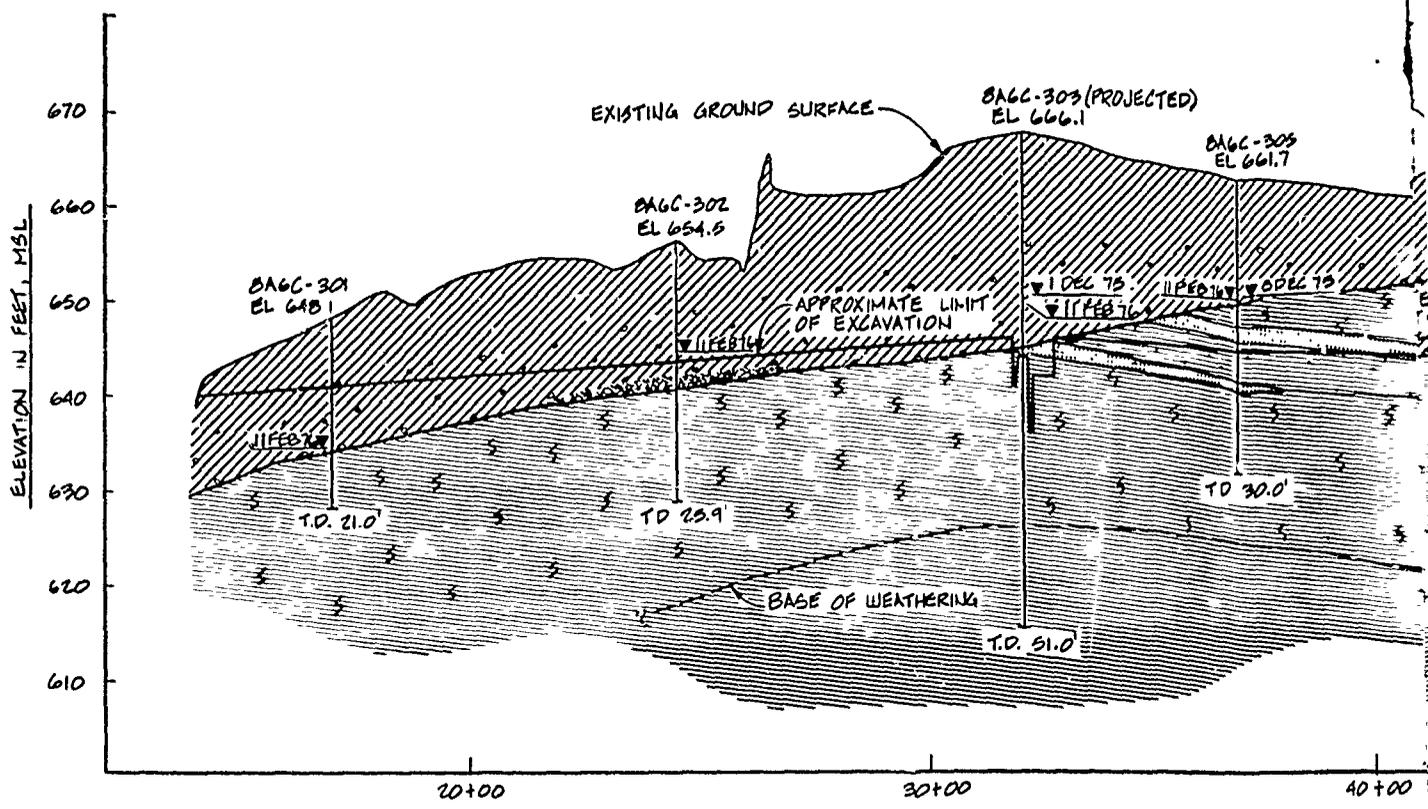

SPILLWAY GEOLOGIC SECTION S2-S2

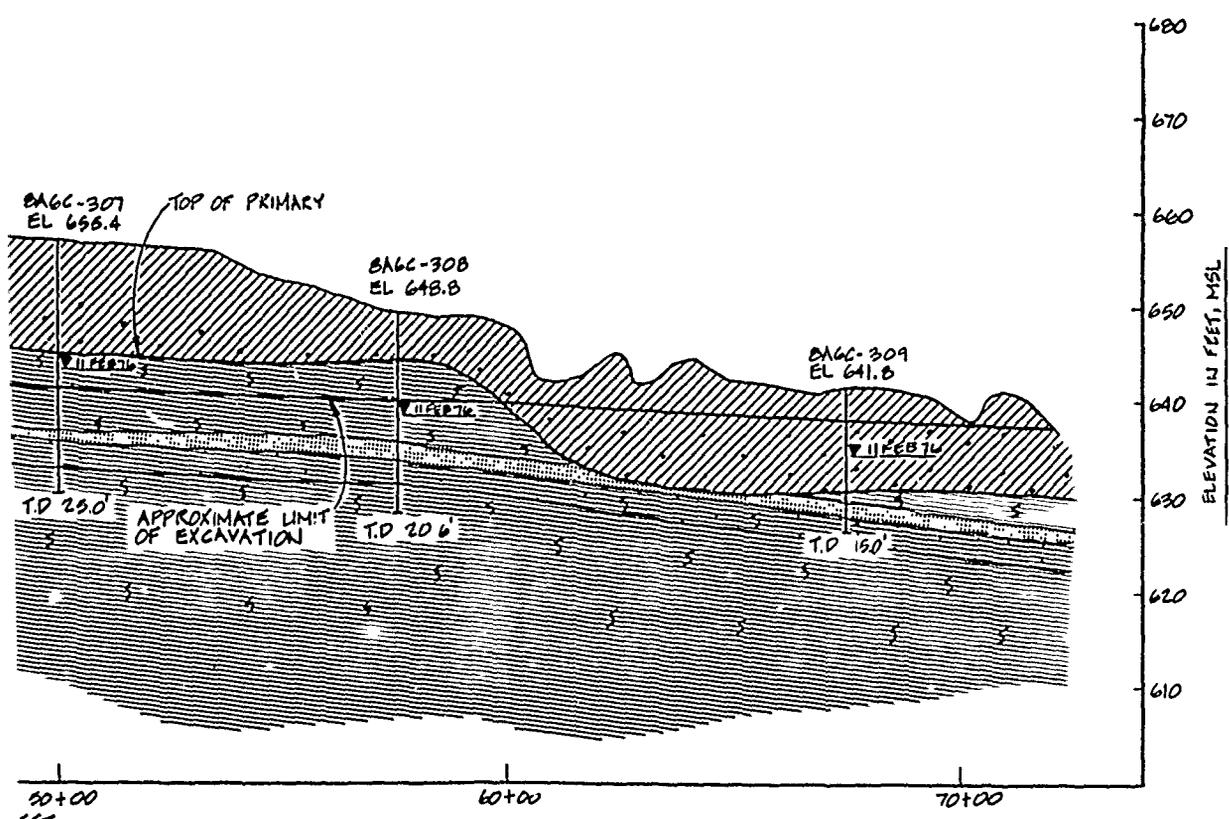


PROFILE S1-S1

- NOTES:
1. FOR LEGEND AND GENERAL NOTES SEE SEQ. 199.
 2. FOR LOCATION OF PROFILE AND SECTION SEE SEQ. 180.

RECORD DRAWING-WORK AS BUILT

REV. NO.	NO.	ACTION	DATE	DESCRIPTION OF REVISION
U.S. ARMY ENGINEER DISTRICT, FORT WORTH CORPS OF ENGINEERS FORT WORTH, TEXAS				
DESIGNED BY:	RAY ROBERTS LAKE			
DRAWN BY:	ELM FORK, TRINITY RIVER, TEXAS			
REVISOR BY:	SPILLWAY, APPROACH CHANNEL AND DISCHARGE CHANNEL			
SUBMITTED BY:	GEOLOGIC PROFILE S1-S1 AND SECTION S2-S2			
ENGINEER:	INVESTIGATION NO. DACHW 63-82-C-0025	DATE: MAR. 1962	SEQUENCE NO. 48	
	CONTRACT NO. DACHW 63-82-C-0023		SHEET NO. OF	48

TO-ACCOMPANY-FOUNDATION-REPORT


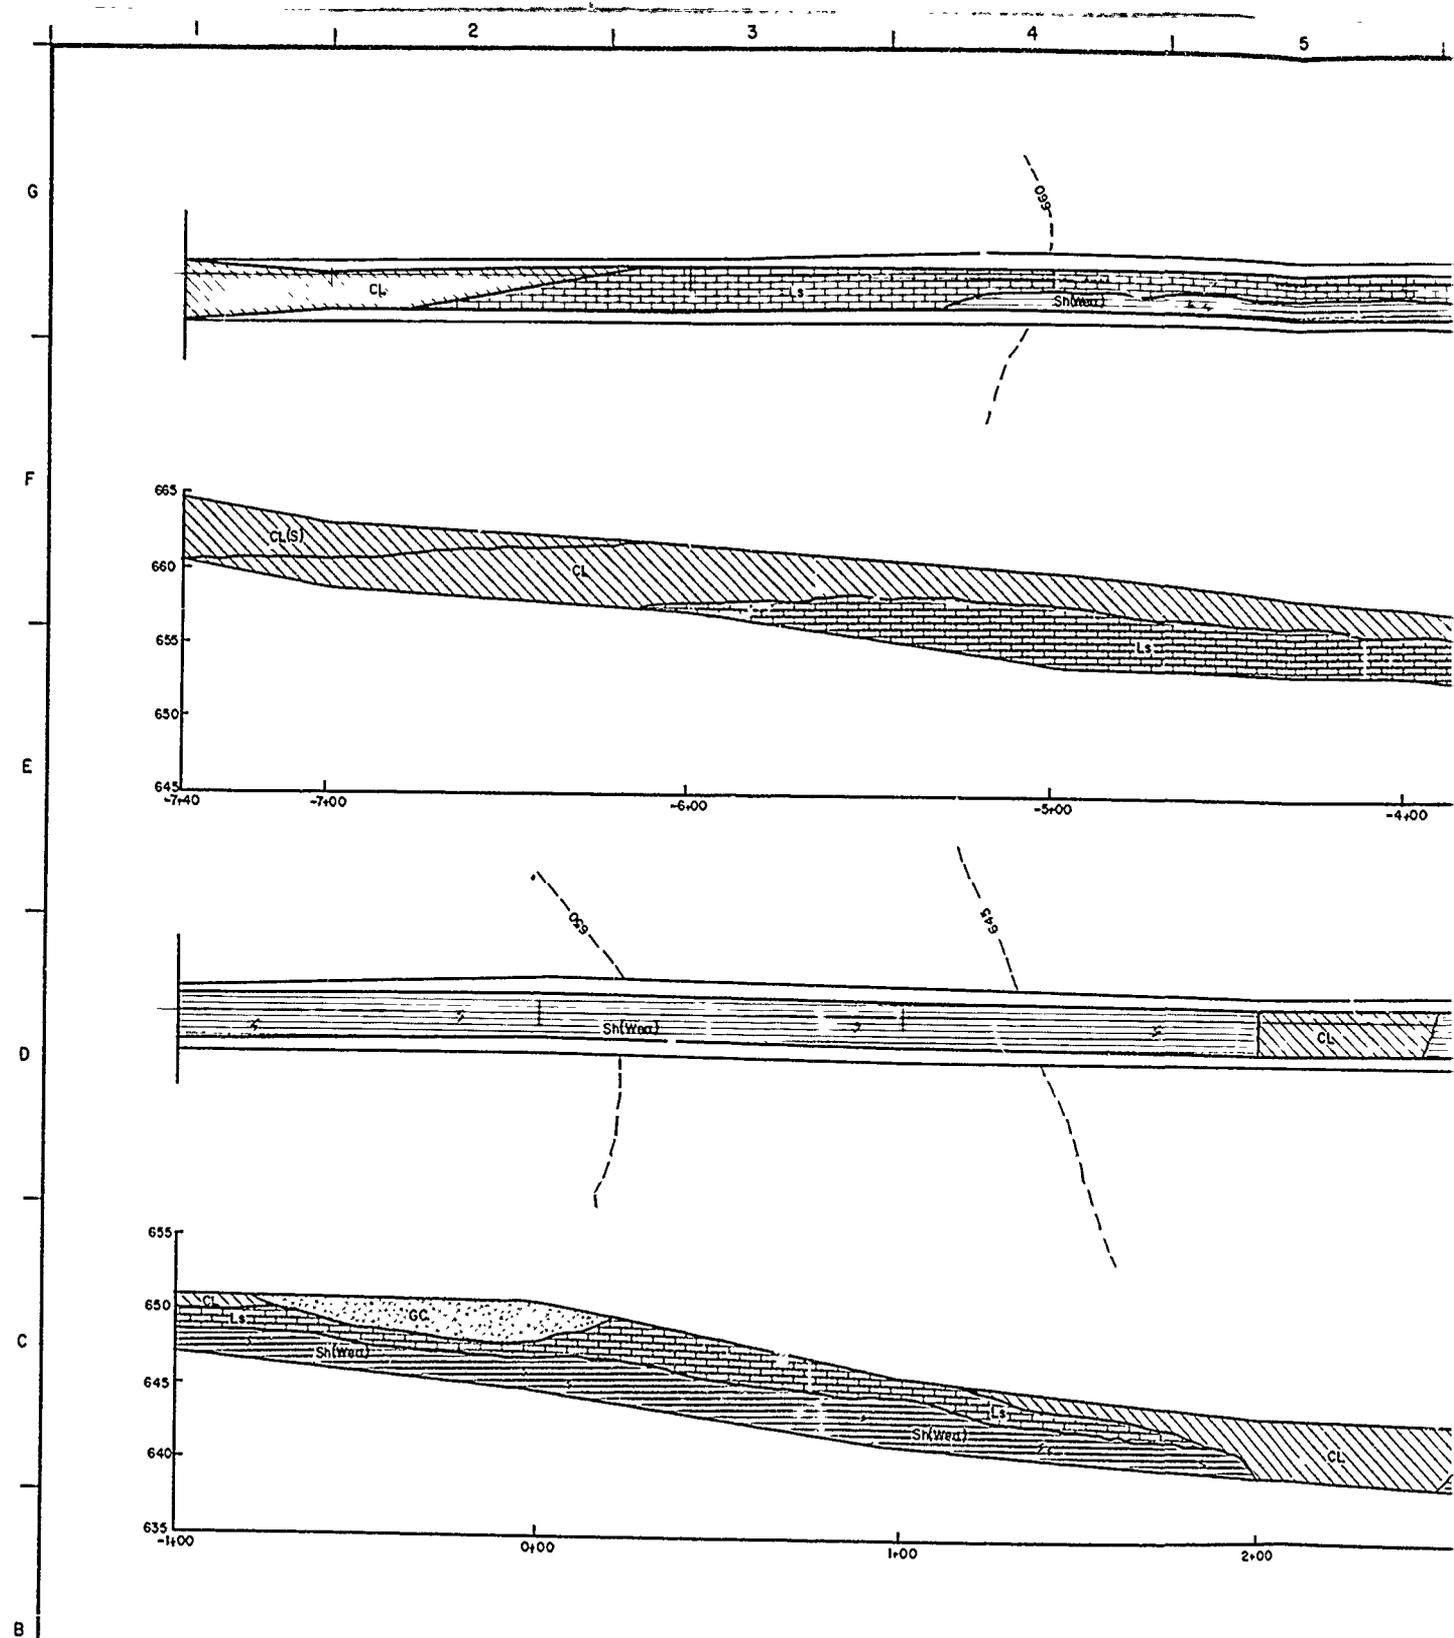


LEGEND

-  CLAY, MEDIUM TO HIGH PLASTICITY, DARK BROWN
-  CLAY, LEAN
-  CLAY, LEAN, SANDY
-  CLAY, GRAVELLY
-  CLAY, HIGH PLASTICITY, ORGANIC, BLACK
-  SAND, CLAYEY, FINE
-  SAND, FINE, POORLY GRADED
-  GRAVEL, VARIABLY CLAYEY
-  CLAY, STIFF, HAS APPEARANCE OF WEATHERED SHALE INCLUDING SHALE-LIKE STRUCTURE.
-  SHALE, WEATHERED
-  SHALE, UNWEATHERED

NOTES


- 1. SECTION
- 2. NO INSI
- 3. PLAN V
- GEOLOG

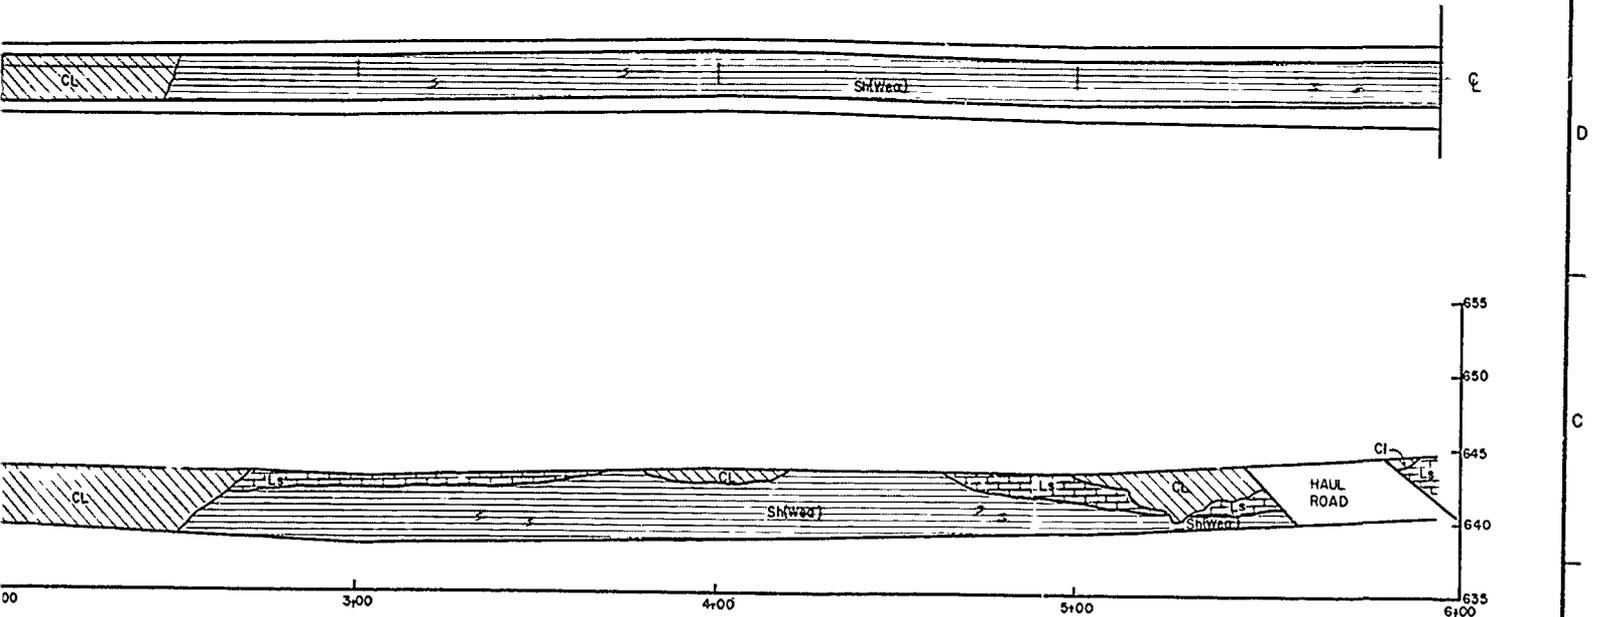
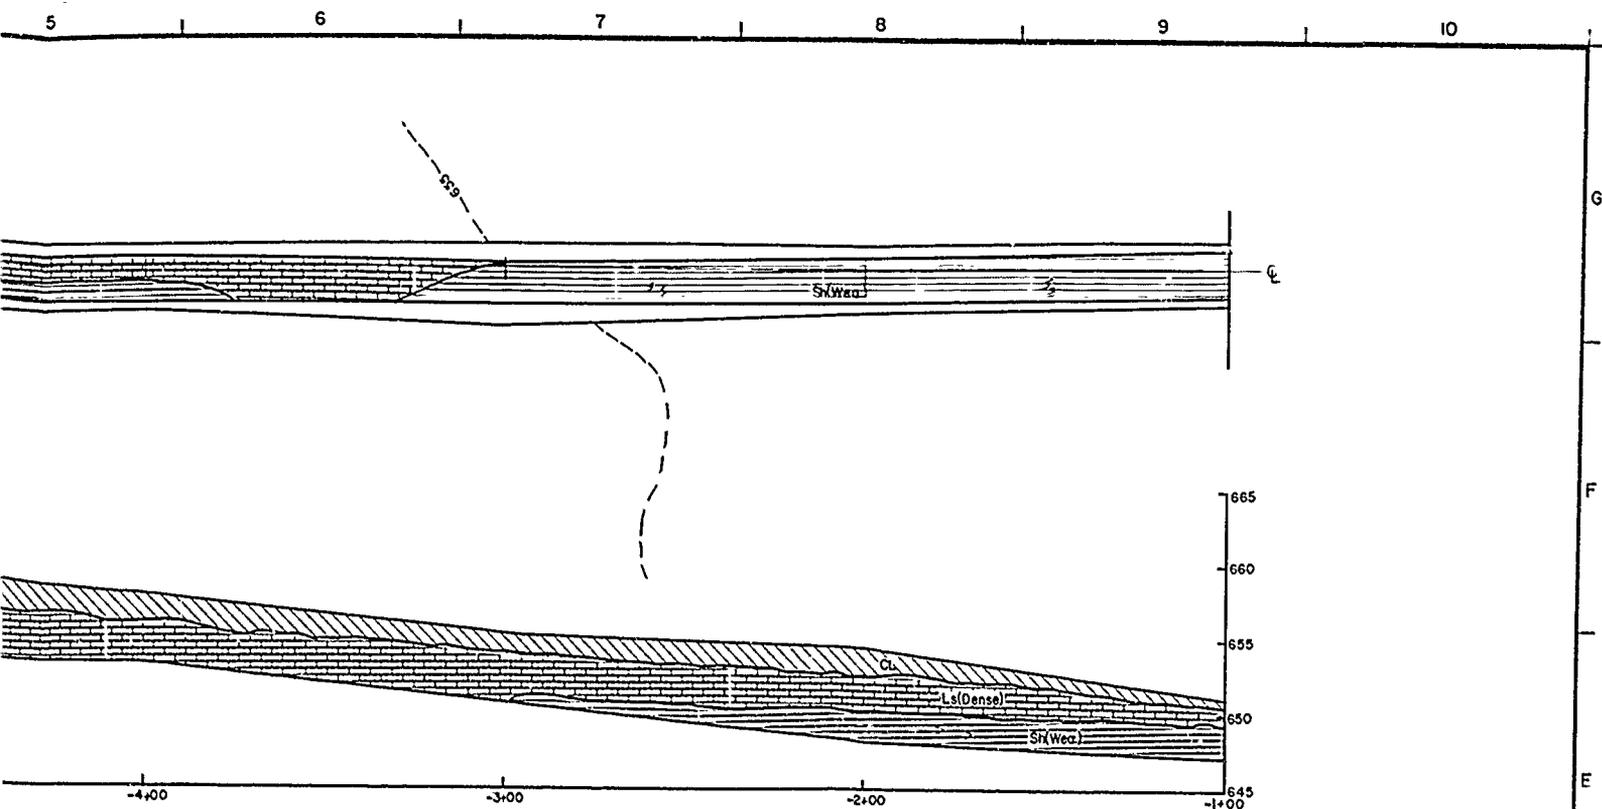


NOTES


1. SECTIONS REPRESENT UPSTREAM(LEFT) FACE OF INSPECTION TRENCH
2. NO INSPECTION TRENCH WAS EXCAVATED BETWEEN STATIONS 117+50 AND 125+50.
3. PLAN VIEW OF INSPECTION TRENCH PRESENTS GEOLOGY OF THE FLOOR ONLY. GEOLOGY OF SIDE SLOPES IS PRESENTED IN THE SECTION.


DESIGNED BY: H. BARNETT		RAY ROBERTS LAKE ELM W'ORK, TRINITY RIVER, TEXAS	
DRAWN BY: C. KIRBY		FOUNDATION REPORT INSPECTION TRENCH AS-BUILT PLAN AND PROFILE STA. -7+40 TO 6+00	
REVIEWED BY: R. BEHM			
SUBMITTED BY: ROBERT C. BEHM		SOL. NO.	DATED:
ENGINEER:		CONTR. NO.	SEQUENCE NO.
		DRAWING NUMBER	SHEET NO.

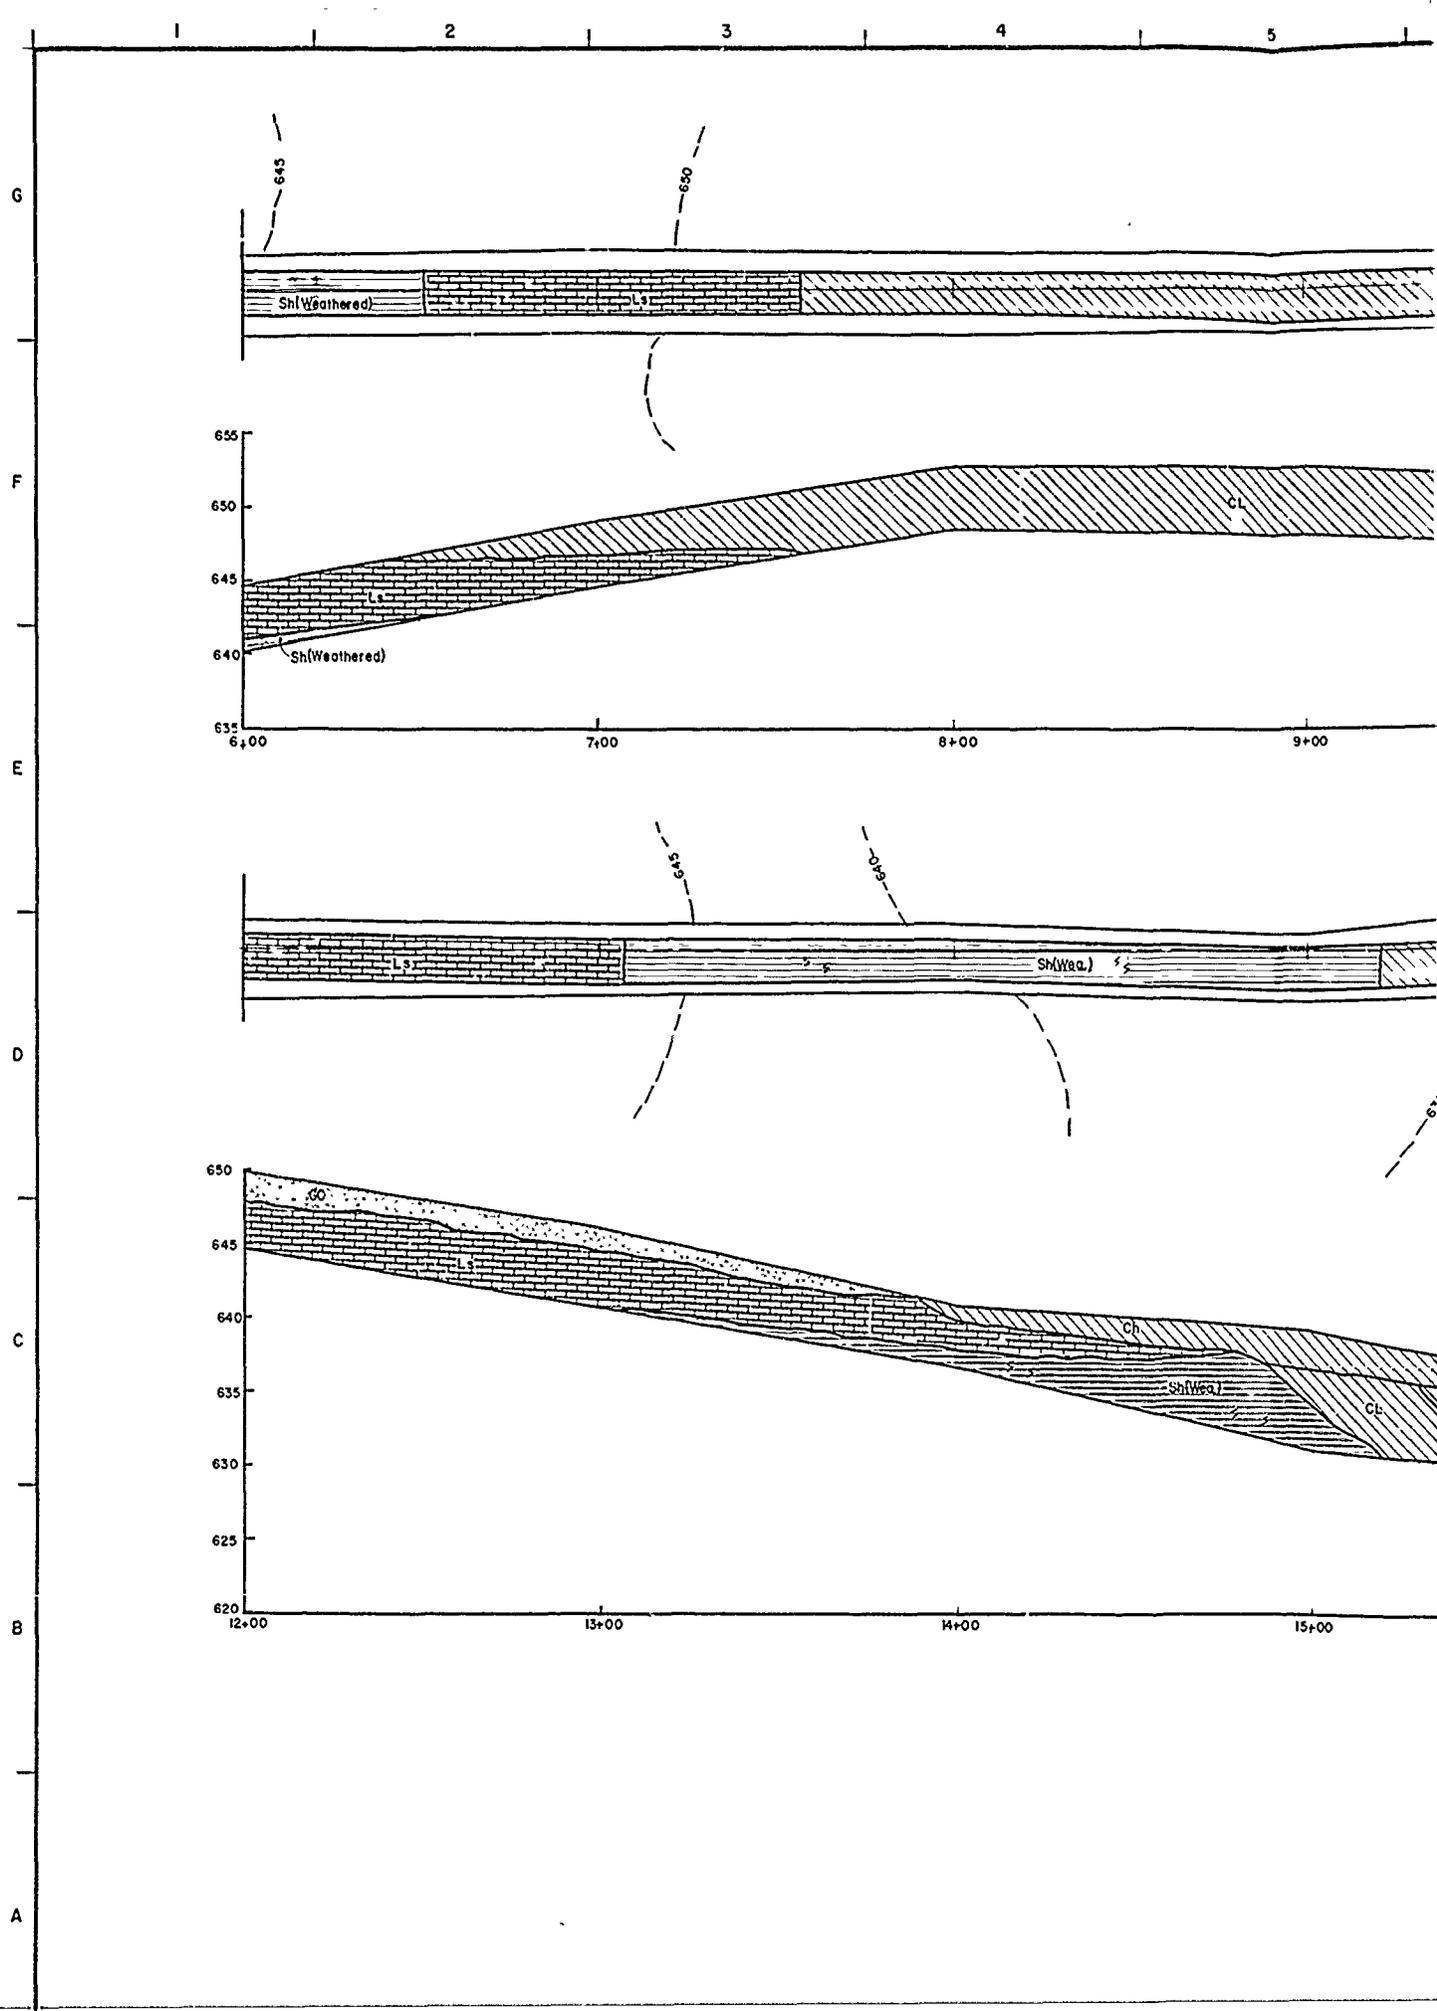

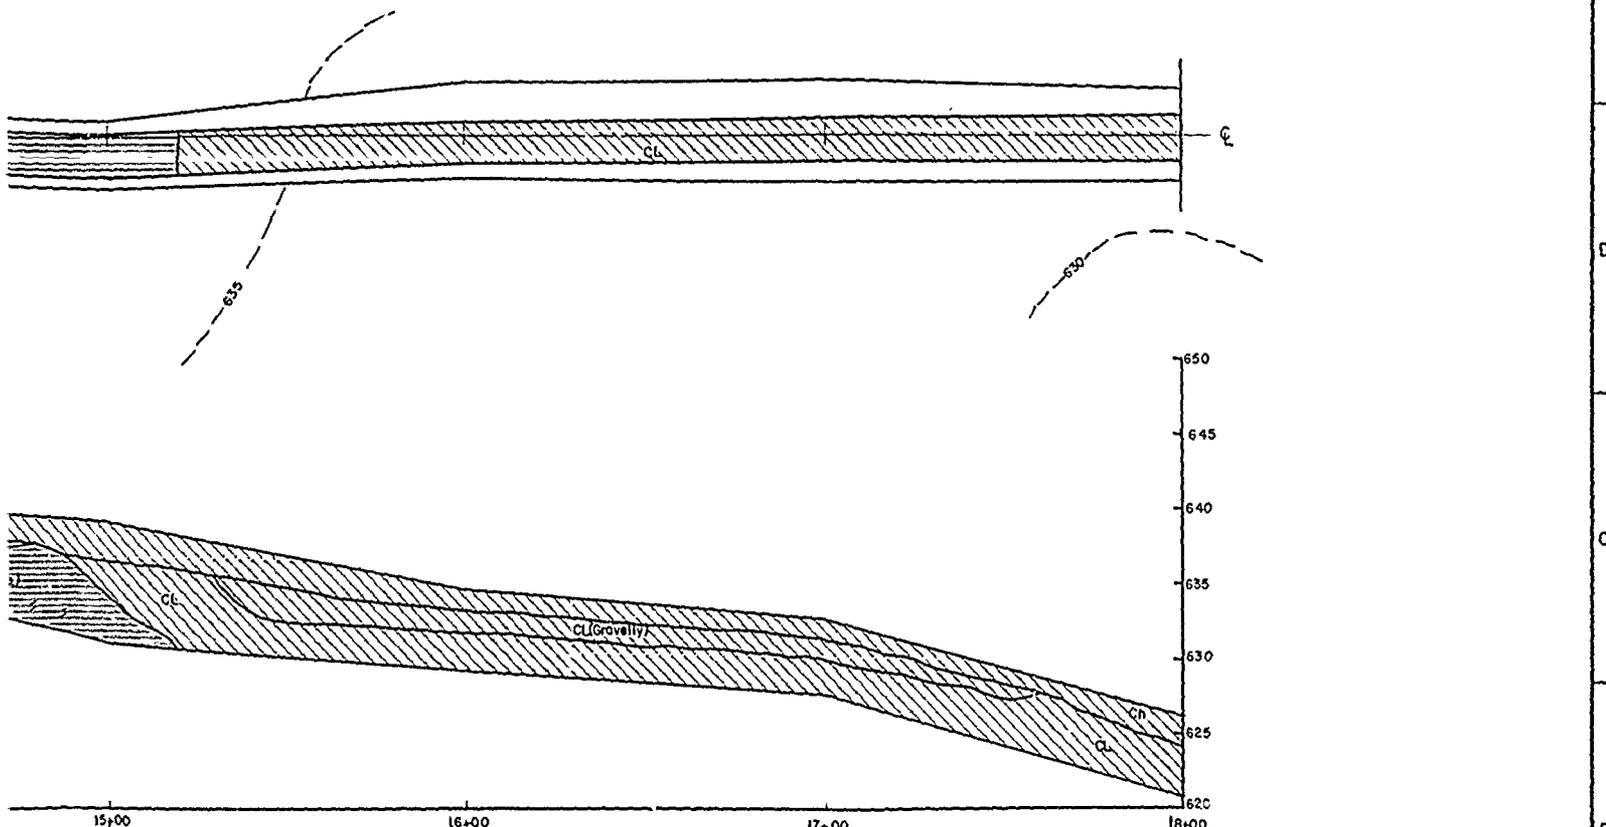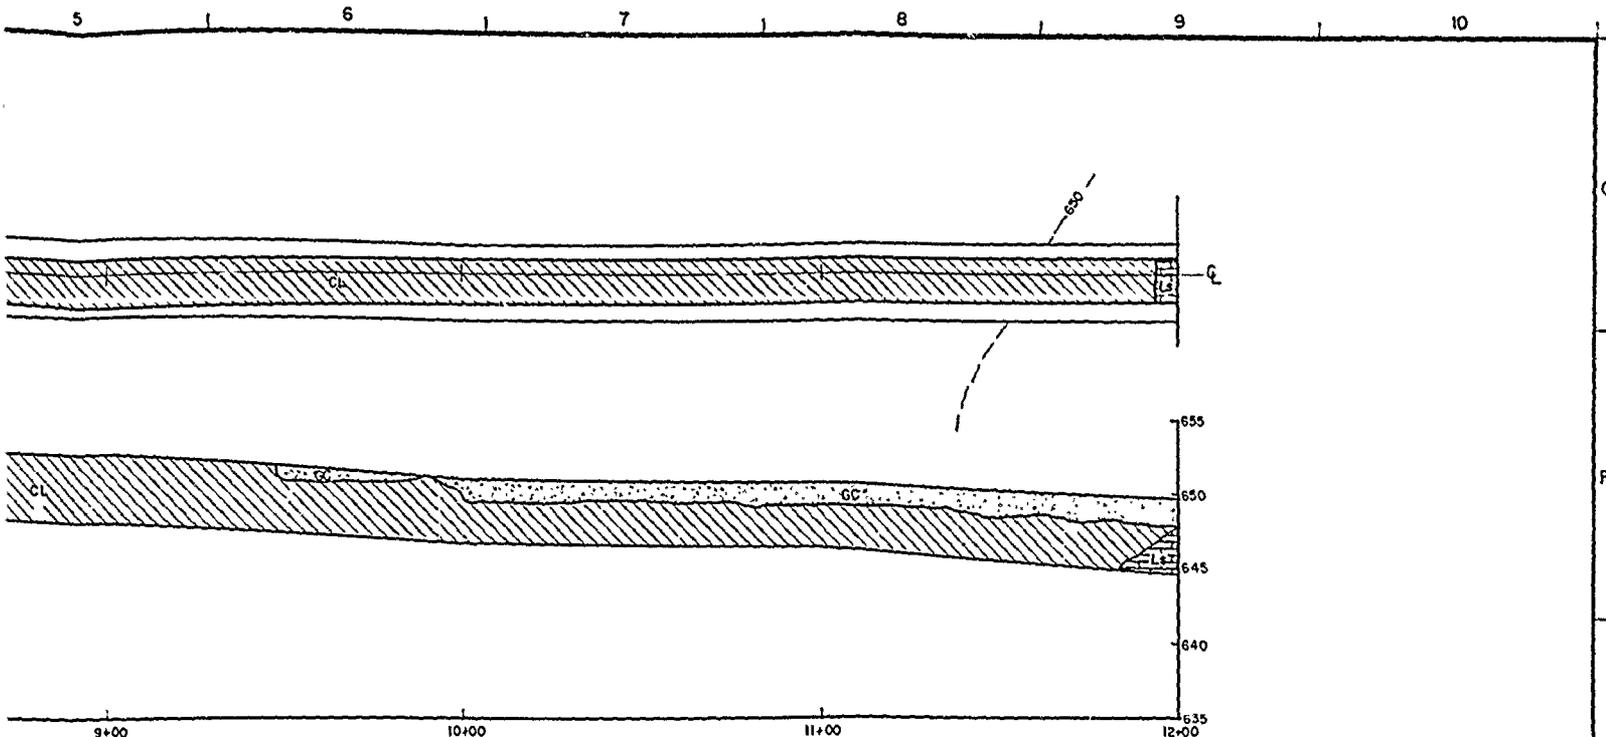



DESIGNED BY: H. BARNETT		DRAWN BY: C. KIRBY		REVIEWED BY: R. BEHM		SUBMITTED BY: ROBERT C. BEHM		ENGINEER:		SOL. NO.		DATED:		SEQUENCE NO. 50	
U.S. ARMY ENGINEER DISTRICT, FORT WORTH CORPS OF ENGINEERS FORT WORTH, TEX 8										RAY ROBERTS LAKE ELM FORK, TRINITY RIVER, TEXAS					
FOUNDATION REPORT INSPECTION TRENCH AS-BUILT PLAN AND PROFILE STA. 6+00 TO 18+00															

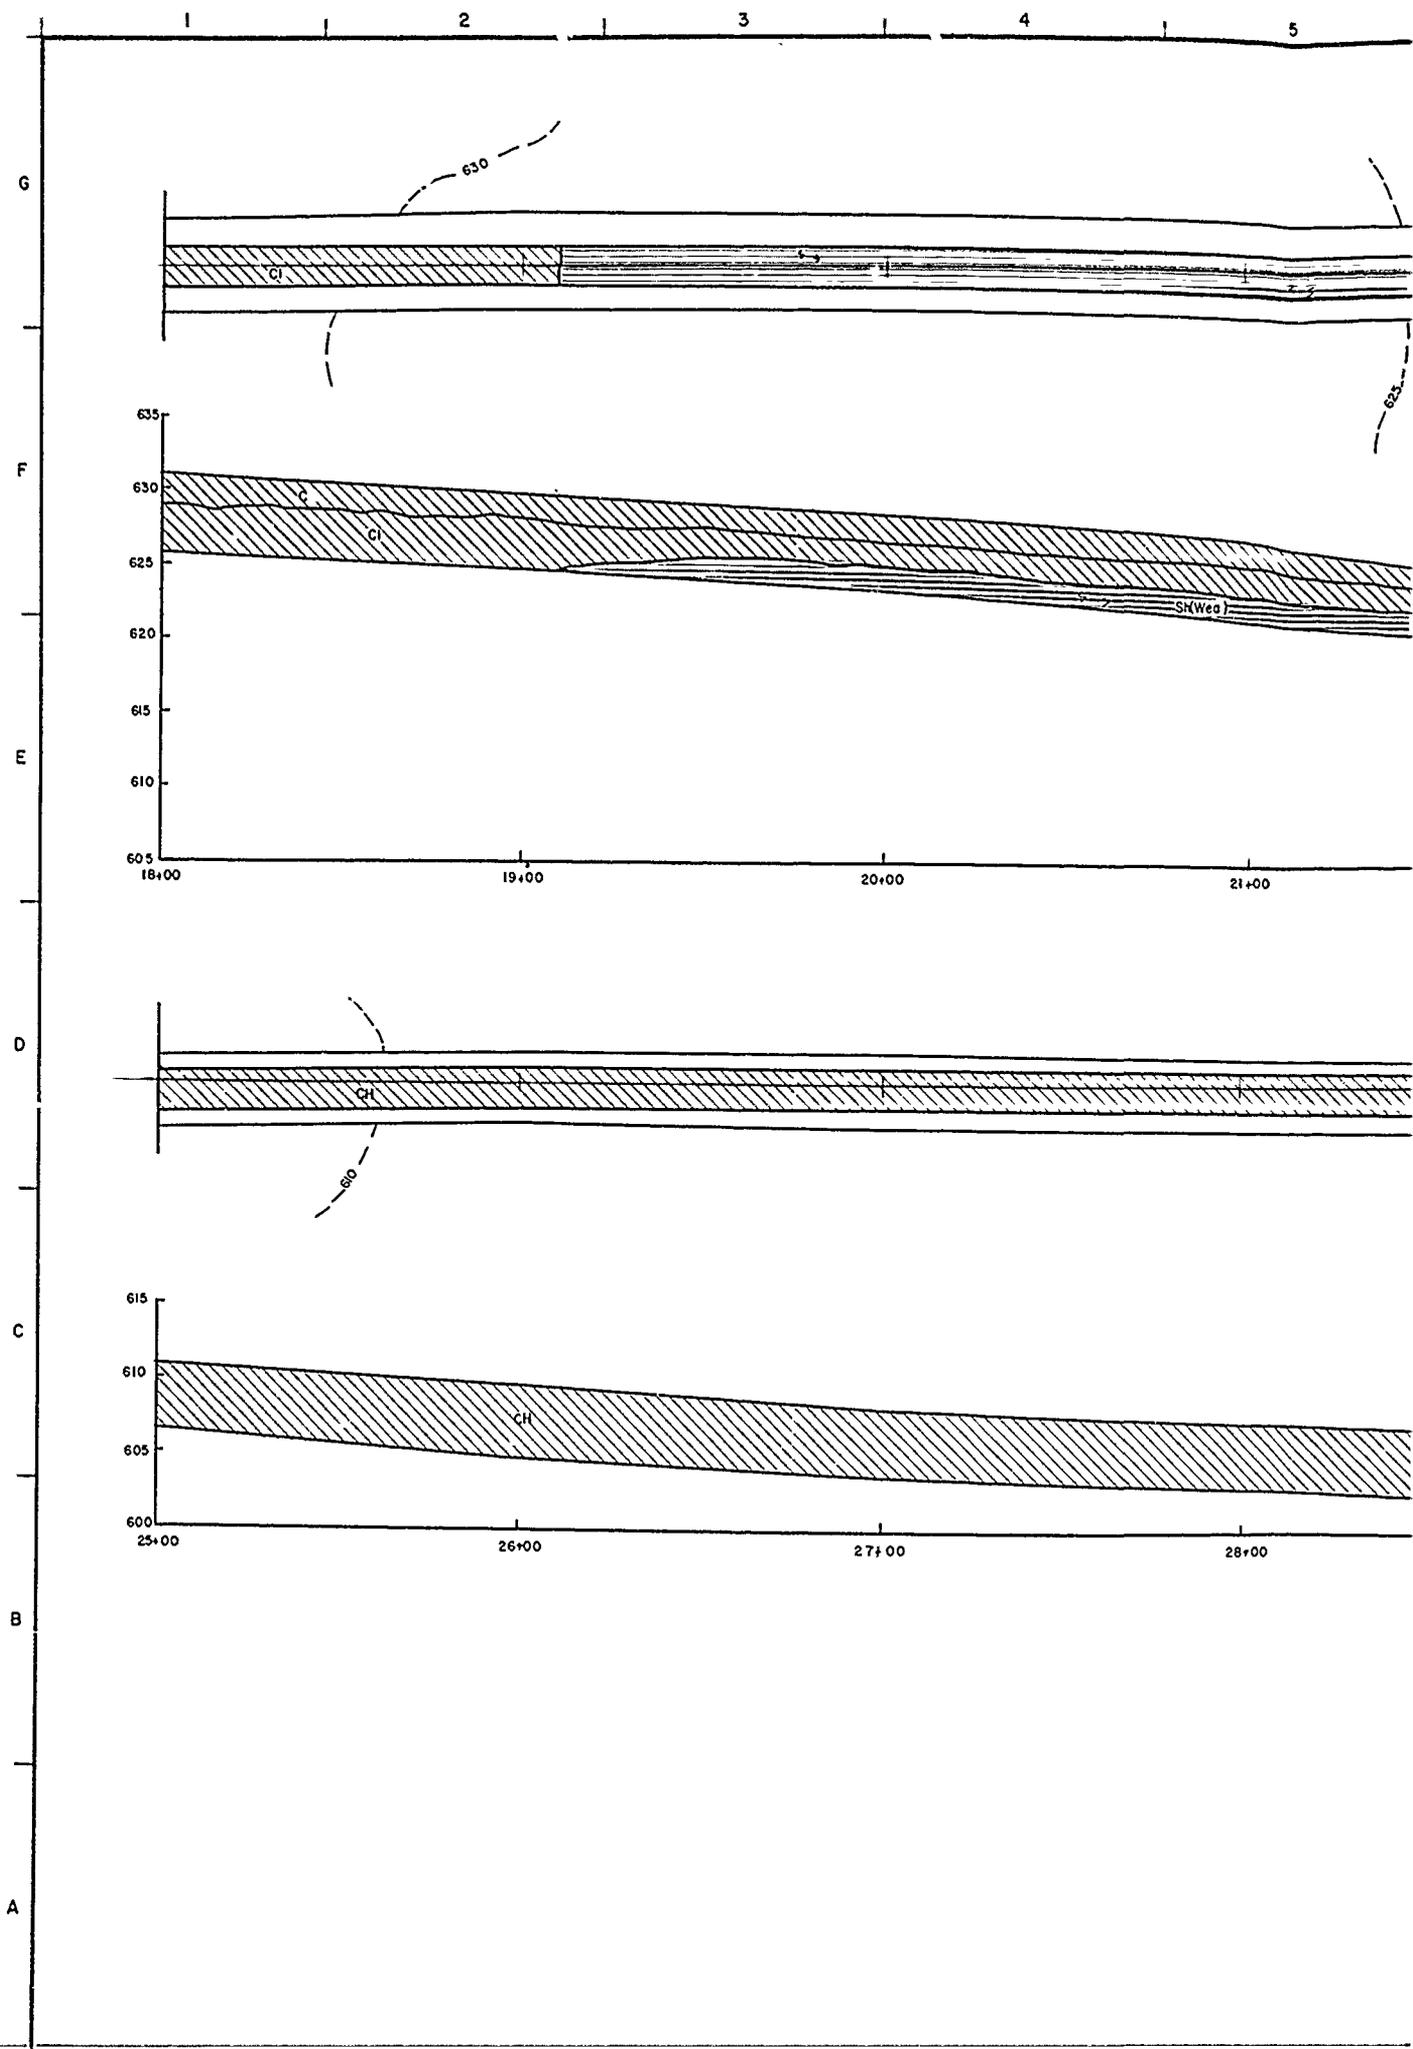

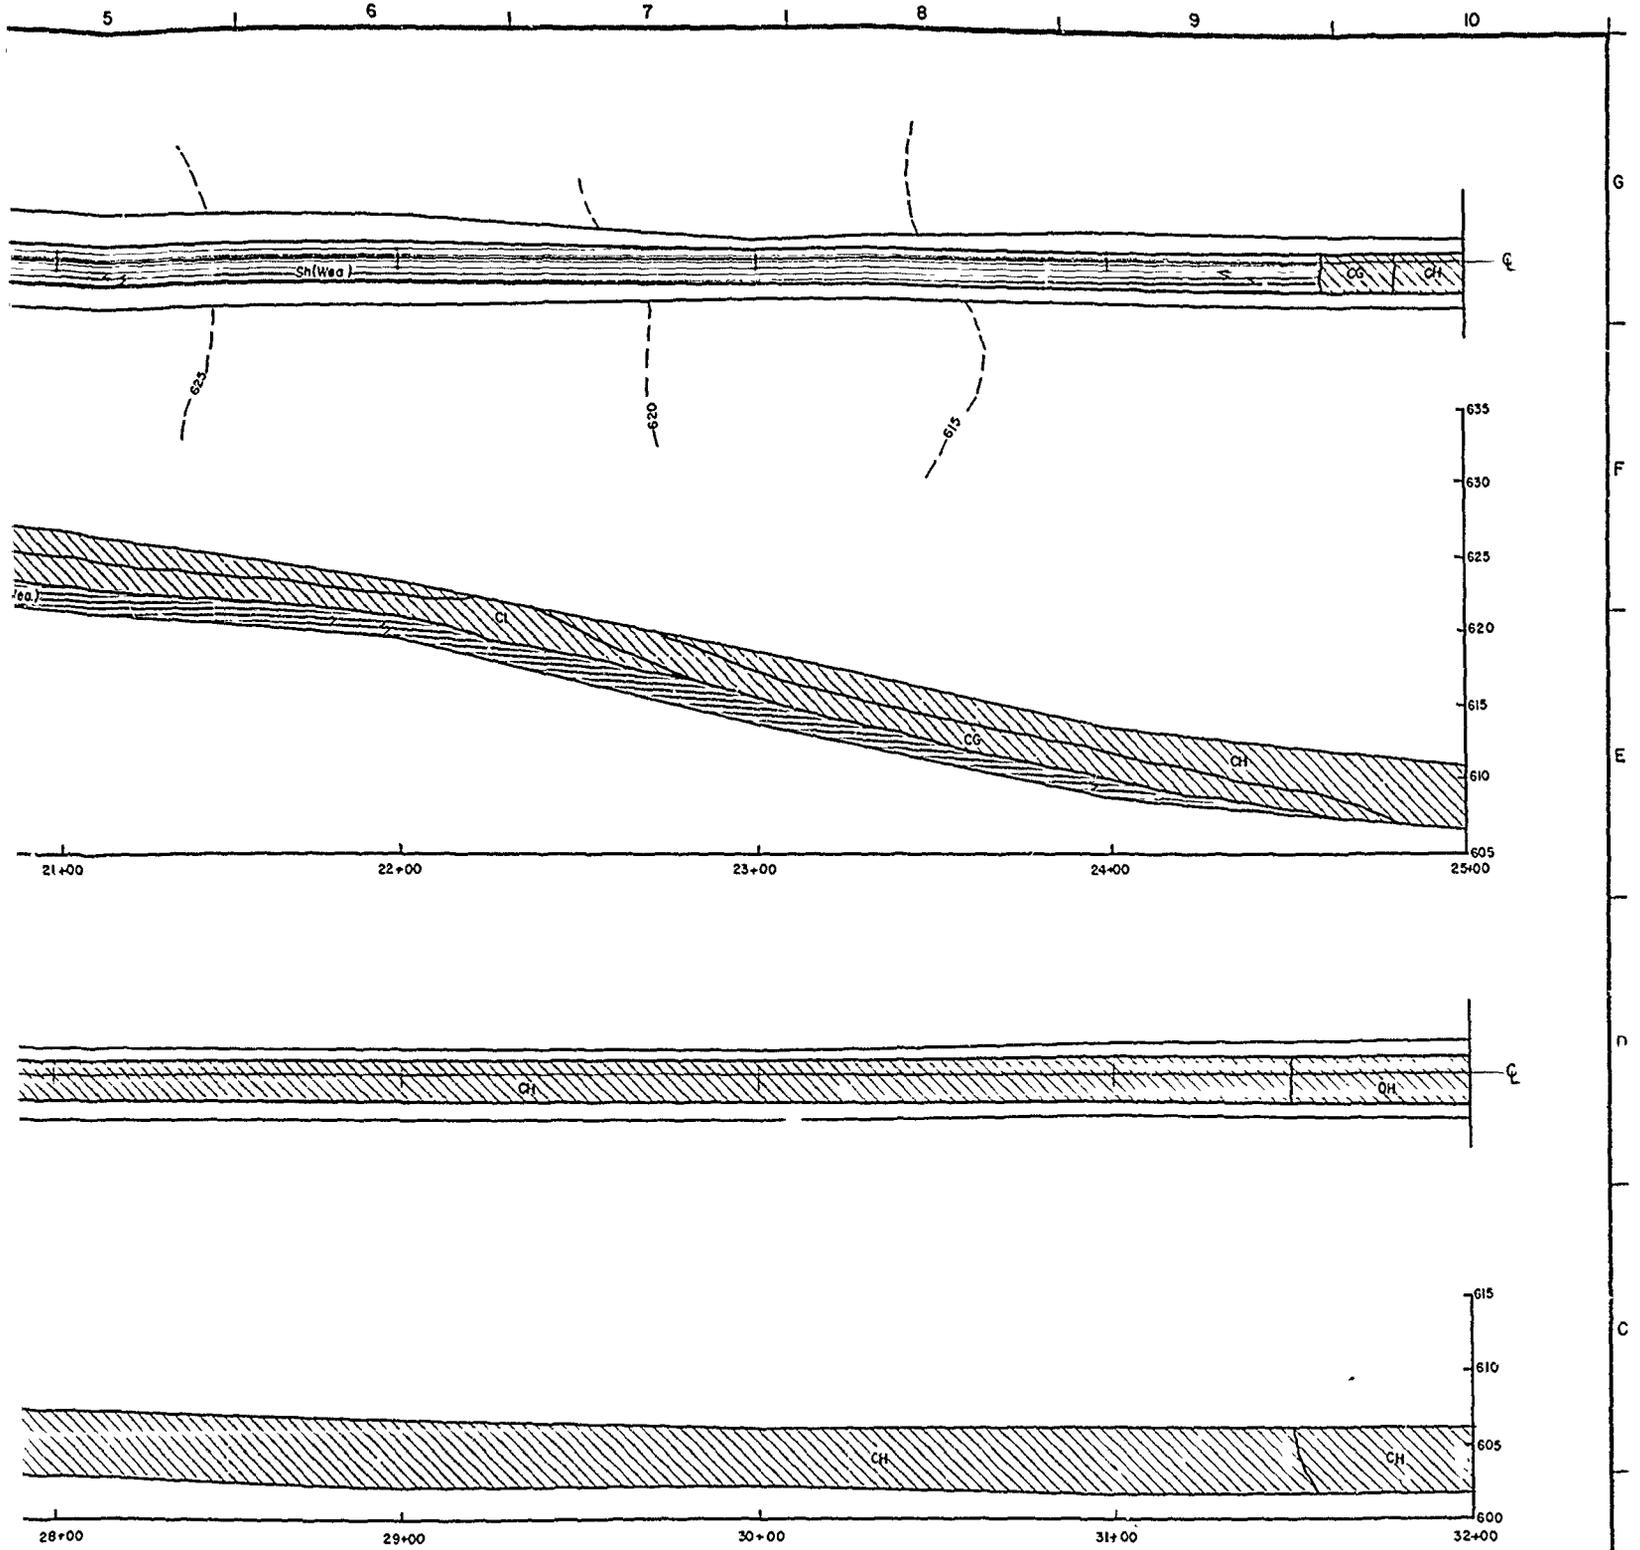



DESIGNED BY: H. BARNETT		RAY ROBERTS LAKE ELM FORK, TRINITY RIVER, TEXAS	
DRAWN BY: C. KIRBY		FOUNDATION REPORT INSPECTION TRENCH AS-BUILT PLAN AND PROFILE STA. 18+00 TO 32+00	
REVIEWED BY: R. BEHM			
SUBMITTED BY: ROBERT C. BEHM		CONTR. NO.	DATED:
ENGINEER:		DRAWING NUMBER	SHEET NO. OF
		SEQUENCE NO.	51

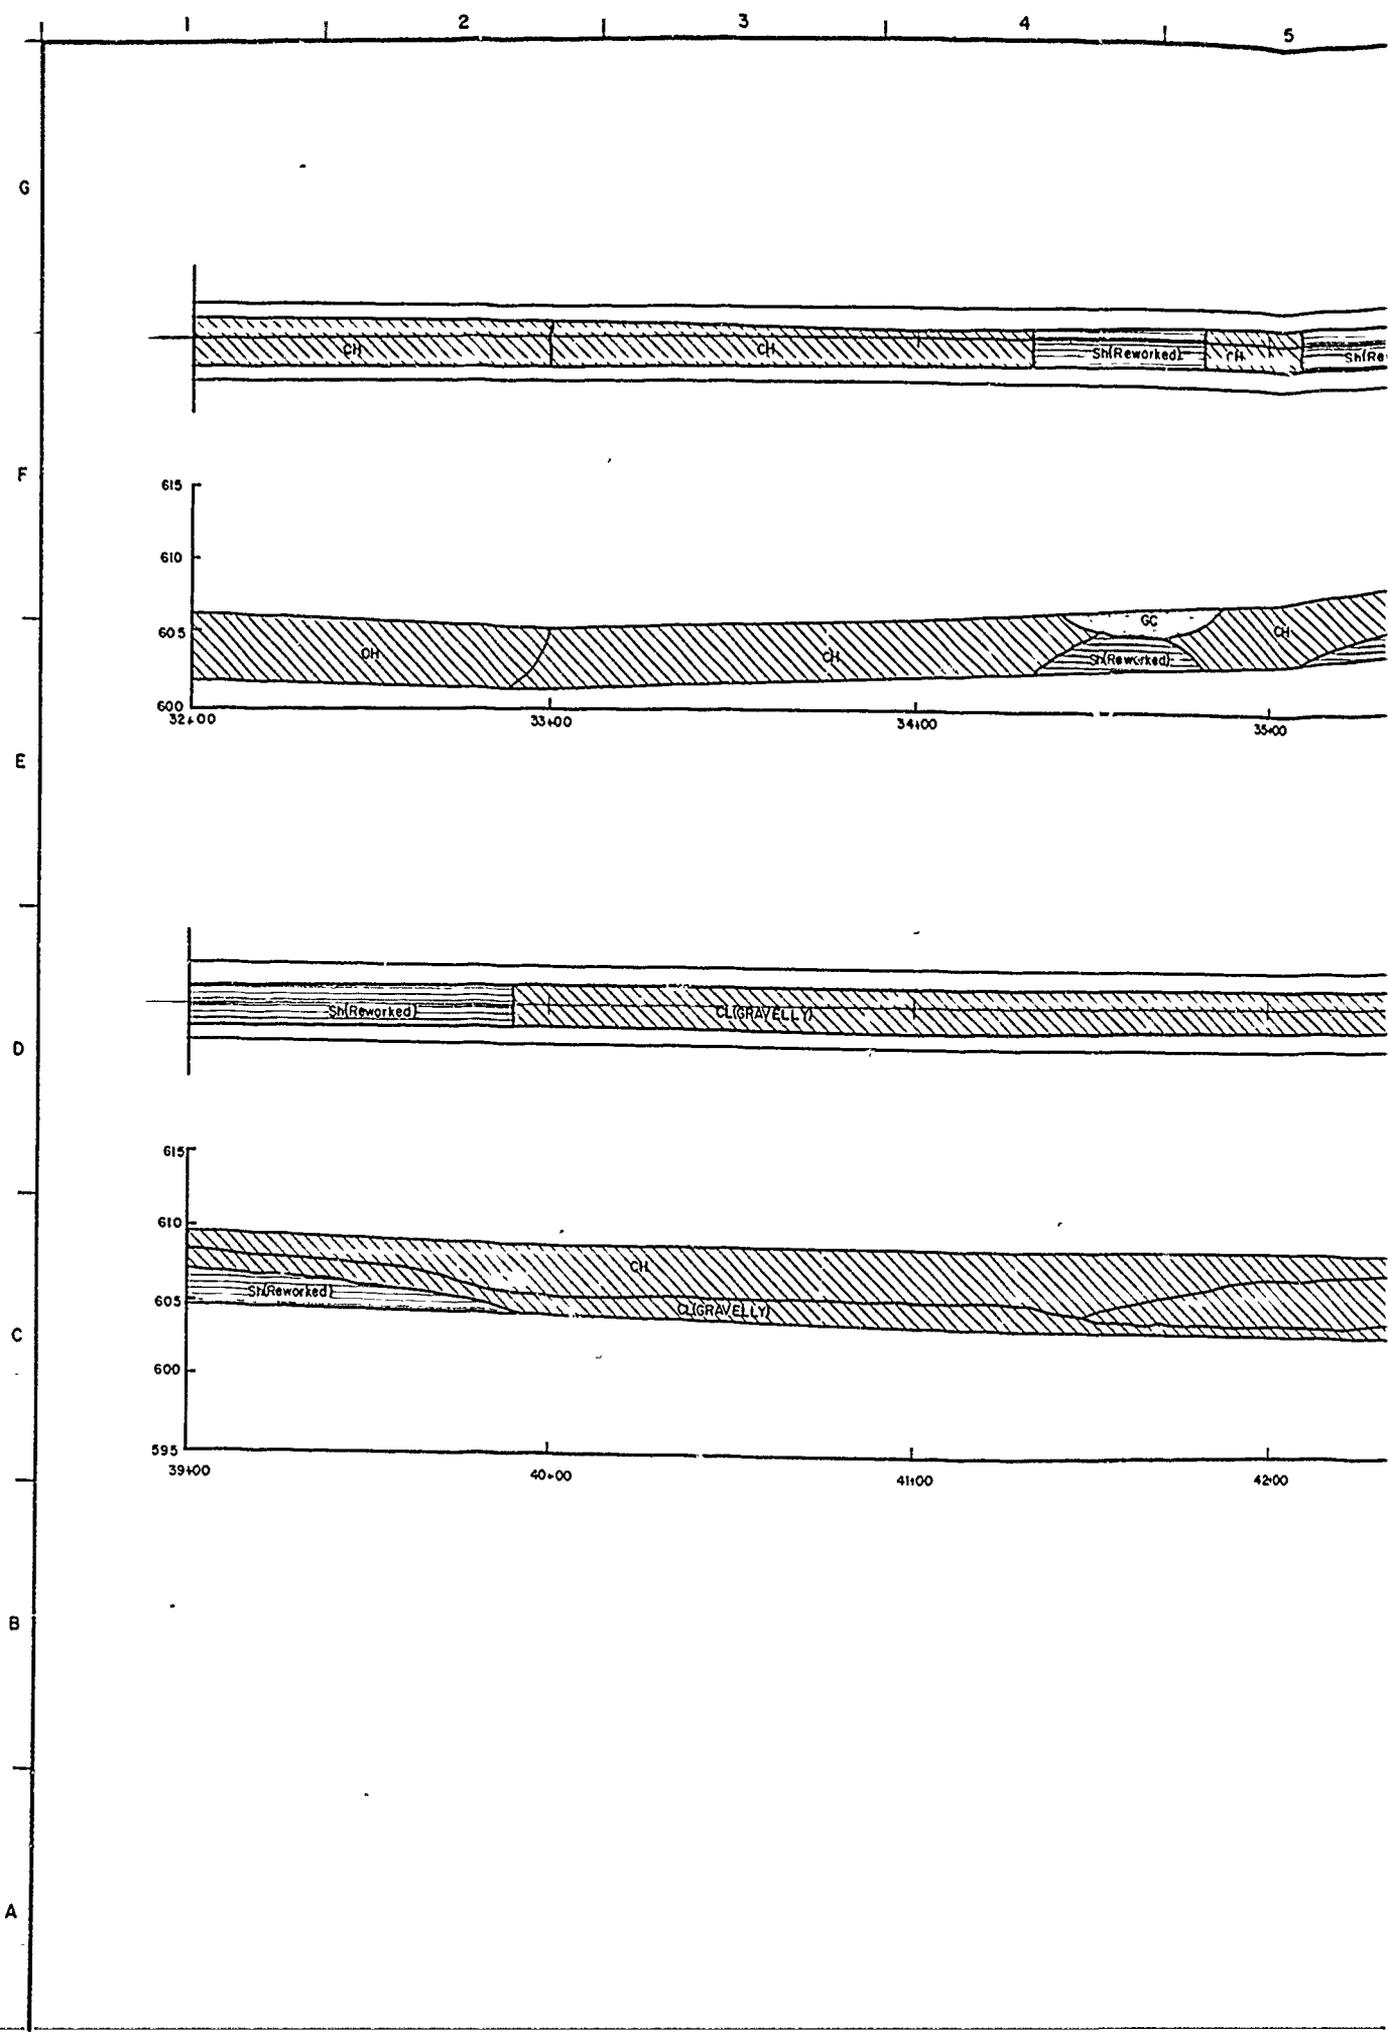

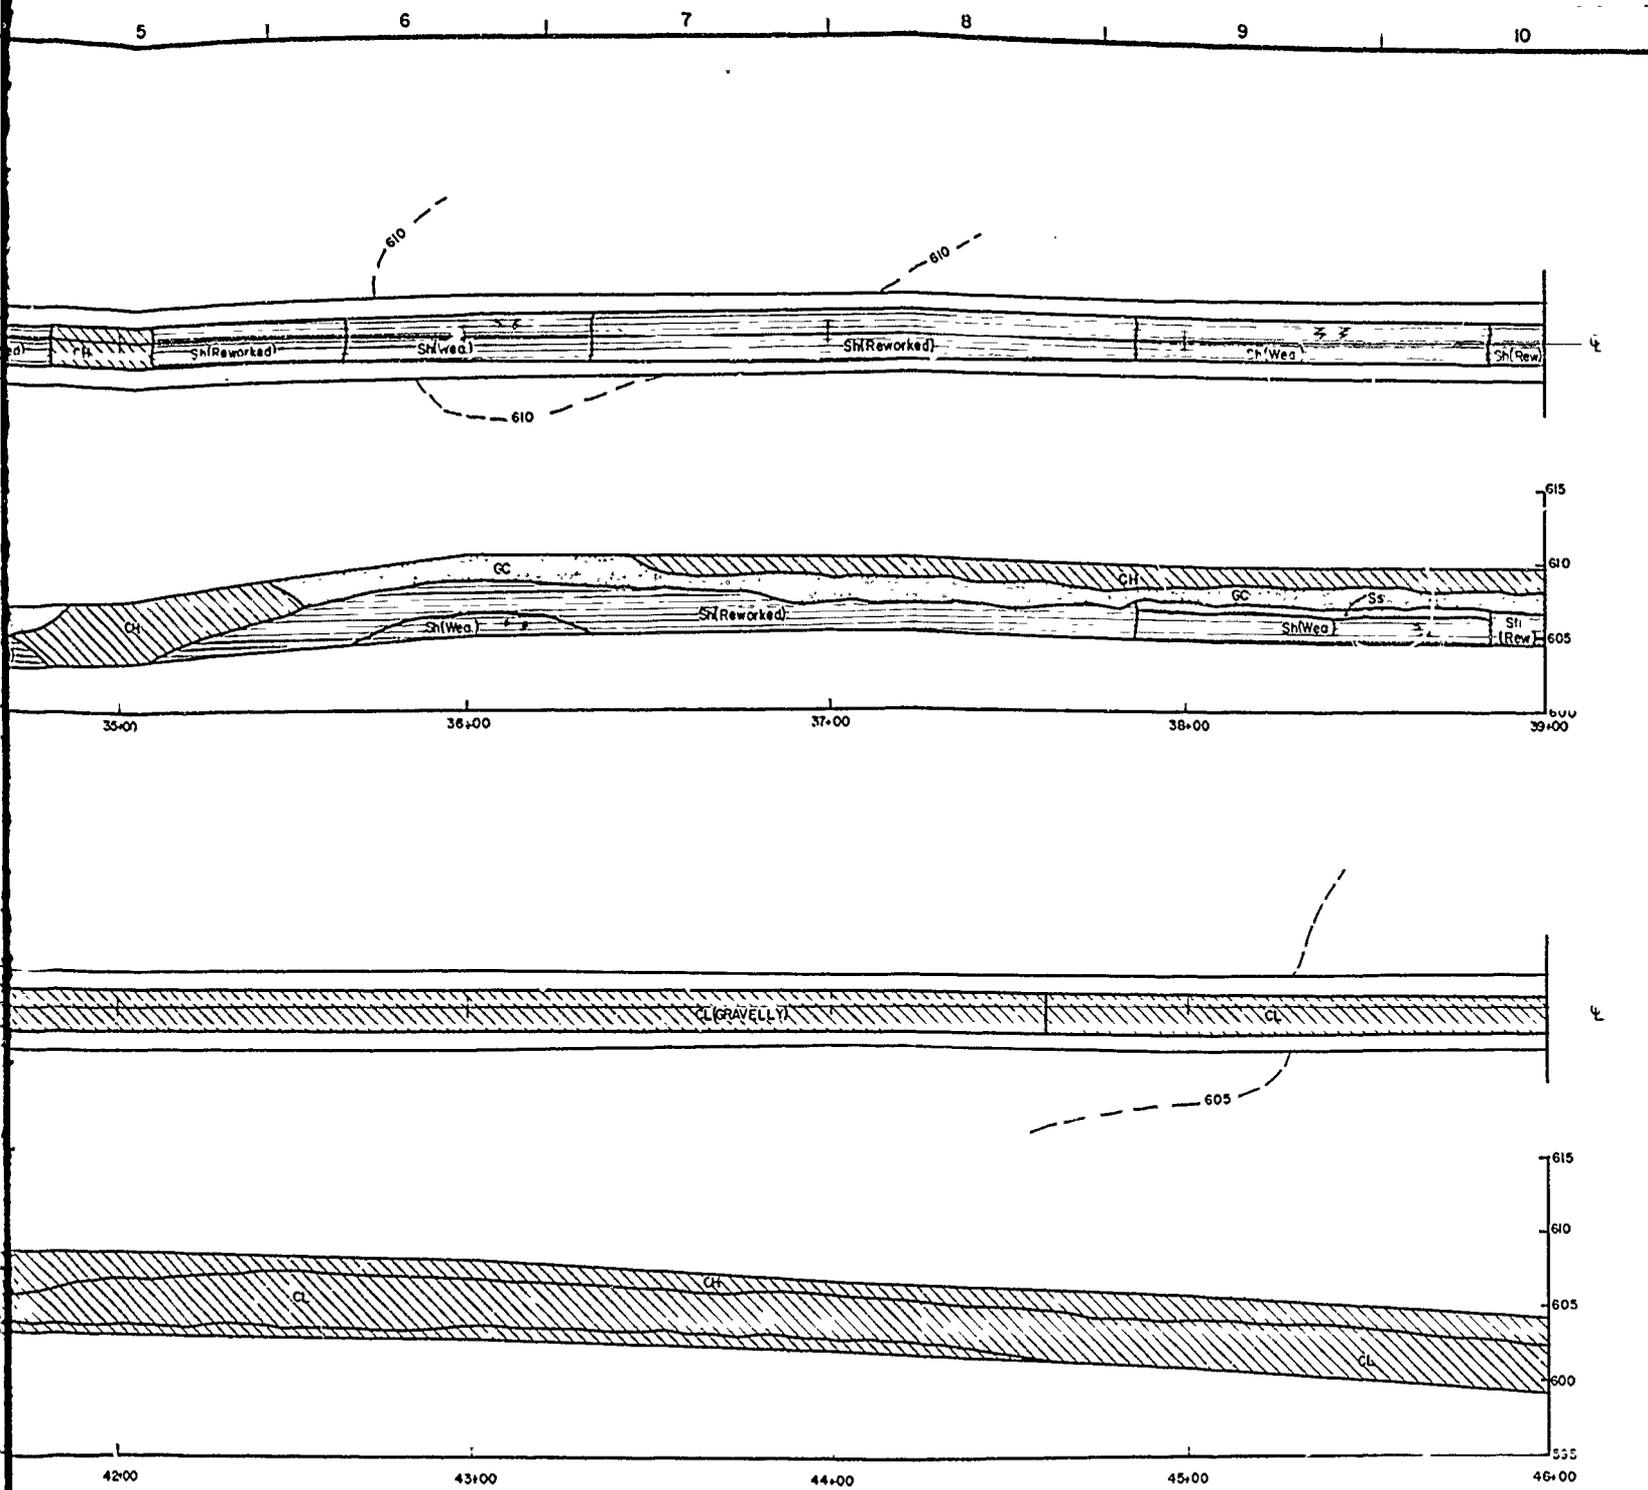



DESIGNED BY: H. BARNETT		RAY ROBERTS LAKE ELM FORK, TRINITY RIVER, TEXAS	
DRAWN BY: C. KIRBY		FOUNDATION REPORT INSPECTION TRENCH AS-BUILT PLAN AND PROFILE STA. 32+00 TO 46+00	
REVIEWED BY: R. BEHM		U.S. ARMY ENGINEER DISTRICT, FORT WORTH CORPS OF ENGINEERS FORT WORTH, TEXAS	
SUBMITTED BY: ROBERT C. BEHM		SOL. NO.	DATED:
		CONTR. NO.	SECURE:

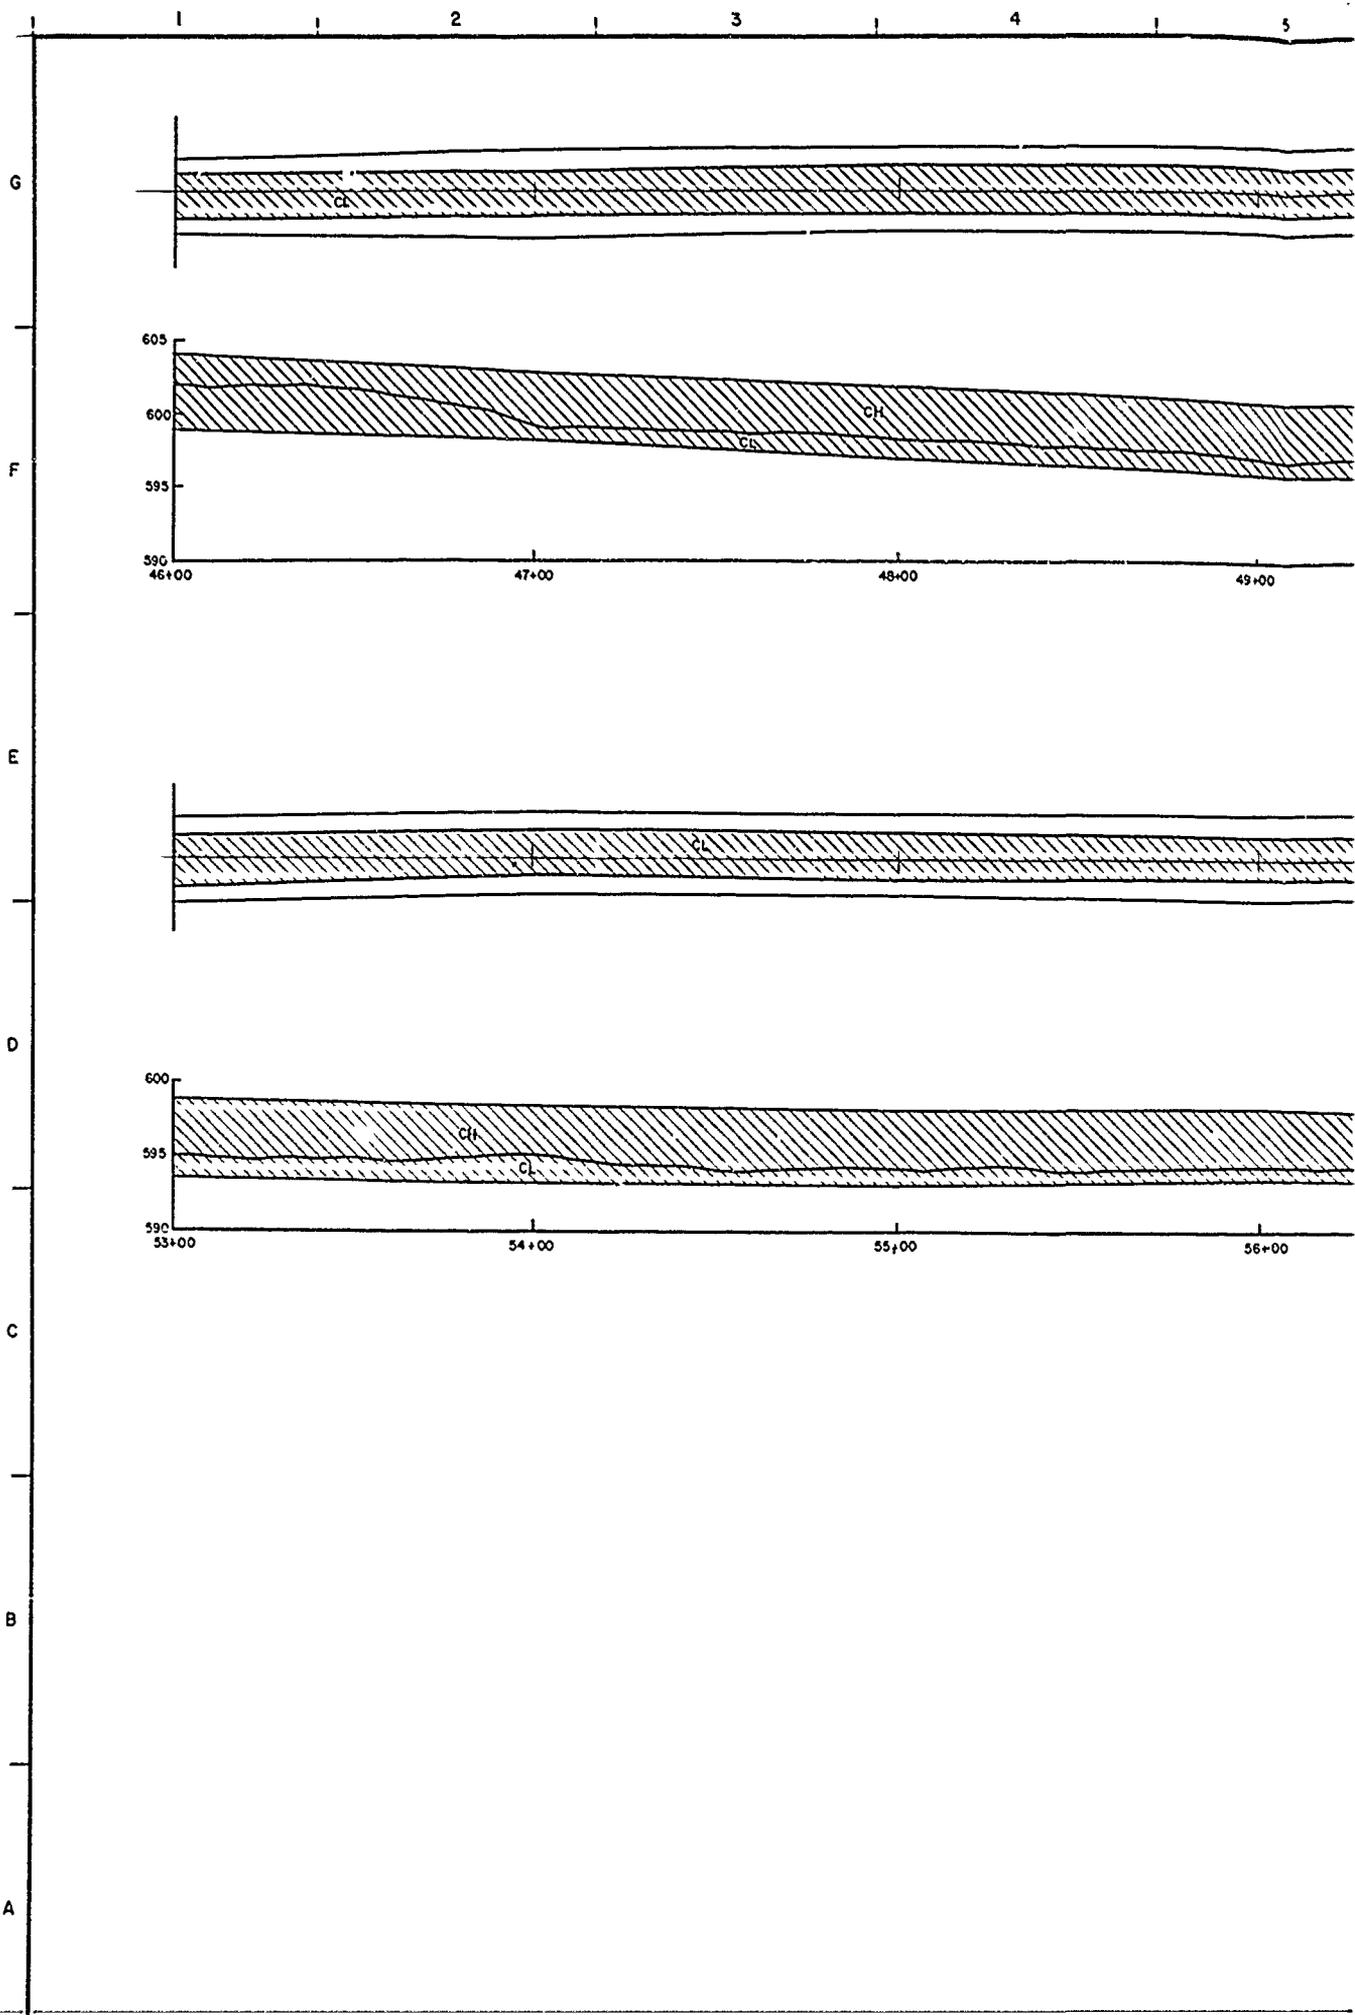

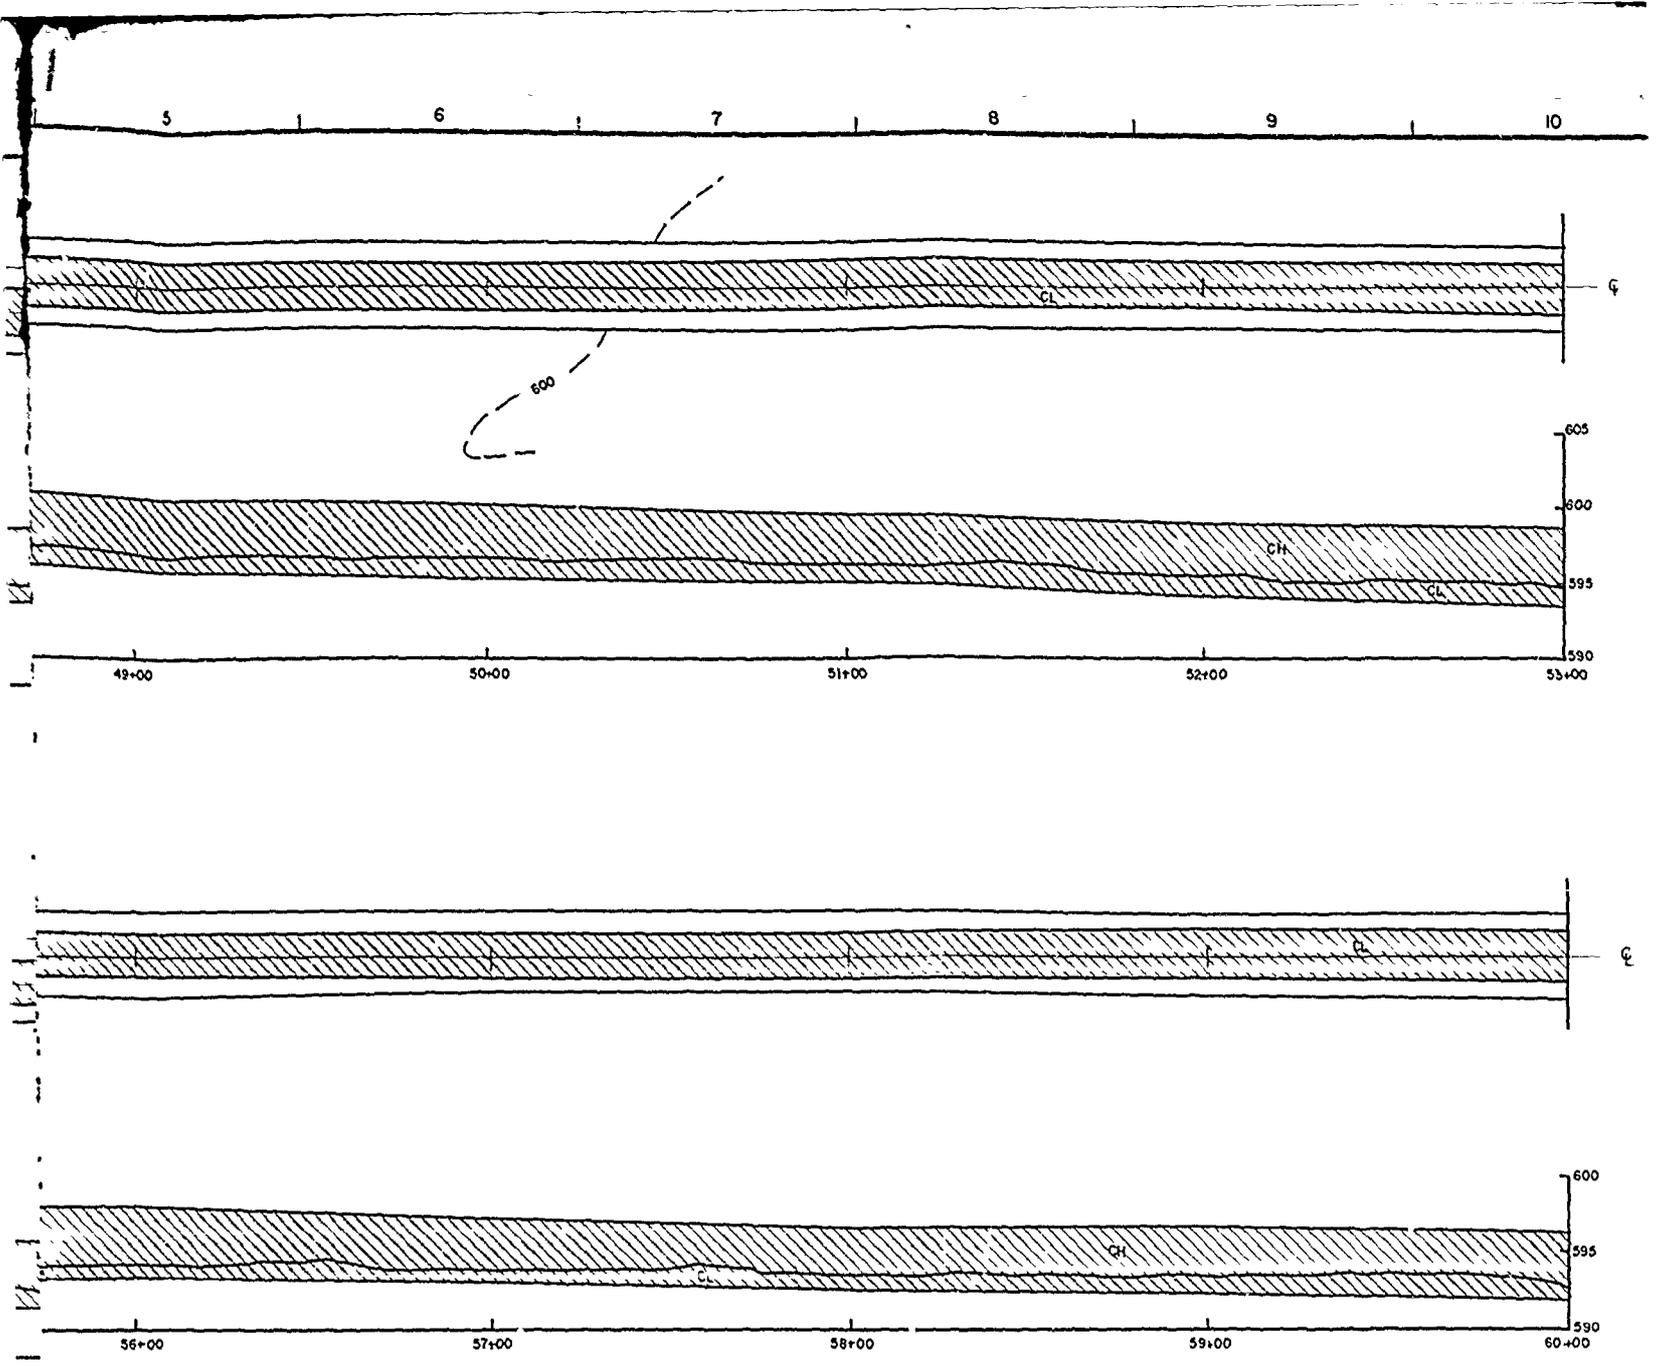

DESIGNED BY: H. BARNETT	RAY ROBERTS LAKE ELM FORK, TRINITY RIVER, TEXAS	
DRAWN BY: C. KIBBY	FOUNDATION REPORT INSPECTION TRENCH AS-BUILT PLAN AND PROFILE STA. 46+00 TO 60+00	
REVIEWED BY: R. BEHM		
SUBMITTED BY: ROBERT C. BEHM	SOL. NO. CONTR. NO.	DATED: SEQUENCE NO.

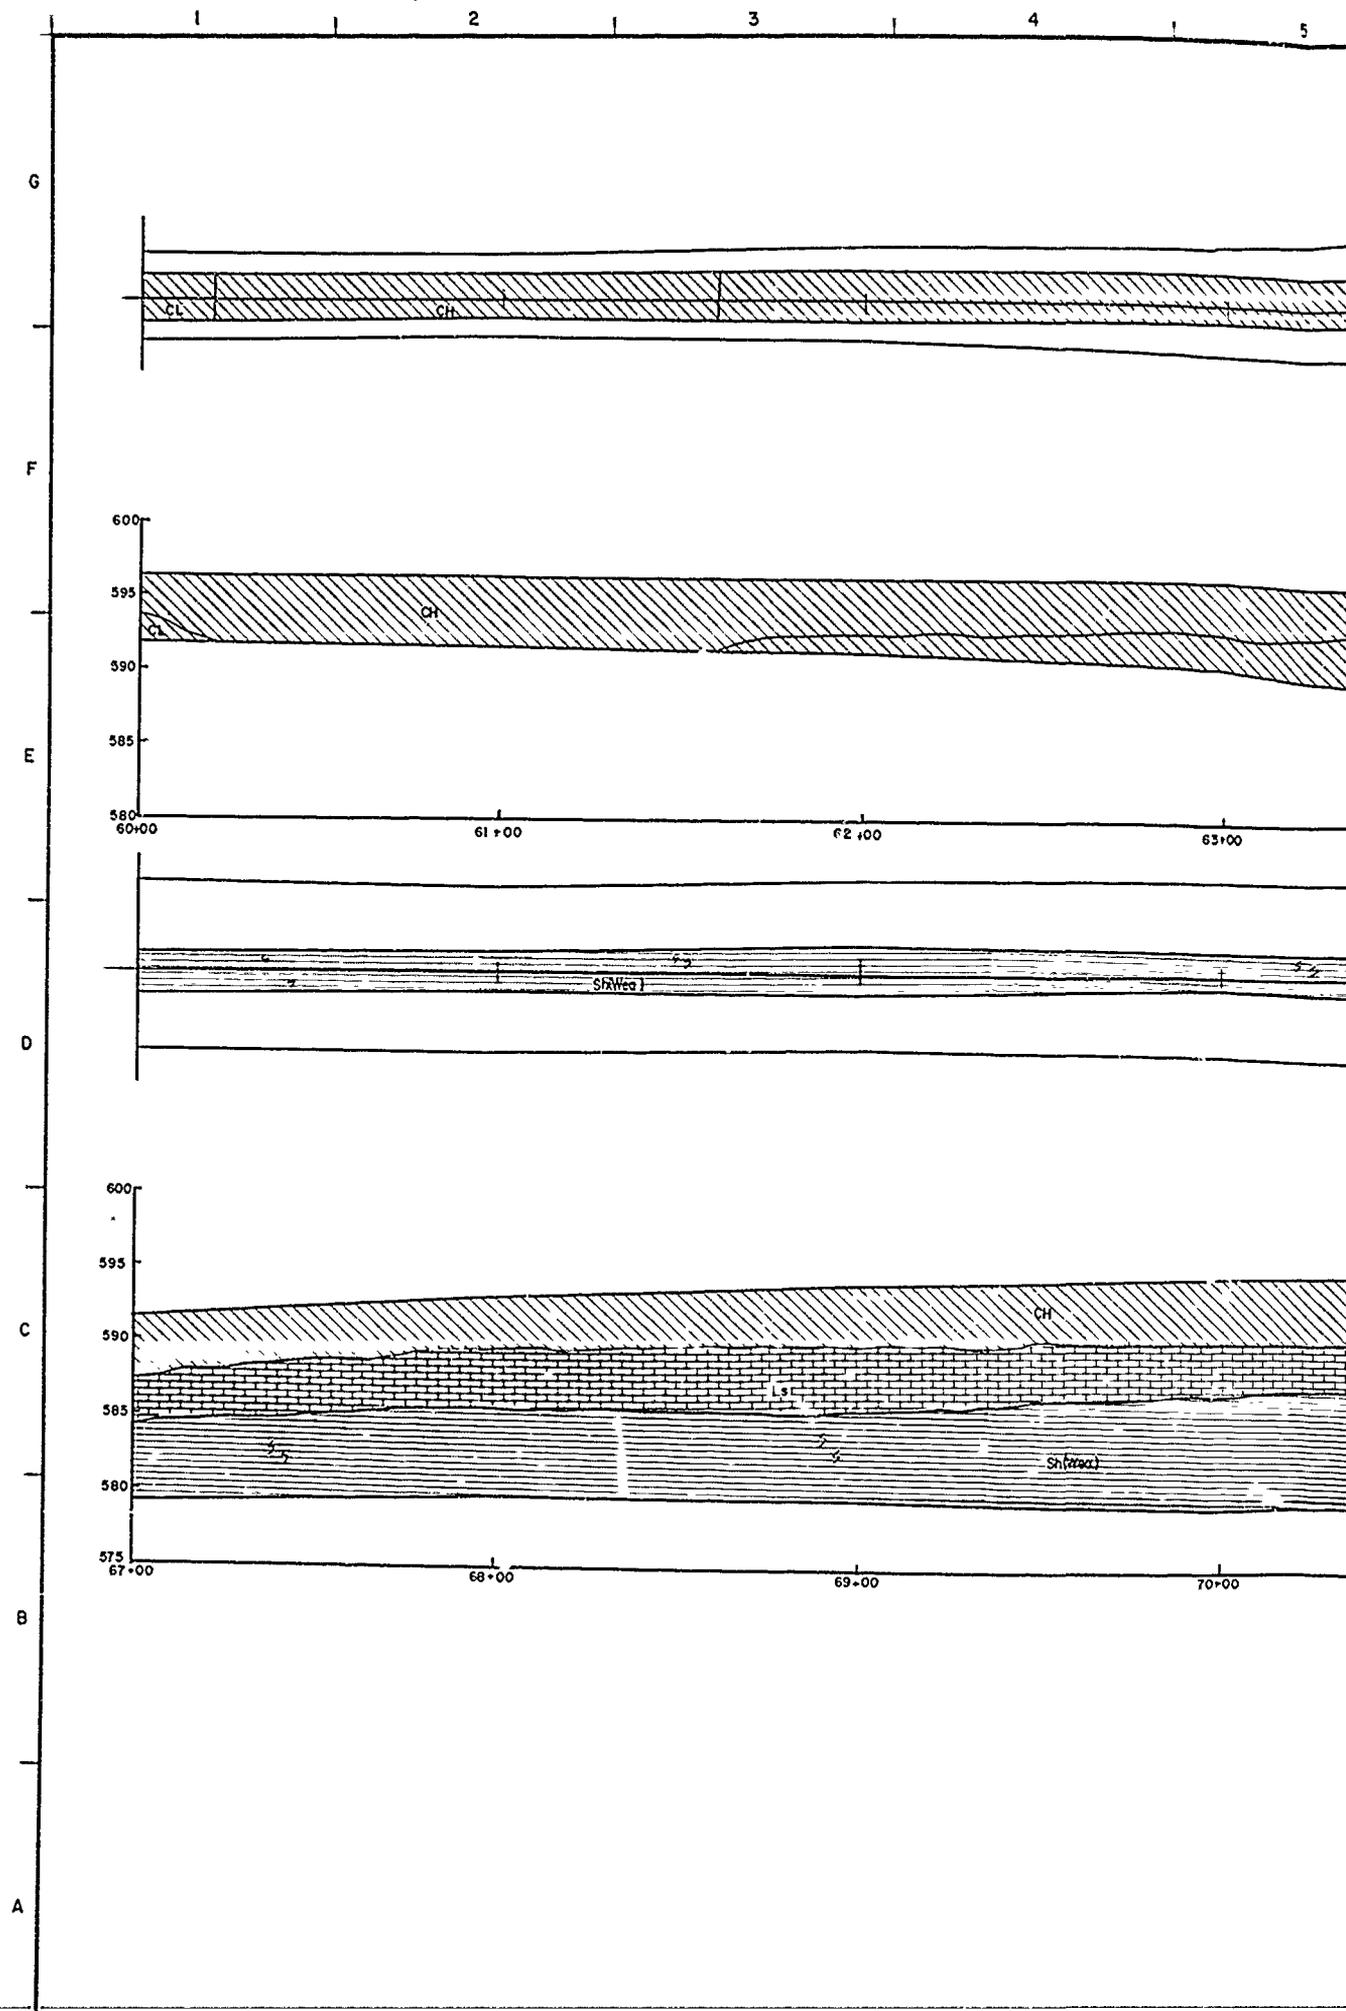


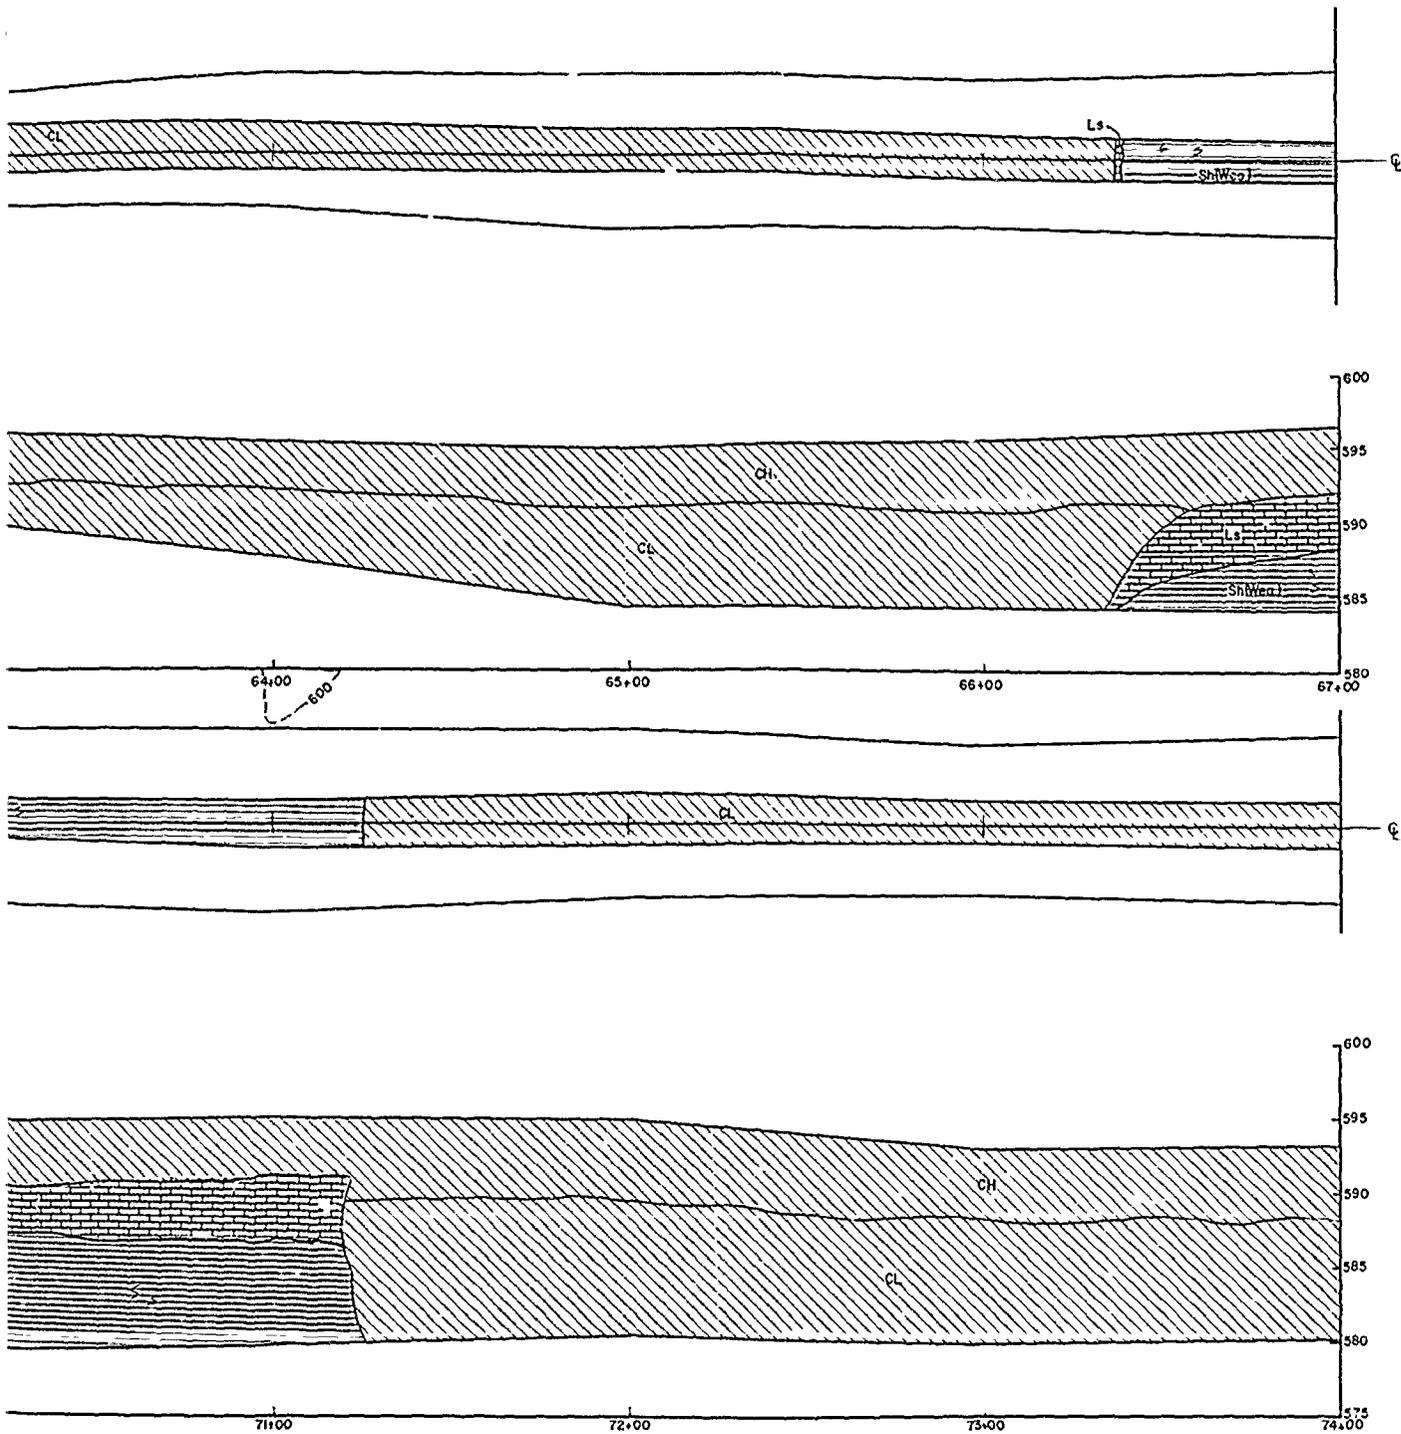


DESIGNED BY: H. BARNETT		RAY ROBERTS LAKE ELM FORK, TRINITY RIVER, TEXAS	
DRAWN BY: C. KIRBY		FOUNDATION REPORT	
REVIEWED BY: R. BEHM		INSPECTION TRENCH AS-BUILT PLAN AND PROFILE STA. 60+00 TO 74+00	
SUBMITTED BY: ROBERT C. BEHM ENGINEER		SOL. NO.	DATED:
		CONTR. NO.	SEQUENCE NO.
		DRAWING NUMBER	SHEET NO. OF
			54

TO ACCOMPANY FOUNDATION REPORT

G

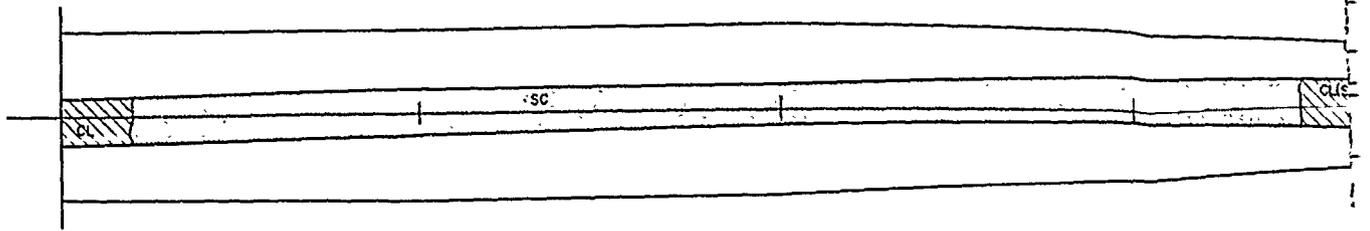


F

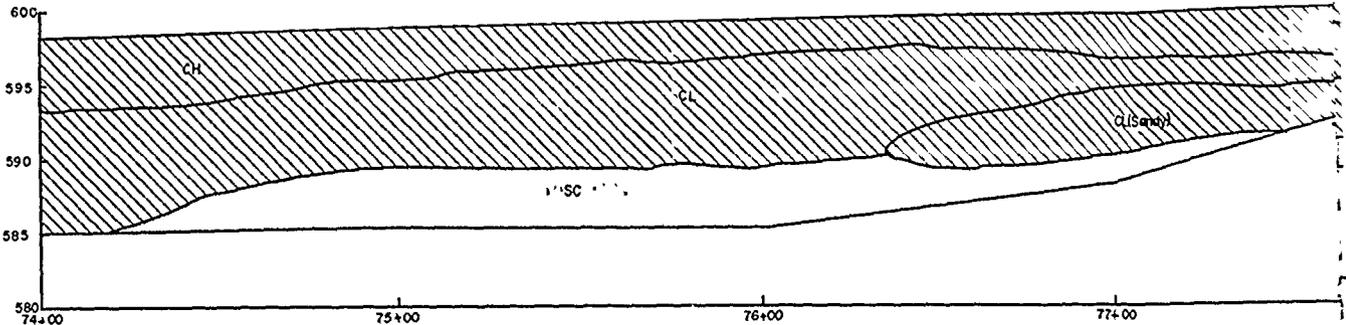


E

D

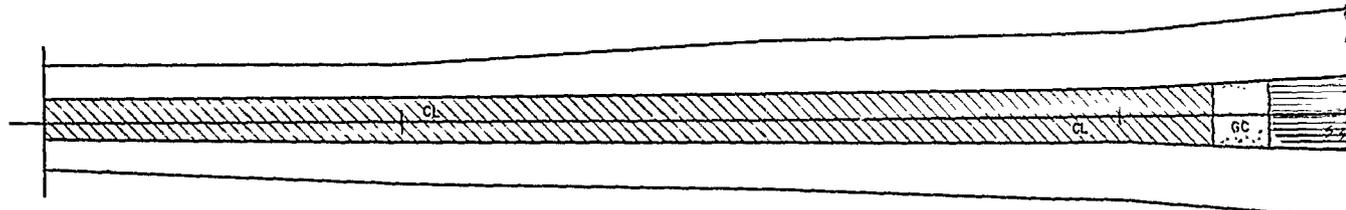


C

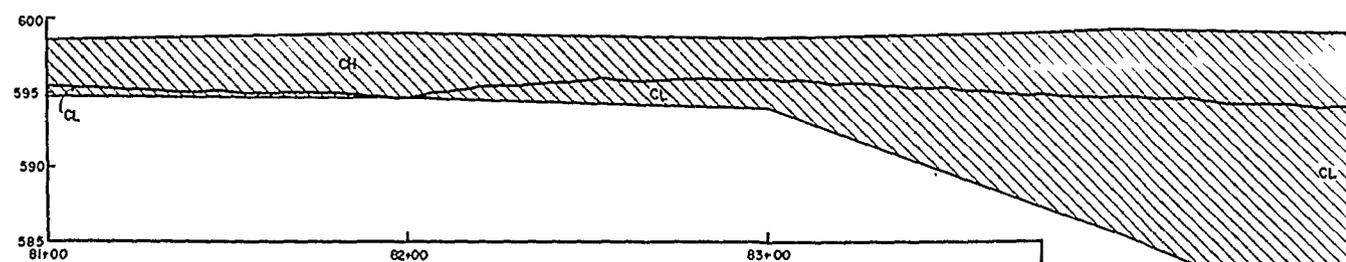

B

A




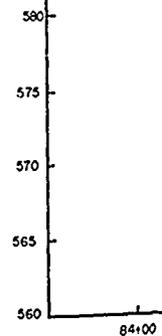


2

3

4

5

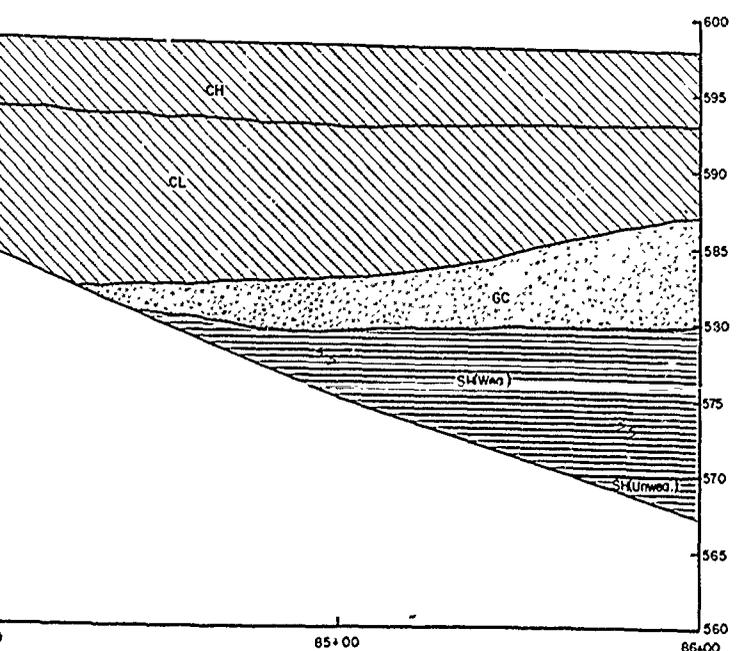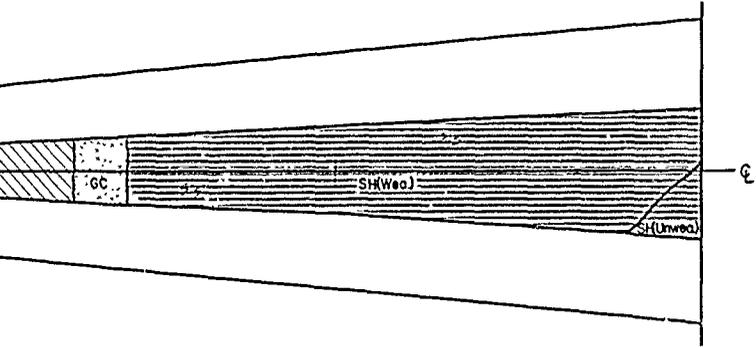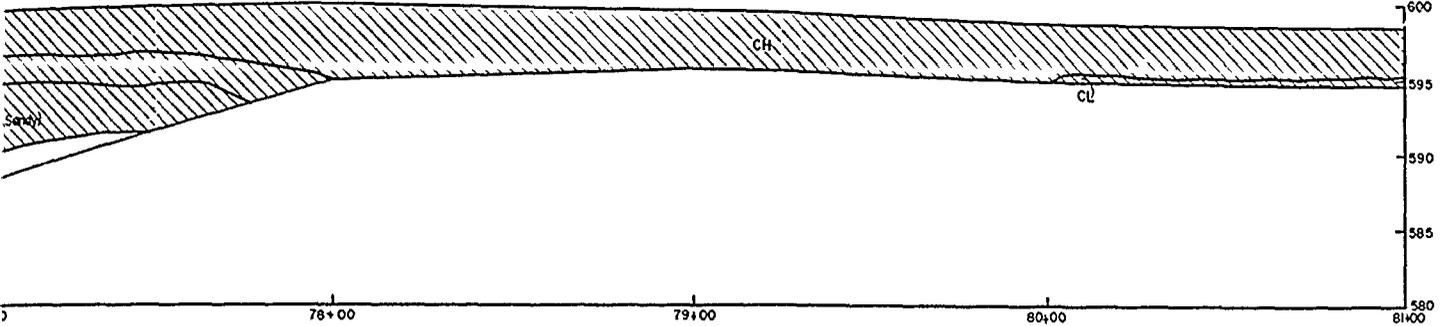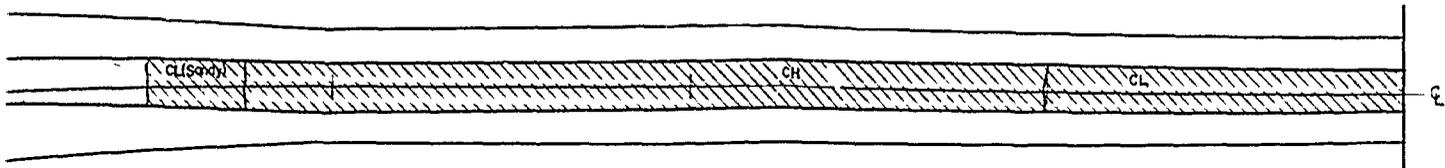

DESIGNED BY H. BARNETT		RAY ROBERTS LAKE ELM FORK, TRINITY RIVER, TEXAS	
DRAWN BY C. KIRBY		FOUNDATION REPORT	
REVIEWED BY R. BEHM		INSPECTION TRENCH	
SUBMITTED BY ROBERT C. BEHM		AS-BUILT PLAN AND PROFILE	
ENGINEER		STA 74+00 TO 86+00	
CONTR. NO.		SOL. NO.	
DRAWING NUMBER		DATED:	
SHEET NO.		SEQUENCE NO.	
OF		55	

TO ACCOMPANY FOUNDATION REPORT

G
F
E
D
C
B

5 6 7 8

G

F



E

D


C

B

A

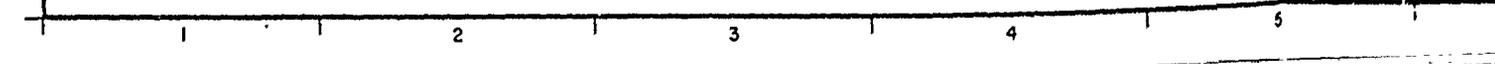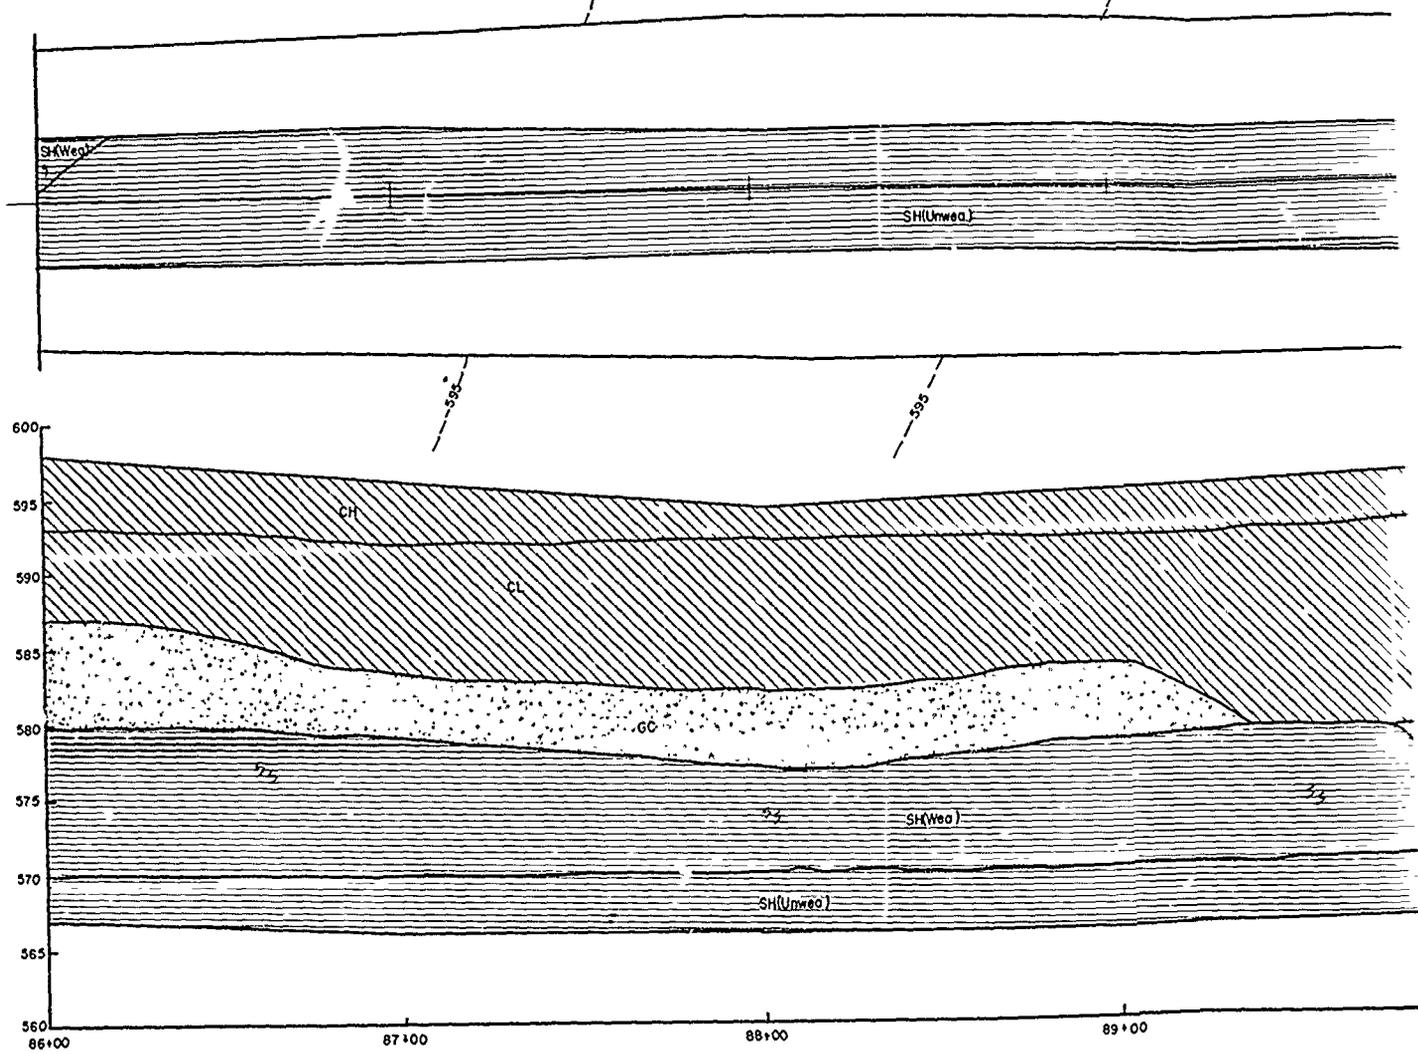

G
F
E
D
C
B

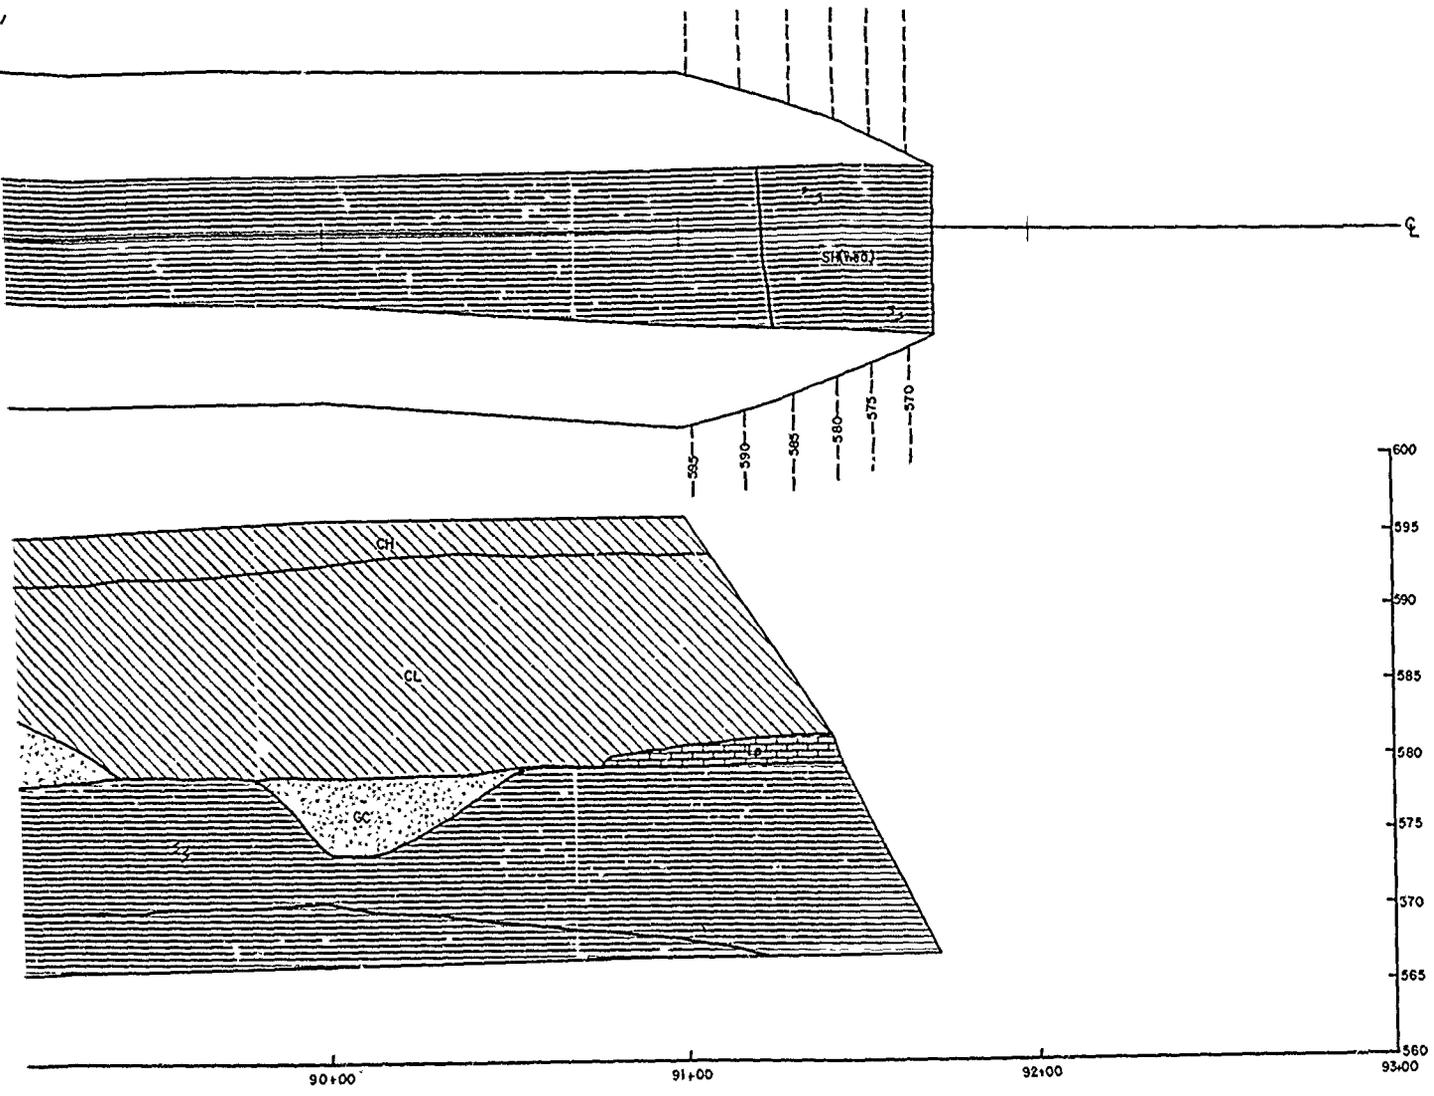


DESIGNED BY: H. RAPPETTI		DRAWN BY: C. KIRBY		REVIEWED BY: R. BEHM	
SUBMITTED BY: ROBERT C. BEHM		CONTR. NO.		DATED:	
ENGINEER:		DRAWING NUMBER		SHEET NO. OF	
				56	



U.S. ARMY ENGINEER DISTRICT, FORT WORTH
 CORPS OF ENGINEERS
 FORT WORTH, TEXAS

RAY ROBERTS LAKE
 ELM FOG, TRINITY RIVER, TEXAS
 FOUNDATION REPORT
 INSPECTION TRENCH
 AS-BUILT PLAN AND PROFILE
 STA. 86+00 TO 93+00

5 6 7 8


TO ACCOMPANY FOUNDATION REPORT




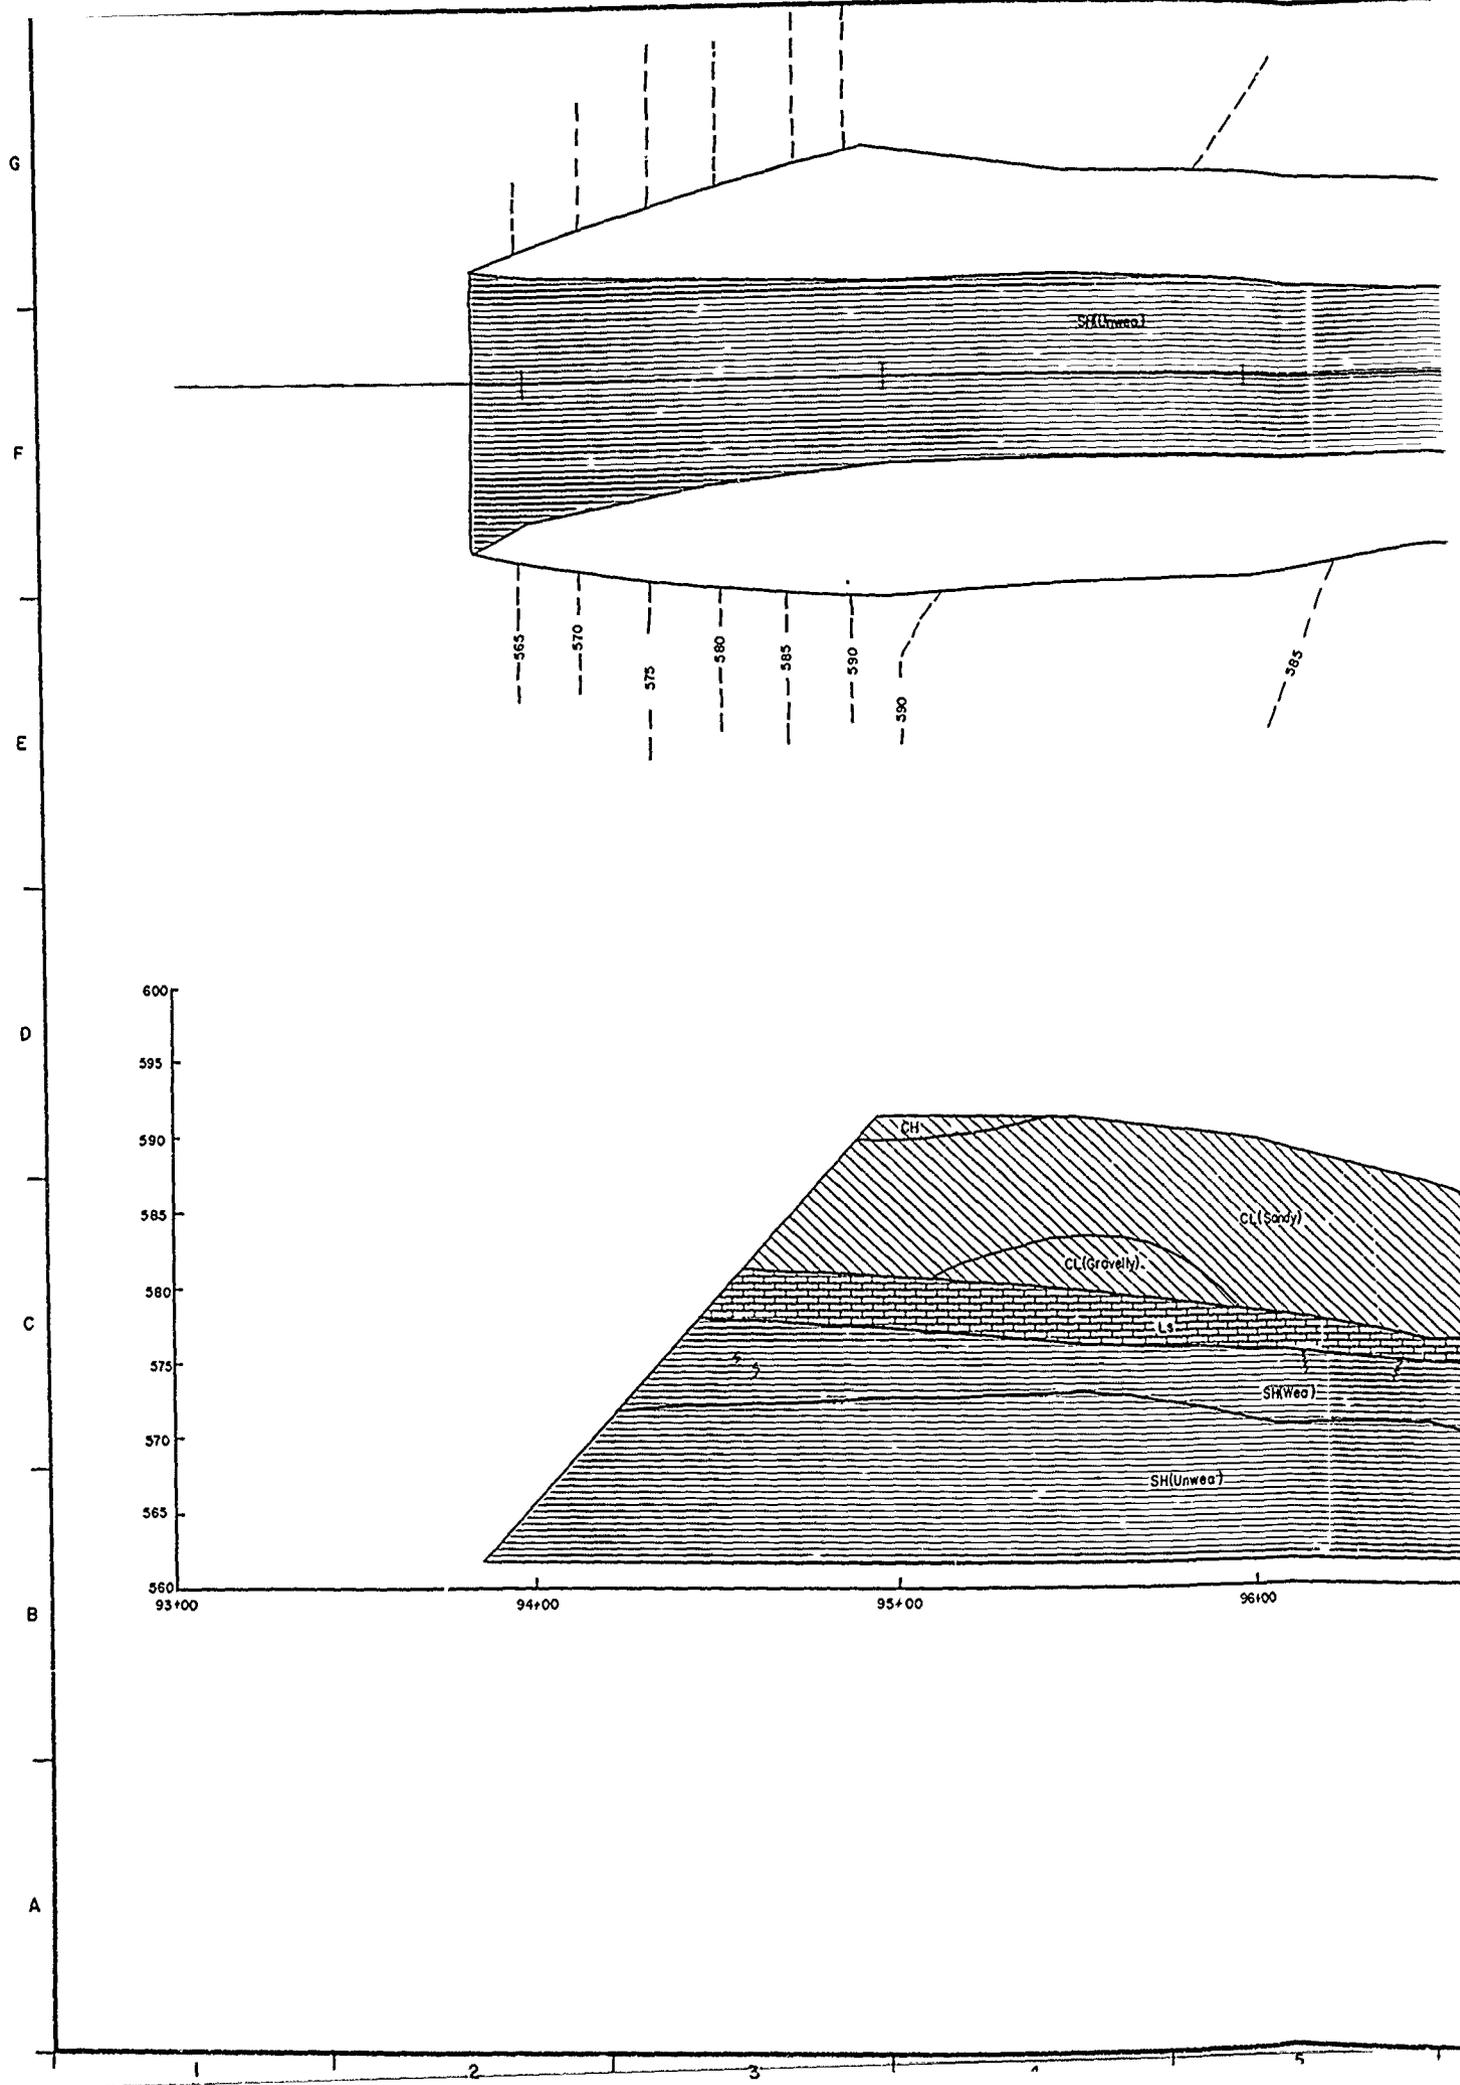


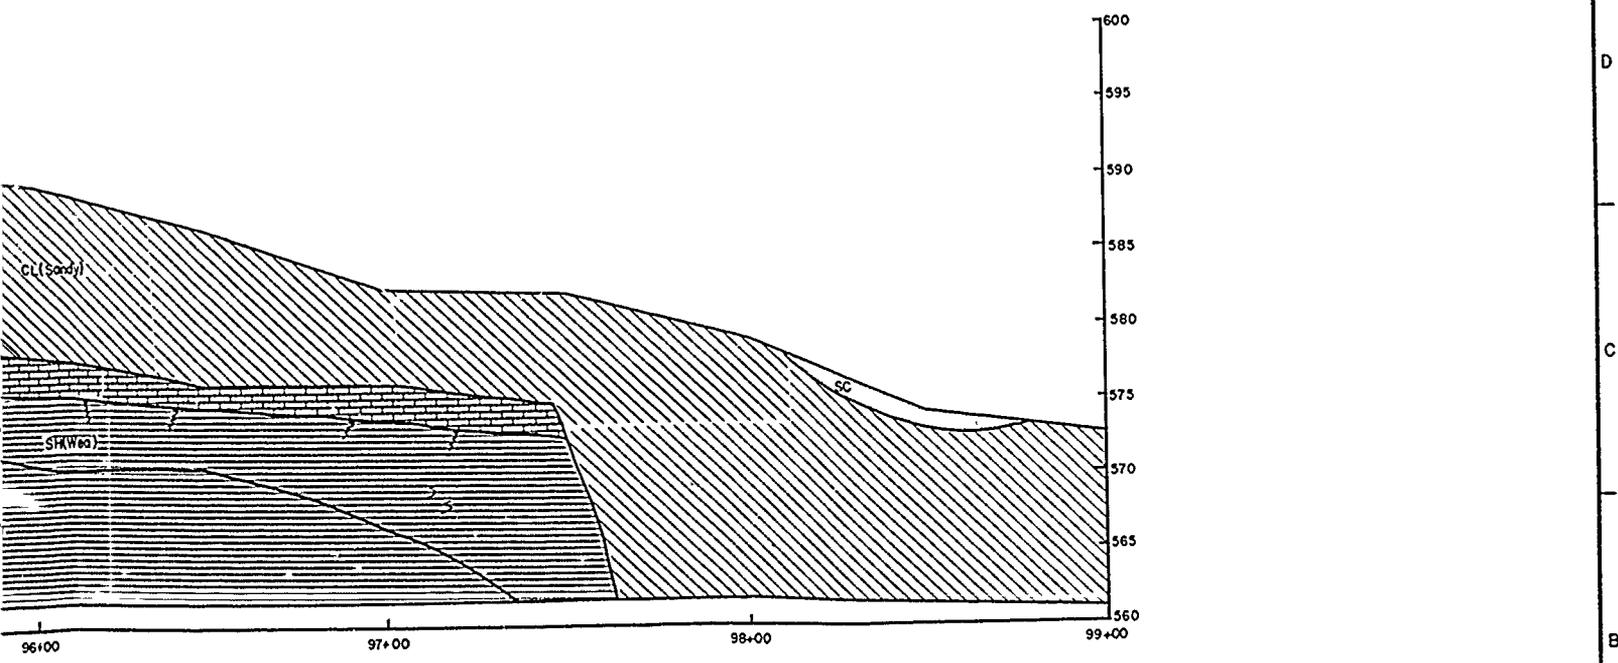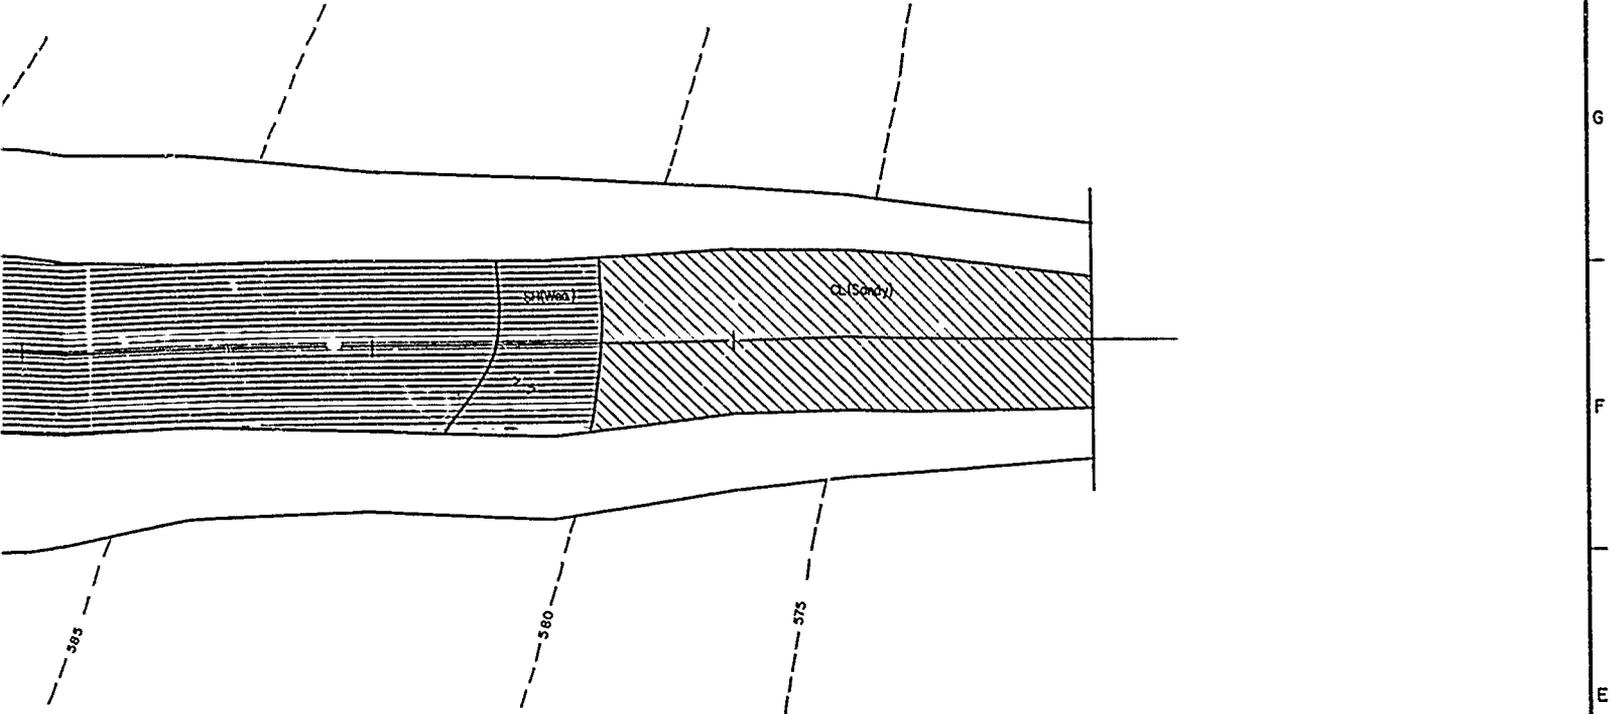


DESIGNED BY: H. BARNETT		RAY ROBERTS LAKE ELM FORK, TRINITY RIVER, TEXAS	
DRAWN BY: C. KIRBY		FOUNDATION REPORT INSPECTION TRENCH	
REVIEWED BY: R. BEHM		AS-BUILT PLAN AND PROFILE STA. 93 00 TO 99 00	
SUBMITTED BY: ROBERT C. BEHM		SOL. NO.	DATED:
ENGINEER:		CONTR. NO.	SEQUENCE NO. 57
		DRAWING NUMBER	SHEET NO. OF


TO ACCOMPANY FOUNDATION REPORT

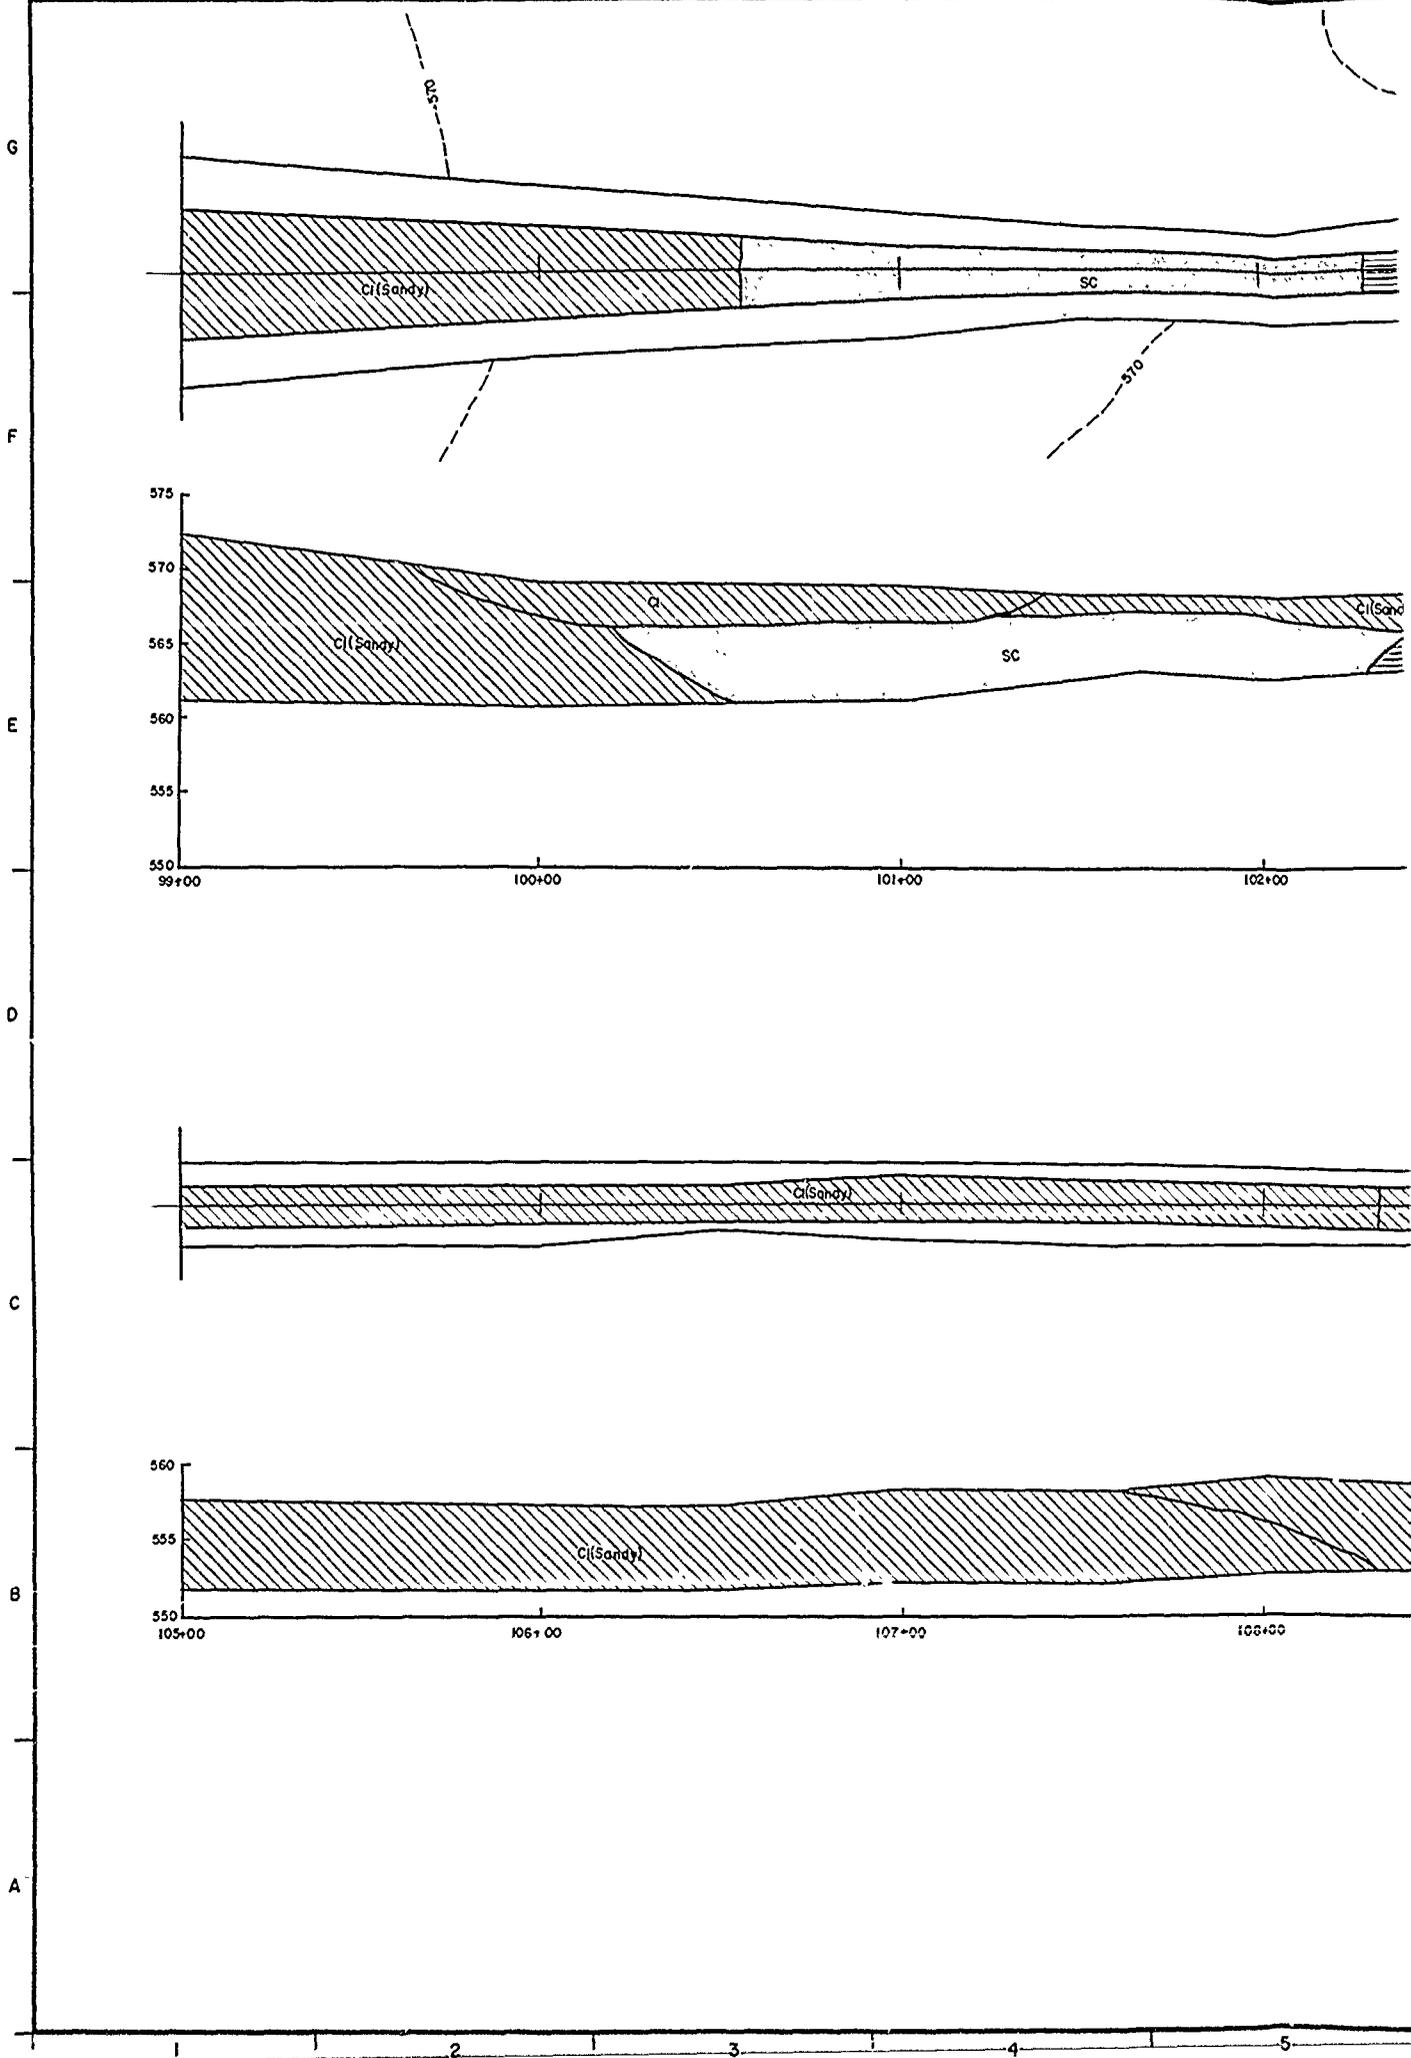

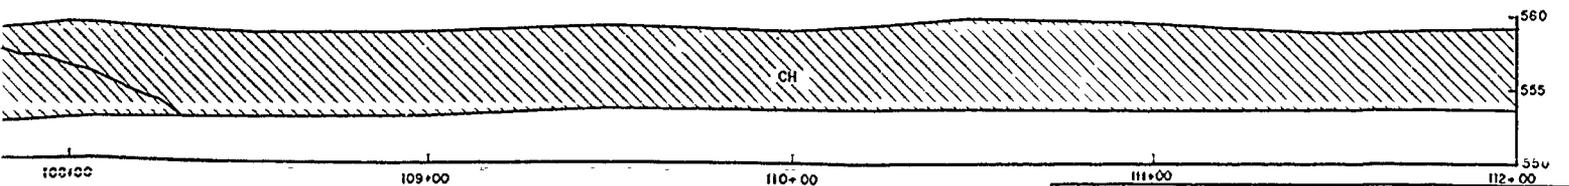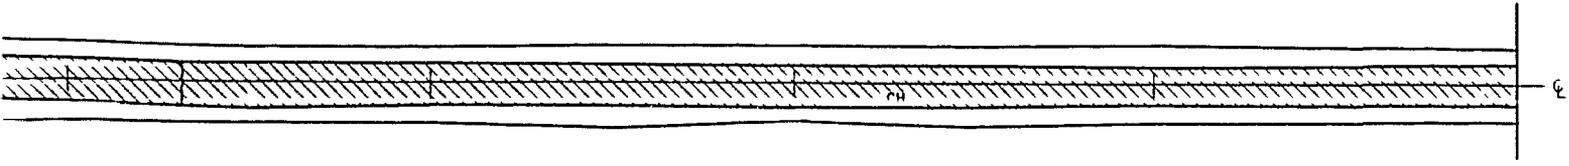
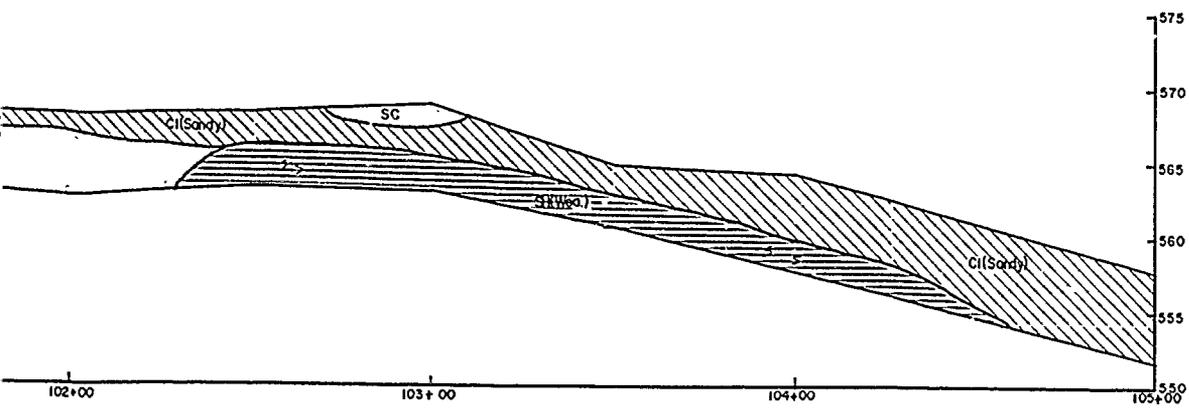
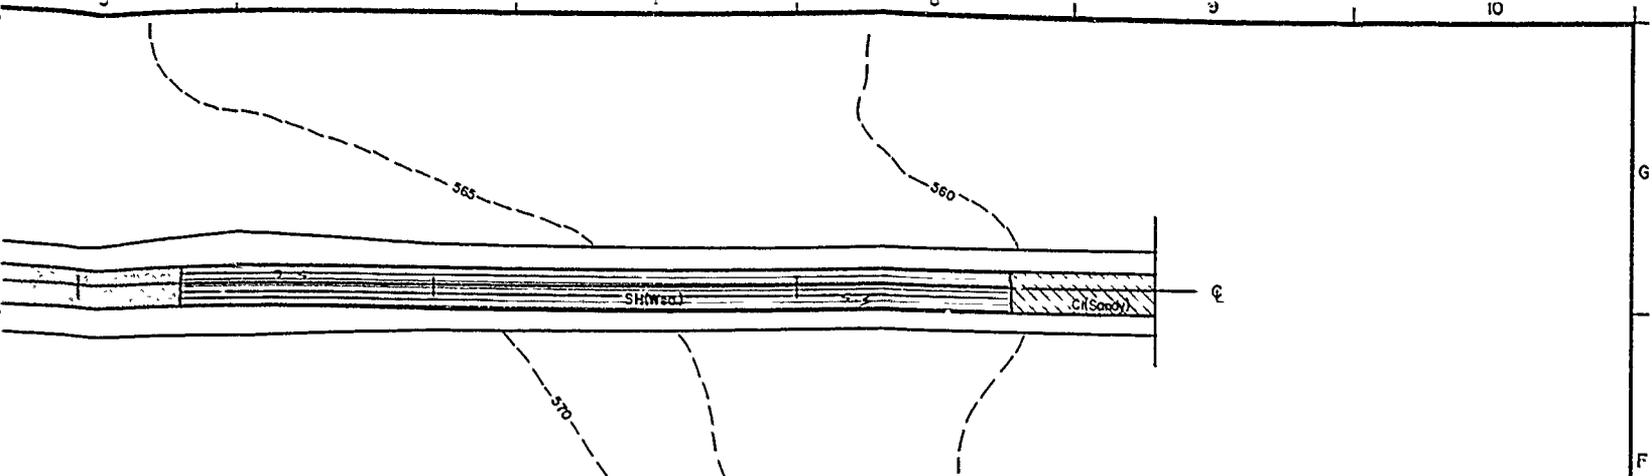


DESIGNED BY: <u>H. BARNETT</u>		RAY ROBERTS LAKE ELM FORK, TRINITY RIVER, TEXAS FOUNDATION REPORT INSPECTION TRENCH AS-BUILT PLAN AND PROFILE STA. 99+00 TO 112+00	
DRAWN BY: <u>C. KIRBY</u>			
REVIEWED BY: <u>R. BEHM</u>			
SUBMITTED BY: <u>ROBERT C. BEHM</u>			
CONTRACT NO.		SEQUENCE NO.	
DRAWING NUMBER		SHEET NO.	
DATE		DATE	
U.S. ARMY ENGINEER DISTRICT, FORT WORTH CORPS OF ENGINEERS FORT WORTH, TEX.		58	

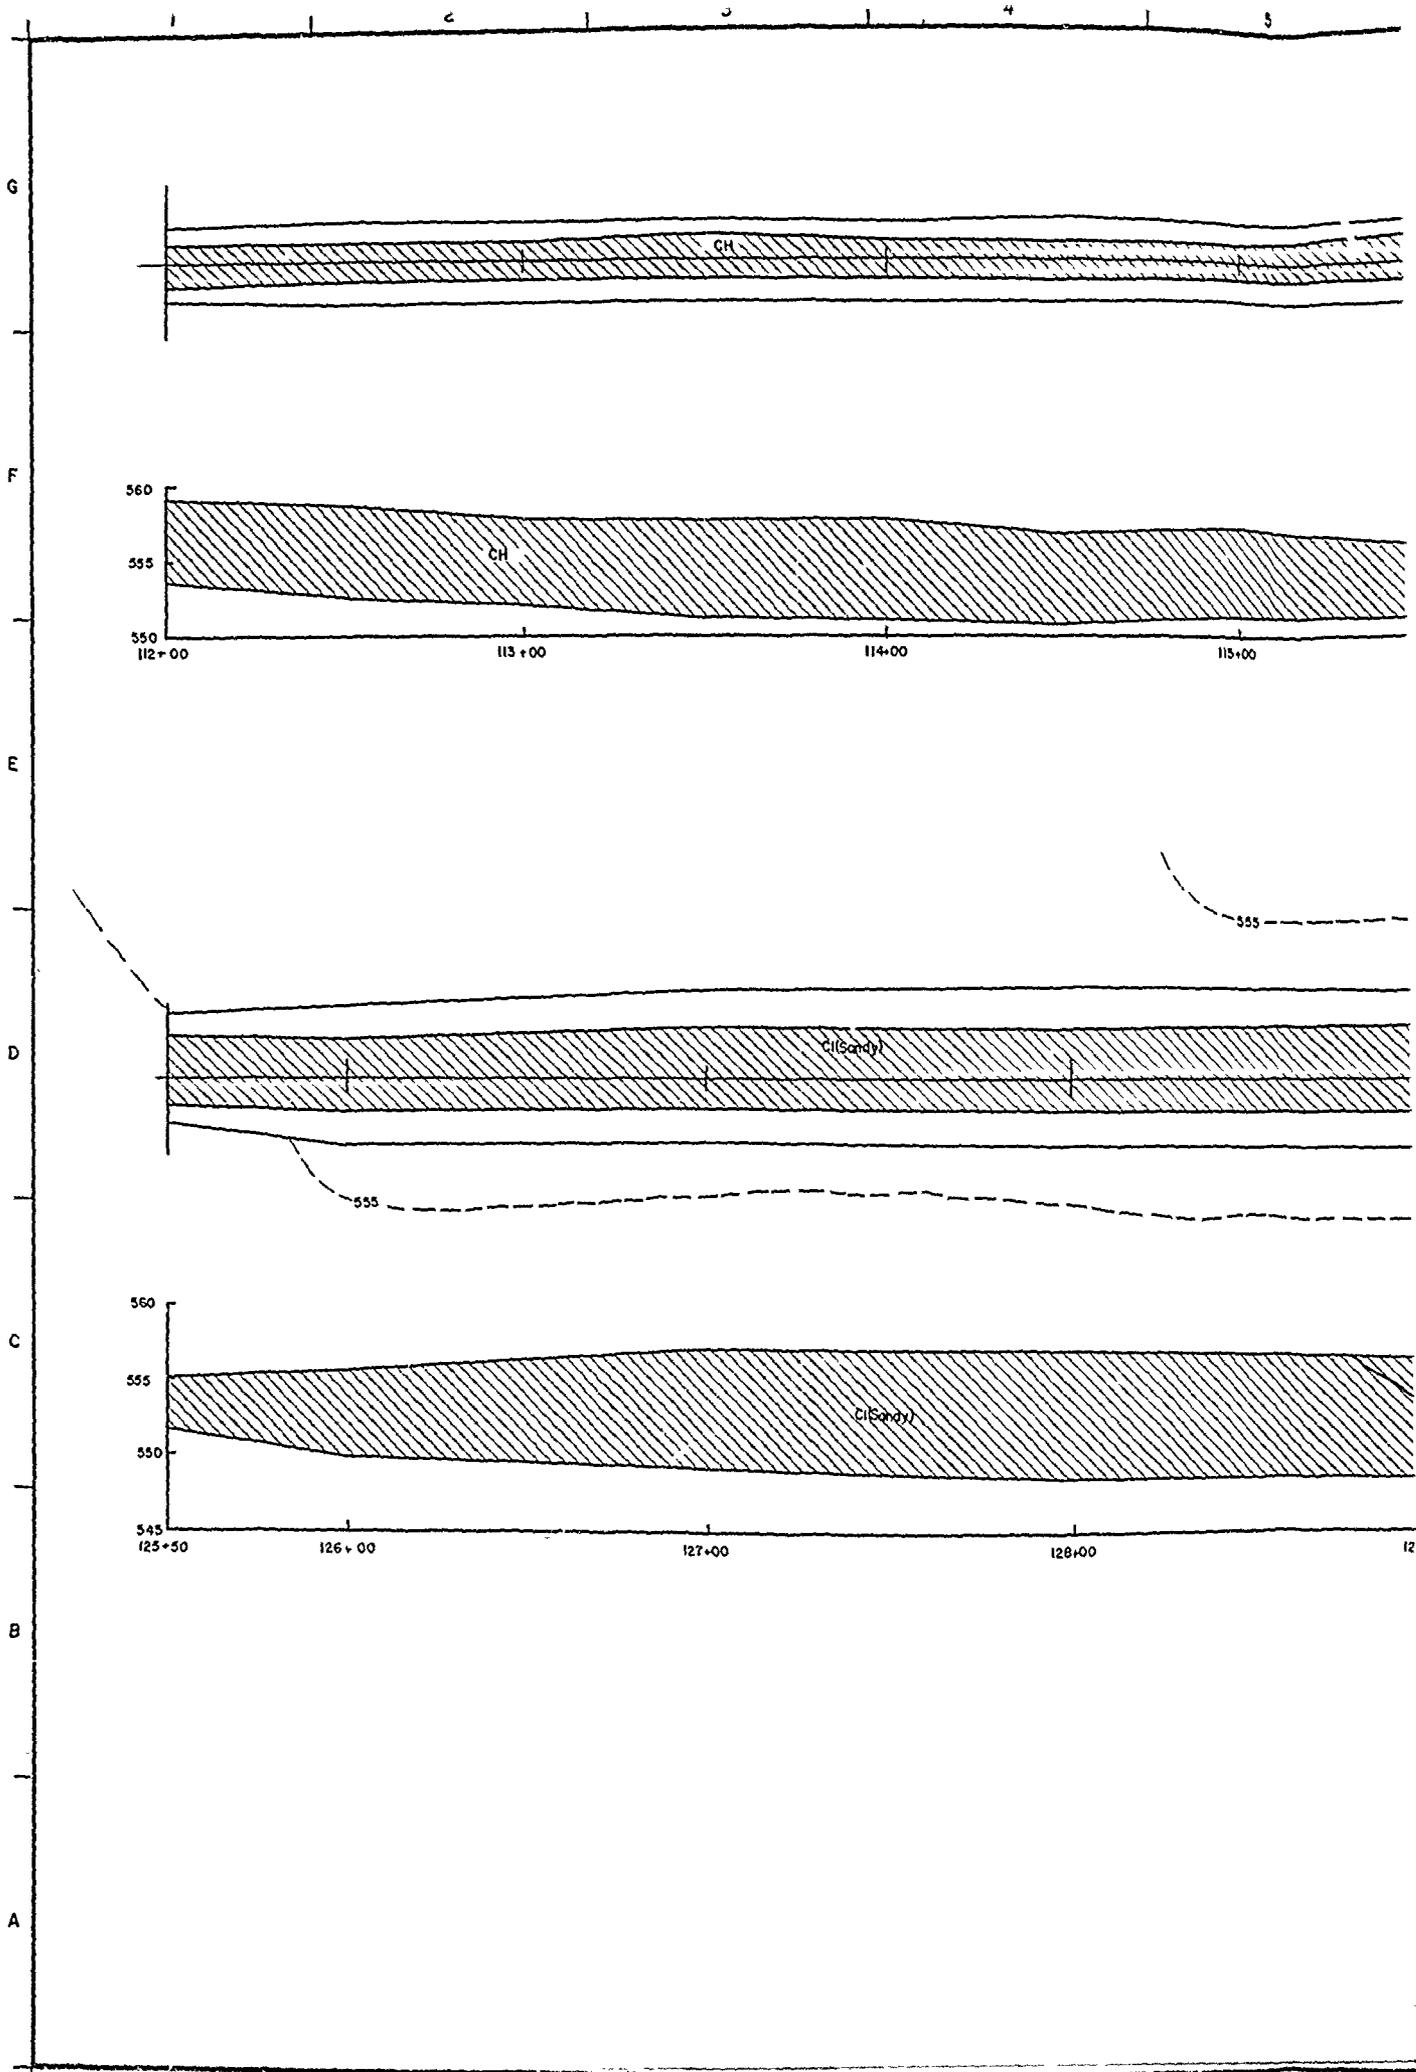

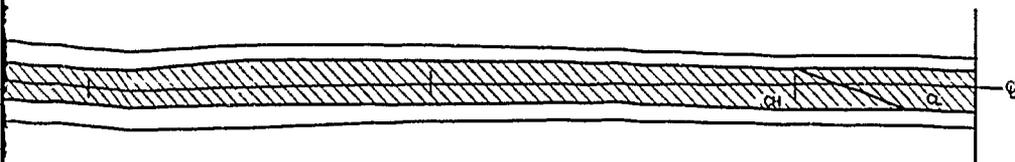


NOTE
 NO INSPECTION TRENCH WAS EXCAVATED BETWEEN
 STATIONS 117+50 AND 125+50

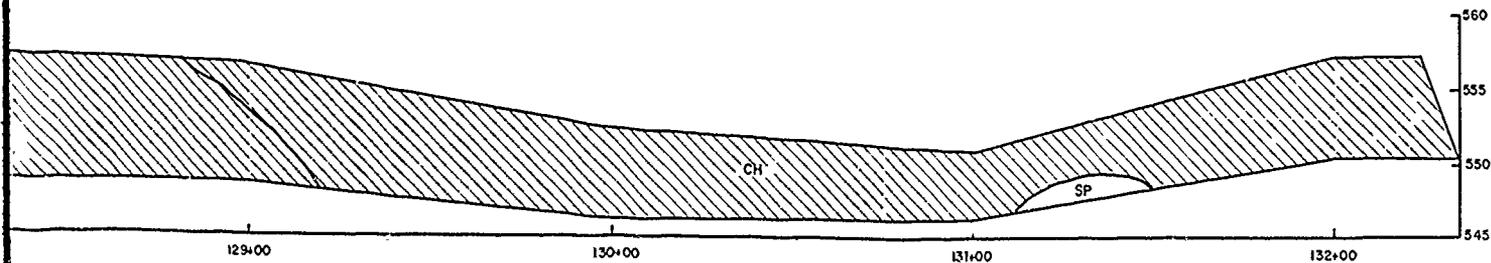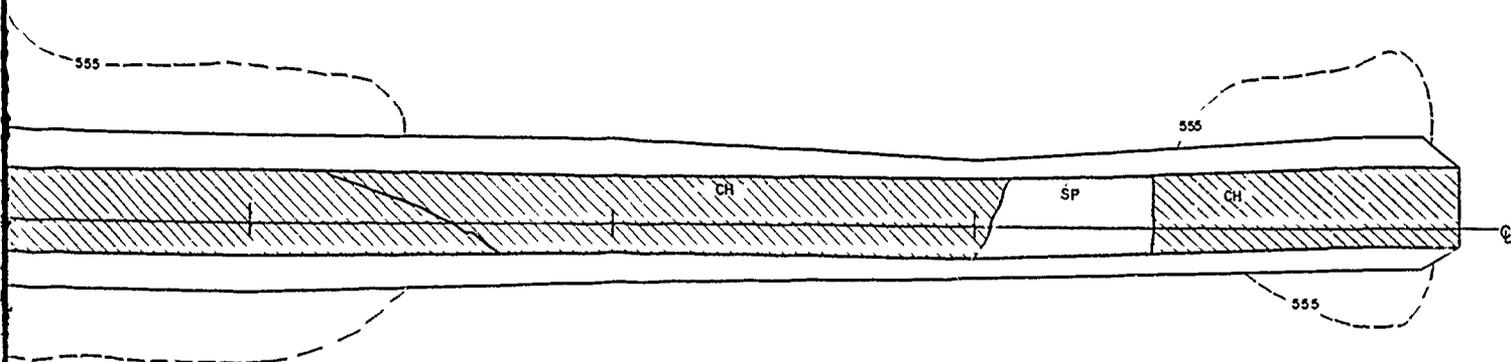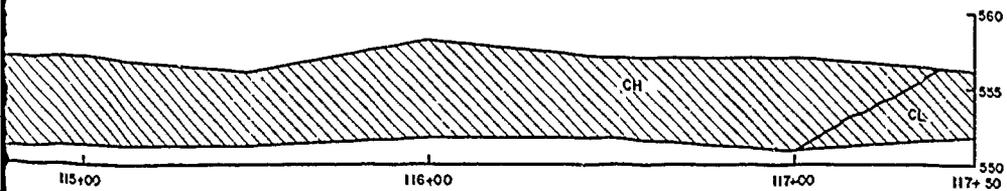


DESIGNED BY: H. BARNETT	RAY ROBERTS LAKE ELM FORK, TRINITY RIVER, TEXAS FOUNDATION REPORT INSPECTION TRENCH AS-BUILT PLAN AND PROFILE STA. 112+00 TO 117+50/125+50 TO 132+35	NO. NO.	DATE:
DRAWN BY: C. KIRBY		CONTR. NO.	SEQUENCE NO. 59
REVIEWED BY: R. BEHM		DRAWING NUMBER	SHEET NO. OF
SUBMITTED BY: ROBERT C. BEHM ENGINEER			



TO ACCOMPANY FOUNDATION REPORT

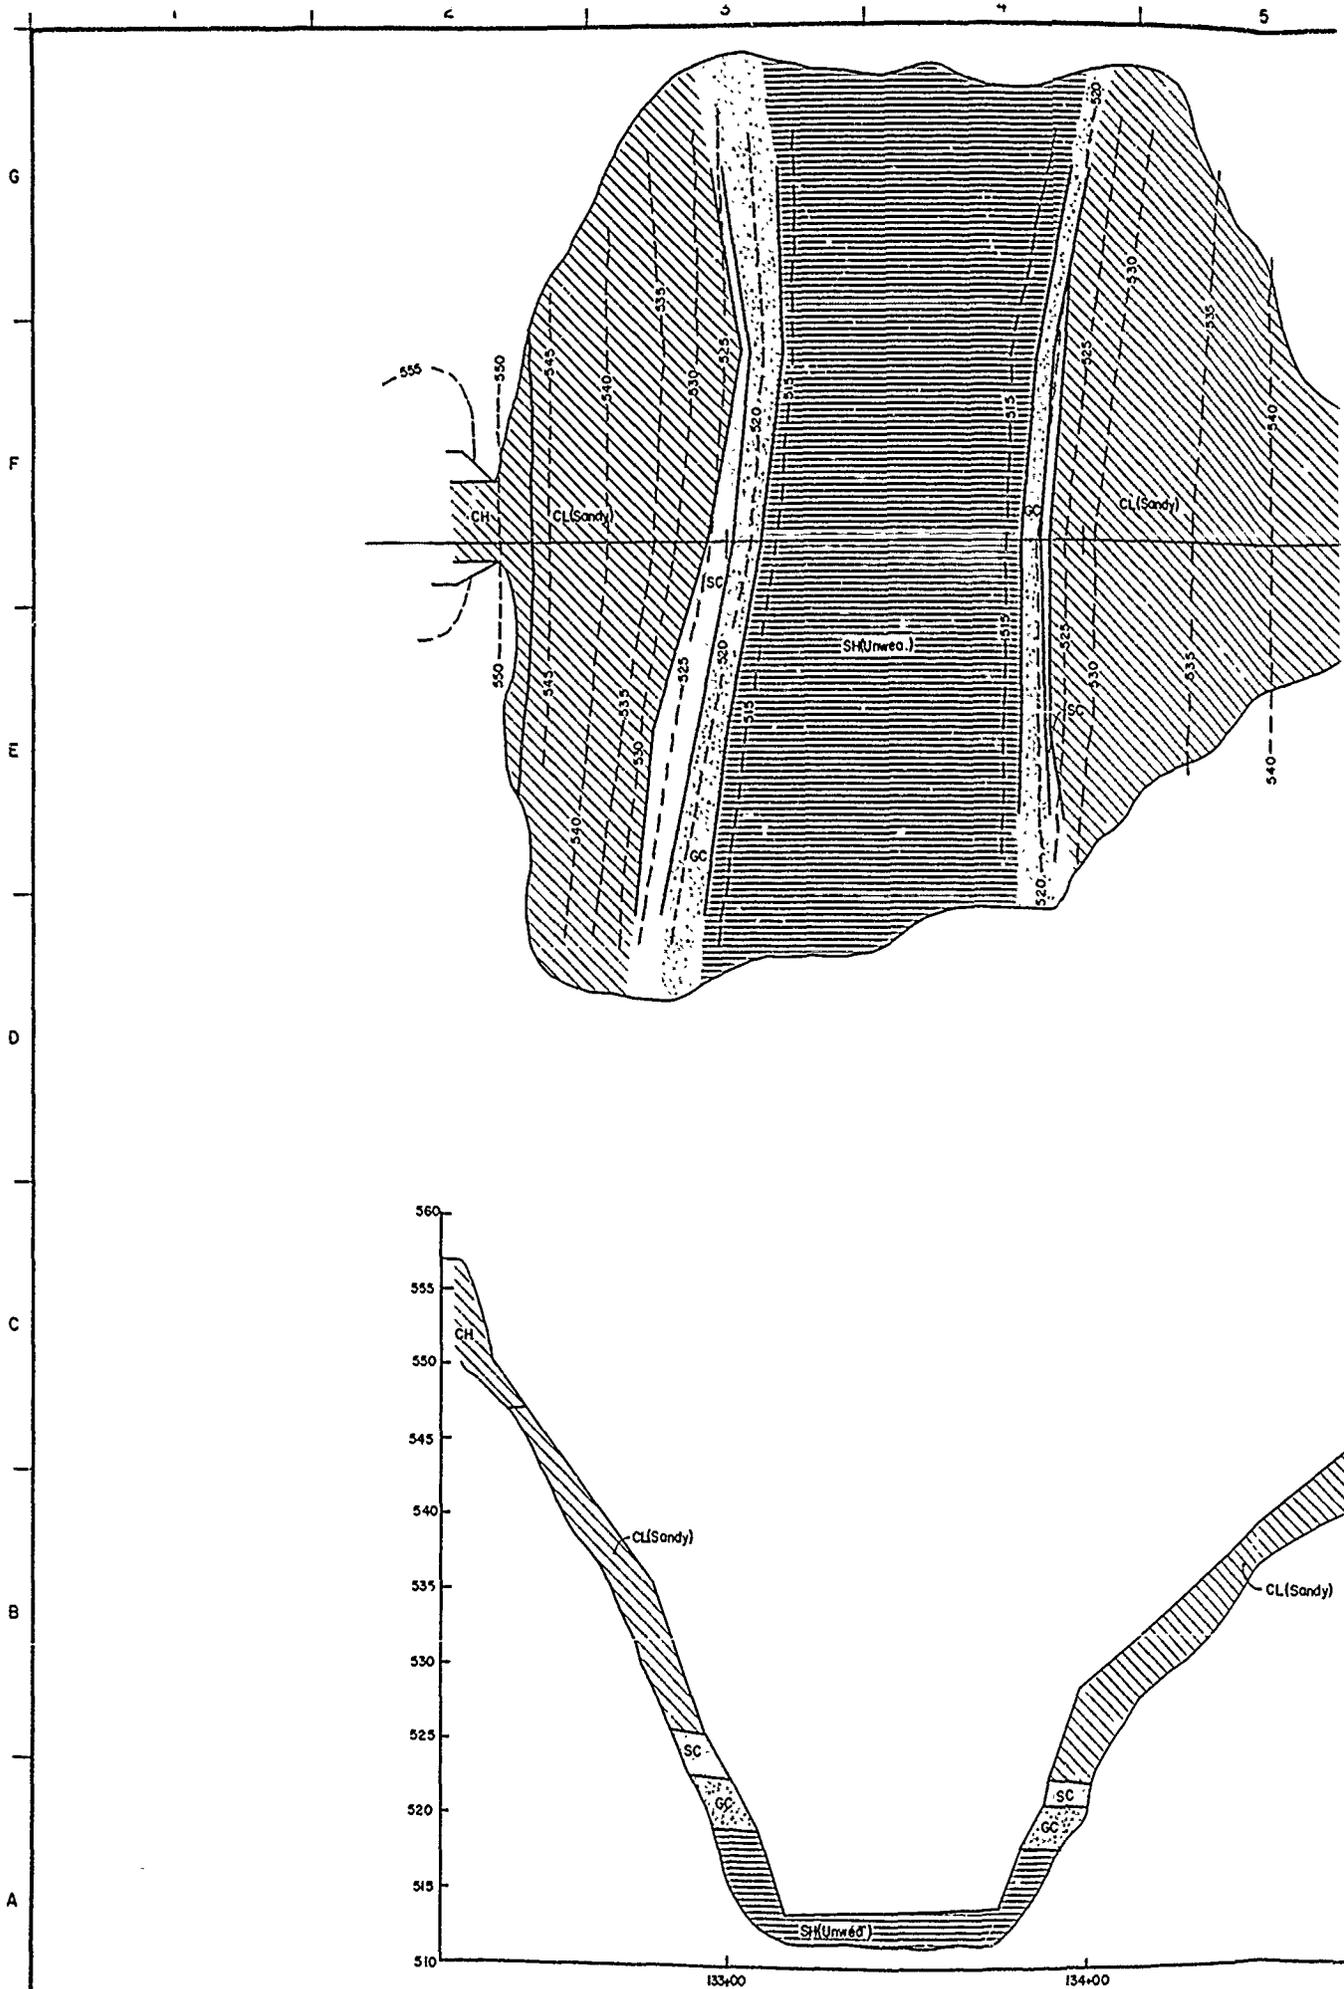

G
F
E
D
C
B
A


2 3 4 5

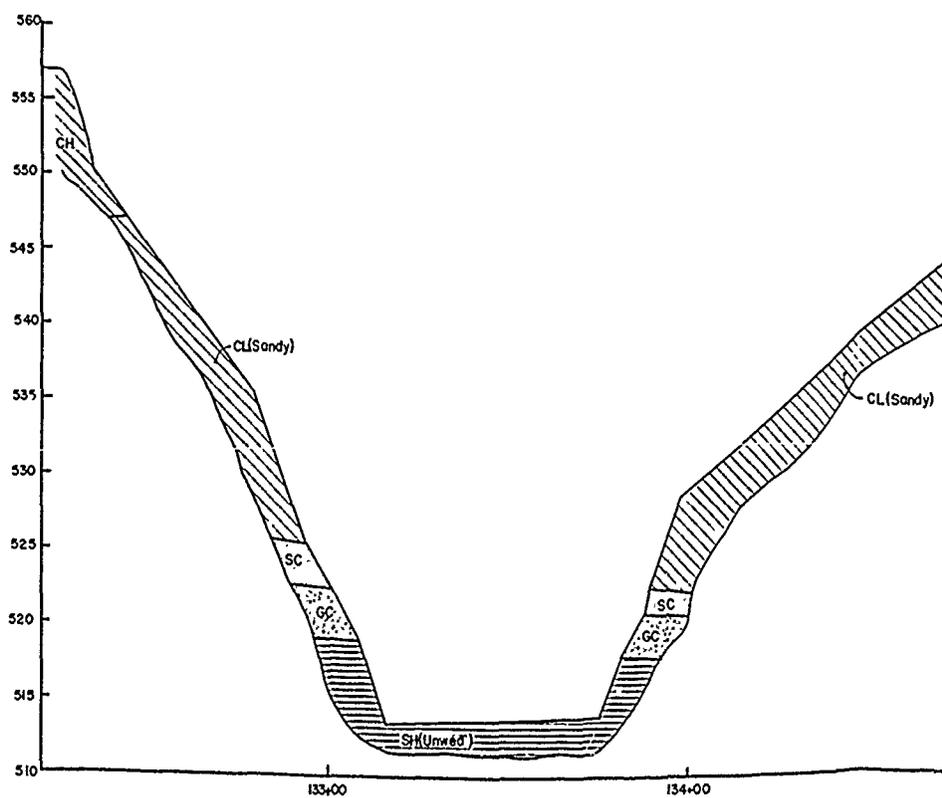

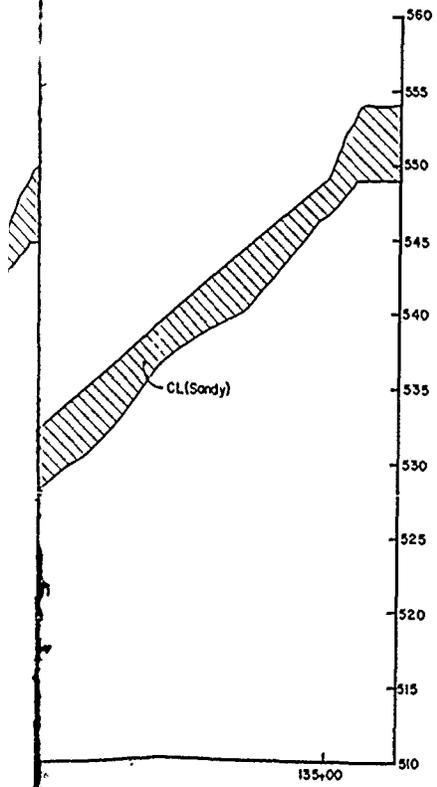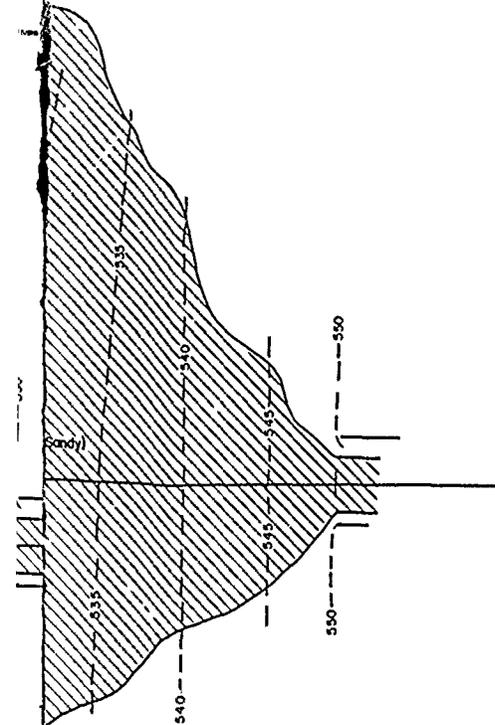

DESIGNED BY: H. BARNETT		RAY ROBERTS LAKE ELM FORK, TRINITY RIVER, TEXAS	
DRAWN BY: C. KIRBY		FOUNDATION REPORT INSPECTION TRENCH	
REVIEWED BY: R. BEHM		AS BUILT PLAN AND PROFILE STA. 132+35 TO 135+20	
SUBMITTED BY: ROBERT C BEHM		SOL. NO.	DATED:
ENGINEER:		CONTR. NO.	SHEET NO.
		DRAWING NUMBER	OF

TO ACCOMPANY FOUNDATION REPORT

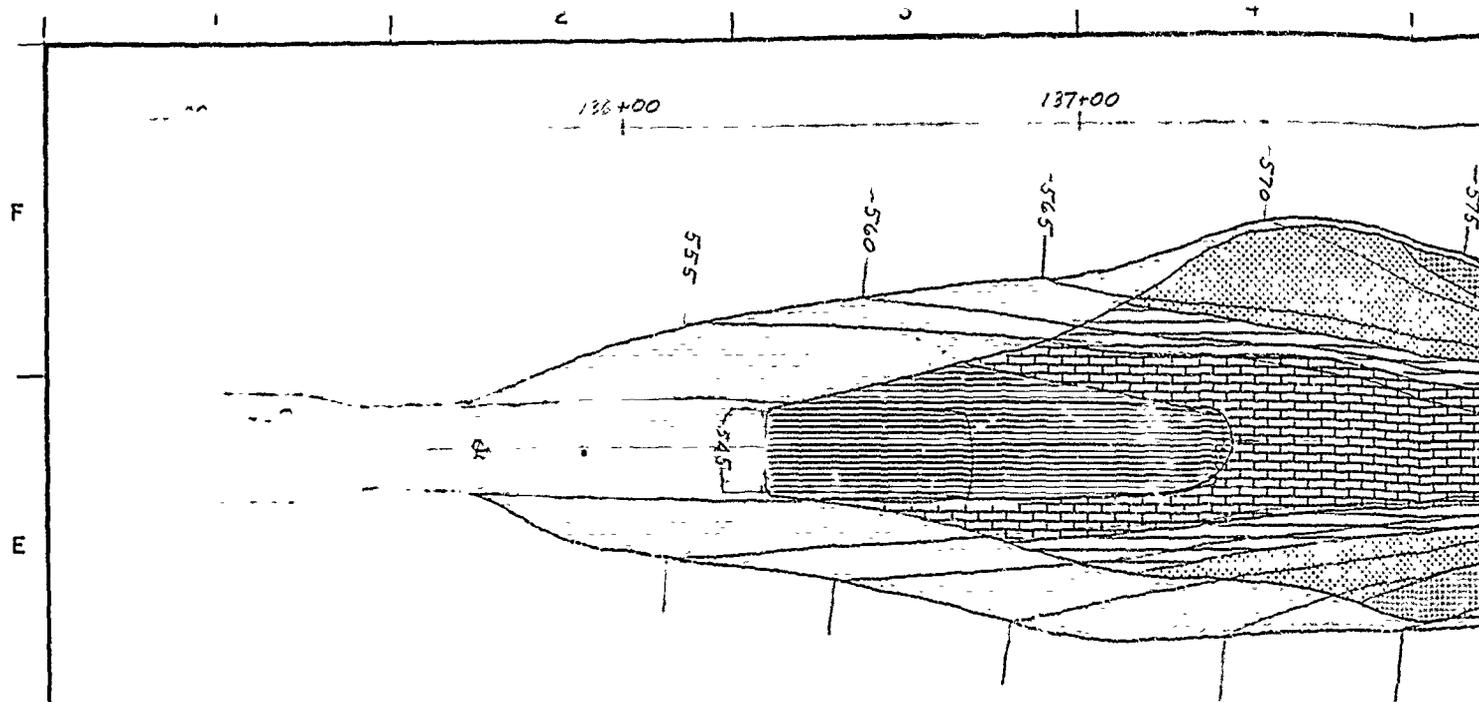

OVERBURDEN

-  CLAY, v sandv, dry. lt gray mottled red-brn
-  SAND, silty, variably clayey, tan, fine. Scattered gravels, irregularly weakly cemented.
-  SAND, clayey, dense, rust. With gravel and cobble-sized sandstone fragments.

PRIMARY

-  SHALE, (Pawpaw) soft, moist, gray w/ rust stains along joint planes, mod-sl cemented.
-  LIMESTONE, (Main Street) hard, sl weathered, non-jointed.
-  MARL, (Grayson) soft-mod hard, moist, weathered, calc. massive, tan and lt gray, scatt stained joints.
-  WEATHERED SANDSTONE, (Woodbine) Non-cemented sand and weakly cemented sandstone, oxide stained. lt gray and rust.
-  CLAY, (Woodbine) sandv, v stiff, dry, lt gray mottled rust. massive, contains plant frags.
-  SAND, (Woodbine) fine, clayey, silty, rust.
-  SAND, (Woodbine) loose, fine, clean, tan.

ELEVATION IN FEET



D

C

B



A

POLYTRACE 033

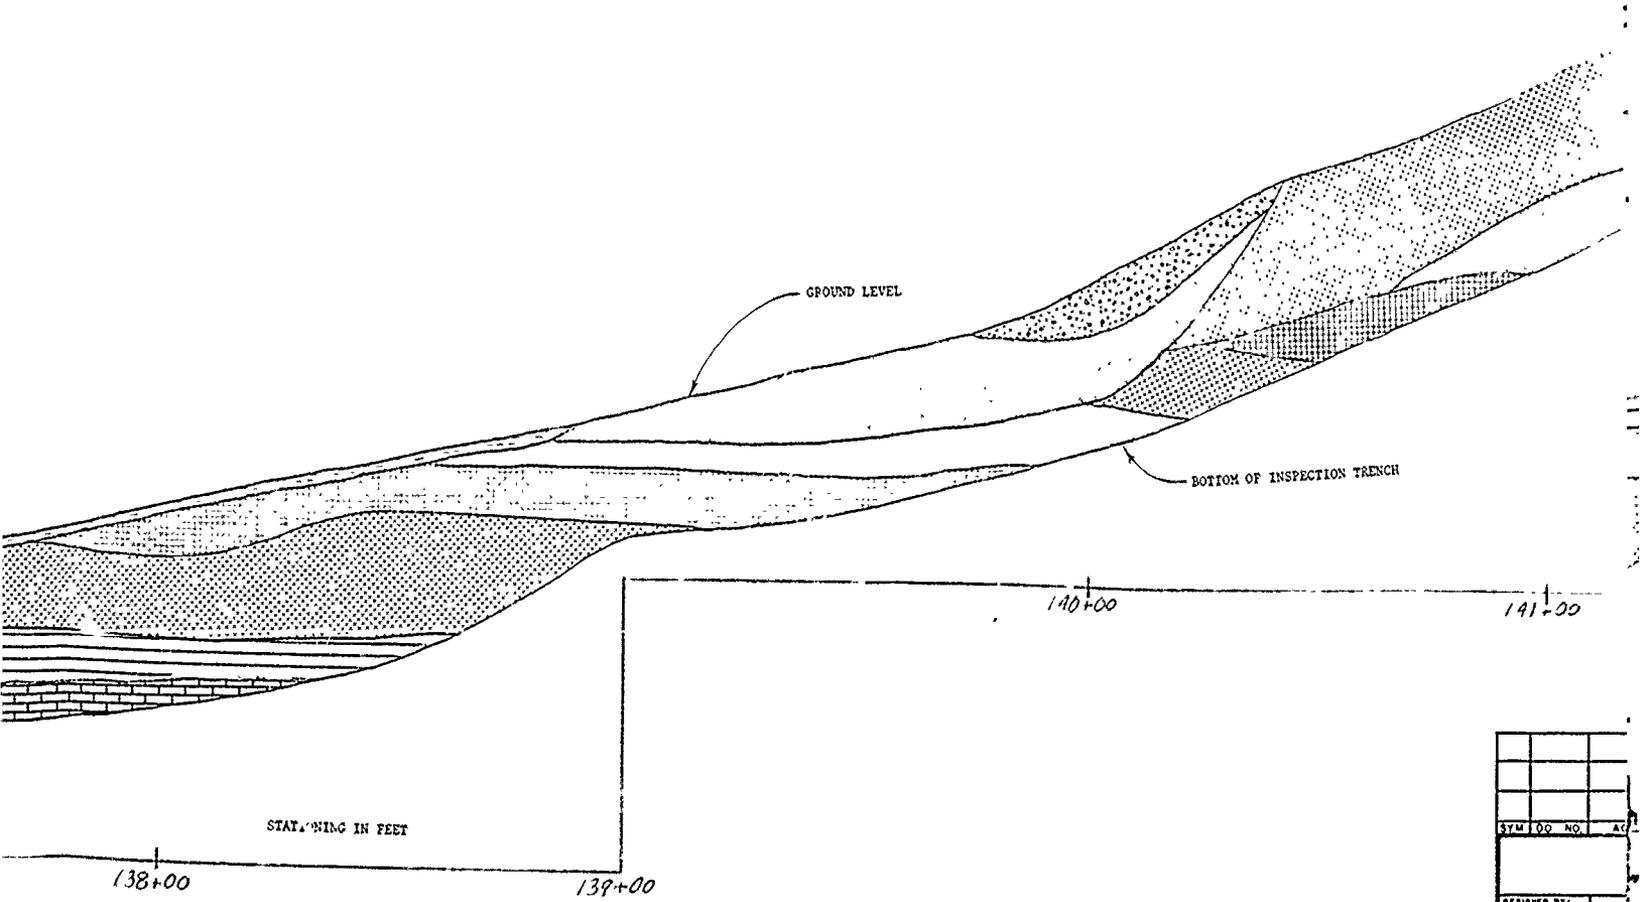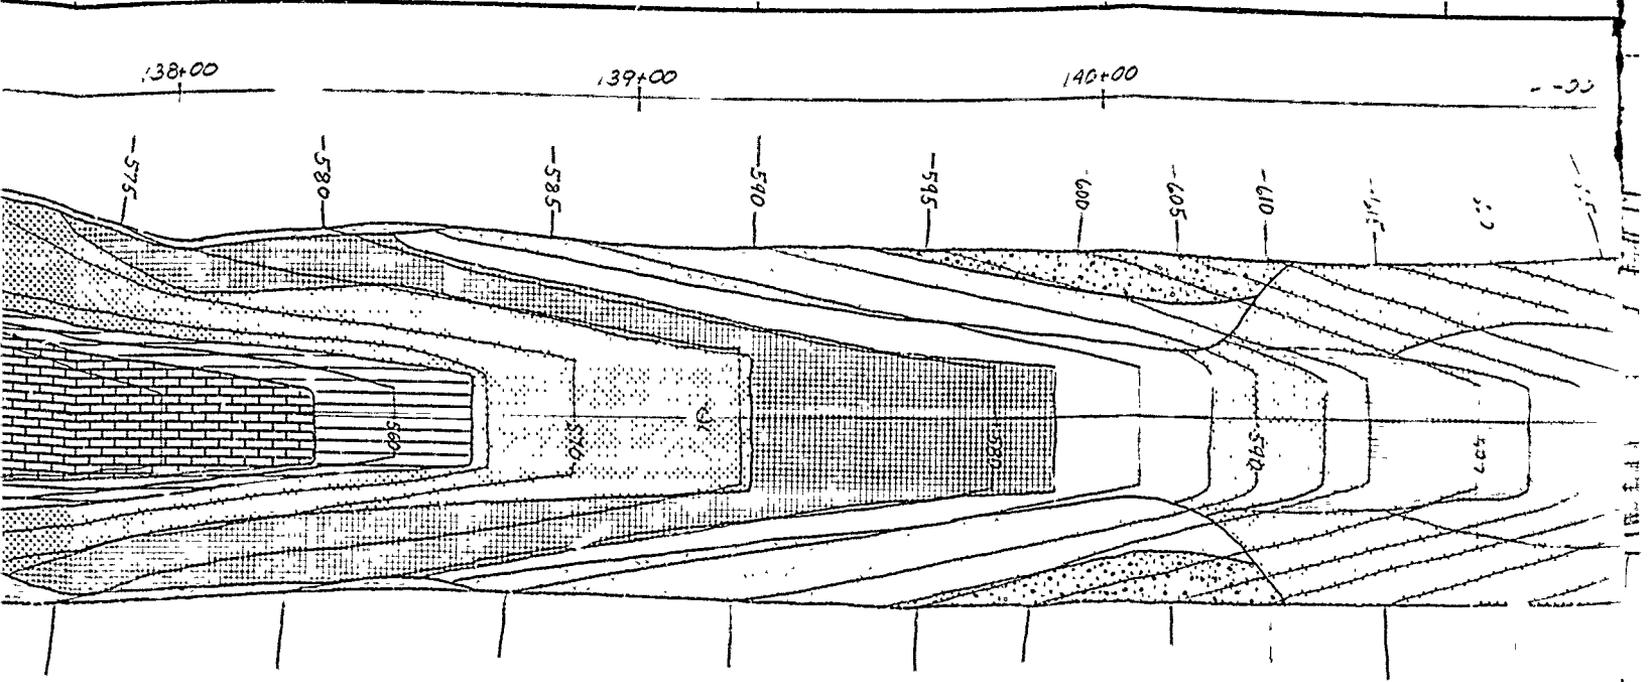


STATIONING IN FEET

DESIGNED BY:	R. HAGEN
DRAWN BY:	R. HAGEN
REVIEWED BY:	R. HAGEN

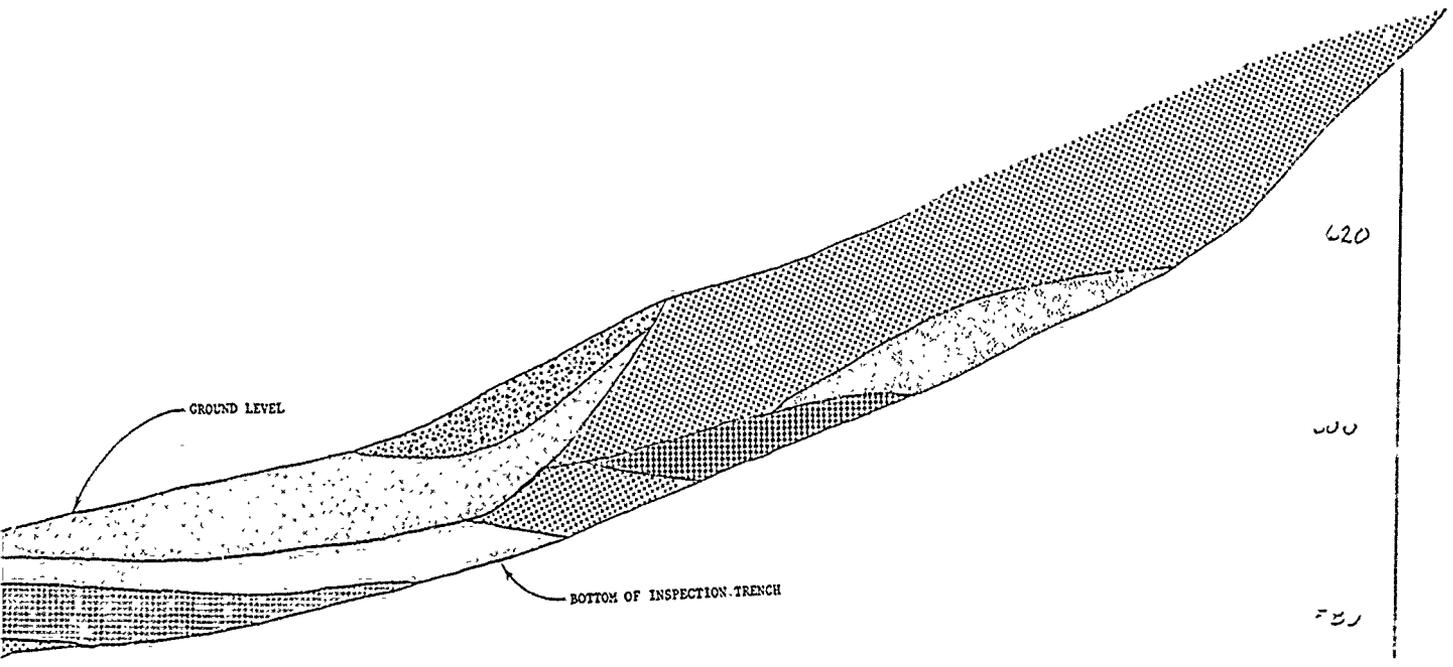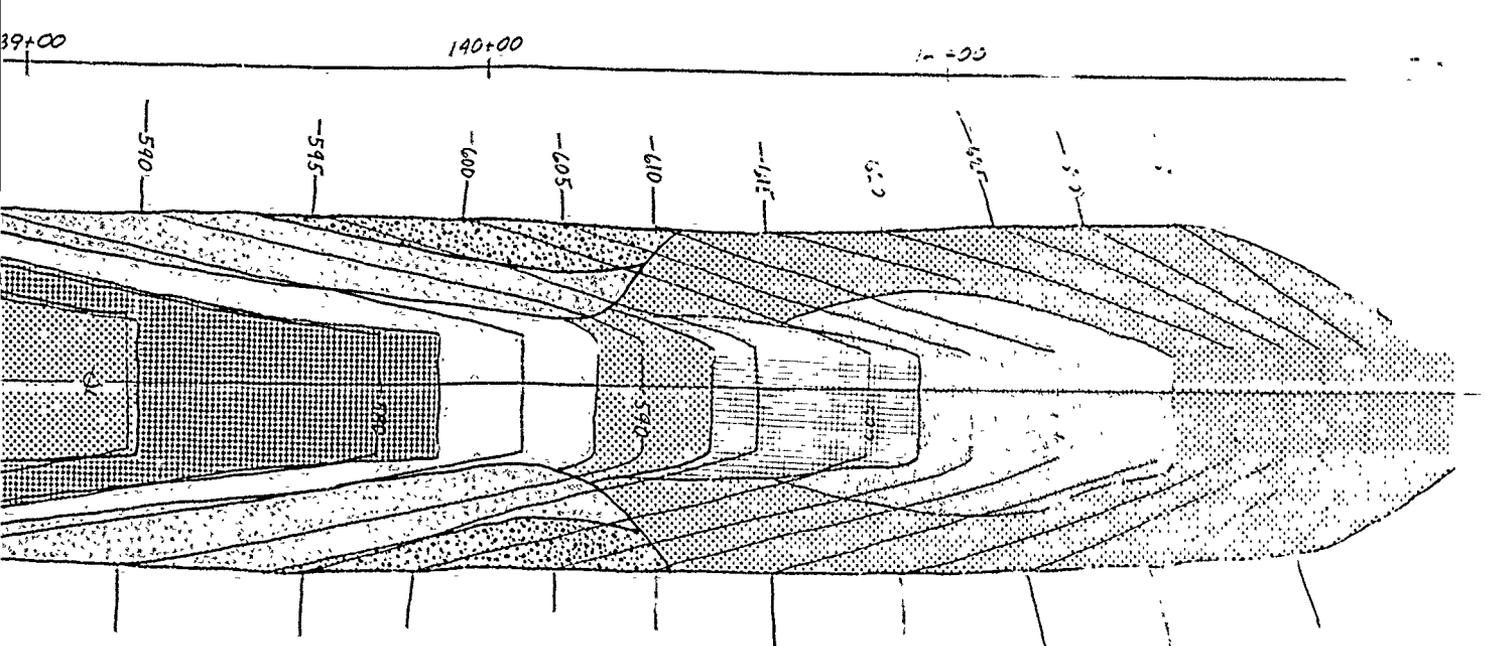

SYM	NO	ACTION	DATE	DESCRIPTION OF REVISION
				U.S. ARMY ENGINEER DISTRICT, FORT WORTH CORPS OF ENGINEERS FORT WORTH, TEXAS
DESIGNED BY:	RAY ROBERTS LAKE ELM-FORK TRINITY RIVER, TEXAS			
DRAWN BY:	LEFT ABUTMENT INSPECTION TRENCH			
REVIEWED BY:	GEOLOGIC PLAN AND PROFILE STA. 135+00 TO STA. 142+00			
SUBMITTED BY:	ROBERT C. BEHAM	INVITATION NO.		DATE:

© DBM-1

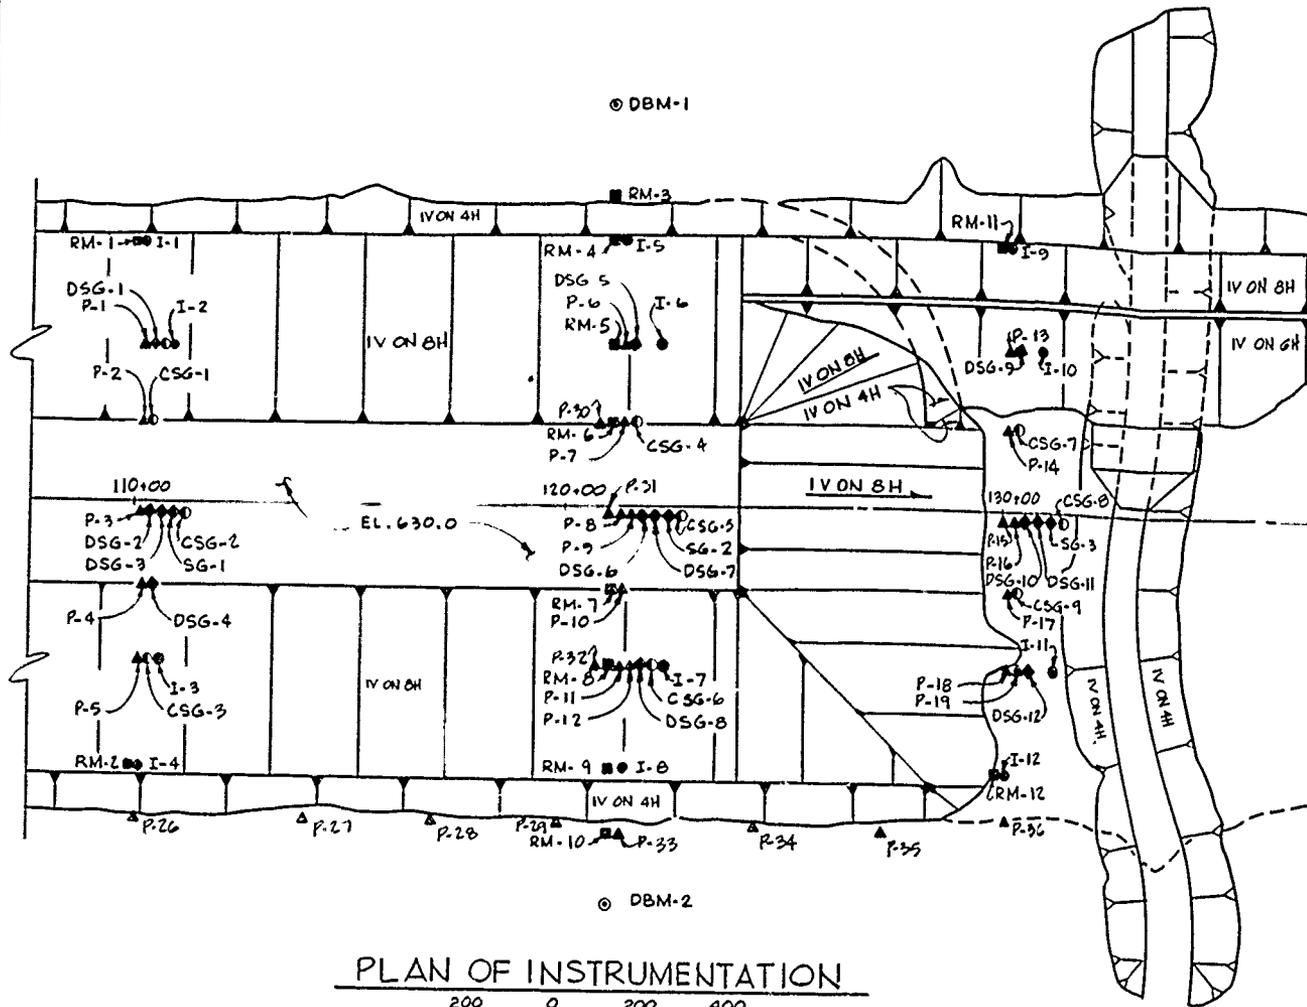

© DBM-2

PLAN OF INSTRUMENTATION

200 0 200 400
SCALE IN FEET




REFERENCE MARKS				
LINE	NO.	STATION	OFFSET	INSTALLATION SCHEDULE
A	RM-1	109+90.2	580.6 U/S	3
	RM-2	109+90.1	580.3 O/S	3
B	RM-3	120+89.4	579.6 U/S	1
	RM-4	120+90.3	579.1 U/S	3
	RM-5	120+90.7	350.0 U/S	3
	RM-6		U/S	3
	RM-7		O/S	3
C	RM-8	120+92.3	351.1 O/S	3
	RM-9	120+77.6	580.2 O/S	3
	RM-10	120+78.3	589.8 O/S	3
	RM-11		U/S	3
	RM-12		O/S	3

POROUS PLASTIC TIP PIEZOMETERS						
LINE NO.	STATION	OFFSET	FILTER LOCATION	APPROX. FILTER EL. FT., MSL	INSTALLATION SCHEDULE	
A	P-1	110+15	349' U/S	WK CI	524-529	
	P-2	110+10	179' U/S	WK CI	529-534	
	P-3	110+10	24' O/S	WK CI	524-529	
	P-4	110+18	181' O/S	WK CI	525-530	
	P-5	110+10	350' O/S	WK CI	526-531	
B	P-6	121+10	350' U/S	WK CI	538-543	
	P-7	121+11	180' U/S	WK CI	538-543	
	P-8	121+01	24' O/S	WK CI	522-527	
	P-9	121+10	24' O/S	SH	492-496	
	P-10	121+10	180' O/S	WK CI	530-535	
	P-11	121+20	350' O/S	WK CI	536-541	
	P-12	121+10	350' O/S	SH	499-504	
C	P-13	129+99	351' U/S	WK CI	533-538	2
	P-14	130+11	112' U/S	WK CI	527-532	2
	P-15	130+00	24' O/S	WK CI	529-534	2
	P-16	130+10	24' O/S	SH	501-506	2
	P-17A	130+01	116' O/S	WK CI	526-531	2
	P-18	129+99	349' O/S	WK CI	524-529	2
	P-11	130+10	349' O/S	SH	499-504	2
SEEPAGE PIEZOMETERS	P-21	28+47	297' O/S	SD+GR	583-588	4
	P-21	32+48	299' O/S	SD+GR	581-586	4
	P-22	54+02	323' O/S	SD+GR	565-570	4
	P-23	63+00	327' O/S	SD+GR	565-570	4
	P-24	73+25	328' O/S	SD+GR	576-581	4
	P-25	85+07	320' O/S	SD+GR	576-581	4
	P-26	110+05	666' O/S	SD+GR	523-528	4
	P-27	114+00	678' O/S	SD+GR	521-526	4
	P-28	116+99	678' O/S	SD+GR	520-525	4
	P-29	119+99	678' O/S	SD+GR	518-523	4
	P-30	121+40	182' U/S	SD+GR	520-525	4
	P-31	120+40	26' O/S	SD+GR	512-518	4
P-32	121+00	345' O/S	SD+GR	524-529	4	
P-33	121+09	677' O/S	SD+GR	518-523	4	
P-34	124+30	675' O/S	SD+GR	520-525	4	
P-35	127+29	672' O/S	SD+GR	521-526	4	
P-36	130+10	675' O/S	SD+GR	522-527	4	

SETTLEMENT			
LINE NO.	STATION	OFF.	
A	DSG-1	110+30	350
	DSG-2	110+20	24
	DSG-3	110+30	24
	SG-1	110+50	25
	DSG-4	110+20	350
B	DSG-5	121+20	350
	DSG-6	121+20	24
	DSG-7	121+40	24
	SG-2	121+31	25
	DSG-8	121+30	350
C	DSG-9	130+09	351
	DSG-11	130+19	24
	SG-3	130+40	24
	DSG-12	130+19	350


POROUS PLASTIC TIP P			
LINE NO.	STATION	OFFSET	L
P-14B	130+07	120' U/S	5
P-31	137+62	104' U/S	
P-35	137+59	361' O/S	
P-37	137+58	621' O/S	
P-40	139+06	107' O/S	
P-42	140+53	326' O/S	
P-41A	141+41	92' O/S	
P-41B	141+39	95' O/S	

P. 101140/03

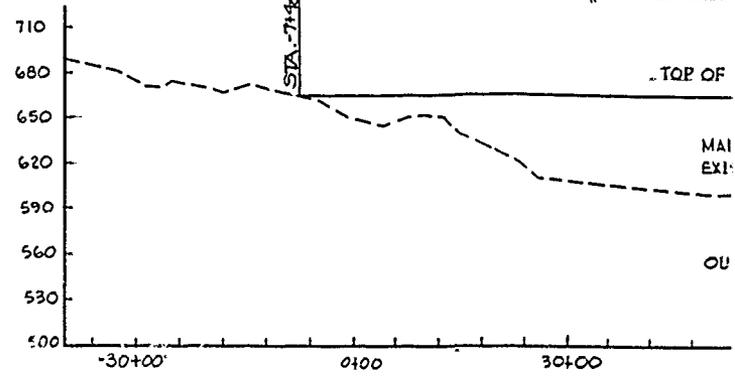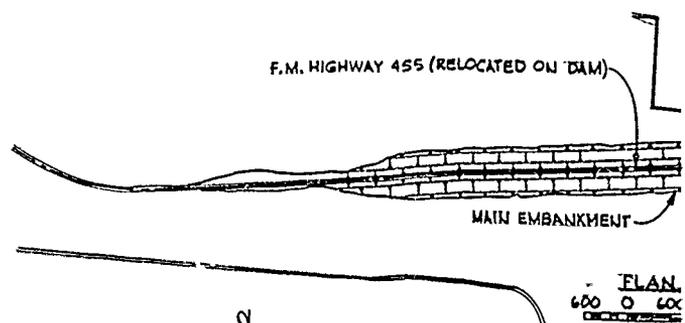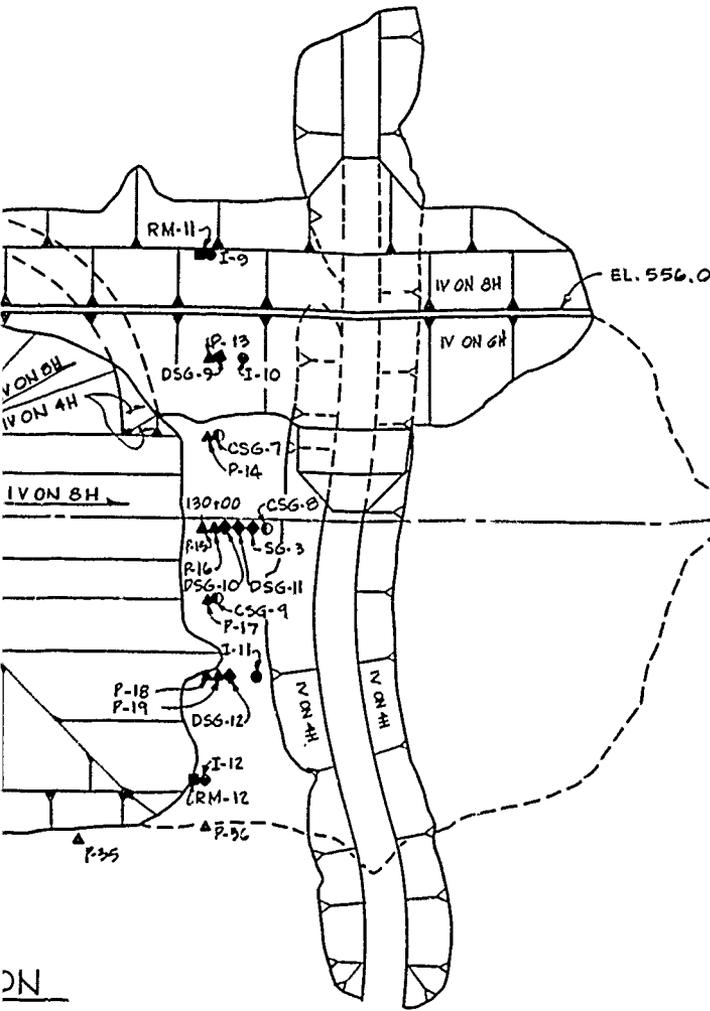

PLAN
0 60'

PRO

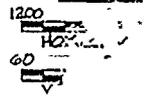

PER TION	APPROX. FILTER EL. FT., MSL	INSTALLATION SCHEDULE
CI	524-529	
CI	529-534	
CI	524-529	
CI	525-530	
CI	526-531	
CI	530-535	
CI	530-535	
CI	522-527	
CI	490-495	
CI	630-635	
CI	536-541	
H	499-504	
CI	533-538	2
CI	527-532	2
CI	524-529	2
CI	501-506	2
CI	526-531	2
CI	524-529	2
CI	499-504	2
GR	583-588	4
GR	581-586	4
GR	585-590	4
GR	585-590	4
GR	576-581	4
GR	576-581	4
GR	523-528	4
GR	521-526	4
GR	520-525	4
GR	513-518	4
GR	524-529	4
GR	518-523	4
GR	520-525	4
GR	521-526	4
GR	522-527	4

SETTLEMENT GAGES					
LINE	NO.	STATION	OFFSET	APPROX. PLATE EL.	INSTALLATION SCHEDULE
A	DSG-1	110+30	350' U/S	536	1
	DSG-2	110+20	24' D/S	503	1
	DSG-3	110+30	24' D/S	526	1
	SG-1	110+50	25' D/S	560	1
	DSG-4	110+20	550' D/S	527	1
B	DSG-5	121+20	350' U/S	540	1
	DSG-6	121+20	24' D/S	526	1
	DSG-7	121+40	24' D/S	508	1
	SG-2	121+31	25' D/S	557	1
	DSG-8	121+30	350' D/S	540	1
C	DSG-9	130+07	351' U/S	536	2
	DSG-10	130+19	24' D/S	532	2
	DSG-11	130+27	24' D/S	516	2
	SG-3	130+40	24' U/S	558	2
	DSG-12	130+19	350' D/S	526	2

INCLINOMETERS					
LINE	NO.	STATION	OFFSET	APPROX. BOTTOM	INSTALLATION SCHEDULE
A	I-1	110+10	580' U/S	490	1
	I-2	110+30	350' U/S	490	1
	I-3	110+30	350' D/S	480	1
	I-4	110+20	580' D/S	488	1
B	I-5	121+10	580' U/S	500	1
	I-6	121+30	350' U/S	498	1
	I-7	121+50	350' D/S	494	1
	I-8	121+10	580' D/S	494	1
C	I-9	130+10	580' U/S	490	2
	I-10	130+30	350' U/S	496	2
	I-11	130+40	350' D/S	494	2
	I-12	130+10	580' D/S	494	2

INSTALLATION SCHEDULE

1. AFTER STRIPPING STA
2. AFTER STRIPPING STA
3. AS EMBANKMENT RELEVATION AT THIS ST OFFSET (BEFORE TOP)
4. AFTER ENTIRE EMB TOPPED-OUT

LEGEND


- ▲ PIEZOMETER
- ◆ SETTLEMENT GAGE
- COLLAPSIBLE SETTLE
- INCLINOMETER
- REFERENCE MARK
- BENCHMARK

POROUS PLASTIC TIP PIEZOMETERS (CONT.)						
LINE	NO.	STATION	OFFSET	FILTER LOCATION	APPROX. FILTER EL. FT., MSL	INSTALLATION SCHEDULE
P	P-14	130+07	120' U/S	SD & CI		
	P-31	137+62	104' U/S	SD		
	P-38	137+59	36' D/S			
	P-37	137+58	62' D/S			
	P-40	139+06	107' D/S	SD & CI		
	P-41	139+04	565' D/S	SD		
	P-42	140+53	326' D/S	SD		
	P-43A	141+41	92' D/S	SD		
P	P-43B	141+39	95' D/S	SD		


COLLAPSIBLE SETTLEMENT GAGES					
LINE	NO.	STATION	OFFSET	APPROX. BOTTOM	INSTALLATION SCHEDULE
A	CSG-1	110+20	180' U/S	490	1
	CSG-2	110+50	24' U/S	480	1
	CSG-3	110+40	350' D/S	480	1
B	CSG-4	121+20	180' U/S	496	1
	CSG-5	121+60	24' D/S	486	1
	CSG-6	121+40	350' D/S	494	1
C	CSG-7	130+20	180' U/S	496	2
	CSG-8	130+60	24' D/S	486	2
	CSG-9	130+20	180' D/S	494	2

DEEP BENCHMARK				
LINE	NO.	STATION	OFFSET	APPR. BOTTM
B	BM-1	21+00	380' D/S	500
B	BM-2	121+00	380' D/S	490
B	BM-3	143+00	50' D/S	650


SEE EMBANKMENT INSTRUMENTATION PLAN THIS SEQUENCE

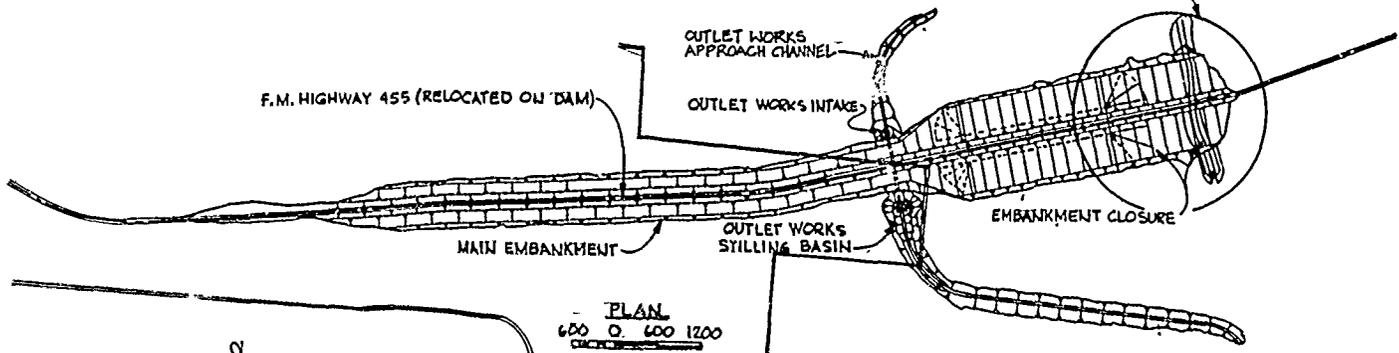

PLAN
600 O. 600 1200

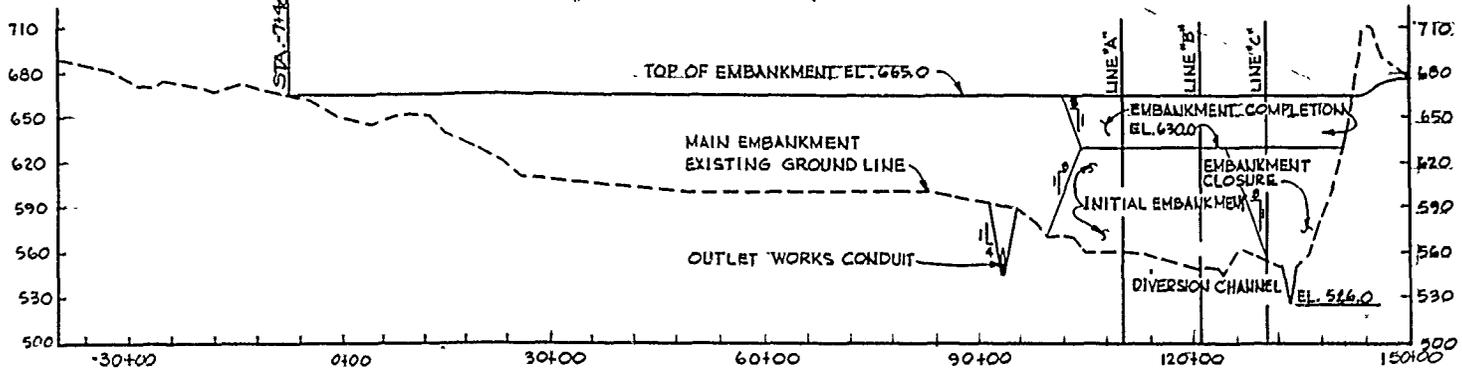

PROFILE

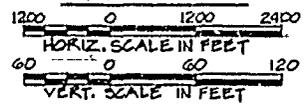

INCLINOMETERS					
LINE	NO.	STATION	OFFSET	APPROX. BOTTOM	INSTALLATION SCHEDULE
A	I-1	110+10	580' U/S	490	1
	I-2	110+30	350' U/S	490	1
	I-3	110+30	350' D/S	480	1
	I-4	110+20	580' D/S	488	1
B	I-5	121+10	580' U/S	500	1
	I-6	121+30	350' U/S	498	1
	I-7	121+50	350' D/S	494	1
	I-8	121+10	580' D/S	494	1
C	I-9	130+10	580' U/S	490	2
	I-10	130+30	350' U/S	496	2
	I-11	130+60	350' D/S	494	2
	I-12	130+20	580' D/S	494	2

INSTALLATION SCHEDULE LEGEND

- AFTER STRIPPING STAGE I
- AFTER STRIPPING STAGE III C
- AS EMBANKMENT REACHES FINISHED ELEVATION AT THIS STATION AND OFFSET (BEFORE TOPSOIL).
- AFTER ENTIRE EMBANKMENT IS TOPPED-OUT

LEGEND

- ▲ PIEZOMETER
- ◆ SETTLEMENT GAGE
- ◇ COLLAPSIBLE SETTLEMENT GAGE
- ⊖ INCLINOMETER
- REFERENCE MARK
- ⊙ BENCHMARK

COLLAPSIBLE SETTLEMENT GAGES					
LINE	NO.	STATION	OFFSET	APPROX. BOTTOM	INSTALLATION SCHEDULE
A	CS4-1	110+20	180' U/S	490	1
	CS4-2	110+50	24' U/S	480	1
	CS4-3	110+40	320' D/S	480	1
B	CS4-4	121+20	180' U/S	496	1
	CS4-5	121+60	24' D/S	486	1
	CS4-6	121+40	350' D/S	494	1
C	CS4-7	130+20	180' U/S	496	2
	CS4-8	130+60	24' D/S	486	2
	CS4-9	130+20	180' D/S	494	2

DEEP BENCHMARK					
LINE	NO.	STATION	OFFSET	APPROX. BOTTOM EL.	INSTALLATION SCHEDULE
B	DB1	121+00	380' D/S	500	1
B	DB2	121+00	380' D/S	490	1
C	DB3	143+00	50' D/S	650	1


NOTES:





- FOR SECTION THRU LINE A, SEE SEQ. NO. 44
- FOR SECTION THRU LINE B, SEE SEQ. NO. 45
- FOR SECTION THRU LINE C, SEE SEQ. NO. 46
- ALL INSTRUMENT ELEVATIONS ARE APPROXIMATE. ACTUAL ELEVATIONS WILL BE DETERMINED AT TIME OF INSTALLATION.
- ALL INSTRUMENTATION WILL HAVE PROTECTIVE FENCE, EXCEPT THOSE ALONG THE DOWNSTREAM CREST. FOR PROTECTIVE FENCE DETAILS, SEE SEQ. 41

RECORD DRAWING-WORK AS-BUILT

10182 2000000 304884 REVISD TO REFLECT AS-BUILT CHANGES 10182 2000000 304884 REVISD TO REFLECT AS-BUILT CHANGES			
DESIGNED BY	RAY ROBERTS LAKE		
DESIGNED BY	ELM FORK, TRINITY RIVER, TEXAS		
DESIGNED BY	CORPS OF ENGINEERS FORT WORTH, TEXAS		
DESIGNED BY	A. BRANCH		
DRAWN BY	J. FIESLER		
REVIEWED BY	A. BRANCH		
SUBMITTED BY	H. KARBS		
ENGINEER	INVTATION NO. DACH63-82-B-0026	DATE: MAR. 1982	SEQUENCE NO.
	CONTRACT NO. DACH63-82-C-0093		62
	DRAWING NUMBER	SHEET NO.	

G
F
E
D
C
B
A

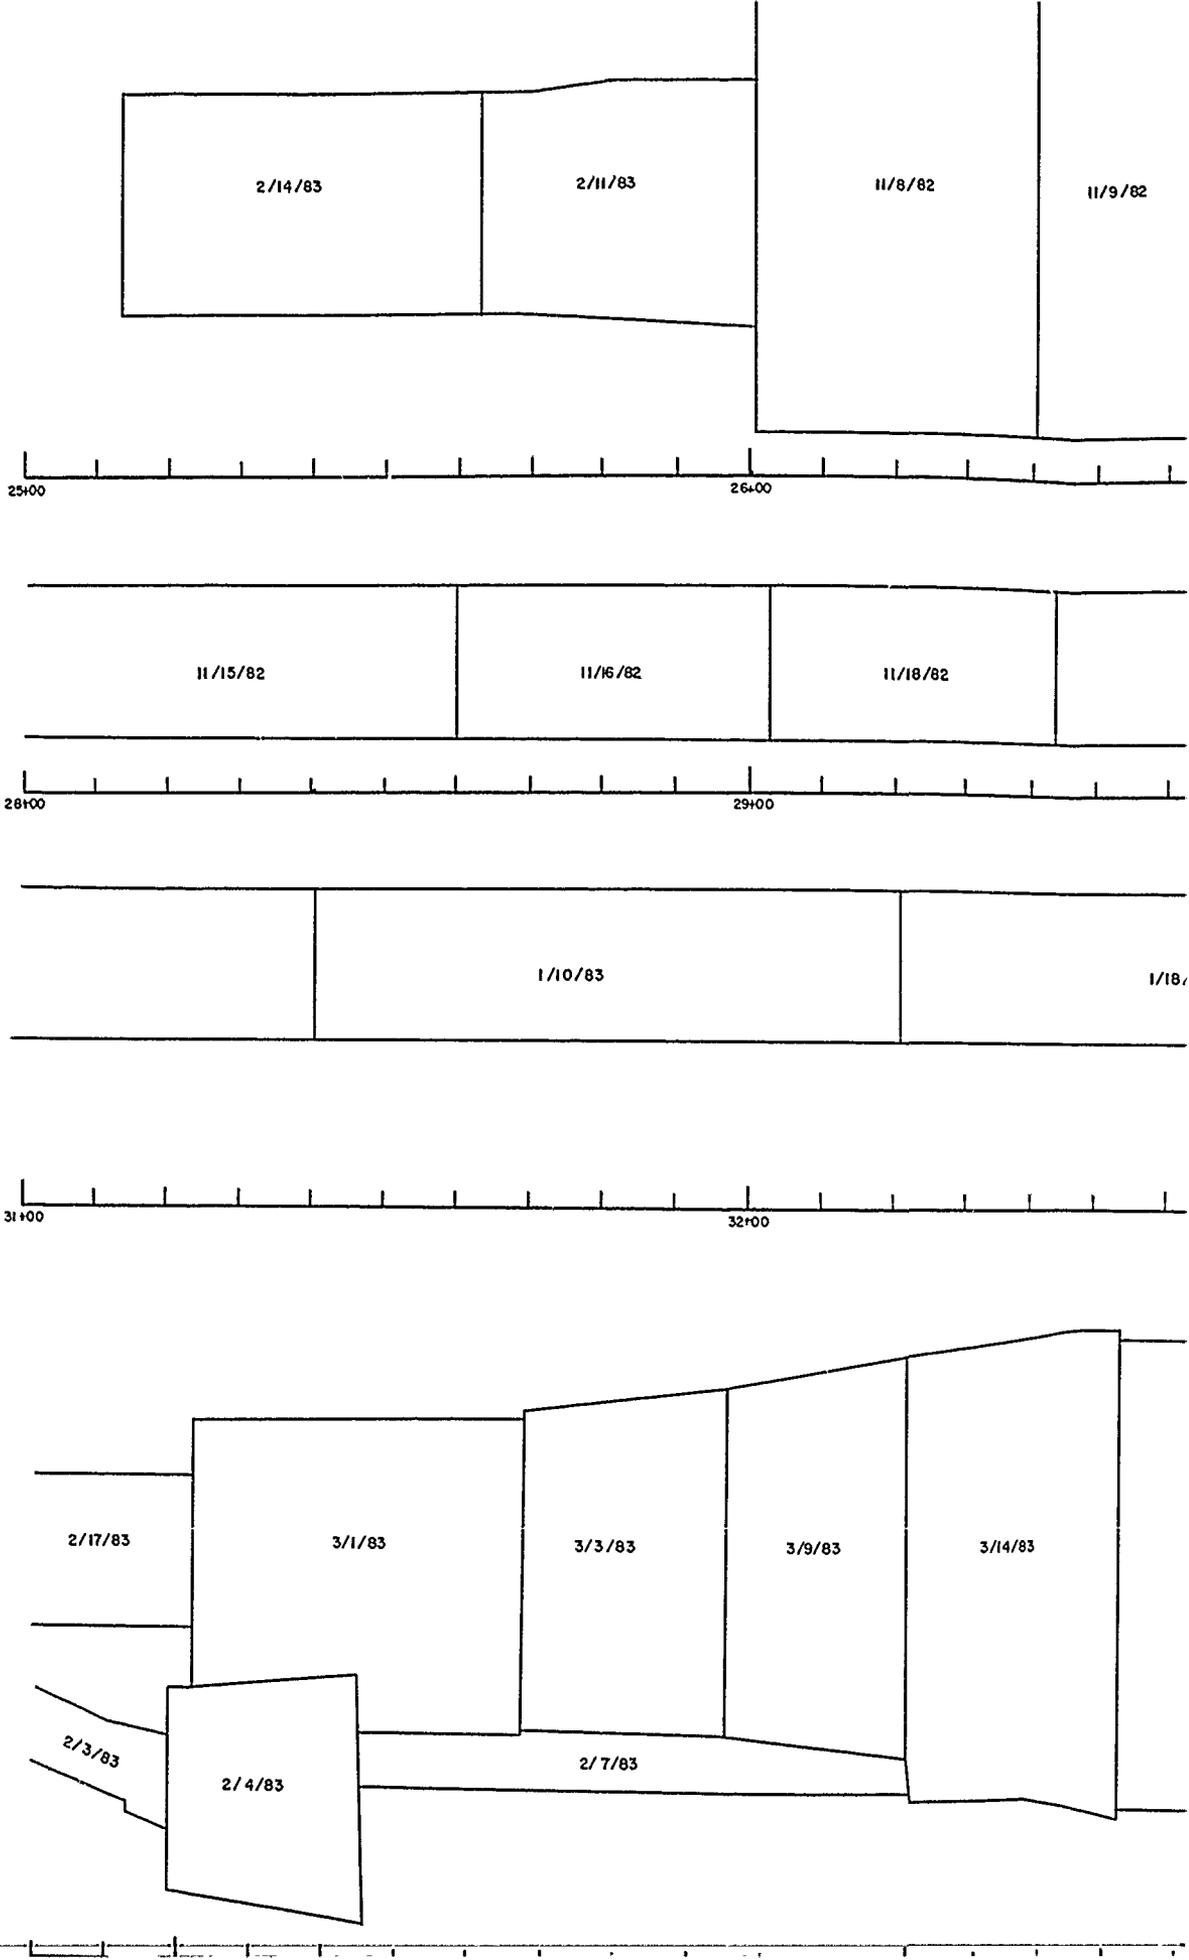

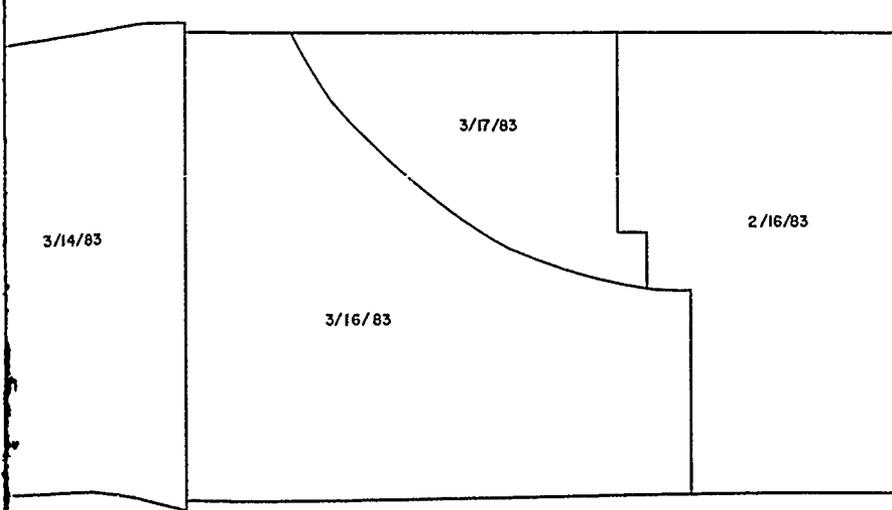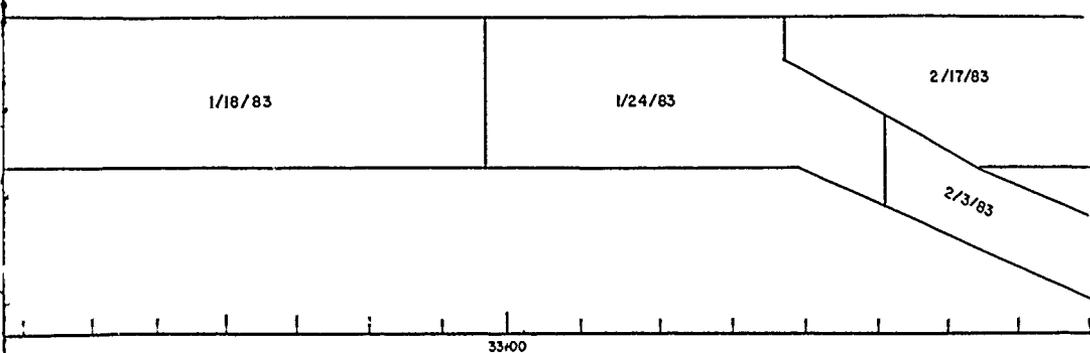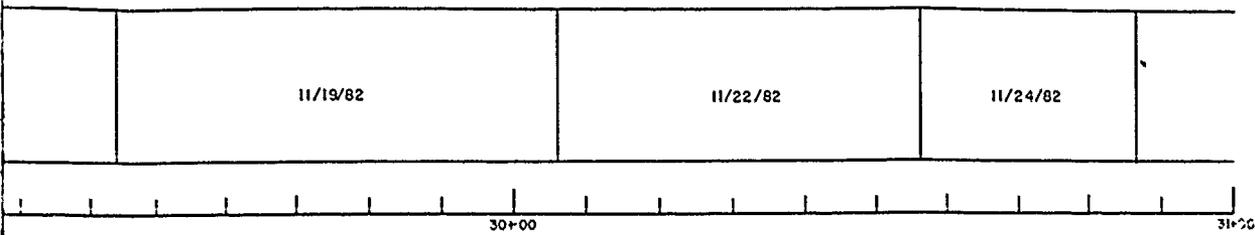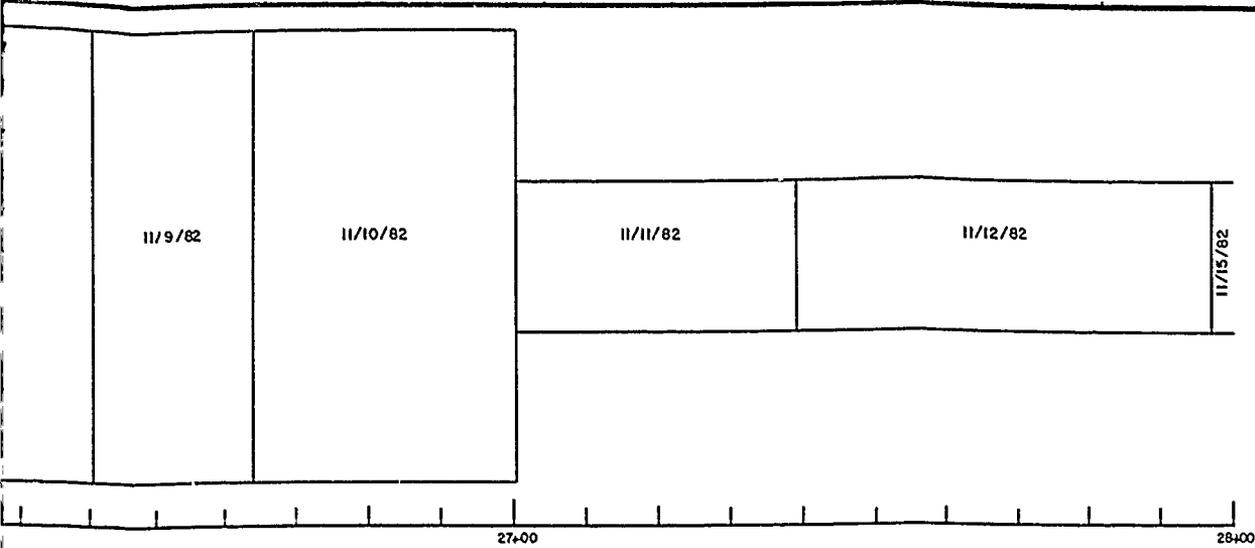

DESIGNED BY: HBARNETT		U.S. ARMY ENGINEER DISTRICT, FORT WORTH CORPS OF ENGINEERS FORT WORTH, TEXAS RAY ROBERTS LAKE ELM FORK, TRINITY RIVER, TEXAS FOUNDATION REPORT RECORD OF FOUNDATION APPROVAL
DRAWN BY: C. KIRBY		
REVIEWED BY: R. BEHM		
DATE: _____		